

17 Dec 2019


Building Division

BUILDING CONSENT NUMBER

HWOP
2019/1381



lewis bradford
CONSULTING ENGINEERS

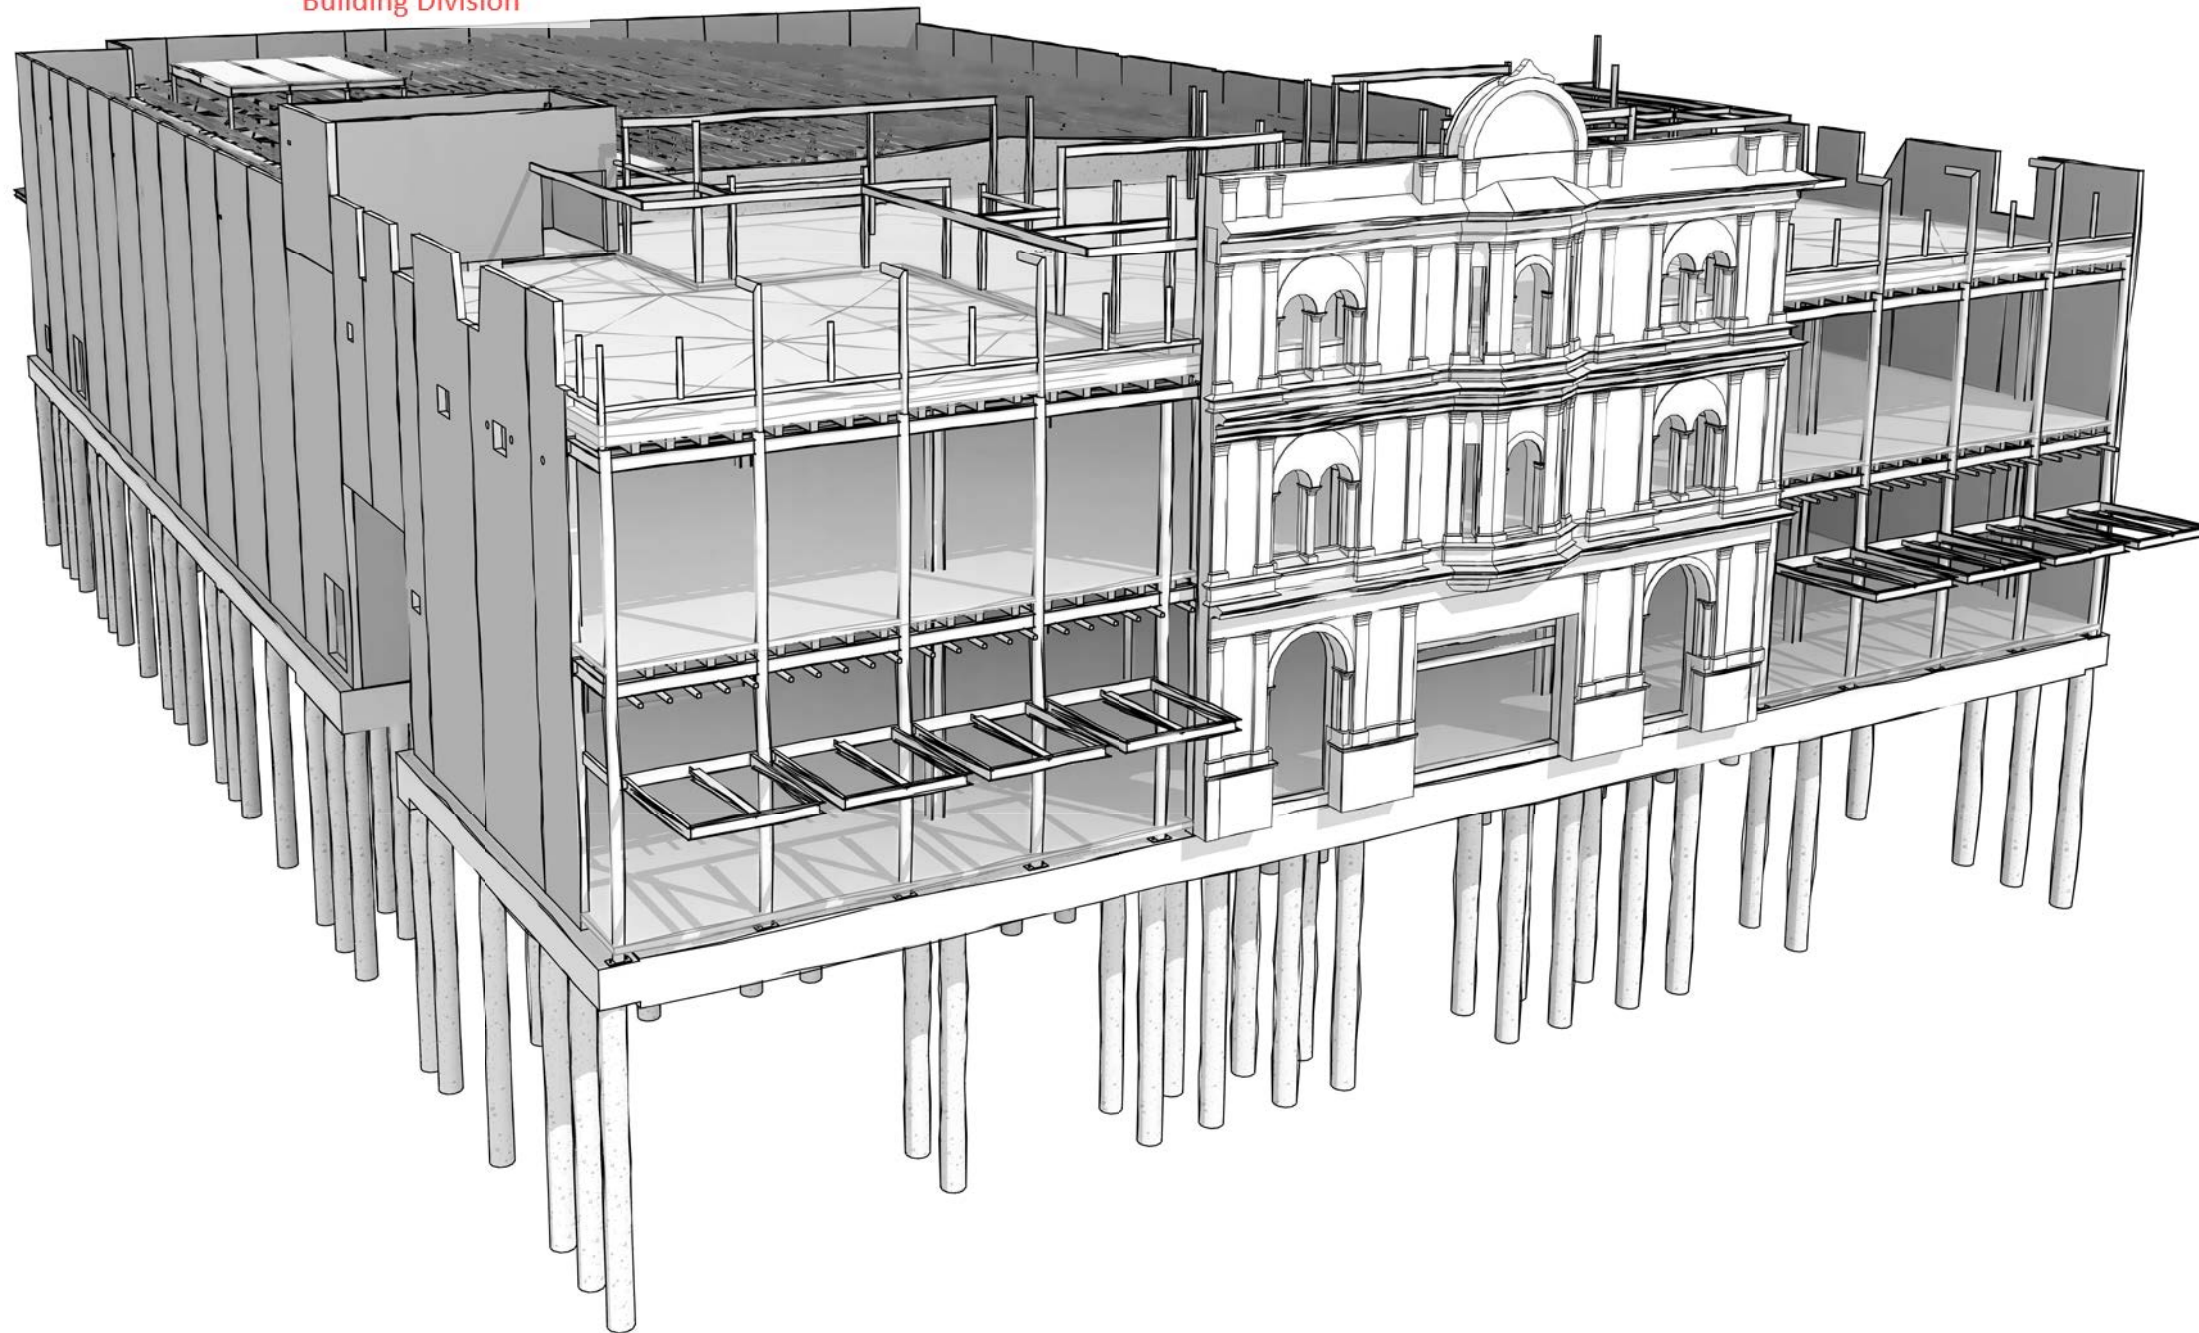

Invercargill City
Council
Building Consent
Authority
Approved Site Copy

Approved For Issue
27/02/2020

CONSENT ISSUE 25.10.19

INVERCARGILL CENTRAL ZONE 1 ANCHOR

118083-Z1-WD-ST 0000

Document Received
STRUCTURAL DRAWING INDEX

17 Dec 2019

Building Division

0001		DRAWING INDEX		25.10.19	2
0002		STANDARD NOTES		25.10.19	2
0003		OVERALL 3D VIEW		25.10.19	2
0004		OVERALL 3D VIEW		25.10.19	2
0005		OVERALL 3D VIEW		25.10.19	2
0006		OVERALL 3D VIEW		25.10.19	2
1100	GROUND FLOOR	3D VIEW		25.10.19	2
1101	GROUND FLOOR	PILE PLAN		23.10.19	2
1102	GROUND FLOOR	FOUNDATION PLAN		25.10.19	2
1103	GROUND FLOOR	OVERALL PLAN		25.10.19	2
1104	GROUND FLOOR	PART PLAN A		25.10.19	2
1105	GROUND FLOOR	PART PLAN B		25.10.19	2
1110	LEVEL 1	3D VIEW		25.10.19	2
1111	LEVEL 1	OVERALL PLAN		25.10.19	2
1112	LEVEL 1	PART PLAN A		25.10.19	2
1113	LEVEL 1	PART PLAN B		25.10.19	2
1120	LEVEL 2	3D VIEW		25.10.19	2
1121	LEVEL 2	OVERALL PLAN		25.10.19	2
1122	LEVEL 2	PART PLAN A		25.10.19	2
1123	LEVEL 2	PART PLAN B		25.10.19	2
1200	ROOF	3D VIEW		25.10.19	2
1201	ROOF	OVERALL PLAN		25.10.19	2
1202	ROOF	PART PLAN A		25.10.19	2
1203	ROOF	PART PLAN B		25.10.19	2
1204	ROOF	CHILDCARE ROOF PLAN		25.10.19	2
1205	ROOF	PLANT DECK PLANS		25.10.19	2
1206	ROOF	CENTRAL CEILING STRUCTURE		25.10.19	1
2300	FRAME ELEVATIONS	GRIDLINES 1.A & 1.B		25.10.19	2
2301	FRAME ELEVATIONS	GRIDLINES 1.C & 1.D		25.10.19	2
2302	FRAME ELEVATIONS	GRIDLINES 1.E & 1.F		25.10.19	2
2303	FRAME ELEVATIONS	GRIDLINES 1.G & 1.H		25.10.19	2
2304	FRAME ELEVATIONS	GRIDLINE 1.J		25.10.19	2
2305	FRAME ELEVATIONS	GRIDLINES 1.1 & 1.2		25.10.19	2
2306	FRAME ELEVATIONS	GRIDLINES 1.3 & 1.4		25.10.19	2
2307	FRAME ELEVATIONS	GRIDLINES 1.5 & 1.6		25.10.19	2
2308	FRAME ELEVATIONS	GRIDLINE 1.7		25.10.19	2
2400	PRECAST PANEL	3D VIEW		25.10.19	2
2401	PRECAST PANEL PLANS	GROUND FLOOR	FIRST FLOOR	25.10.19	2
2410	PRECAST PANEL ELEVATIONS	GRIDLINE 1.1 - PART 1		25.10.19	2
2411	PRECAST PANEL ELEVATIONS	GRIDLINE 1.1 - PART 2		25.10.19	2
2412	PRECAST PANEL ELEVATIONS	GRIDLINE 1.1 - PART 3		25.10.19	2
2413	PRECAST PANEL ELEVATIONS	NEAR GRIDLINE 1.5 AND 1.6		25.10.19	2
2414	PRECAST PANEL ELEVATIONS	NEAR GRIDLINE 1.6		25.10.19	2
2415	PRECAST PANEL ELEVATIONS	NEAR GRIDLINE 1.4, 1.7 and 1.J		25.10.19	2
2416	PRECAST PANEL ELEVATIONS	GRIDLINE 1.7 - PART 1		25.10.19	2
2417	PRECAST PANEL ELEVATIONS	GRIDLINE 1.7 - PART 2		25.10.19	2
2418	PRECAST PANEL ELEVATIONS	GRIDLINE 1.7 - PART 3		25.10.19	2
2419	PRECAST PANEL ELEVATIONS	GRIDLINE 1.C		25.10.19	2
2420	PRECAST PANEL ELEVATIONS	NEAR GRIDLINE 1.D		25.10.19	2
2421	PRECAST PANEL ELEVATIONS	NEAR GRIDLINE 1.C AND 1.G		25.10.19	2
2422	PRECAST PANEL ELEVATIONS	NEAR GRIDLINE 1.H		25.10.19	2
2423	PRECAST PANEL ELEVATIONS	GRIDLINE 1.J - PART 1		25.10.19	2
2424	PRECAST PANEL ELEVATIONS	GRIDLINE 1.J - PART 2		25.10.19	2
2425	PRECAST PANEL ELEVATIONS	NEAR GRIDLINE 1.J		25.10.19	2
5000	GROUND FLOOR / FOUNDATION	PILE DETAILS		23.10.19	2
5010	GROUND FLOOR / FOUNDATION	DETAILS	SHEET 1	25.10.19	2
5011	GROUND FLOOR / FOUNDATION	DETAILS	SHEET 2	25.10.19	2
5012	GROUND FLOOR / FOUNDATION	DETAILS	SHEET 3	25.10.19	2
5013	GROUND FLOOR / FOUNDATION	DETAILS	SHEET 4	25.10.19	2
5110	LEVEL 1	DETAILS	SHEET 1	25.10.19	2
5111	LEVEL 1	DETAILS	SHEET 2	25.10.19	2
5120	LEVEL 2	DETAILS	SHEET 1	25.10.19	2
5121	LEVEL 2	DETAILS	SHEET 2	25.10.19	2
5200	FACADE RETENTION ELEVATION	GRIDLINE 1.A		25.10.19	2
5210	FACADE RETENTION DETAILS	TYPICAL		25.10.19	2
5220	FACADE RETENTION DETAILS	SOUTHLAND TIMES		25.10.19	2
5300	TYPICAL PRECAST PANEL	DETAILS	SHEET 1	25.10.19	2
5301	TYPICAL PRECAST PANEL	DETAILS	SHEET 2	25.10.19	2
5302	TYPICAL PRECAST PANEL	DETAILS	SHEET 3	25.10.19	2
5310	PRECAST PANEL	DETAILS	SHEET 1	25.10.19	2
5311	PRECAST PANEL	DETAILS	SHEET 2	25.10.19	2
5500	STAIR 1.1	PART PLANS		25.10.19	2

5501	STAIR 1.1	ELEVATIONS		25.10.19	2
5502	STAIR 1.1	DETAILS	SHEET 1	25.10.19	2
5503	STAIR 1.1	DETAILS	SHEET 2	25.10.19	2
5510	STAIR 1.2	PART PLANS AND ELEVATIONS		25.10.19	2
5511	STAIR 1.2	DETAILS	SHEET 1	25.10.19	2
5601	ZONE 1	BASEPLATE DETAILS	SHEET 1	25.10.19	2
5610	TYPICAL	STEELWORK DETAILS	SHEET 1	25.10.19	2
5620	ZONE 1	STEELWORK DETAILS	SHEET 1	25.10.19	2
5621	ZONE 1	STEELWORK DETAILS	SHEET 2	25.10.19	2
5622	ZONE 1	STEELWORK DETAILS	SHEET 3	25.10.19	2
5623	ZONE 1	STEELWORK DETAILS	SHEET 4	25.10.19	2
5624	ZONE 1	STEELWORK DETAILS	SHEET 5	25.10.19	2
5625	ZONE 1	STEELWORK DETAILS	SHEET 6	25.10.19	2
5626	ZONE 1	STEELWORK DETAILS	SHEET 7	25.10.19	2
5627	ZONE 1	STEELWORK DETAILS	SHEET 8	25.10.19	1
5628	ZONE 1	STEELWORK DETAILS	SHEET 9	25.10.19	1
5700	TYPICAL ROOF	STEELWORK DETAILS	SHEET 1	25.10.19	2
5710	ROOF	STEELWORK DETAILS	SHEET 1	25.10.19	2
5711	ROOF	STEELWORK DETAILS	SHEET 2	25.10.19	2
5712	ROOF	STEELWORK DETAILS	SHEET 3	25.10.19	2
5713	ROOF	STEELWORK DETAILS	SHEET 4	25.10.19	1
5714	ROOF	STEELWORK DETAILS	SHEET 5	25.10.19	1
5715	ROOF	STEELWORK DETAILS	SHEET 6	25.10.19	1
5716	ROOF	STEELWORK DETAILS	SHEET 7	25.10.19	1
5900		WELDPLATE DETAILS	SHEET 1	25.10.19	2
Grand total: 97					

BUILDING CONSENT NUMBER

2019/1381

THIS DRAWING AND ALL INFORMATION CONTAINED WITHIN IS THE PROPERTY OF LEWIS BRADFORD. ITS CONTENTS ARE CONFIDENTIAL AND MUST NOT BE REPRODUCED OR DISTRIBUTED TO ANY OTHER PERSON OR COMPANY UNLESS AGREED TO IN WRITING BY LEWIS BRADFORD

CONTRACTOR TO VERIFY ALL DIMENSIONS ON SITE REFER TO ARCHITECT'S DRAWING FOR ALL SETOUTS

NOTES :

Refer drawing 0002 for standard notes. Refer also to Structural Specification.

Invercargill City Council
Building Consent Authority
Approved Site Copy

Approved For Issue
27/02/2020

2	25.10.19	CONSENT ISSUE	GPW
1	27.09.19	PEER REVIEW ISSUE	GPW
REV	DATE	AMENDMENT	BY

CLIENT:

HWCP



lewis bradford
CONSULTING ENGINEERS

PROJECT:

INVERCARGILL CENTRAL
ZONE 1 ANCHOR

DRAWING TITLE:

DRAWING INDEX

DRAWN:	GPW	SCALE:	
ENGINEER:	EL/TSS		at A1
CHECKED:	-		

118083-Z1-WD-ST 0001 REV. 2

GENERAL NOTES:

This drawing is to be read in conjunction with all relevant Engineers and Architects drawings and the Specification.

Refer Architects drawings for all set out dimensions, opening sizes, slab set downs, rebates, insitu nibs and upstands etc.

All discrepancies shall be referred to the Architect for resolution before proceeding work.

Refer hydraulic drawings for pipe penetrations required through foundations.

Foundation material shall be approved by the Engineer for safe bearing capacity before construction of any footings.

All reinforcing steel shall be manufactured by Pacific Steel Limited using the microalloy process and shall be Grade 500 E or Grade 300 E

Typical wall reinforcing:
HD12 at 400 crs. each way (unless stated otherwise), HD16 trimmers to all edges and openings.

All insitu interfaces and construction joints shall be thoroughly roughened to 5mm amplitude.

All precast to insitu interfaces and grouted joints shall be thoroughly roughened to 5mm amplitude.

Confirm all lift dimensions with lift manufacturers before commencing construction. Also confirm location of lift pit sumps.

Slab construction joints and saw cuts as shown or typically at 5000 each way. Discuss and agree setout of construction joints and saw cuts well in advance of construction with Site Engineer. Refer Specification also.

Unless agreed in writing by the Engineer allow to water cure all floor slabs for at least 7 days by ponding or similar methods

All load bearing steelwork (including columns, beams, etc.) will require specific fire rating where noted on structural drawings. Refer also to Fire Engineer and/or Architect for requirements, details, and fire rating options.

General work sequences assume normal construction methods completed by competent tradesmen. The Contractor is strongly encouraged to pre-plan all phases of the construction process and discuss any specific areas that are non-standard or of concern well in advance with the design/site engineer.

INSITU CONCRETE NOTES:

Refer Architects drawings for all set out dimensions, opening sizes, slab set downs, rebates etc. Should there be any discrepancies between the architectural and engineering drawings advise the engineer.

All reinforcing steel shall be manufactured by Pacific Steel Limited using the microalloy process and shall be Grade 500E or Grade 300E.

All insitu interfaces and construction joints shall be thoroughly roughened to 5mm amplitude.

Refer hydraulic drawings for pipe penetrations required through foundations.

All reinforcing to be continuous around corners.


Bar annotations:
HD - denotes grade 500E
D - denotes grade 300E.

Refer to Specification for cover requirements to reinforcement.

Refer to Architect's drawings for details of cast-in fixings requirements to suit timber plate fixings to concrete work unless noted otherwise, typically M12 galvanised bolts at 800.

Refer specification for minimum concrete compressive strength for all insitu concrete work.

All horizontal foundation reinforcing must lap adequately at corners and junctions as indicated below:

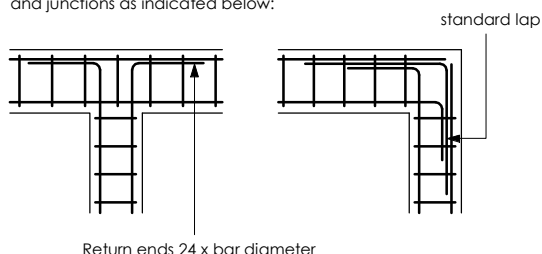

PRECAST PANEL NOTES:

Refer Architects drawings for all set out dimensions, opening sizes, slab set downs, rebates etc. Should there be any discrepancies between the architectural and engineering plans advise the engineer.

All reinforcing steel shall be manufactured by Pacific Steel Limited using the microalloy process and shall be Grade 500E or Grade 300E

Confirm all lift dimensions with lift manufacturers before commencing construction. Also confirm location of lift pit sumps.

Construction joints, where not shown on drawings, shall be located to the approval of the Engineer.

No penetrations, chases or embedments of pipes, other than those shown on the structural drawings shall be made in concrete members without the prior approval of the Engineer.

Unless shown otherwise all horizontal and vertical precast panel joints to be 15mm.

All insitu interfaces and construction joints shall be thoroughly roughened to 5mm amplitude.

All precast to insitu interfaces and grouted joints shall be thoroughly roughened to 5mm amplitude.

The lifting and transporting etc. of all panels is the responsibility of the Contractor, this includes the provision of strong backs as required (refer Specification).


The Contractor shall provide two hardcopies of the shop drawings for precast concrete work to the Engineer for approval 14 days prior to manufacture.

The Engineer shall be given a copy of the prestressed floor unit layout plan and design calculations for approval before any floor units are manufactured.

All precast beams to be propped during construction.

Unless noted otherwise provide 35 mm cover to horizontal bars (i.e. outer bars).

Typically horizontal bars in double reinforced panels are to be outside vertical reinforcing
35mm cover to outside bars typical

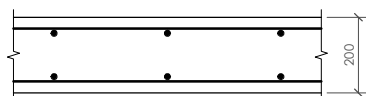

STEELWORK NOTES :

All structural steel shall comply with NZS 3404.

Refer Architect's drawings for details of drilled hole requirements to suit timber plate fixings to steel work members unless detailed otherwise.

Surface preparation and corrosion protection of steel work shall be in accordance with the Specification.

All exposed ends of RHS members to be capped with ex. 3mm ms plate unless shown otherwise.

All plates shall be 10mm minimum unless noted otherwise.

Unless shown otherwise, all welds are to be 6 fillet weld all round refer to the Specification for type and class of weld.

Mild steel flat anchors to weldplates to have minimum bend radius of 2.5 x thickness of flat and bent around a former pin.

All bolts and nuts shall be grade 8.8 high strength.

Oversized holes up to 1.33D may be provided for fixing structural steelwork to cast-in items (such as floor seating angle connections to cast-in Reid threaded inserts) if required for construction tolerance. All oversized holes must be accompanied with a flat square steel washer 6mm min. thick welded all around with 6 fwar min.

All holding down bolts and other fixing devices, shall have a minimum yield stress of 240 MPa unless noted otherwise.

All exterior steel work to be hot dip galvanised in accordance with AS/NZS 4680, unless noted otherwise. All cold formed purlins/girts exposed to the weather to have 450g/m2/ galvanising.

Exposed steel work members and brackets to be fire rated where noted on the structural drawings to Architects specification.

All load bearing steelwork (including columns, beams, etc.) will require specific fire rating where noted on structural drawings. Refer also to Fire Engineer and/or Architect for requirements, details, and fire rating options.

All dry pack mortar/grout shall have a compressive strength of at least 40 MPa unless noted otherwise.

The Contractor shall provide two hardcopies of the shop drawings for the structural steel work to the Engineer for approval, 14 days prior to manufacture.

REIDBRACE NOTES:


to reduce sag it is permissible to pre-tension unlubricated braces to a maximum of:
100Nm torque for RB16 bracing
250Nm torque for RB20 bracing
400Nm torque for RB25 bracing
750Nm torque for RB32 bracing

Install Reidbrace in strict accordance with Reid's details including site installation of safety clip, tension nut and spring and washers either side of cleats.


Provide plastic sleeves wired to brace where braces cross

Where splicing of bars is required use Reidbar couplers

All RB25 & RB32 Reidbar crossbracing to have ductile steel fuse plate elements to end bays of bracing.

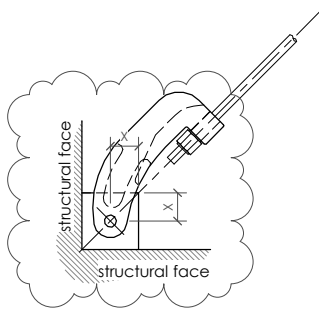

Refer detail below for modified brace and connection.

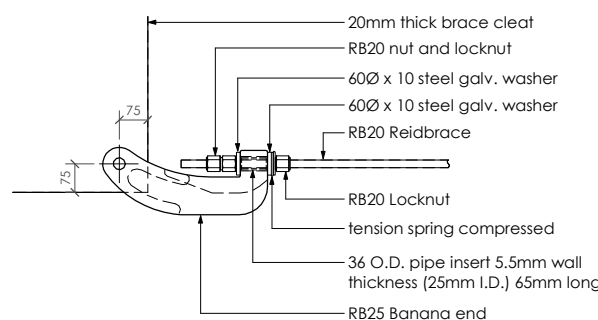

RB25 BANANA END CONVERSION TO RB20 ROOF BRACING

BUILDING CONSENT NUMBER

2019/1381

Refer Architects drawings for all set out dimensions, opening sizes, slab set downs, rebates, insitu nibs and upstands etc.

Confirm all lift dimensions with lift manufacturers before commencing construction. Also confirm location of lift pit sumps.

Concrete masonry blocks shall have a compressive strength of 25 MPa, density 1800 kg/m3/ and conform to AS/NZS 4455, unless noted otherwise.

Mortar shall comply with the requirements of NZS 4210, with compressive strength not less than 20 MPa.

All cores shall be grout filled (20 MPa) unless noted otherwise on the drawings.

In general, walls to be full height before grouting cores. Cleanout openings to be provided in the bottom course (1200mm crs. maximum). Before placing vertical reinforcement, cores are to be cleaned of all mortar fins and droppings through cleanout openings which are not to be closed until inspected by the Engineer. Grout to be rodded to ensure filling of cores with a maximum continuous pour height of 3600mm.

Control joints should be provided at 8000mm maximum crs. Where not shown on the drawings, the joints should be located to the approval of the Engineer.


Where masonry is to be constructed on suspended concrete without a corresponding wall under, the concrete must be fully depropped before commencement of this masonry.

Cutting chases in loadbearing masonry units is not permitted without prior approval of the Engineer.

Typical wall reinforcing:
HD12 at 400 crs. each way (unless stated otherwise), HD16 trimmers to all edges and openings.

DEFORMED GRADE 500E	
Bar size	Lap length concrete
HD10	600mm
HD12	700mm
HD16	800mm
HD20	1000mm
HD25	1250mm
HD32	1600mm

All horizontal foundation reinforcing must lap adequately at corners and junctions as indicated below.

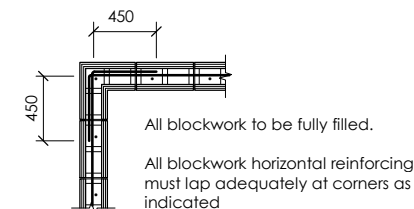

THIS DRAWING AND ALL INFORMATION CONTAINED WITHIN IS THE PROPERTY OF LEWIS BRADFORD. ITS CONTENTS ARE CONFIDENTIAL AND MUST NOT BE REPRODUCED OR DISTRIBUTED TO ANY OTHER PERSON OR COMPANY UNLESS AGREED TO IN WRITING BY LEWIS BRADFORD

CONTRACTOR TO VERIFY ALL DIMENSIONS ON SITE REFER TO ARCHITECT'S DRAWING FOR ALL SETOUTS

Invercargill City Council Building Consent Authority Approved Site Copy

Approved For Issue 27/02/2020

REV	DATE	AMENDMENT	BY
2	25.10.19	CONSENT ISSUE	GPW
1	27.09.19	PEER REVIEW ISSUE	GPW

CLIENT: **HWCP**

lewis bradford
CONSULTING ENGINEERS

PROJECT: **INVERCARGILL CENTRAL ZONE 1 ANCHOR**


DRAWING TITLE: **STANDARD NOTES**

DRAWN: GPW	SCALE: N . A
ENGINEER: EL/TSS	
CHECKED: -	
118083-Z1-WD-ST 0002	REV. 2

17 Dec 2019

Building Division

BUILDING CONSENT NUMBER
2019/1381

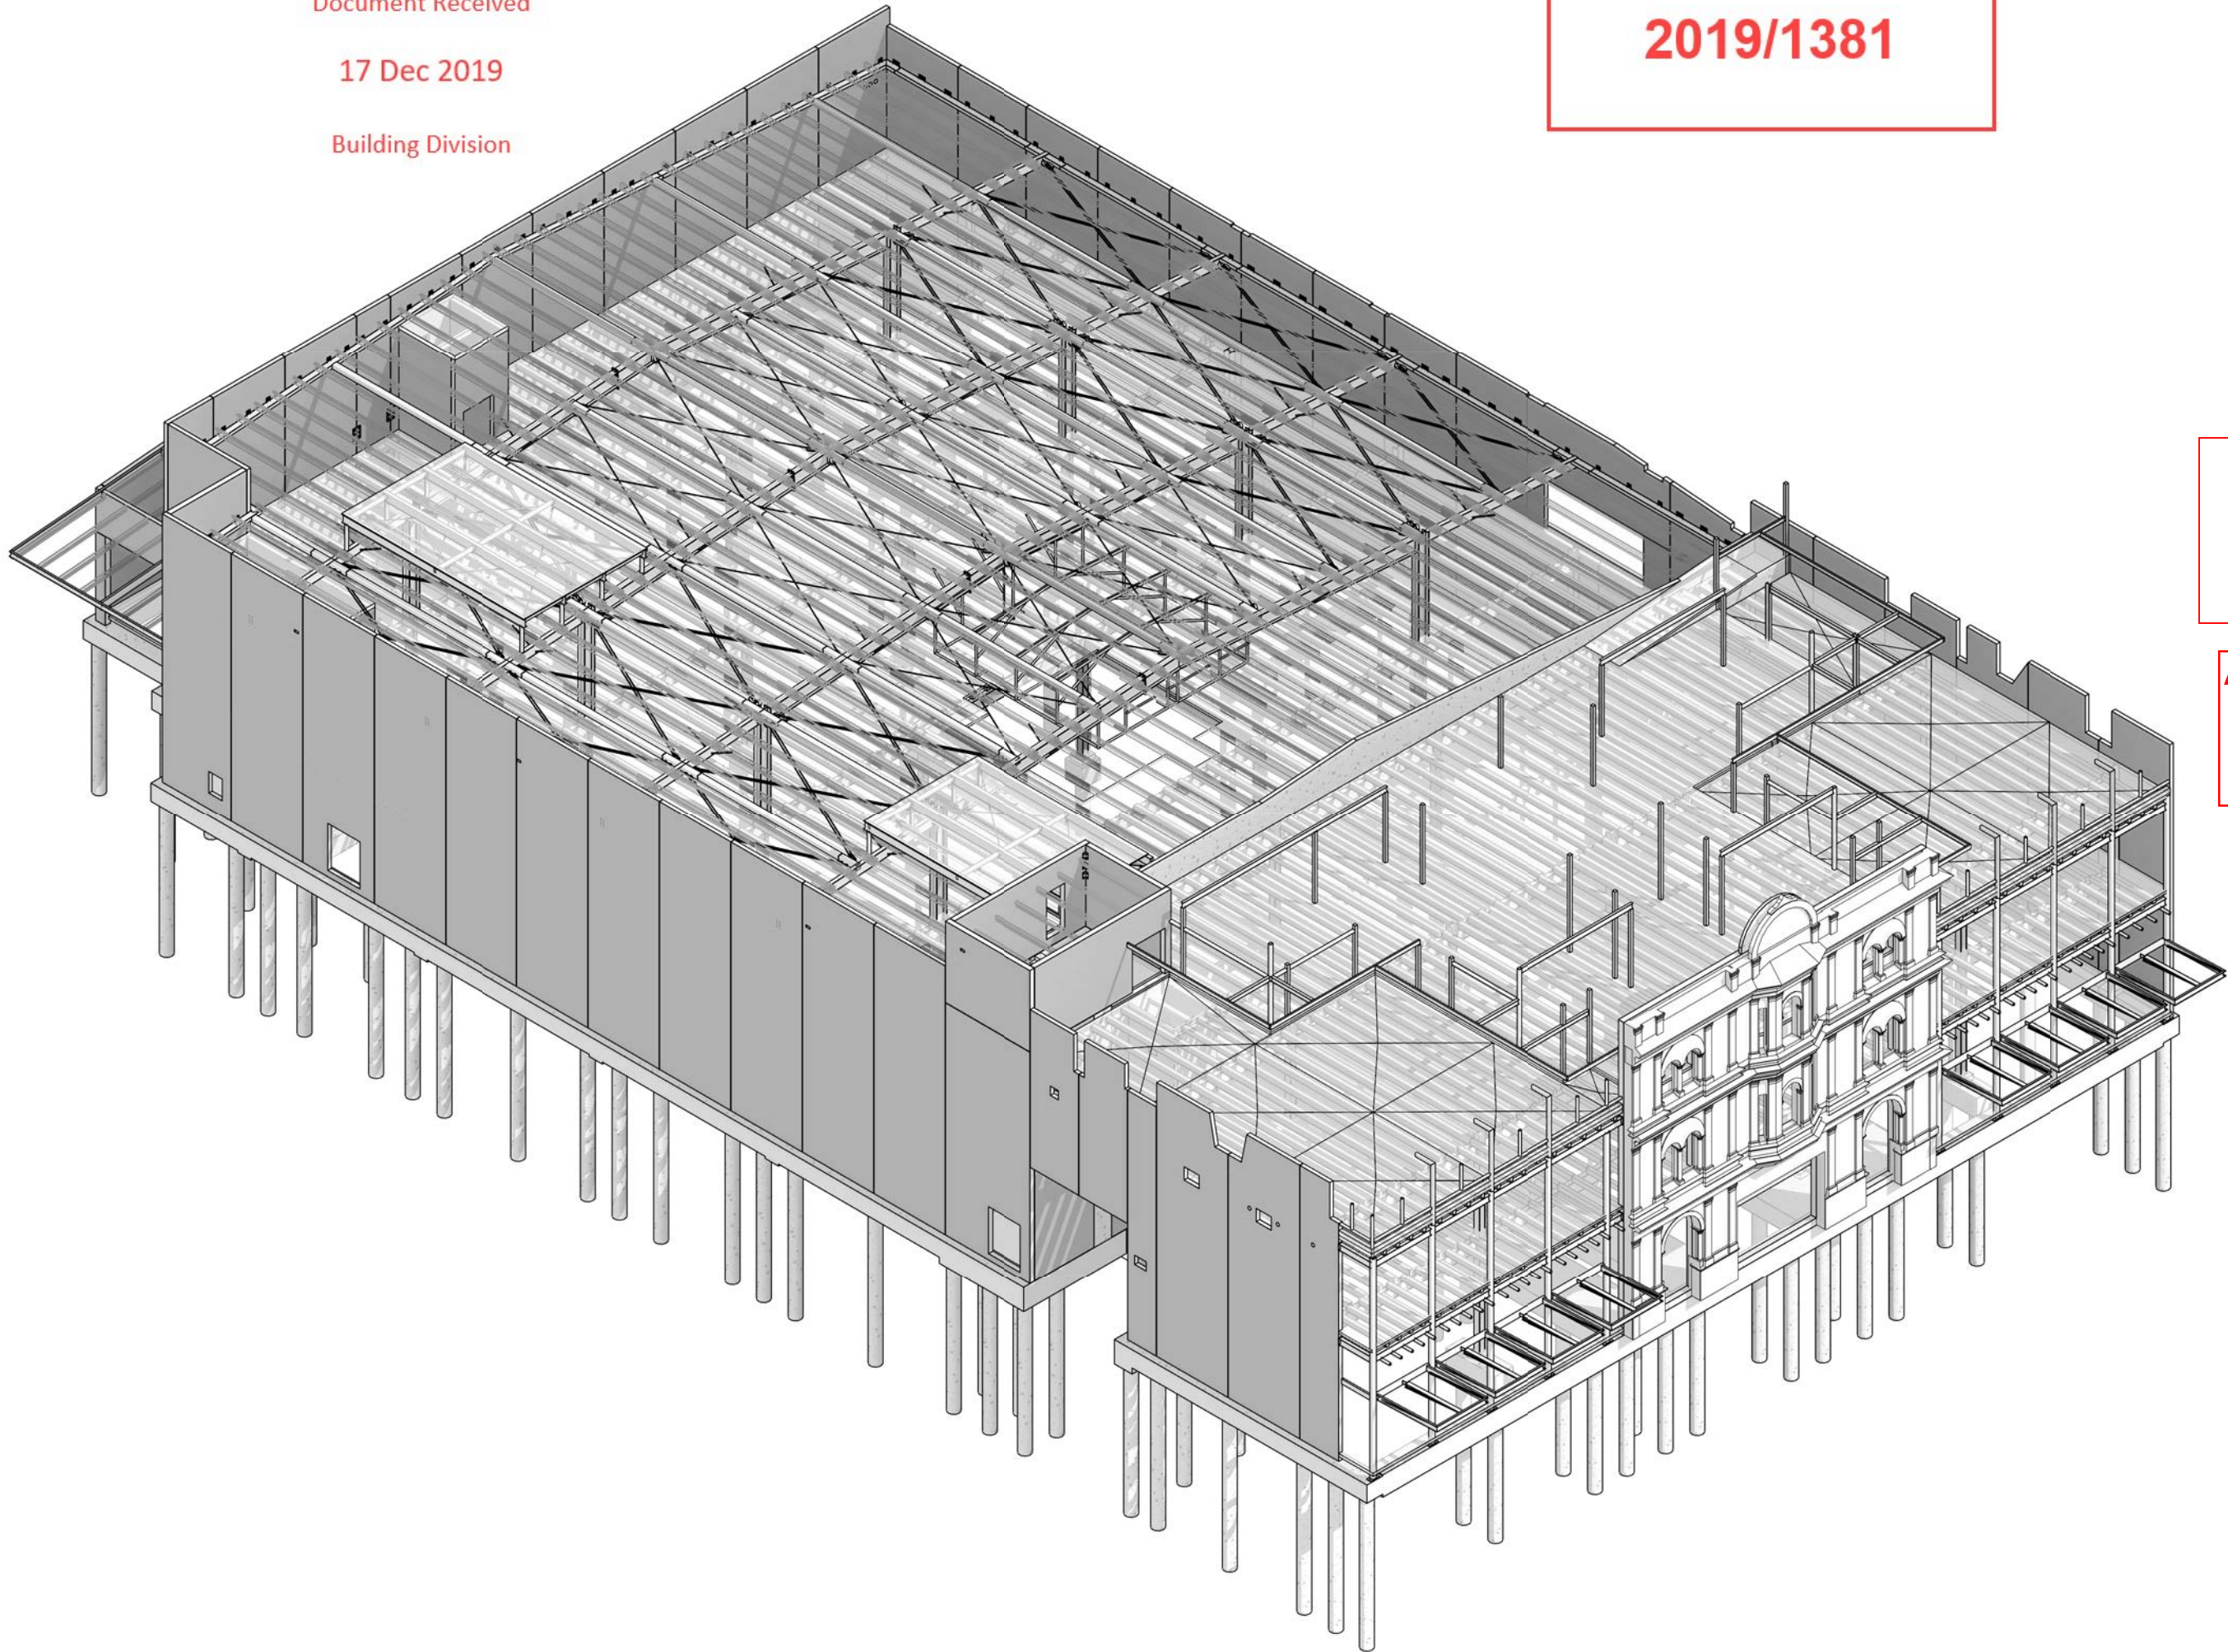

THIS DRAWING AND ALL INFORMATION CONTAINED WITHIN IS THE PROPERTY OF LEWIS BRADFORD. ITS CONTENTS ARE CONFIDENTIAL AND MUST NOT BE REPRODUCED OR DISTRIBUTED TO ANY OTHER PERSON OR COMPANY UNLESS AGREED TO IN WRITING BY LEWIS BRADFORD

CONTRACTOR TO VERIFY ALL DIMENSIONS ON SITE
REFER TO ARCHITECT'S DRAWING FOR ALL SETOUTS

NOTES :


Refer drawing 0002 for standard notes.
Refer also to Structural Specification.

Invercargill City
Council
Building Consent
Authority
Approved Site Copy

Approved For Issue
27/02/2020

2	25.10.19	CONSENT ISSUE	GPW
1	27.09.19	PEER REVIEW ISSUE	GPW
REV	DATE	AMENDMENT	BY

CLIENT:
HWCP

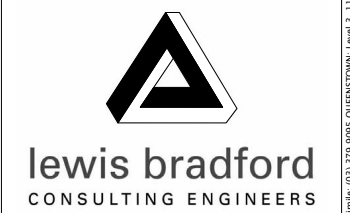

PROJECT:
**INVERCARGILL CENTRAL
ZONE 1 ANCHOR**

DRAWING TITLE:
OVERALL 3D VIEW

DRAWN: GPW	SCALE:
ENGINEER: EL/TSS	at A1
CHECKED: -	
118083-Z1-WD-ST 0003	REV. 2

17 Dec 2019

Building Division

BUILDING CONSENT NUMBER
2019/1381

THIS DRAWING AND ALL INFORMATION CONTAINED WITHIN IS THE PROPERTY OF LEWIS BRADFORD. ITS CONTENTS ARE CONFIDENTIAL AND MUST NOT BE REPRODUCED OR DISTRIBUTED TO ANY OTHER PERSON OR COMPANY UNLESS AGREED TO IN WRITING BY LEWIS BRADFORD


CONTRACTOR TO VERIFY ALL DIMENSIONS ON SITE REFER TO ARCHITECT'S DRAWING FOR ALL SETOUTS

NOTES :

Refer drawing 0002 for standard notes.
Refer also to Structural Specification.


**Invercargill City Council
Building Consent Authority
Approved Site Copy**

**Approved For Issue
27/02/2020**

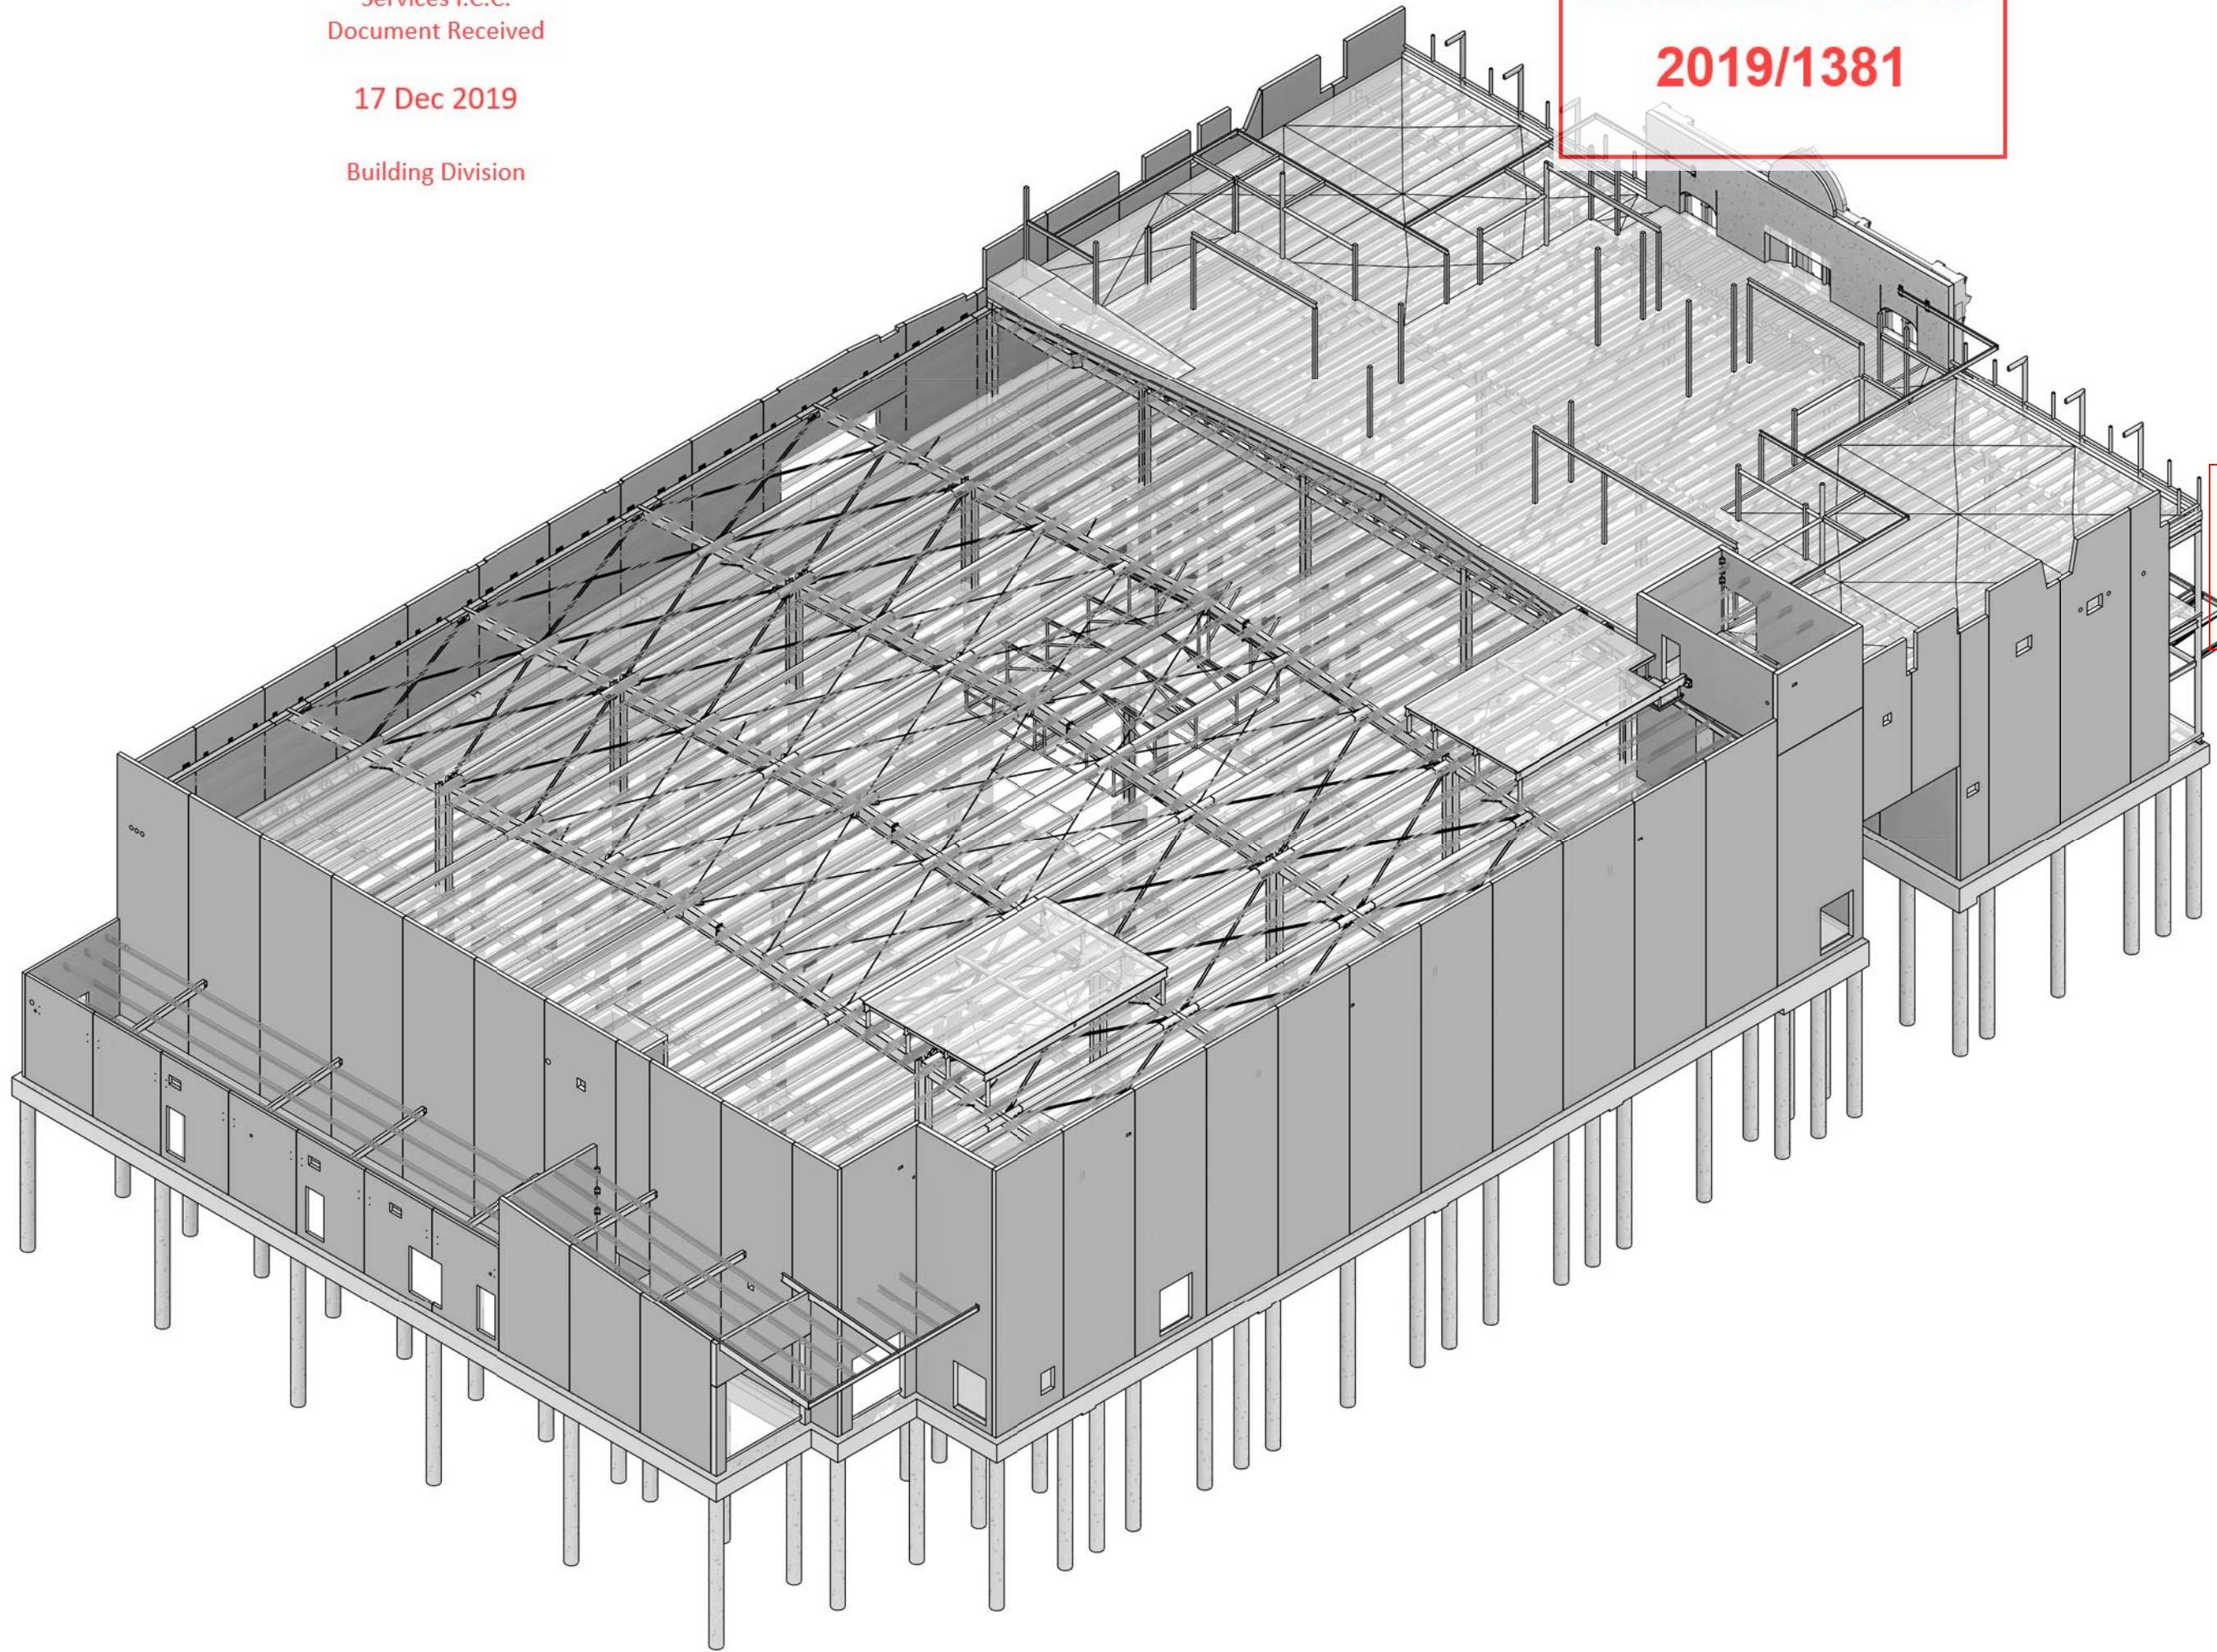

REV	DATE	AMENDMENT	BY
2	25.10.19	CONSENT ISSUE	GPW
1	27.09.19	PEER REVIEW ISSUE	GPW

CLIENT:
HWCP

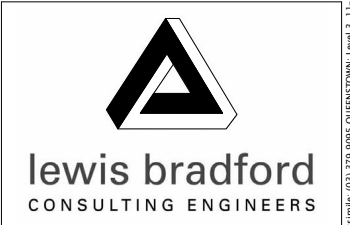

PROJECT:
**INVERCARGILL CENTRAL
ZONE 1 ANCHOR**


DRAWING TITLE:
OVERALL 3D VIEW

DRAWN: GPW	SCALE:
ENGINEER: EL/TSS	at A1
CHECKED: -	
118083-Z1-WD-ST 0004	REV. 2

17 Dec 2019

Building Division

BUILDING CONSENT NUMBER
2019/1381

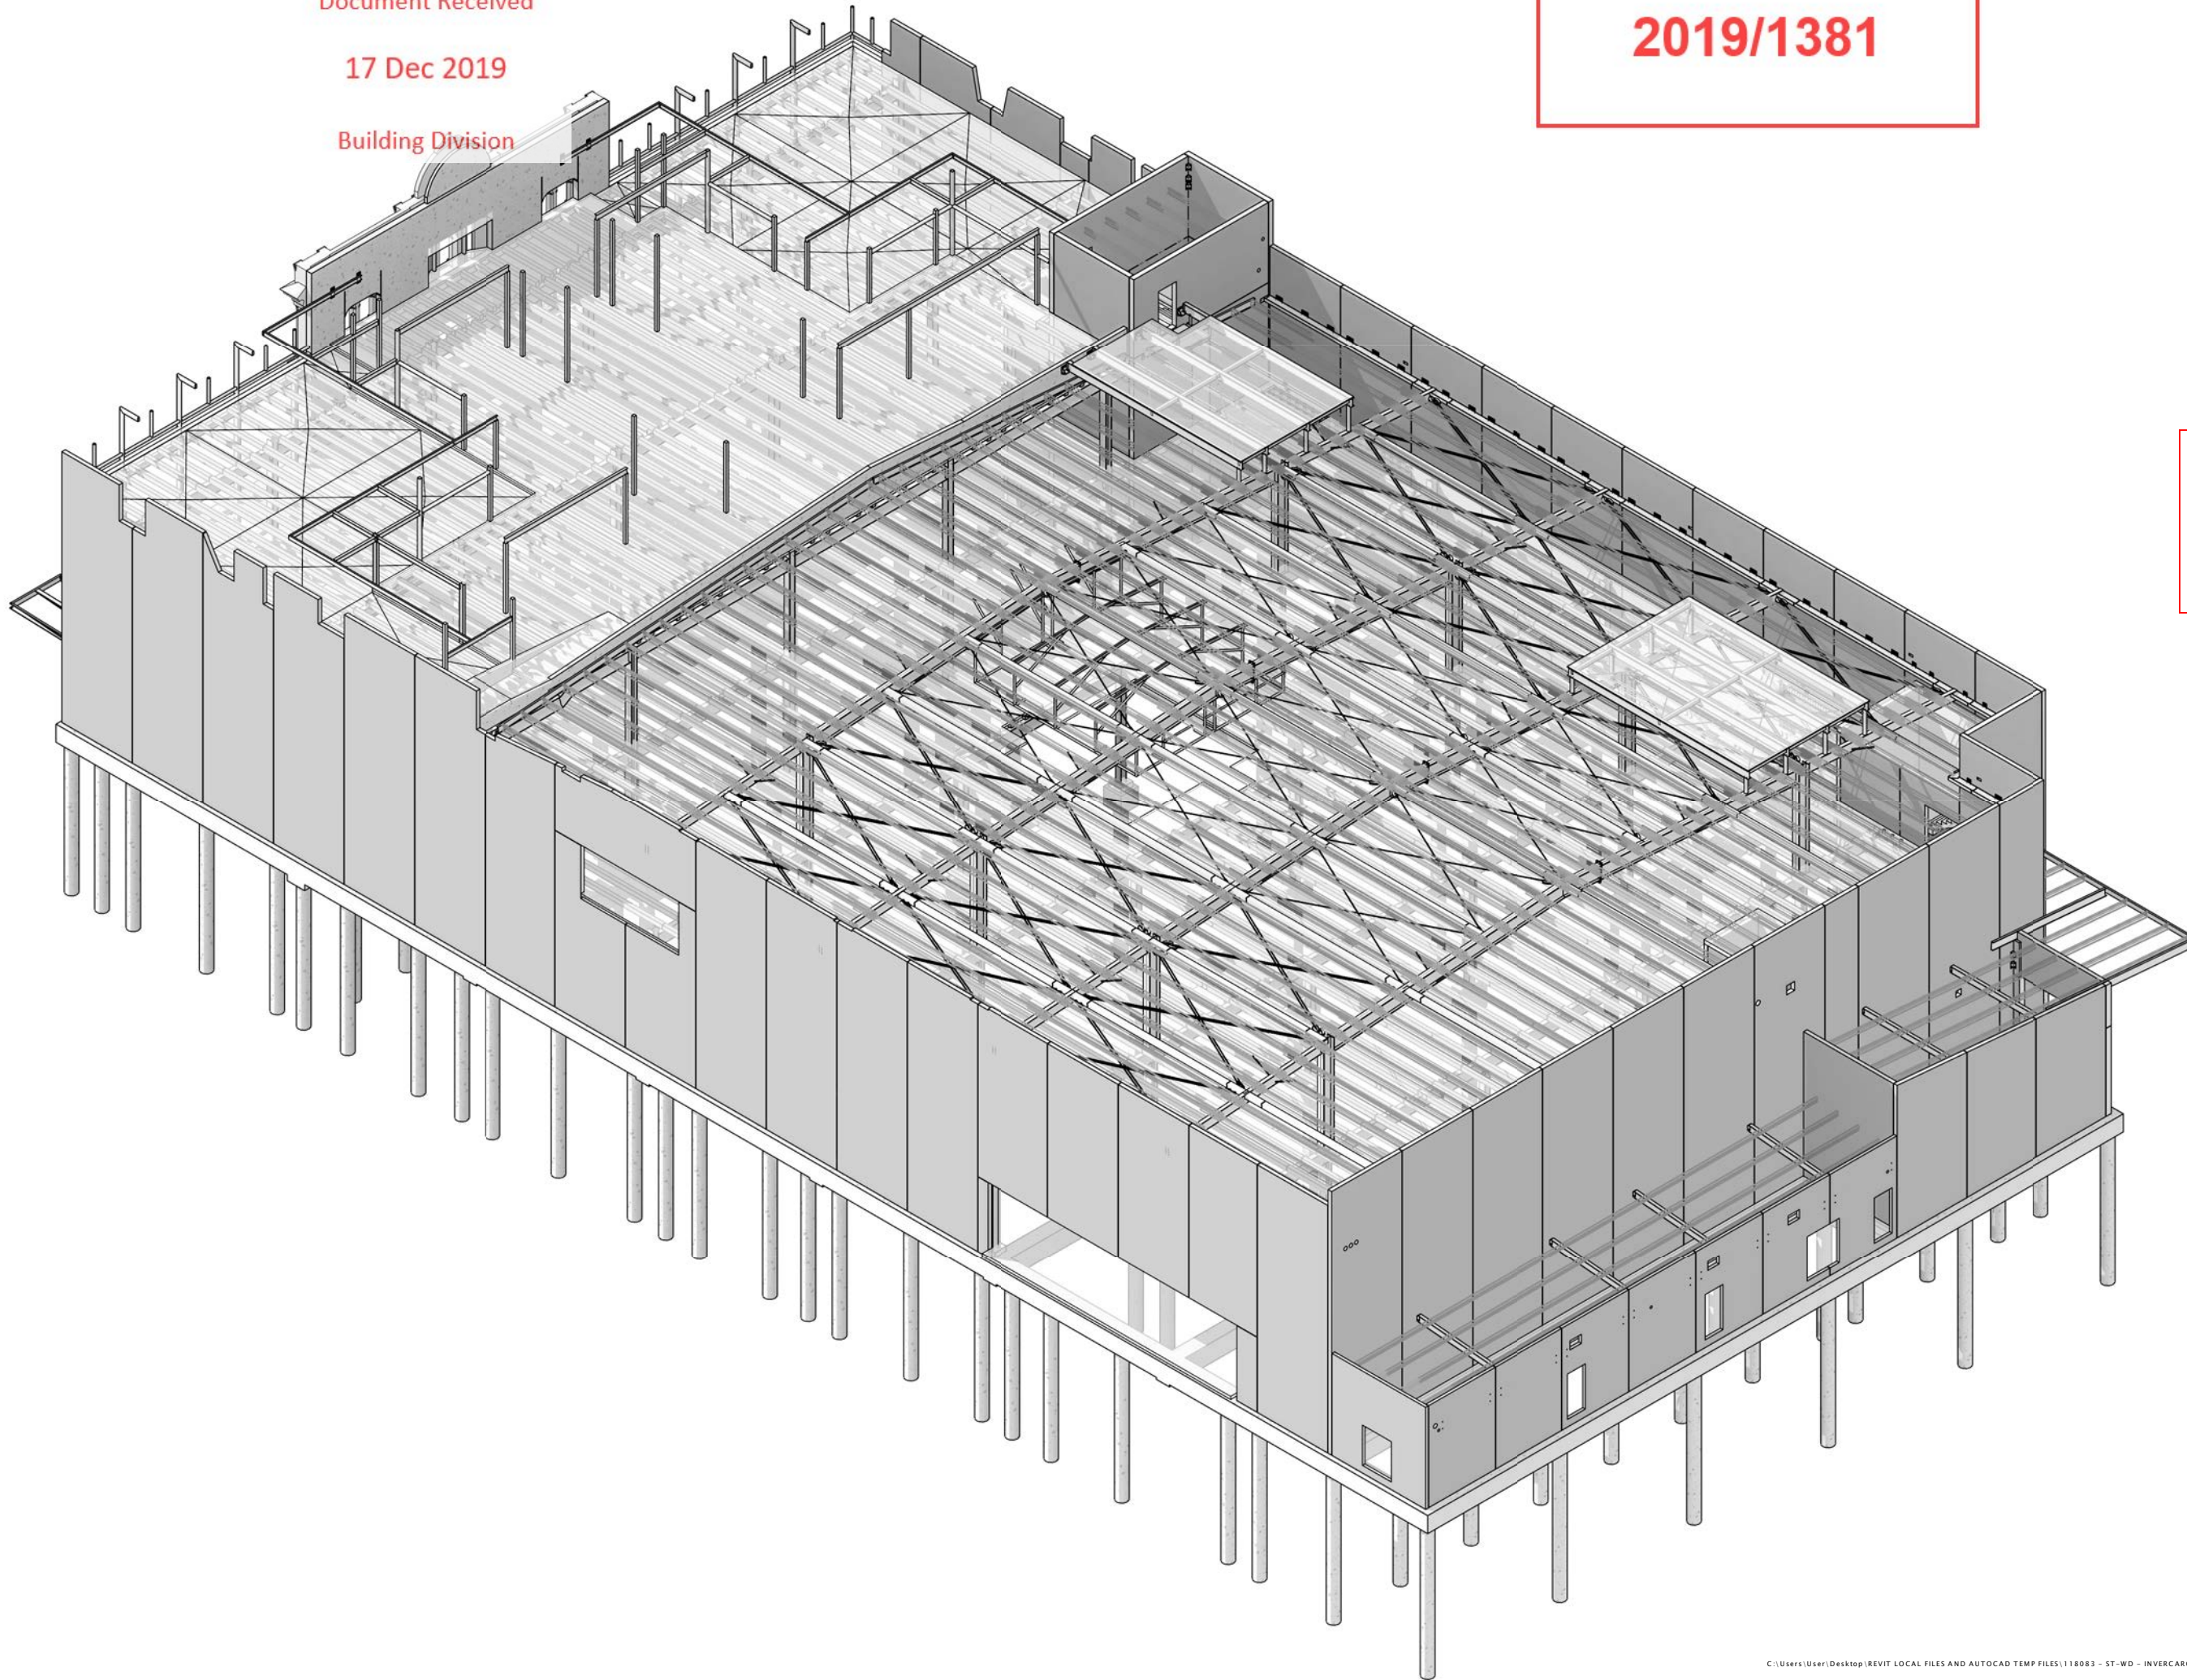

THIS DRAWING AND ALL INFORMATION CONTAINED WITHIN IS THE PROPERTY OF LEWIS BRADFORD. ITS CONTENTS ARE CONFIDENTIAL AND MUST NOT BE REPRODUCED OR DISTRIBUTED TO ANY OTHER PERSON OR COMPANY UNLESS AGREED TO IN WRITING BY LEWIS BRADFORD

CONTRACTOR TO VERIFY ALL DIMENSIONS ON SITE REFER TO ARCHITECT'S DRAWING FOR ALL SETOUTS

NOTES :


Refer drawing 0002 for standard notes.
Refer also to Structural Specification.

Invercargill City
Council
Building Consent
Authority
Approved Site Copy

Approved For Issue
27/02/2020

2	25.10.19	CONSENT ISSUE	GPW
1	27.09.19	PEER REVIEW ISSUE	GPW
REV	DATE	AMENDMENT	BY

CLIENT:
HWCP

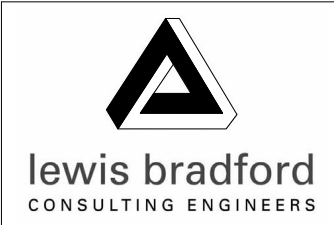

PROJECT:
**INVERCARGILL CENTRAL
ZONE 1 ANCHOR**

DRAWING TITLE:
OVERALL 3D VIEW

DRAWN: GPW	SCALE:
ENGINEER: EL/TSS	at A1
CHECKED: -	
118083-Z1-WD-ST 0005	REV. 2

17 Dec 2019

Building Division

BUILDING CONSENT NUMBER
2019/1381

THIS DRAWING AND ALL INFORMATION CONTAINED WITHIN IS THE PROPERTY OF LEWIS BRADFORD. ITS CONTENTS ARE CONFIDENTIAL AND MUST NOT BE REPRODUCED OR DISTRIBUTED TO ANY OTHER PERSON OR COMPANY UNLESS AGREED TO IN WRITING BY LEWIS BRADFORD


CONTRACTOR TO VERIFY ALL DIMENSIONS ON SITE REFER TO ARCHITECT'S DRAWING FOR ALL SETOUTS

NOTES :

Refer drawing 0002 for standard notes.
Refer also to Structural Specification.


**Invercargill City Council
Building Consent Authority
Approved Site Copy**

**Approved For Issue
27/02/2020**

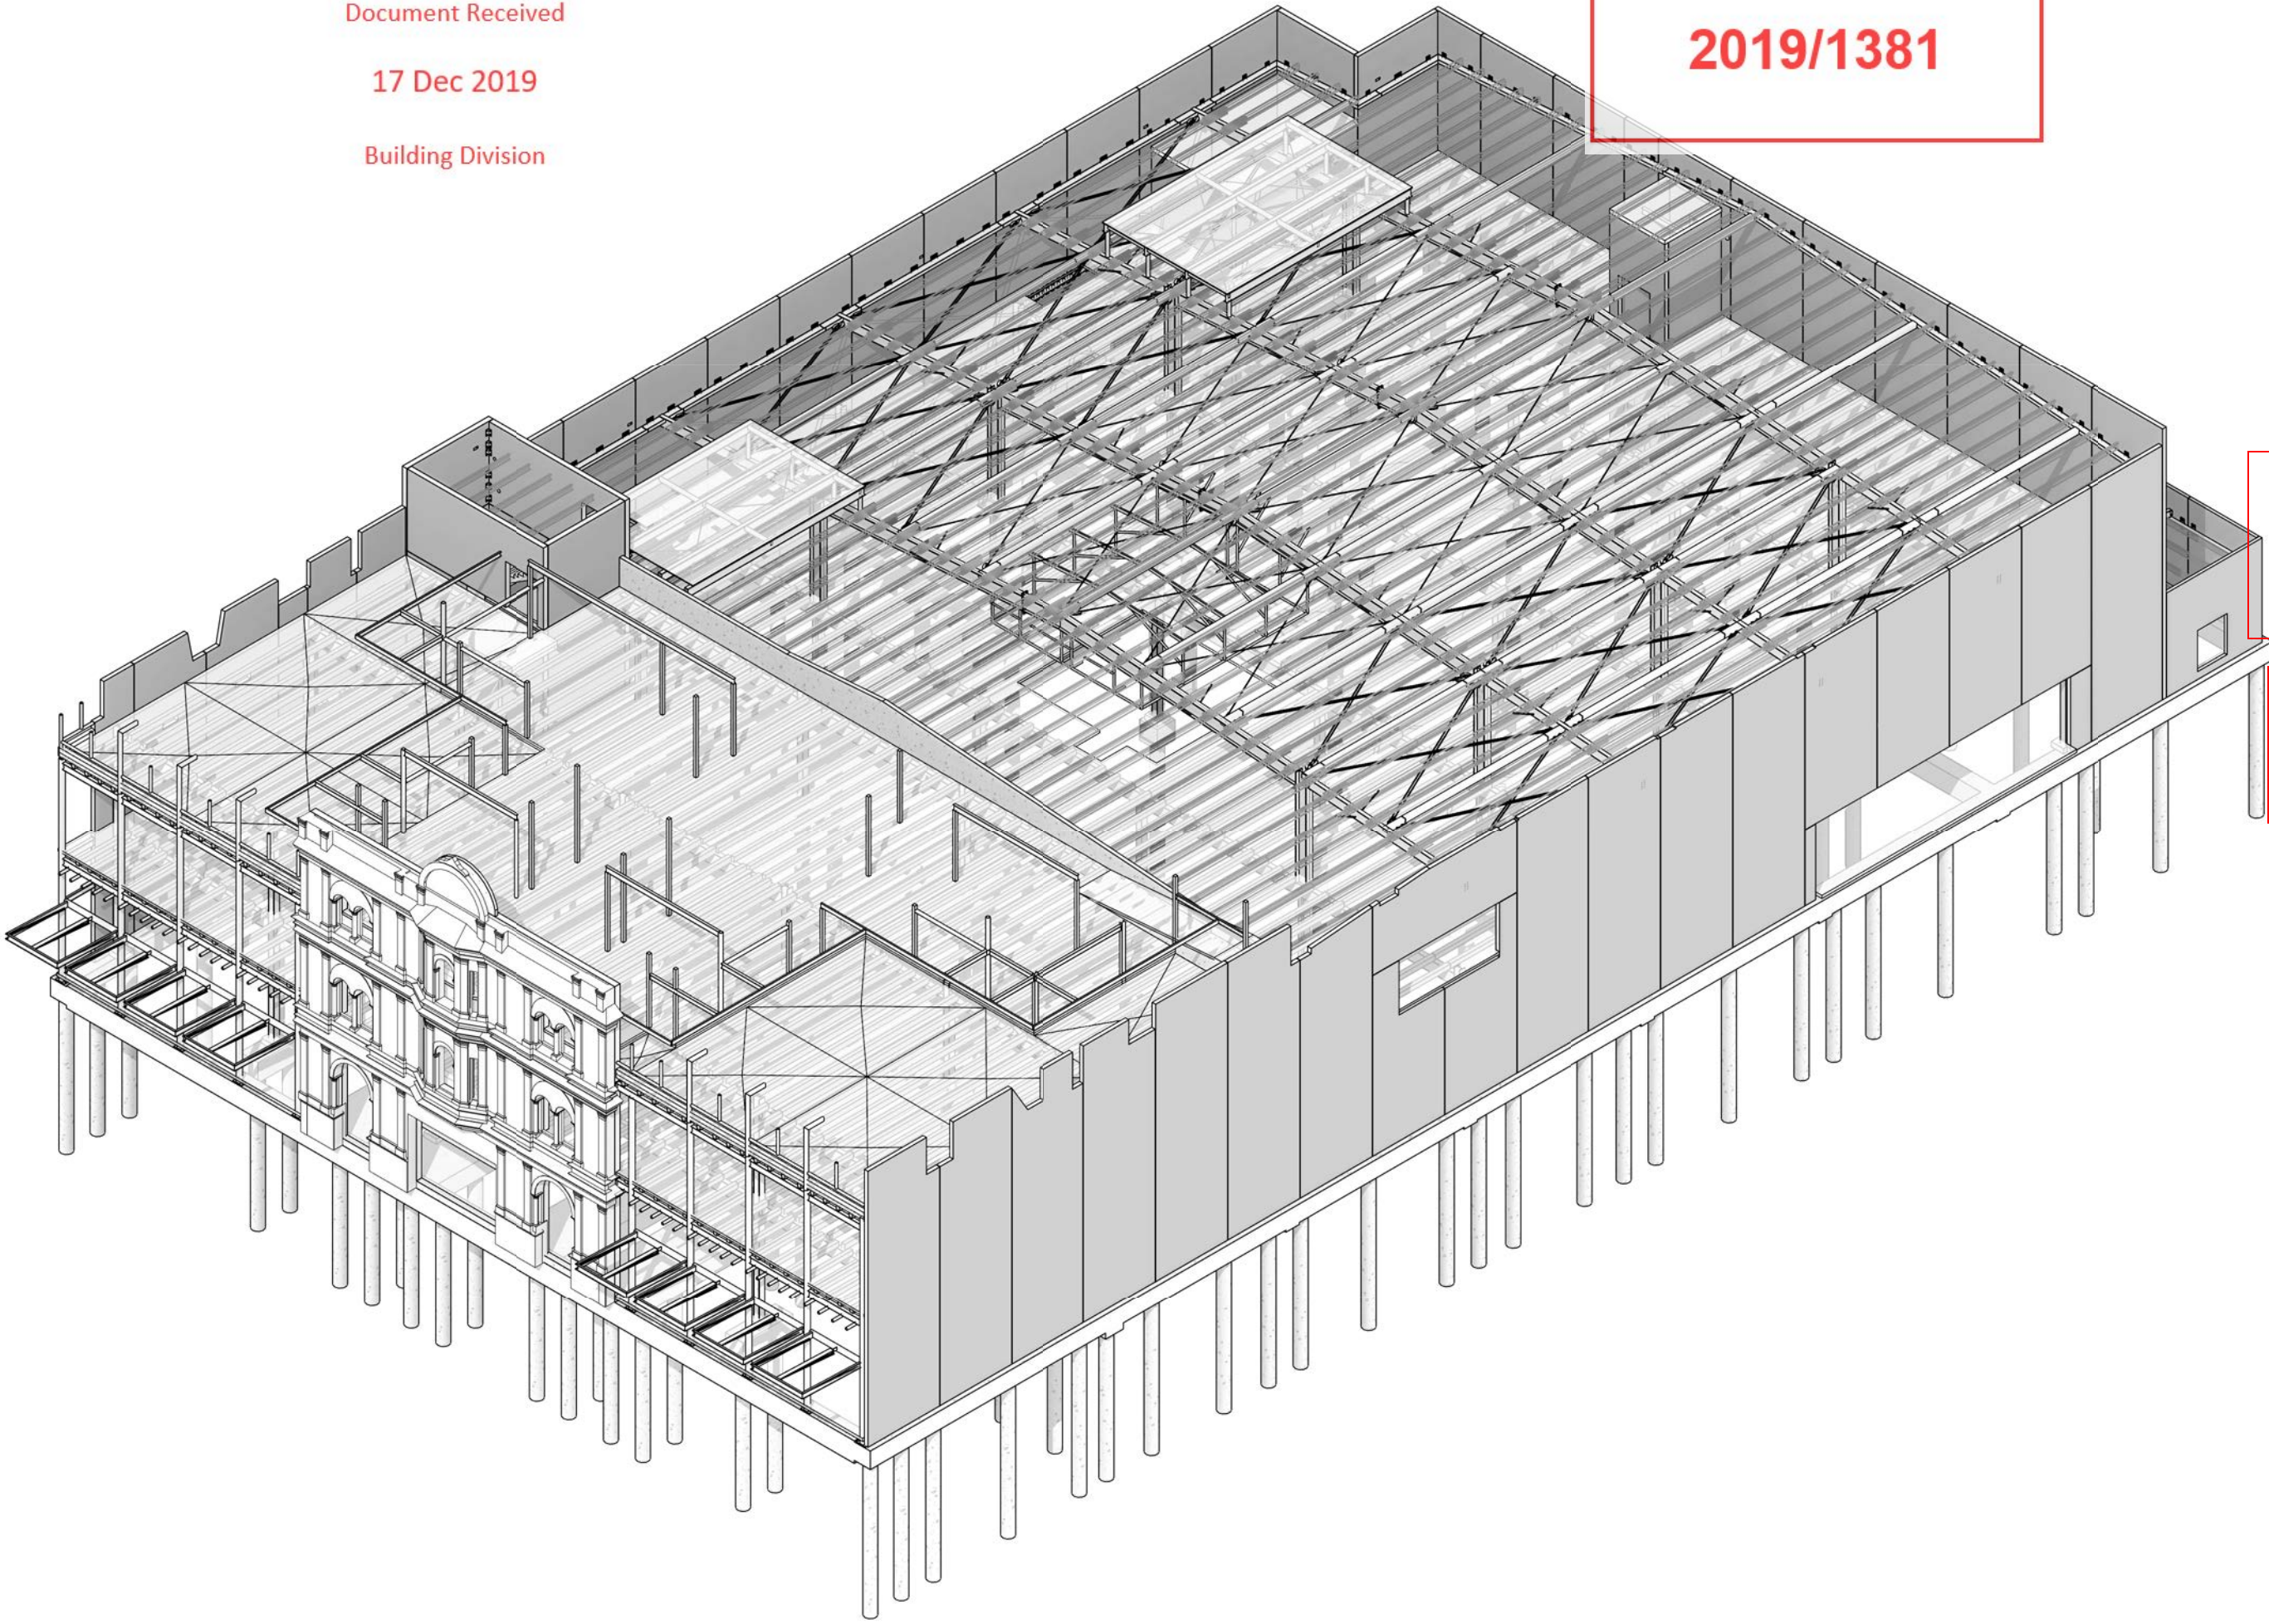

REV	DATE	AMENDMENT	BY
2	25.10.19	CONSENT ISSUE	GPW
1	27.09.19	PEER REVIEW ISSUE	GPW

CLIENT:
HWCP

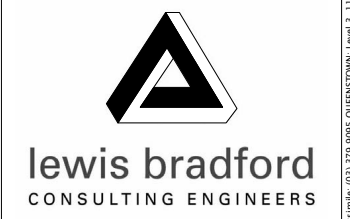

PROJECT:
**INVERCARGILL CENTRAL
ZONE 1 ANCHOR**

DRAWING TITLE:
OVERALL 3D VIEW

DRAWN: GPW	SCALE:
ENGINEER: EL/TSS	at A1
CHECKED: -	
118083-Z1-WD-ST 0006	REV. 2

17 Dec 2019

Building Division


BUILDING CONSENT NUMBER
2019/1381

THIS DRAWING AND ALL INFORMATION CONTAINED WITHIN IS THE PROPERTY OF LEWIS BRADFORD. ITS CONTENTS ARE CONFIDENTIAL AND MUST NOT BE REPRODUCED OR DISTRIBUTED TO ANY OTHER PERSON OR COMPANY UNLESS AGREED TO IN WRITING BY LEWIS BRADFORD

CONTRACTOR TO VERIFY ALL DIMENSIONS ON SITE
REFER TO ARCHITECT'S DRAWING FOR ALL SETOUTS

NOTES :

Refer drawing 0002 for standard notes.
Refer also to Structural Specification.

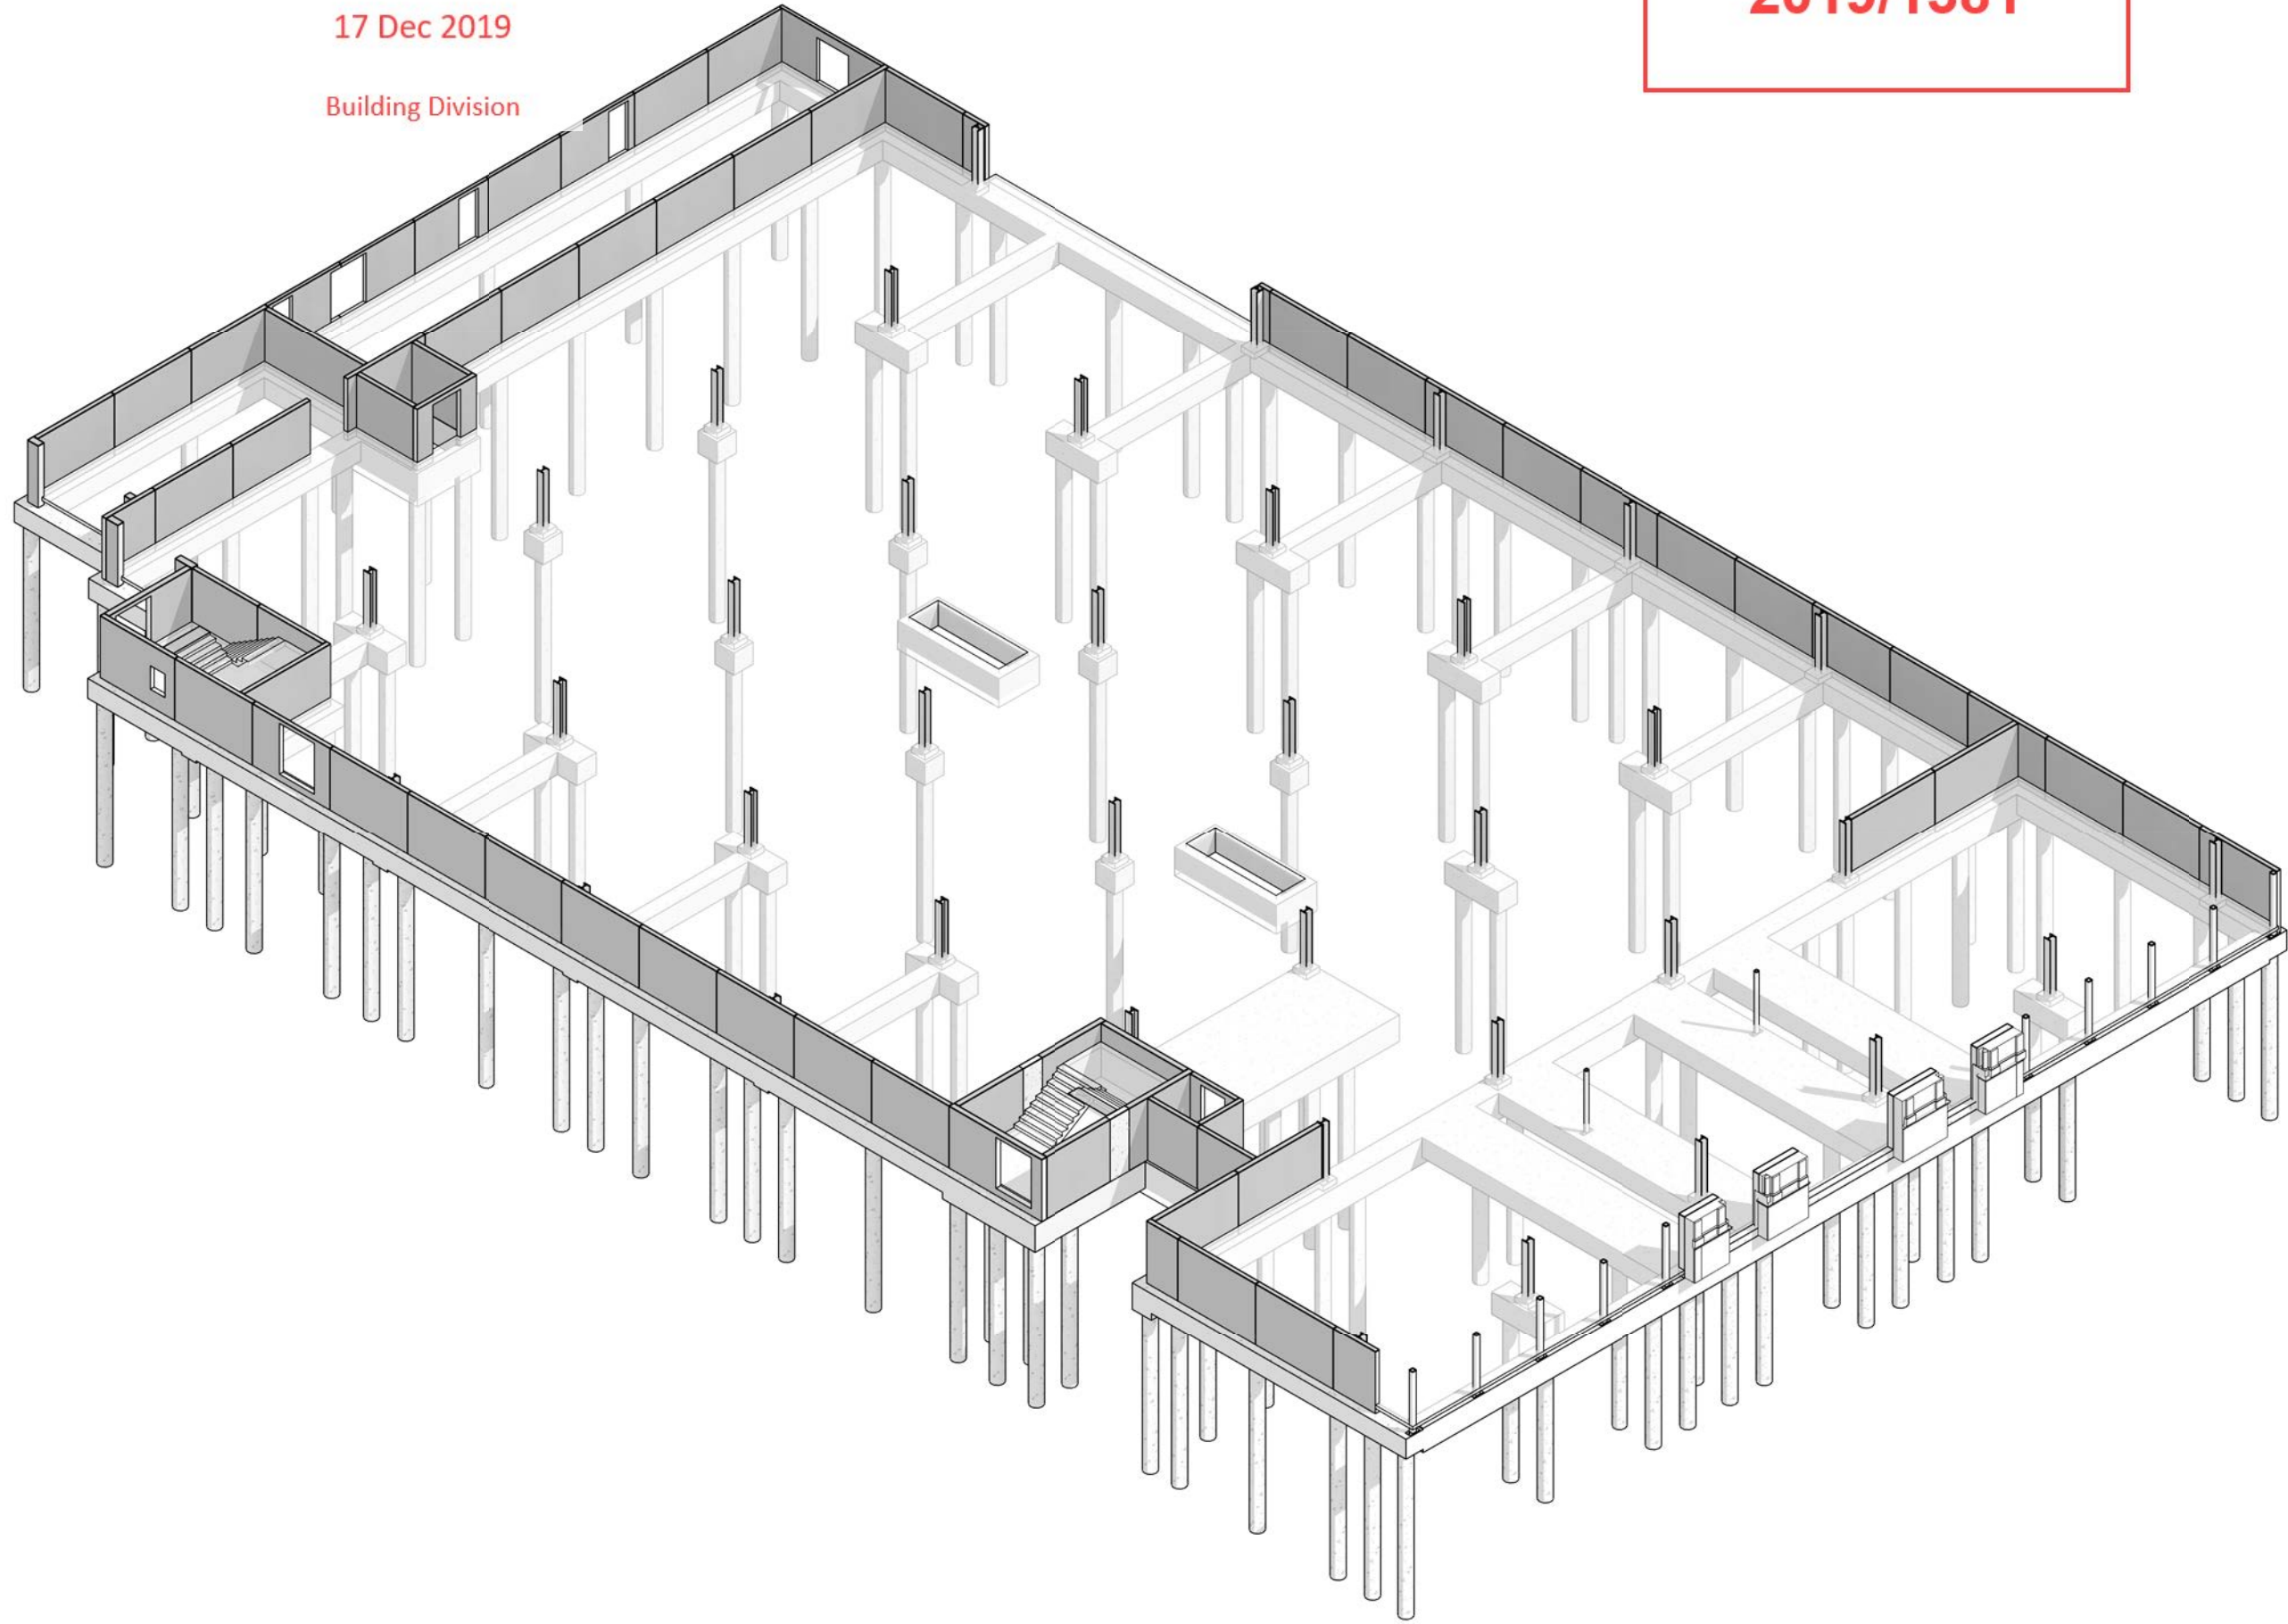


Invercargill City
Council
Building Consent
Authority
Approved Site Copy

Approved For Issue
27/02/2020

REV	DATE	AMENDMENT	BY
2	25.10.19	CONSENT ISSUE	GPW
1	27.09.19	PEER REVIEW ISSUE	GPW

CLIENT:
HWCP

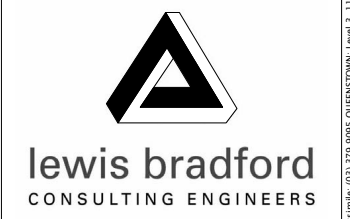

PROJECT:
**INVERCARGILL CENTRAL
ZONE 1 ANCHOR**

DRAWING TITLE:
**GROUND FLOOR
3D VIEW**

DRAWN: GPW	SCALE:
ENGINEER: EL/TSS	at A1
CHECKED: -	
118083-Z1-WD-ST 1100	REV. 2


BUILDING CONSENT NUMBER
2019/1381



THIS DRAWING AND ALL INFORMATION CONTAINED WITHIN IS THE PROPERTY OF LEWIS BRADFORD. ITS CONTENTS ARE CONFIDENTIAL AND MUST NOT BE REPRODUCED OR DISTRIBUTED TO ANY OTHER PERSON OR COMPANY UNLESS AGREED TO IN WRITING BY LEWIS BRADFORD

CONTRACTOR TO VERIFY ALL DIMENSIONS ON SITE REFER TO ARCHITECT'S DRAWING FOR ALL SETOUTS

NOTES :
 Refer drawing 0002 for standard notes.
 Refer also to Structural Specification.

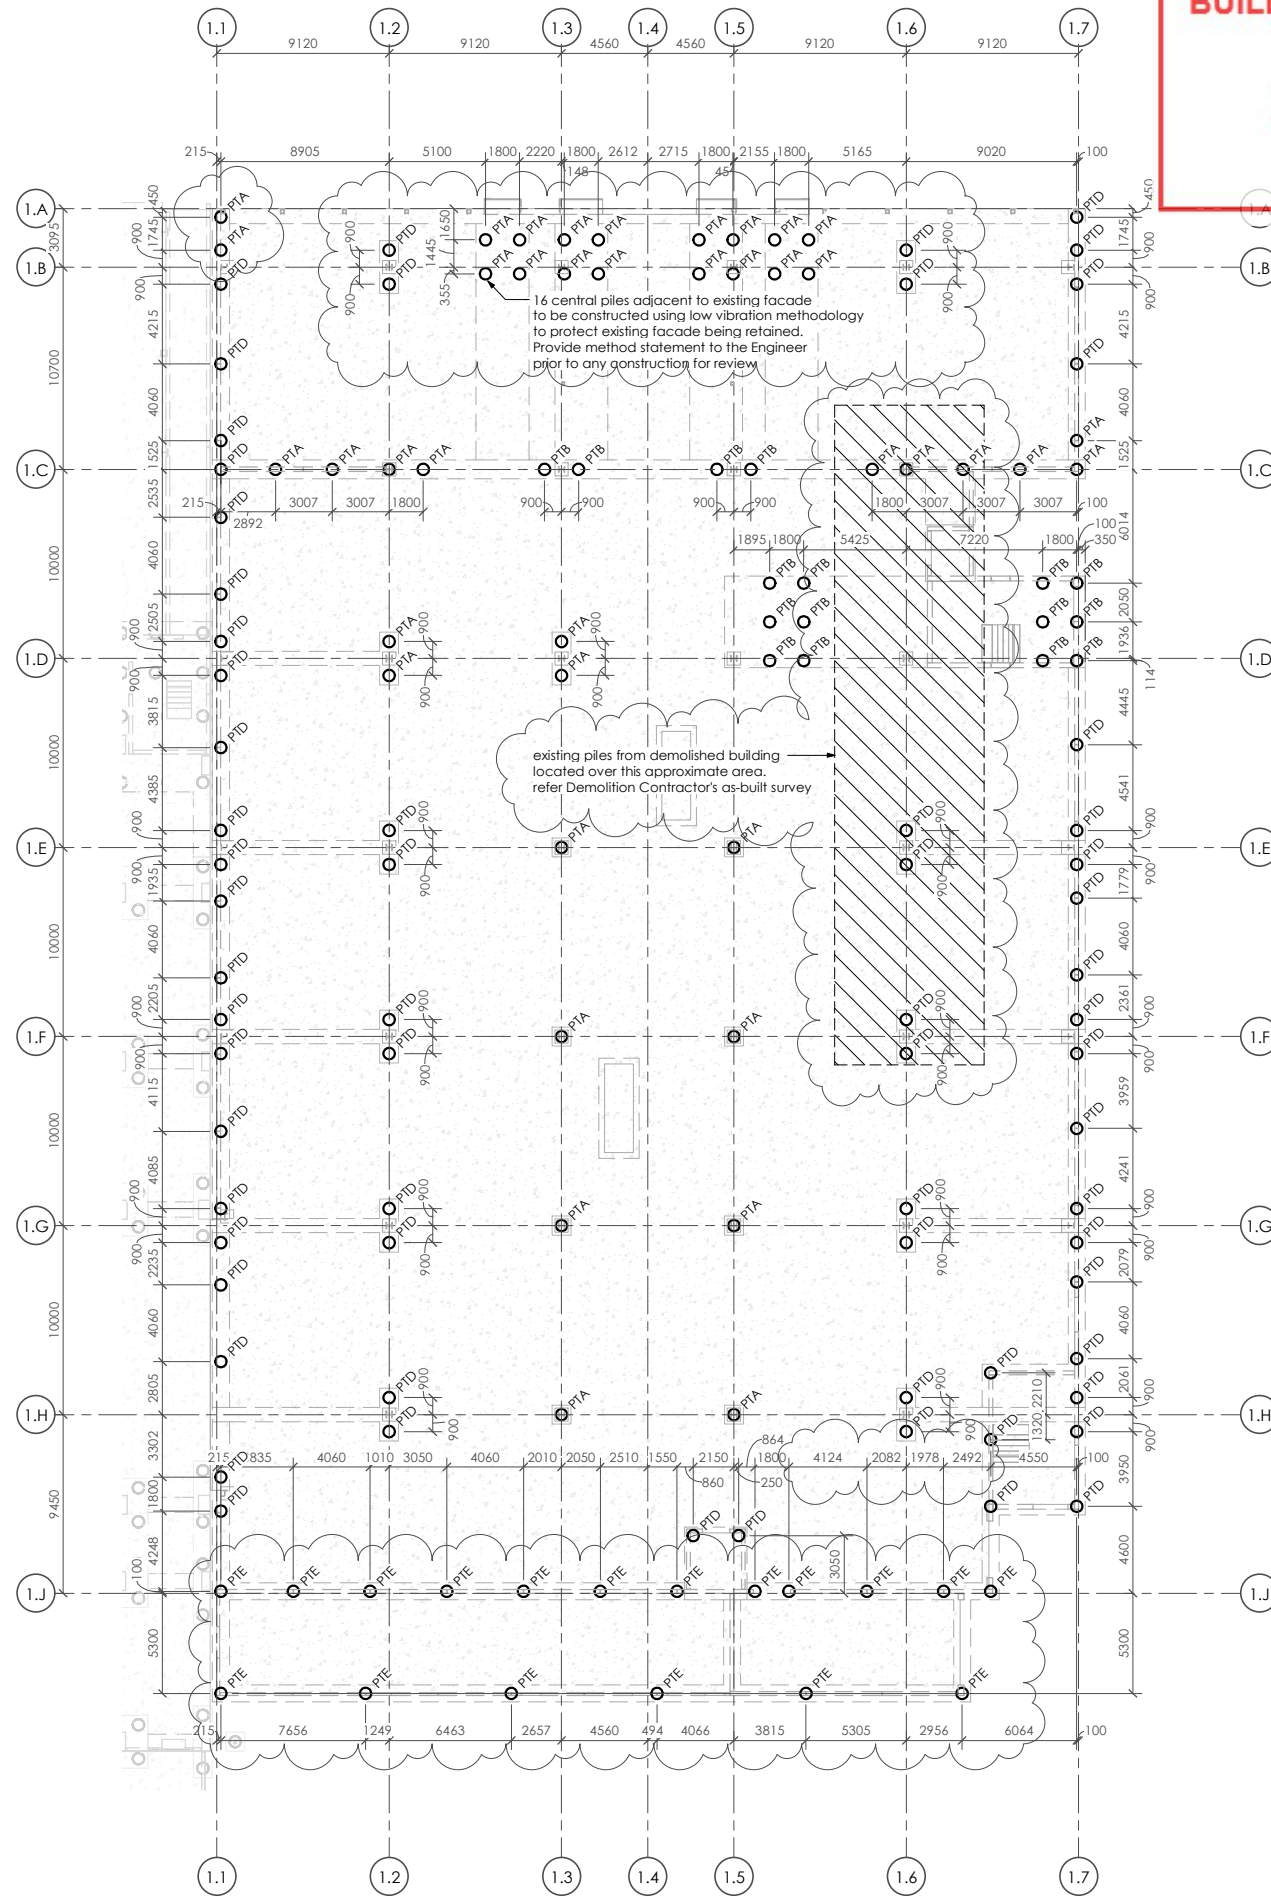


GROUND FLOOR - PILE PLAN
 1 : 200

Invercargill City Council
Building Consent Authority
Approved Site Copy

Approved For Issue
27/02/2020

REV	DATE	AMENDMENT	BY
2	23.10.19	CONSENT ISSUE	GPW
1	27.09.19	PEER REVIEW ISSUE	GPW

CLIENT:
HWCP

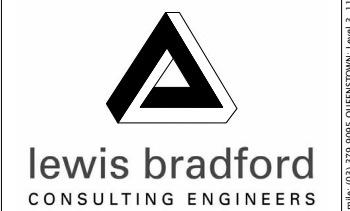

PROJECT:
INVERCARGILL CENTRAL ZONE 1 ANCHOR

DRAWING TITLE:
GROUND FLOOR PILE PLAN

DRAWN: GPW	SCALE: 1 : 200 at A1
ENGINEER: EL/TSS	
CHECKED: -	

118083-Z1-WD-ST 1101 REV. 2

17 Dec 2019

Building Division

BUILDING CONSENT NUMBER

2019/1381




THIS DRAWING AND ALL INFORMATION CONTAINED WITHIN IS THE PROPERTY OF LEWIS BRADFORD. ITS CONTENTS ARE CONFIDENTIAL AND MUST NOT BE REPRODUCED OR DISTRIBUTED TO ANY OTHER PERSON OR COMPANY UNLESS AGREED TO IN WRITING BY LEWIS BRADFORD

CONTRACTOR TO VERIFY ALL DIMENSIONS ON SITE REFER TO ARCHITECT'S DRAWING FOR ALL SETOUTS

NOTES :

Refer drawing 0002 for standard notes.
Refer also to Structural Specification.

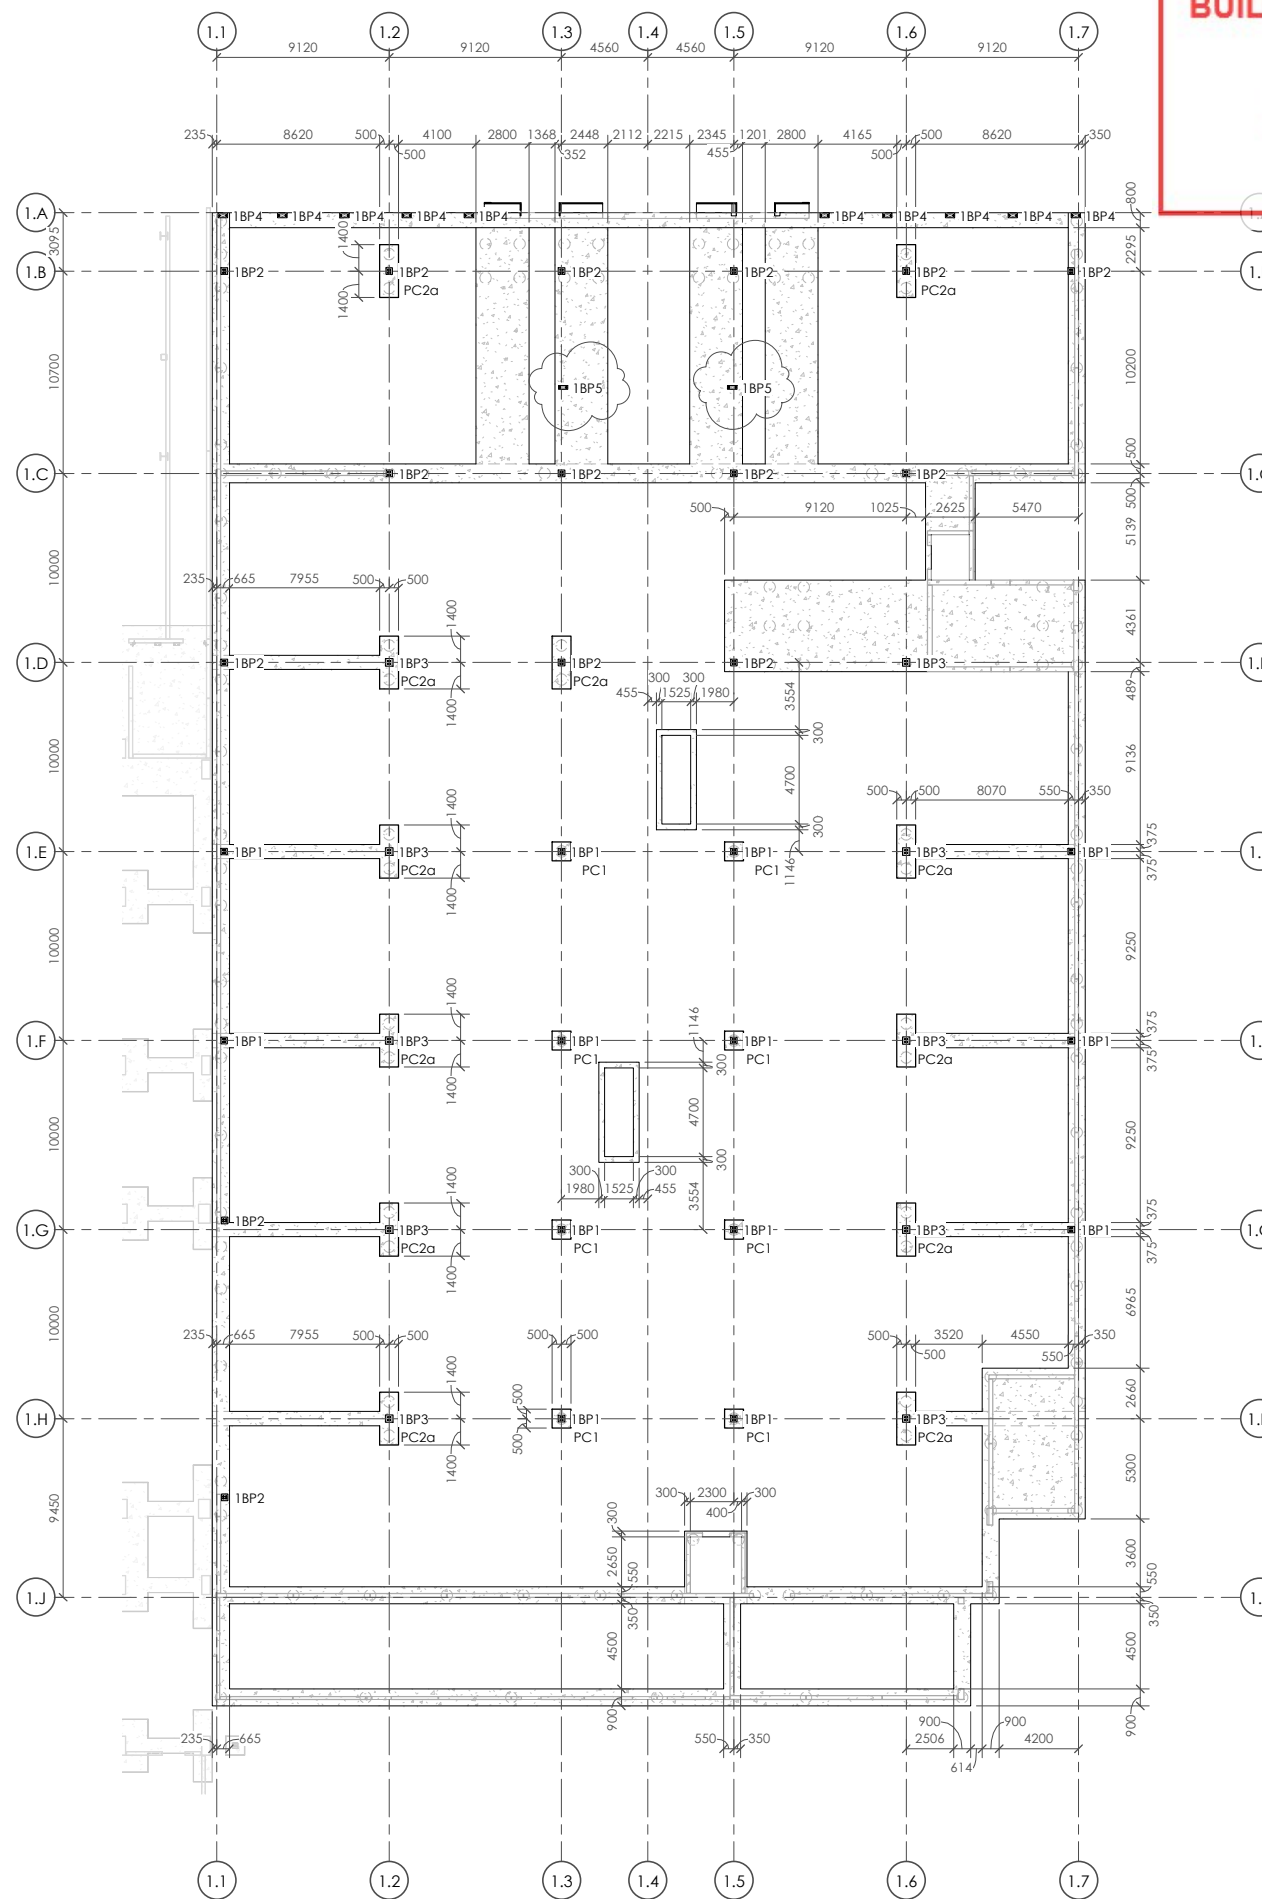

GROUND FLOOR - FOUNDATION PLAN

1 : 200

Invercargill City
Council
Building Consent
Authority
Approved Site Copy

Approved For Issue
27/02/2020

REV	DATE	AMENDMENT	BY
2	25.10.19	CONSENT ISSUE	GPW
1	27.09.19	PEER REVIEW ISSUE	GPW

CLIENT:

HWCP



lewis bradford
CONSULTING ENGINEERS

PROJECT:

**INVERCARGILL CENTRAL
ZONE 1 ANCHOR**

DRAWING TITLE:


**GROUND FLOOR
FOUNDATION PLAN**

DRAWN: GPW	SCALE:
ENGINEER: EL/TSS	1 : 200 at A1
CHECKED: -	

118083-Z1-WD-ST 1102

REV. 2

BUILDING CONSENT NUMBER
2019/1381

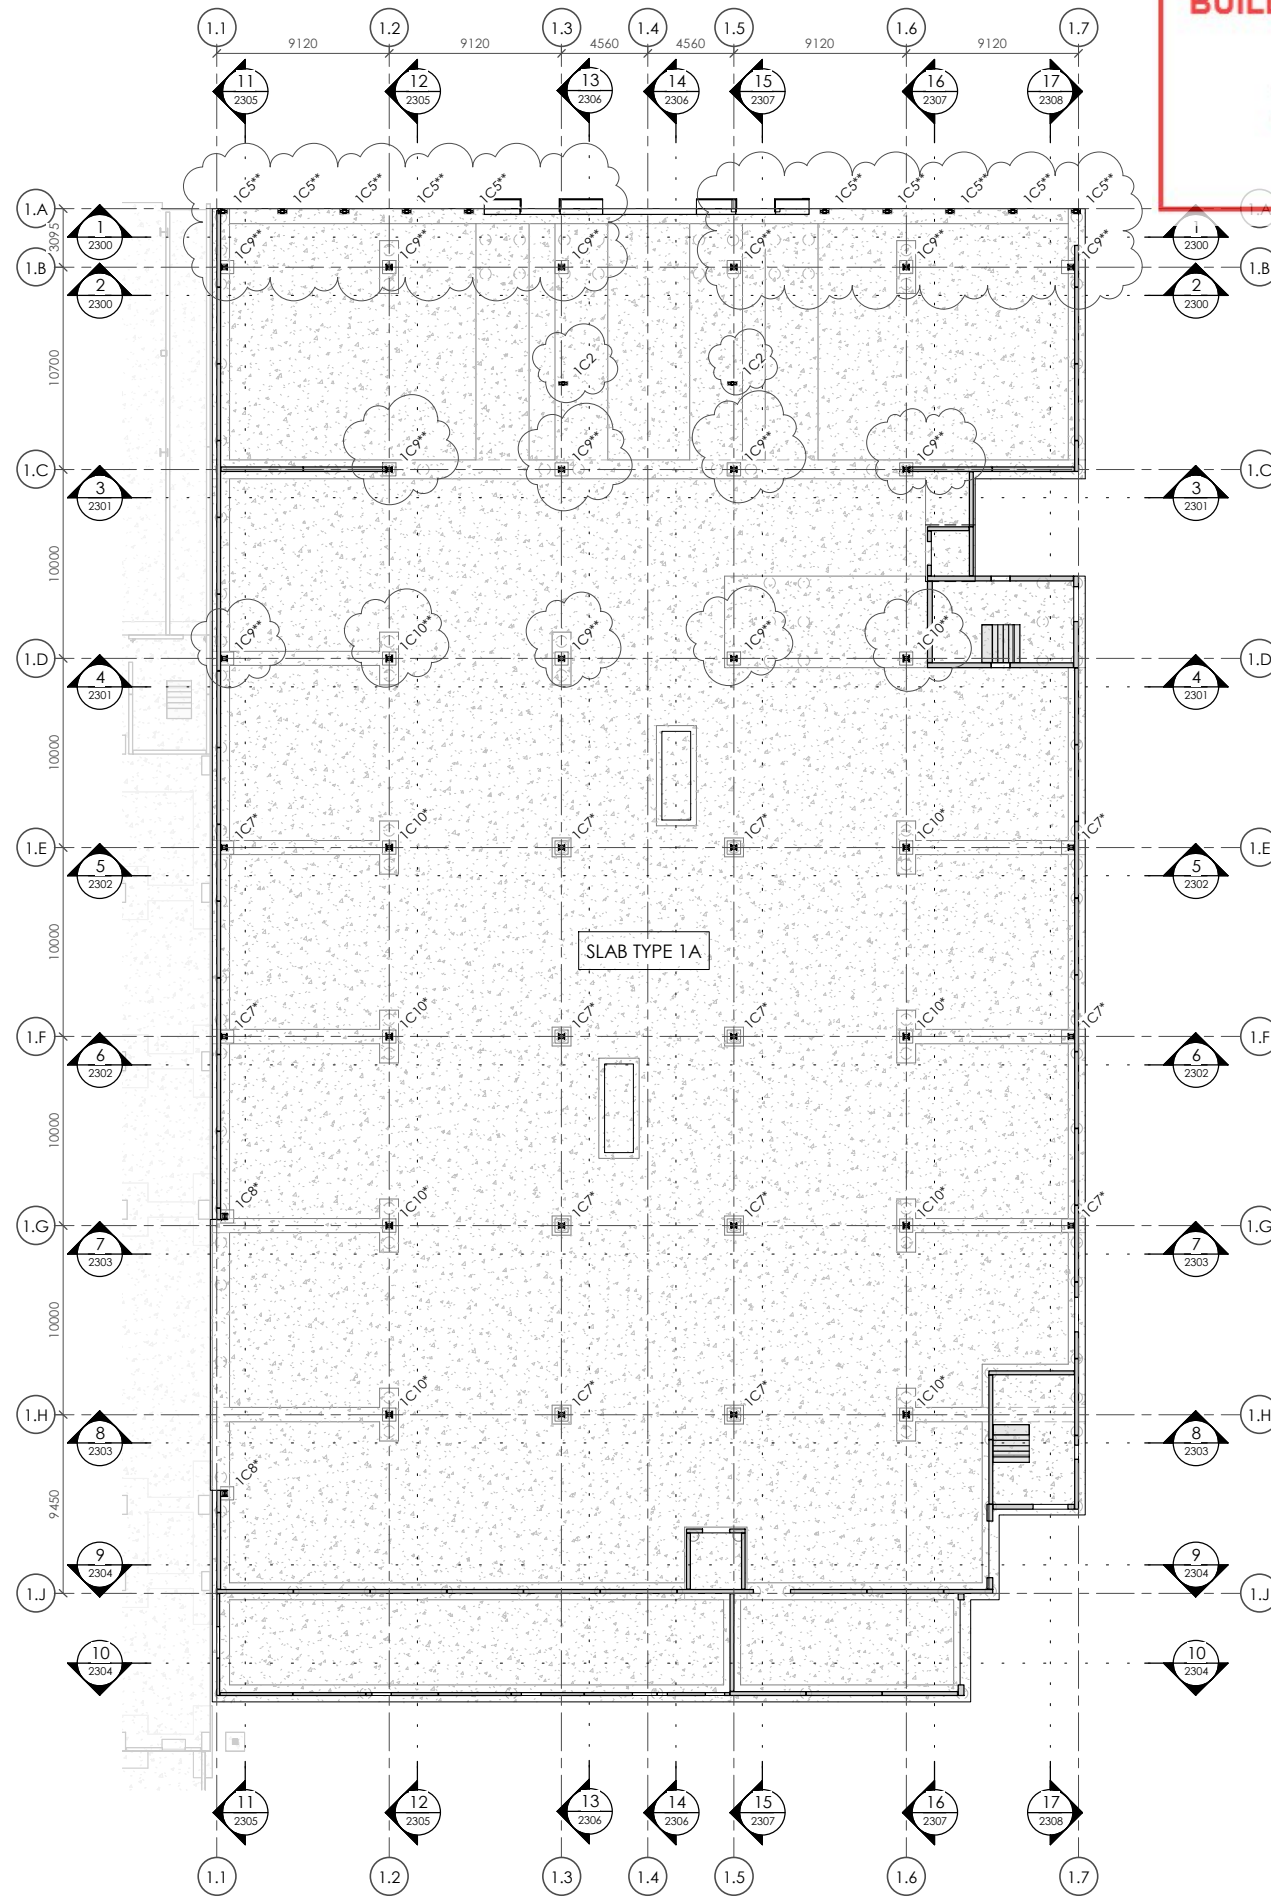

GROUND FLOOR - OVERALL PLAN
 1 : 200

THIS DRAWING AND ALL INFORMATION CONTAINED WITHIN IS THE PROPERTY OF LEWIS BRADFORD. ITS CONTENTS ARE CONFIDENTIAL AND MUST NOT BE REPRODUCED OR DISTRIBUTED TO ANY OTHER PERSON OR COMPANY UNLESS AGREED TO IN WRITING BY LEWIS BRADFORD

CONTRACTOR TO VERIFY ALL DIMENSIONS ON SITE REFER TO ARCHITECT'S DRAWING FOR ALL SETOUTS

NOTES :

Refer drawing 0002 for standard notes. Refer also to Structural Specification.

COLUMN LEGEND

IC1	100 x 6 SHS
IC2	150 x 9 SHS
IC3	150 x 100 x 5 RHS
IC4	200 x 100 x 9 RHS
IC5*	200 x 9 SHS**
IC6	200 UB 30
IC7*	310 UC 118*
IC7**	310 UC 118**
IC8*	310 UC 137*
IC8**	310 UC 158**
IC9**	310 UC 158**
IC10*	350 WC 197*
IC10**	350 WC 197**
IC11	600 WB 197
IC12	140 x 140 GLB post

* indicates steel member to have 30 minutes fire rated paint protection (limiting temperature 550°C)
 ** indicates steel member to have 60 minutes fire rated paint protection (limiting temperature 550°C)
 *** indicates steel member to have 120 minutes fire rated paint protection (limiting temperature 550°C)
 Where unprotected areas of steelwork meet fire protected elements overlap the fire protection onto the adjoining 500mm of 'unprotected' structural steel

FLOOR LEGEND

FLY	90 thick insitu topsoil in 25 timber infills
TYPE 1	300 Interspan ribs to hatched areas reinforced with HD10 @ 110 c/s. e.w. with 30 top and 20 bottom trimmer bars to all edges, corners and openings.
FLOOR	80-165 thick insitu topping on 25 timber infills @ 250 interspan ribs at 900 max. c/s. reinforced with HD10 @ 200 c/s. e.w. with 30 top and 20 bottom trimmer bars to all edges, corners and openings. refer plans for additional reinforcing.
TYPE 12	150 thick insitu concrete slab reinforced with S82 @ 150 mm top cover on min. compacted hardfill. HD12 trimmer bars to all edges, corners and openings. refer plans for additional reinforcing.
SLAB	150 thick insitu concrete slab reinforced with S82 @ 150 mm top cover on min. compacted hardfill. HD12 trimmer bars to all edges, corners and openings. refer plans for additional reinforcing.

Invercargill City Council
 Building Consent Authority
 Approved Site Copy
 Approved for Issue
 27/02/2020

2	25.10.19	CONSENT ISSUE	GPW
1	27.09.19	PEER REVIEW ISSUE	GPW
REV	DATE	AMENDMENT	BY

CLIENT:
HWCP

lewis bradford
 CONSULTING ENGINEERS

PROJECT:
**INVERCARGILL CENTRAL
 ZONE 1 ANCHOR**



DRAWING TITLE:
**GROUND FLOOR
 OVERALL PLAN**

DRAWN:	GPW	SCALE:	1 : 200 at A1
ENGINEER:	EL/TSS		
CHECKED:	-		
118083-Z1-WD-ST 1103		REV.	2

17 Dec 2019

Building Division

BUILDING CONSENT NUMBER
2019/1381

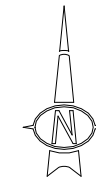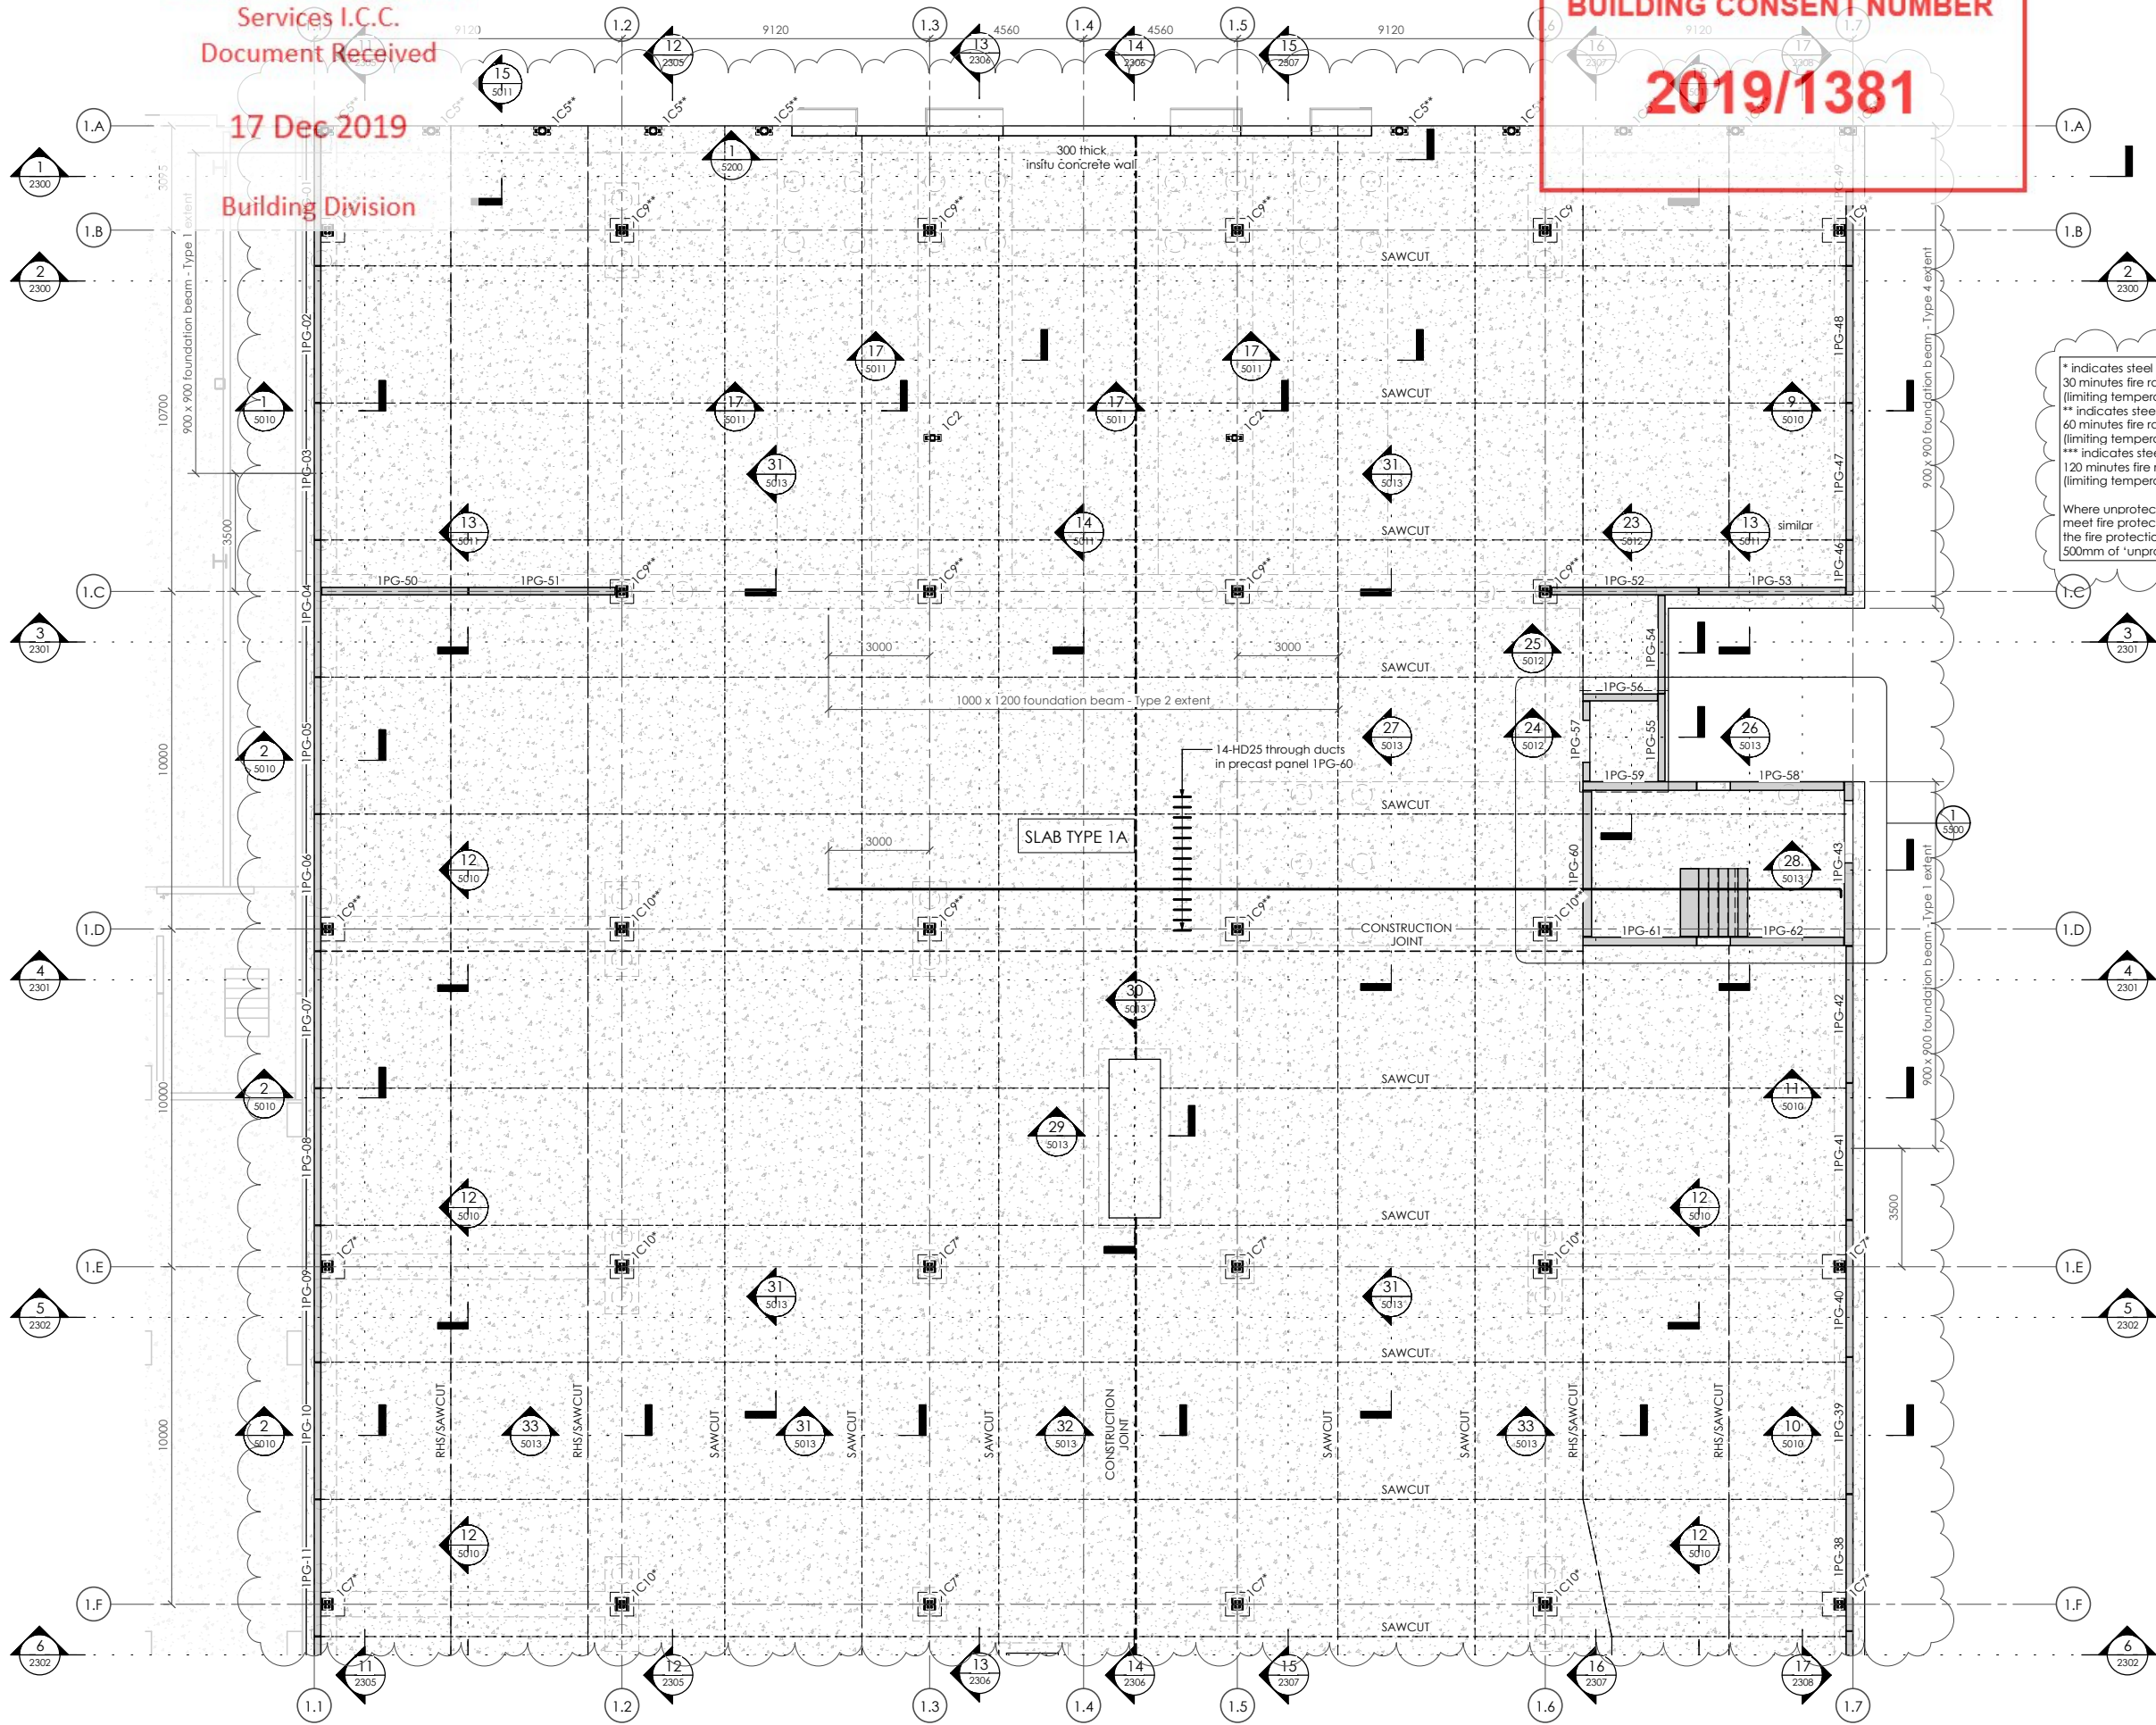

THIS DRAWING AND ALL INFORMATION CONTAINED WITHIN IS THE PROPERTY OF LEWIS BRADFORD. ITS CONTENTS ARE CONFIDENTIAL AND MUST NOT BE REPRODUCED OR DISTRIBUTED TO ANY OTHER PERSON OR COMPANY UNLESS AGREED TO IN WRITING BY LEWIS BRADFORD

CONTRACTOR TO VERIFY ALL DIMENSIONS ON SITE REFER TO ARCHITECT'S DRAWING FOR ALL SETOUTS

NOTES:
Refer drawing 0002 for standard notes.
Refer also to Structural Specification.

COLUMN LEGEND

IC1	100 x 6 SHS
IC2	150 x 9 SHS
IC3	150 x 100 x 5 RHS
IC4	200 x 100 x 9 RHS
IC5**	200 x 9 SHS**
IC6	200 UB 30
IC7*	310 UC 118*
IC7**	310 UC 118**
IC8*	310 UC 137*
IC8**	310 UC 137**
IC9**	310 UC 158**
IC10*	350 WC 197*
IC10**	350 WC 197**
IC11	600 WB 197
IC12	140 x 140 GL8 post

FLOOR LEGEND


Where unprotected areas of steelwork meet fire protected elements provide the fire protection onto the adjoining 500mm of 'unprotected' structural steel

SLAB 150 thick insitu concrete slab reinforced with S82 @ 150mm top cover on min. compacted hardcore, HD12 trimmer bars to 250mm centres and additional reinforcing.

Invercargill City Council
Building Consent Authority
Approved Site Copy
Approved for Issue
27/02/2020

2	25.10.19	CONSENT ISSUE	GPW
1	27.09.19	PEER REVIEW ISSUE	GPW
REV	DATE	AMENDMENT	BY

CLIENT:
HWCP

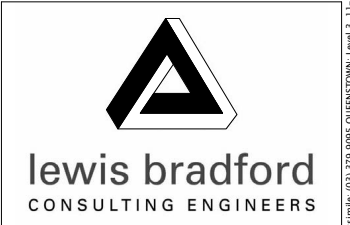

PROJECT:
INVERCARGILL CENTRAL ZONE 1 ANCHOR

DRAWING TITLE:
GROUND FLOOR PART PLAN A

DRAWN:	GPW	SCALE:	1 : 100 at A1
ENGINEER:	EL/TSS		
CHECKED:	-		
118083-Z1-WD-ST 1104		REV.	2

GROUND FLOOR - PART PLAN A
1 : 100

17 Dec 2019

Building Division

BUILDING CONSENT NUMBER
2019/1381

THIS DRAWING AND ALL INFORMATION CONTAINED WITHIN IS THE PROPERTY OF LEWIS BRADFORD. ITS CONTENTS ARE CONFIDENTIAL AND MUST NOT BE REPRODUCED OR DISTRIBUTED TO ANY OTHER PERSON OR COMPANY UNLESS AGREED TO IN WRITING BY LEWIS BRADFORD.

CONTRACTOR TO VERIFY ALL DIMENSIONS ON SITE REFER TO ARCHITECT'S DRAWING FOR ALL SETOUTS

NOTES:
Refer drawing 0002 for standard notes.
Refer also to Structural Specification.

COLUMN LEGEND

IC1	100 x 6 SHS
IC2	150 x 9 SHS
IC3	150 x 100 x 5 RHS
IC4	200 x 100 x 9 RHS
IC5**	200 x 9 SHS**
IC6	200 UB 30
IC7*	310 UC 118*
IC7**	310 UC 118**
IC8*	310 UC 137*
IC8**	310 UC 137**
IC9**	310 UC 158**
IC10*	350 WC 197*
IC10**	350 WC 197**
IC11	600 WB 197
IC12	140 x 140 GL8 post

FLOOR LEGEND

R/C FLOOR 90 thick insitu topping on 25 timber infills (300 interspan ribs to hatched areas) reinforce with HD10 @ 110 crs. e.w. with 30 top and 20 bottom trimmer bars to all edges, corners and openings.

FLOOR 80-165 thick insitu topping on 25 timber infills (250 interspan ribs at 900 max. crs. e.w. to hatched areas) reinforce with HD10 @ 200 crs. e.w. with 30 top and 20 bottom trimmer bars to all edges, corners and openings. refer plans for additional reinforcing.


SLAB 150 thick insitu concrete slab reinforced with S82 @ 150mm top cover on 25 timber infills (250 interspan ribs at 900 min. compacted hardfill, HD12 trimmer bars to all edges, corners and openings. refer plans for additional reinforcing.

Approved for Issue
27/02/2020

Approved Site Copy

REV	DATE	AMENDMENT	BY
2	25.10.19	CONSULT ISSUE	GPW
1	27.09.19	PEER REVIEW ISSUE	GPW


CLIENT:
HWCP

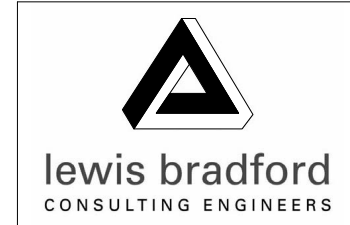

PROJECT:
**INVERCARGILL CENTRAL
ZONE 1 ANCHOR**

DRAWING TITLE:
**GROUND FLOOR
PART PLAN B**

DRAWN: GPW	SCALE: 1 : 100 at A1
ENGINEER: EL/TSS	
CHECKED: -	
118083-Z1-WD-ST 1105	REV. 2

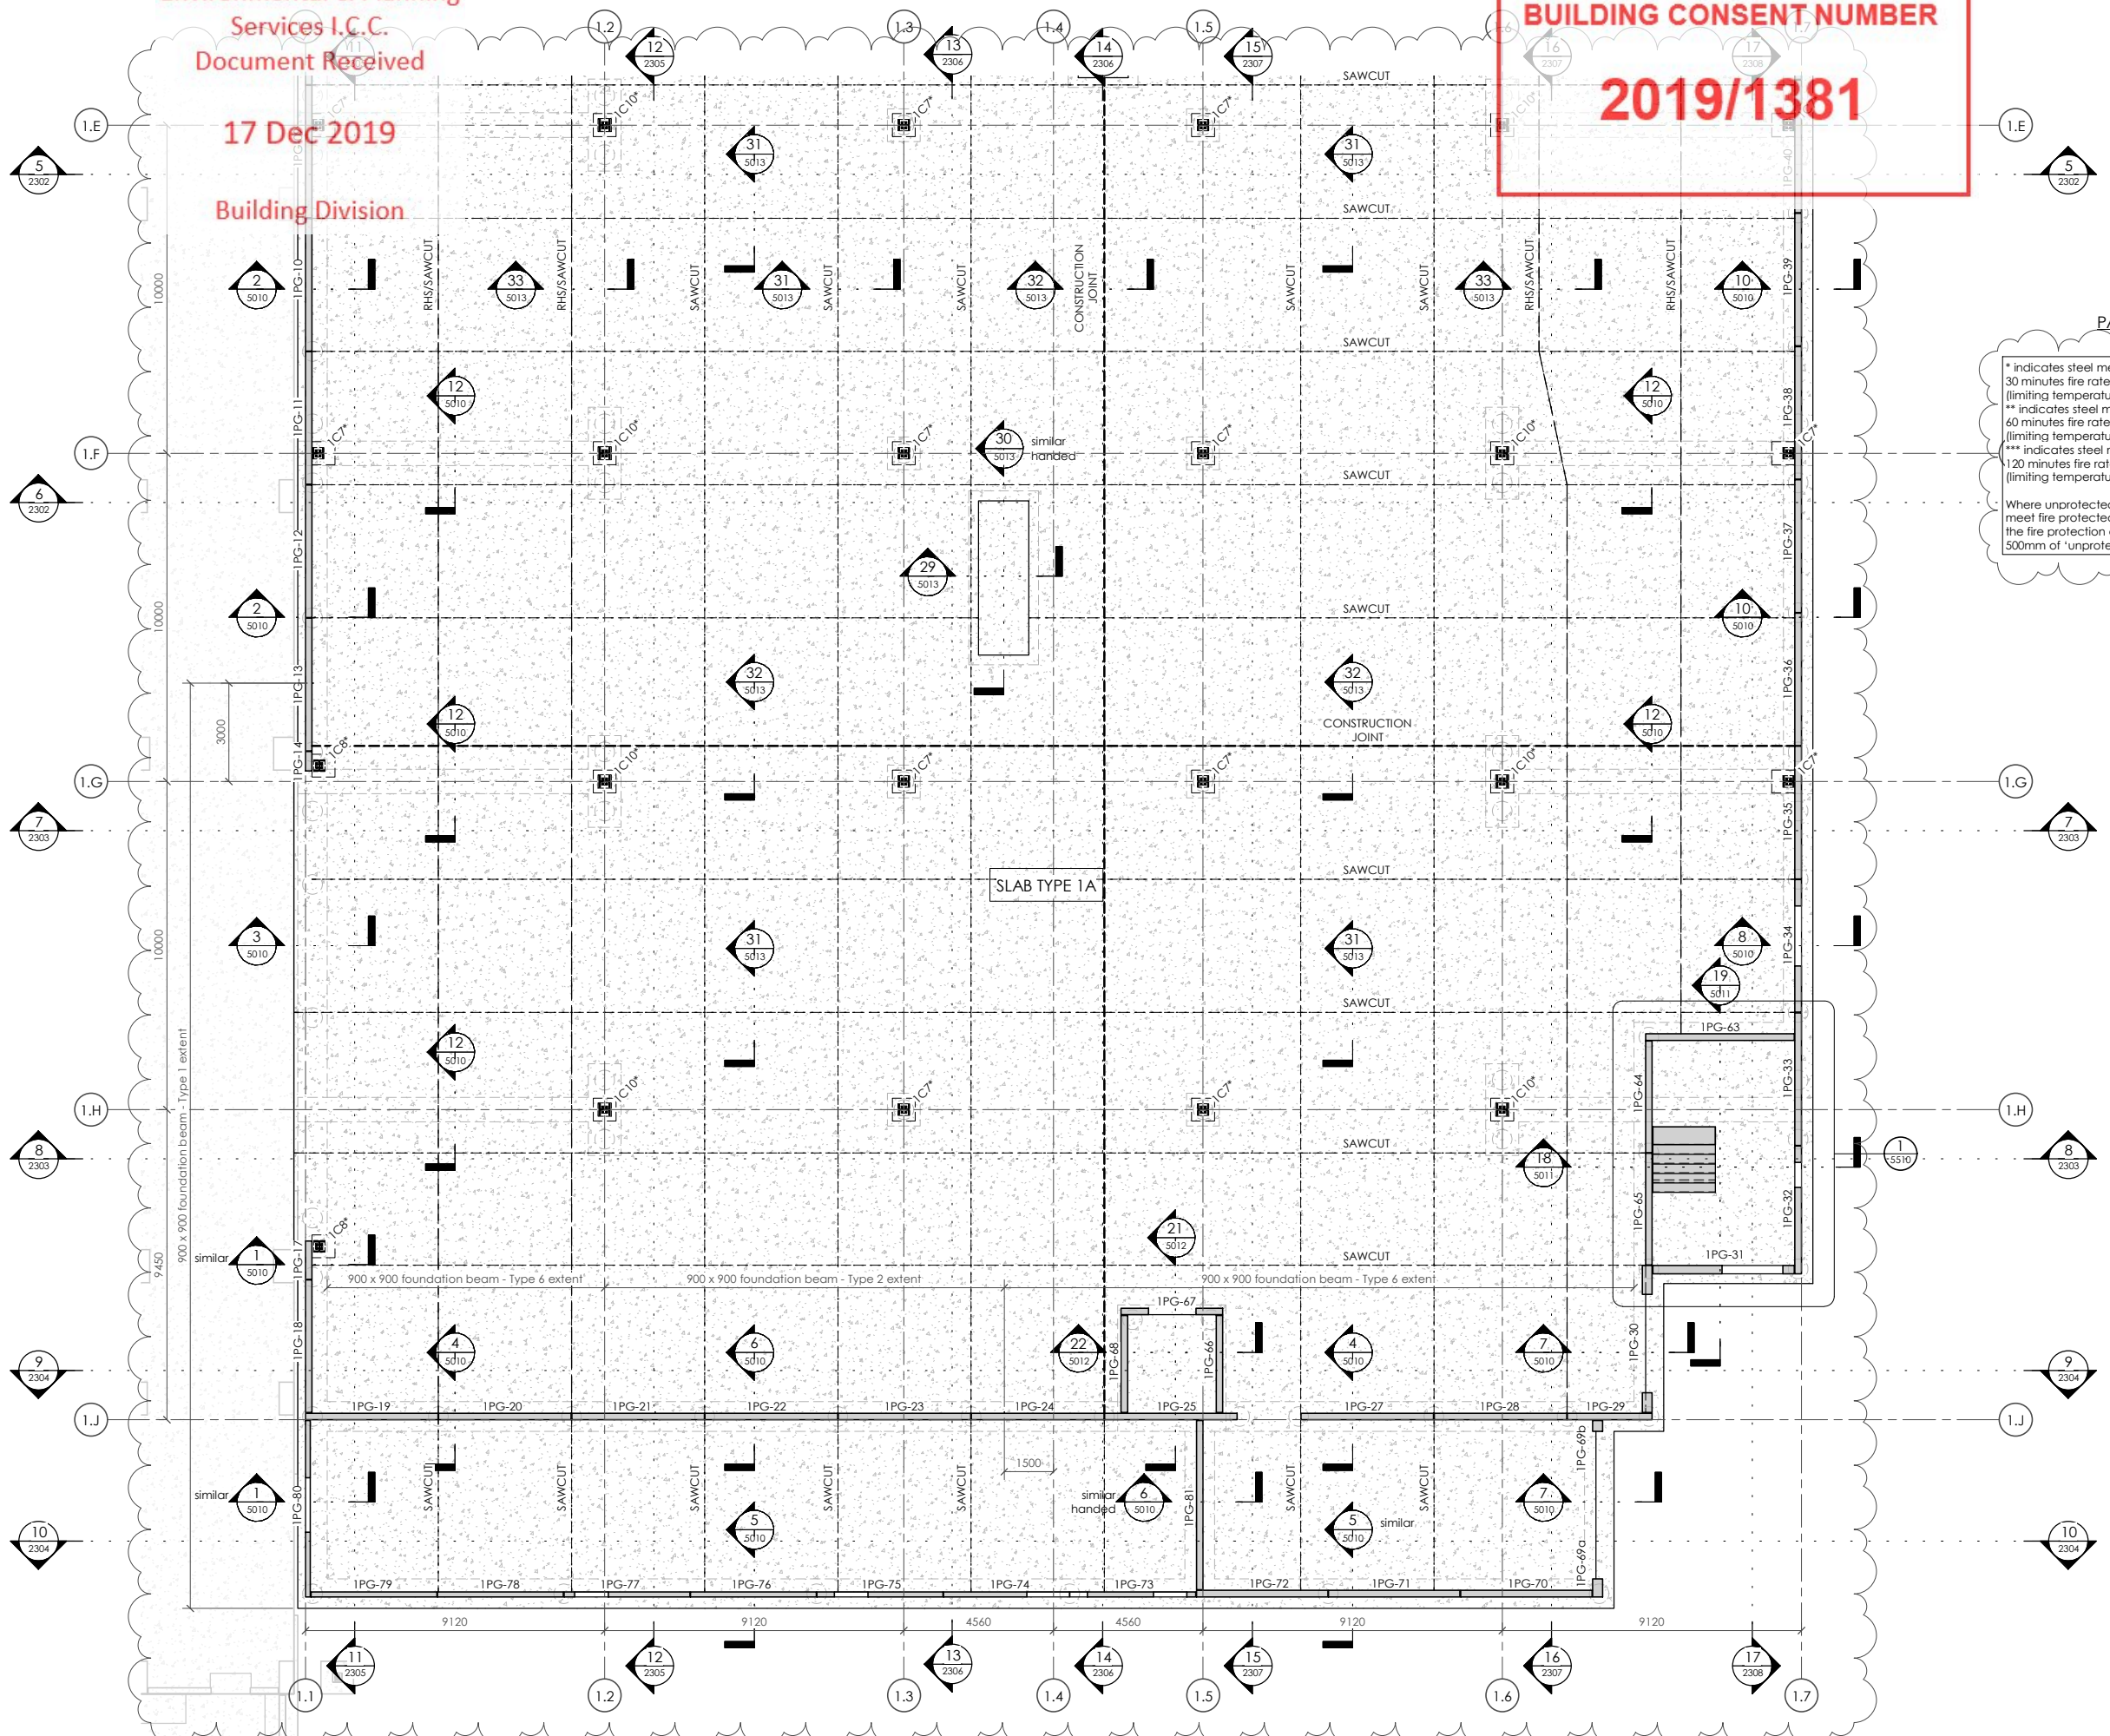

GROUND FLOOR - PART PLAN B
1 : 100

17 Dec 2019

Building Division

BUILDING CONSENT NUMBER


2019/1381

THIS DRAWING AND ALL INFORMATION CONTAINED WITHIN IS THE PROPERTY OF LEWIS BRADFORD. ITS CONTENTS ARE CONFIDENTIAL AND MUST NOT BE REPRODUCED OR DISTRIBUTED TO ANY OTHER PERSON OR COMPANY UNLESS AGREED TO IN WRITING BY LEWIS BRADFORD

CONTRACTOR TO VERIFY ALL DIMENSIONS ON SITE
REFER TO ARCHITECT'S DRAWING FOR ALL SETOUTS

NOTES :

Refer drawing 0002 for standard notes.
Refer also to Structural Specification.

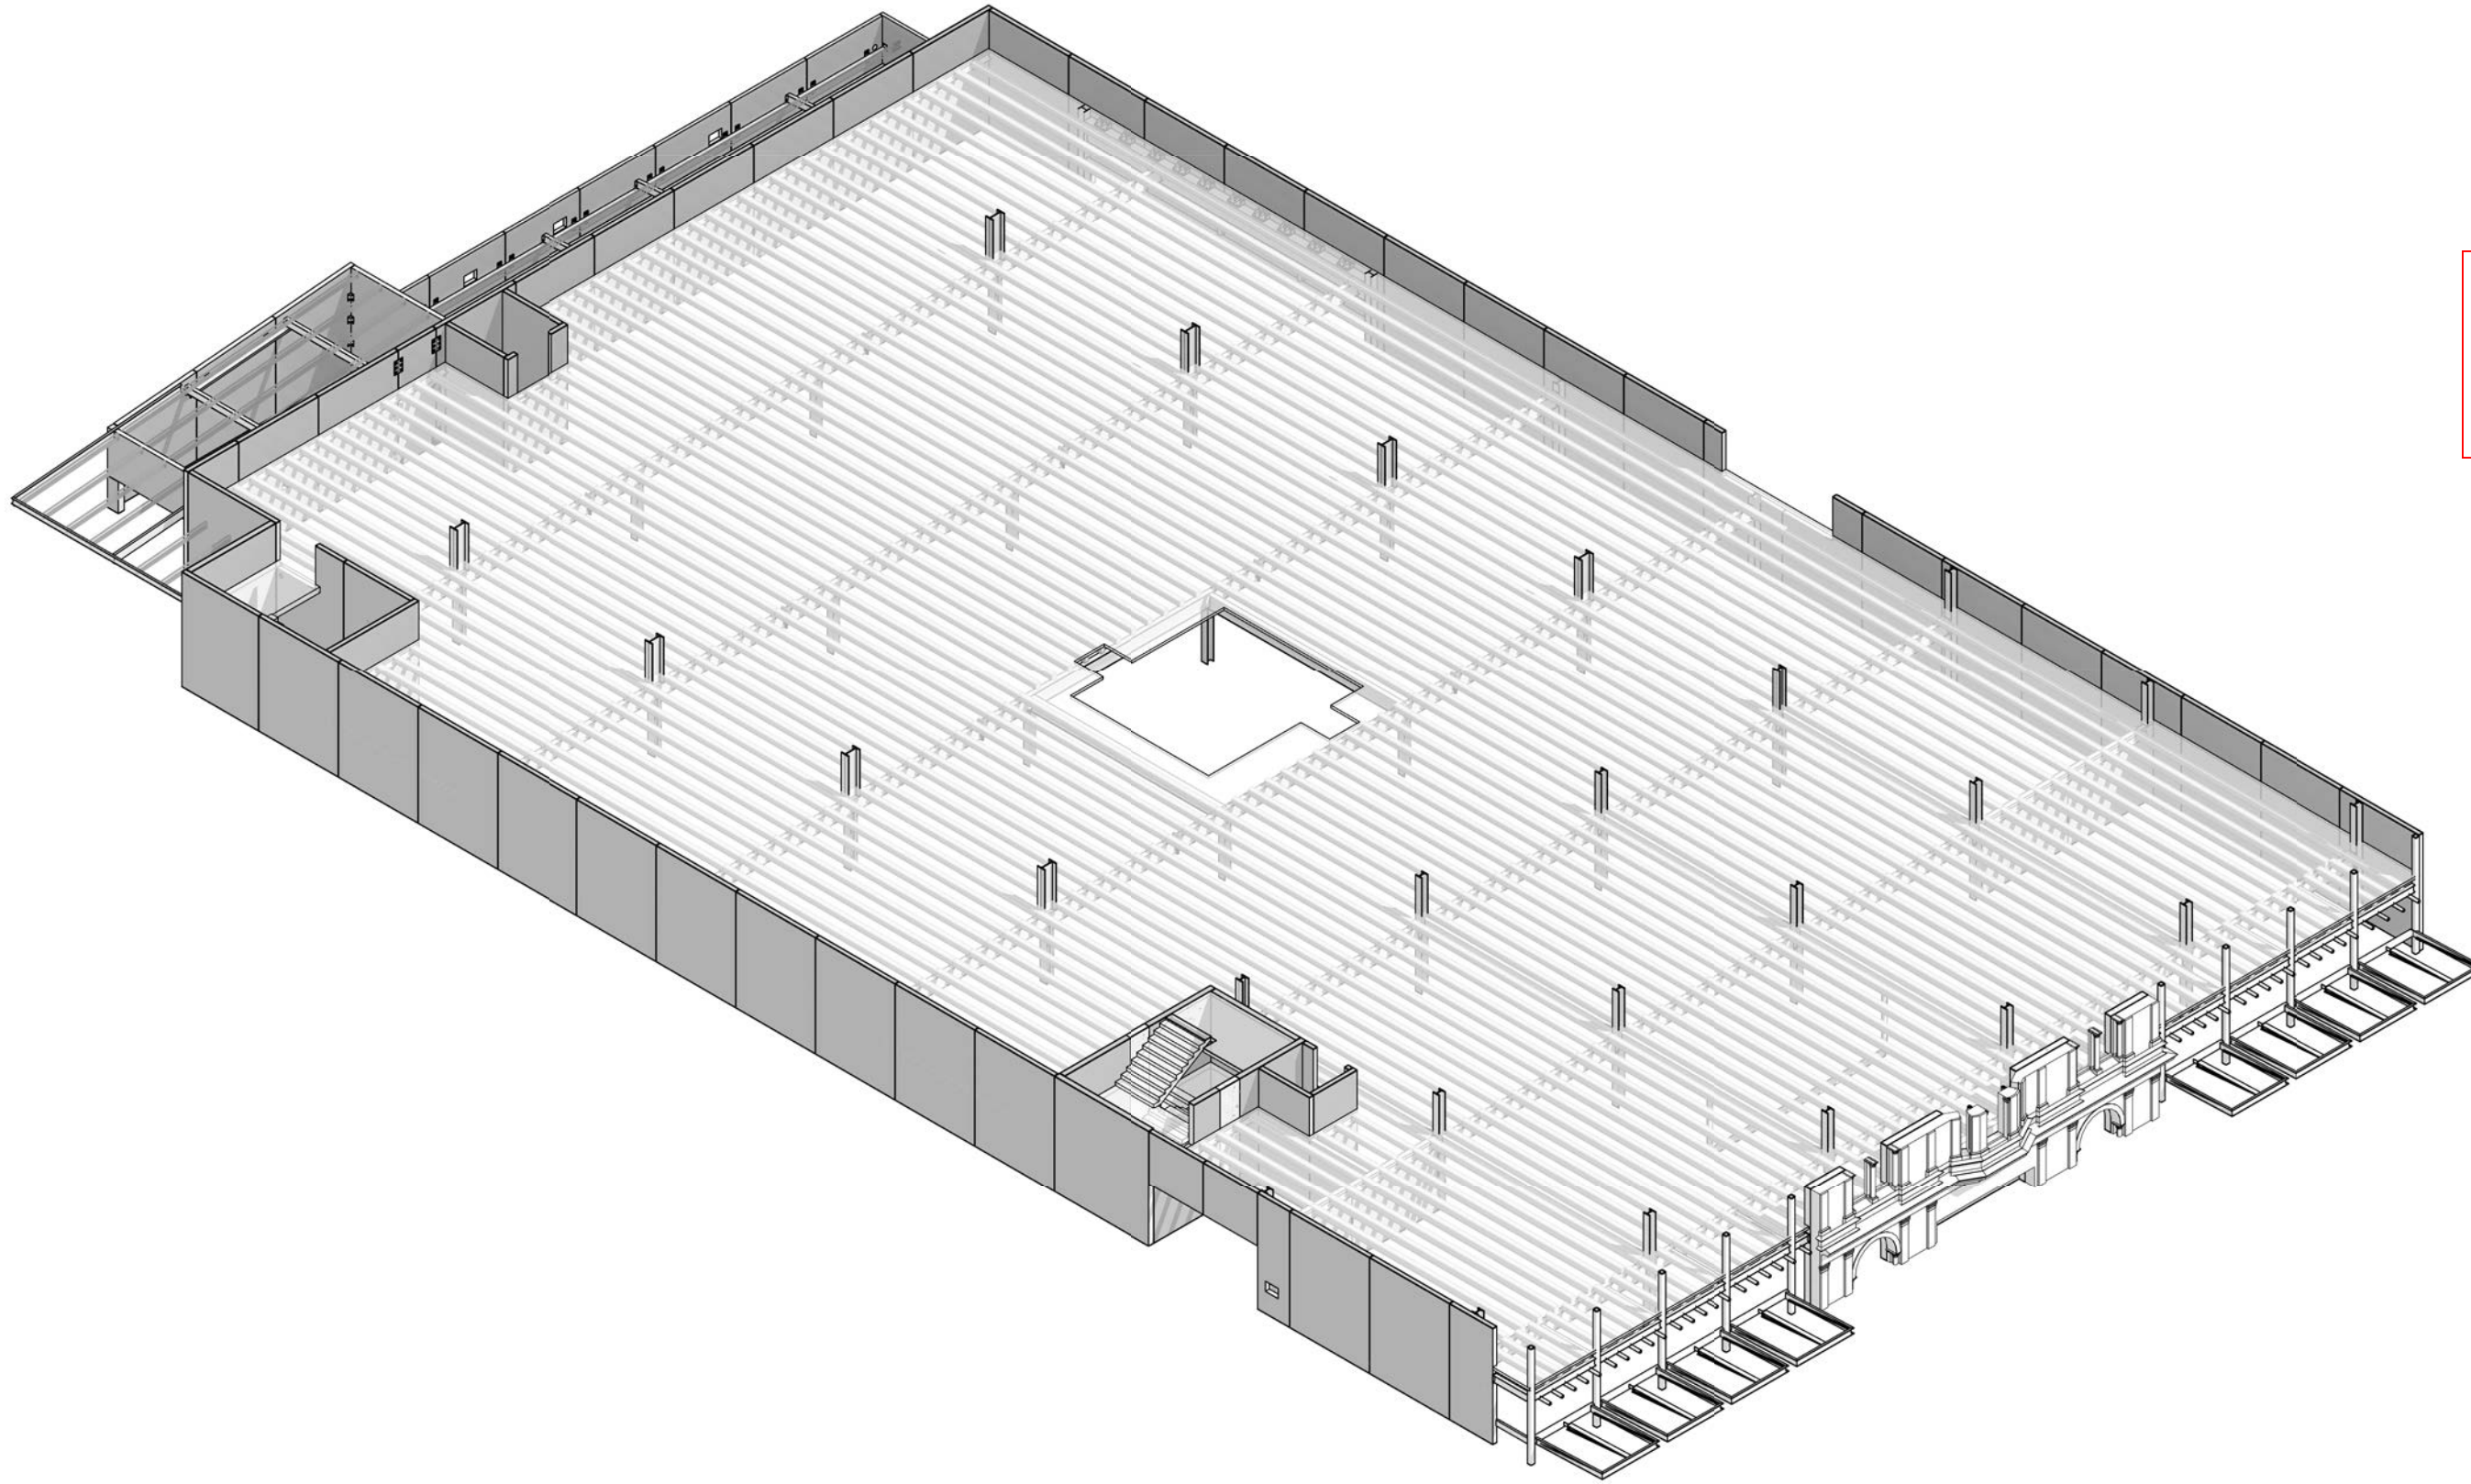

Invercargill City
Council
Building Consent
Authority
Approved Site Copy

Approved For Issue
27/02/2020

2	25.10.19	CONSENT ISSUE	GPW
1	27.09.19	PEER REVIEW ISSUE	GPW
REV	DATE	AMENDMENT	BY

CLIENT:

HWCP



lewis bradford
CONSULTING ENGINEERS

PROJECT:

INVERCARGILL CENTRAL
ZONE 1 ANCHOR

DRAWING TITLE:

LEVEL 1
3D VIEW


DRAWN: GPW
ENGINEER: EL/TSS
CHECKED: -

SCALE:
at A1

118083-Z1-WD-ST 1110

REV.
2

BUILDING CONSENT NUMBER
2019/1381

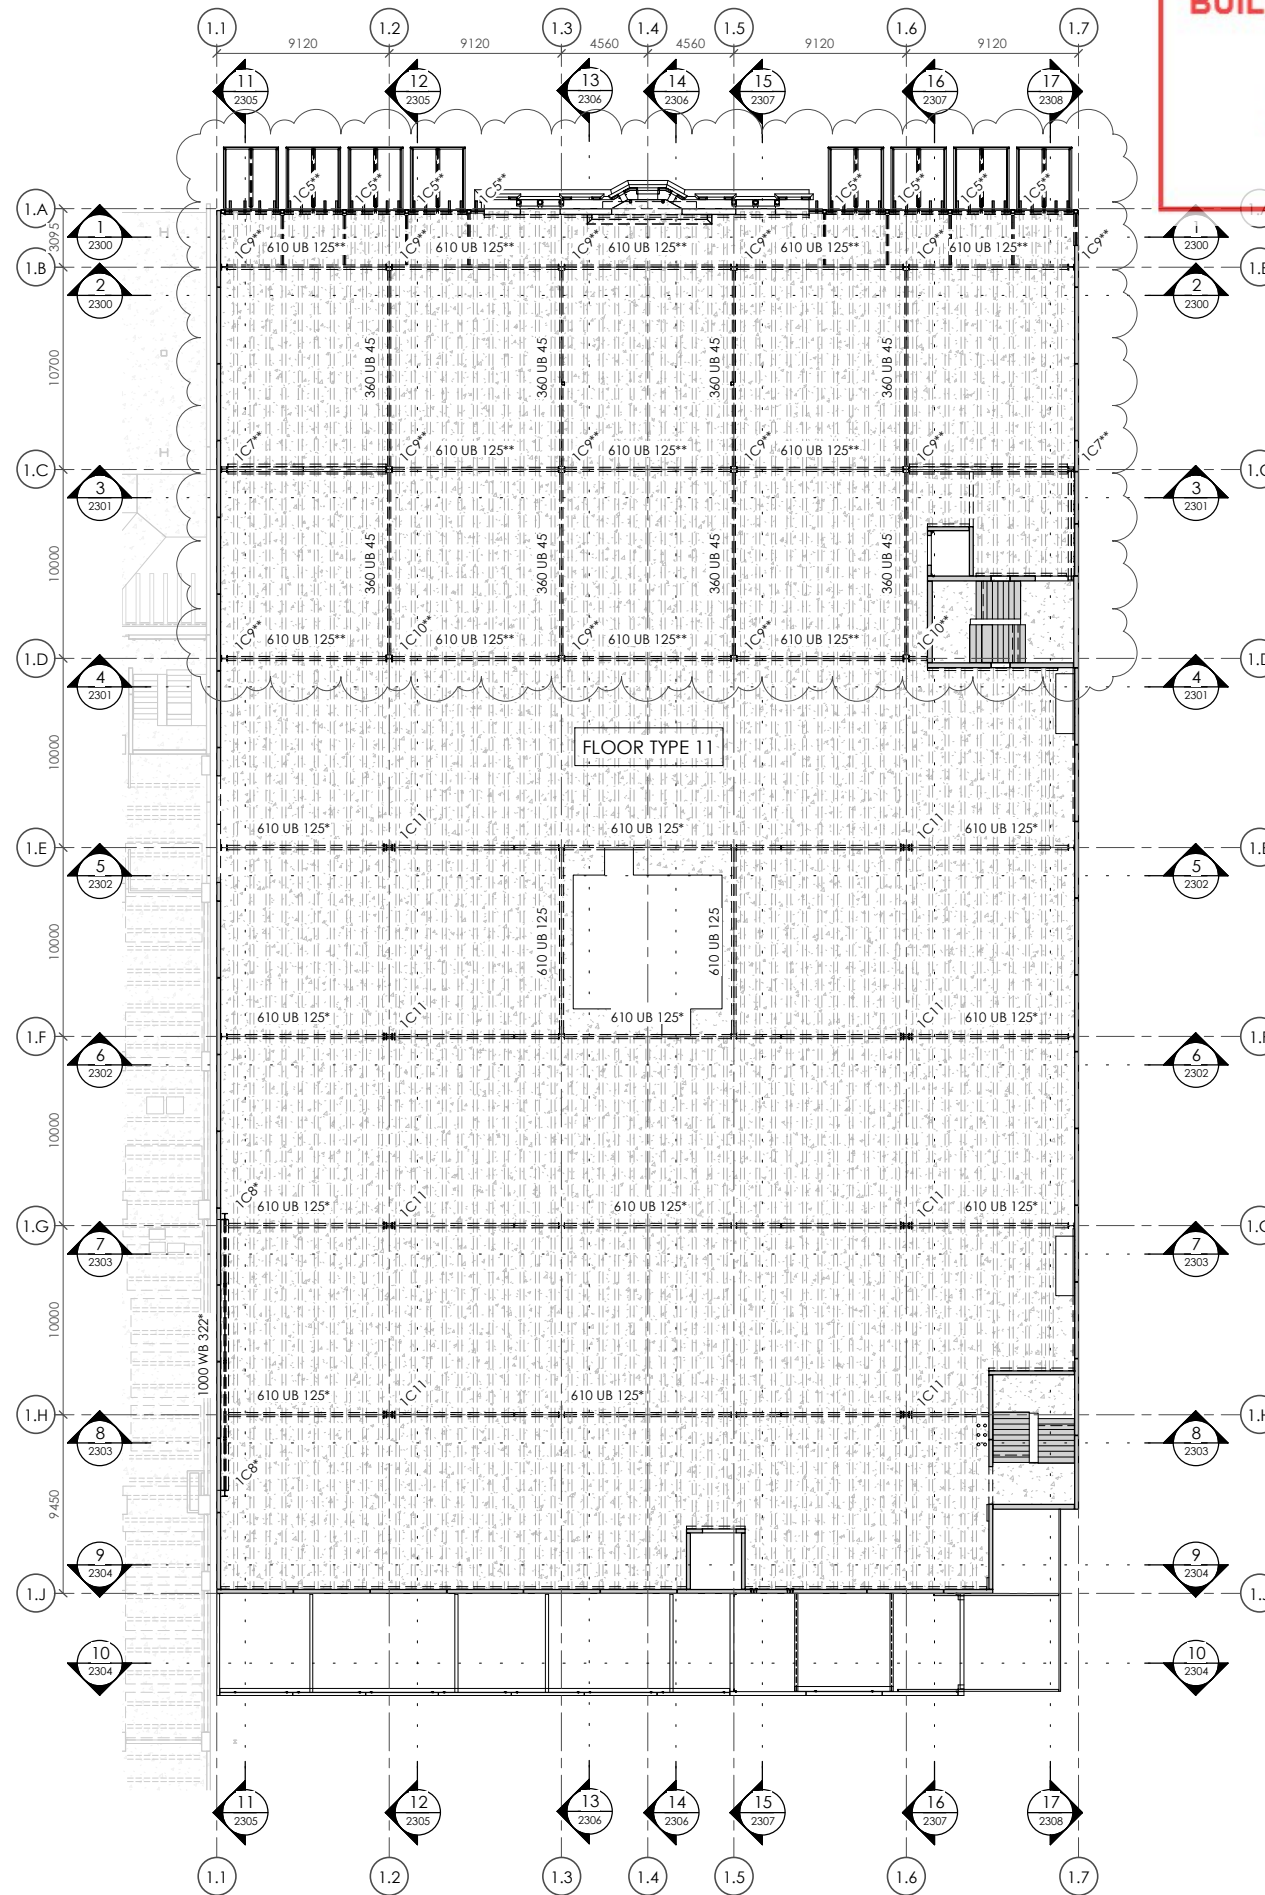

LEVEL 1 - OVERALL PLAN
 1 : 200

THIS DRAWING AND ALL INFORMATION CONTAINED WITHIN IS THE PROPERTY OF LEWIS BRADFORD. ITS CONTENTS ARE CONFIDENTIAL AND MUST NOT BE REPRODUCED OR DISTRIBUTED TO ANY OTHER PERSON OR COMPANY UNLESS AGREED TO IN WRITING BY LEWIS BRADFORD

CONTRACTOR TO VERIFY ALL DIMENSIONS ON SITE REFER TO ARCHITECT'S DRAWING FOR ALL SETOUTS

NOTES :

Refer drawing 0002 for standard notes.
 Refer also to Structural Specification.

COLUMN LEGEND

1C1	100 x 6 SHS
1C2	150 x 9 SHS
1C3	150 x 100 x 5 RHS
1C4	200 x 100 x 9 RHS
1C5**	200 x 9 SHS**
1C6	200 UB 30
1C7*	310 UC 118*
1C7**	310 UC 118**
1C8*	310 UC 137*
1C8**	310 UC 137**
1C9**	310 UC 158**
1C10*	350 WC 197*
1C10**	350 WC 197**
1C11	600 WB 197
1C12	140 x 140 GLB post

FLOOR LEGEND


FLOOR	90 thick insitu topping on 25 timber infill (300 interspan ribs to hatched areas) reinforce with HD10 @ 110 c/s. e.w. with 30 top and bottom trimmer bars to all edges, corners and openings.
FLOOR TYPE 12	80-165 thick insitu topping on 25 timber infill (300 interspan ribs to hatched areas) reinforce with HD10 @ 200 c/s. e.w. with 30 top and bottom trimmer bars to all edges, corners and openings. refer plans for additional reinforcing.
SLAB TYPE 1A	150 thick insitu concrete slab reinforced with SF82 class 50mm top cover on min. compacted hardfill. HD12 trimmer bars to all edges, corners and openings. refer plans for additional reinforcing.

* indicates steel member to have 30 minutes fire rated paint protection (limiting temperature 550°C)
 ** indicates steel member to have 60 minutes fire rated paint protection (limiting temperature 550°C)
 *** indicates steel member to have 120 minutes fire rated paint protection (limiting temperature 550°C)
 Where unprotected areas of steelwork meet fire protected elements cascade the fire protection onto the adjoining 500mm of 'unprotected' structural steel

Invercargill City Council
 Building Consent Authority
 Approved Site Copy
 Approved for Issue
 27/02/2020

2	25.10.19	CONSENT ISSUE	GPW
1	27.09.19	PEER REVIEW ISSUE	GPW
REV	DATE	AMENDMENT	BY

CLIENT:
HWCP

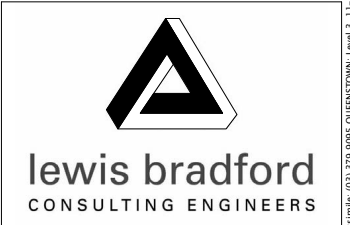

PROJECT:
INVERCARGILL CENTRAL ZONE 1 ANCHOR

DRAWING TITLE:
LEVEL 1 OVERALL PLAN

DRAWN:	GPW	SCALE:	1 : 200 at A1
ENGINEER:	EL/TSS	CHECKED:	-
118083-Z1-WD-ST 1111			REV. 2

17 Dec 2019

Building Division

BUILDING CONSENT NUMBER

2019/1381

THIS DRAWING AND ALL INFORMATION CONTAINED WITHIN IS THE PROPERTY OF LEWIS BRADFORD. ITS CONTENTS ARE CONFIDENTIAL AND MUST NOT BE REPRODUCED OR DISTRIBUTED TO ANY OTHER PERSON OR COMPANY UNLESS AGREED TO IN WRITING BY LEWIS BRADFORD

CONTRACTOR TO VERIFY ALL DIMENSIONS ON SITE REFER TO ARCHITECT'S DRAWING FOR ALL SETOUTS

NOTES:

Refer drawing 0002 for standard notes. Refer also to Structural Specification.

COLUMN LEGEND

1C1	100 x 6 SHS
1C2	150 x 9 SHS
1C3	150 x 100 x 5 RHS
1C4	200 x 100 x 9 RHS
1C5**	200 x 9 SHS**
1C6	200 UB 30
1C7*	310 UC 118*
1C7**	310 UC 118**
1C8*	310 UC 137*
1C9**	310 UC 158**
1C10*	350 WC 197*
1C10**	350 WC 197**
1C11	600 WB 197
1C12	140 x 140 GL8 post


FLOOR LEGEND

FLOOR	90 thick insitu topping on 25 timber infills (300 interspan max to hatched areas) reinforce with HD10 at 100 crs. e.w. with 30 top and 30 bottom trimmer bars to all edges, corners and openings.
FLOOR TYPE 12	80-165 thick insitu topping on 25 timber infills (250 interspan max to hatched areas) reinforce with HD10 at 200 crs. e.w. with 30 top and 30 bottom trimmer bars to all edges, corners and openings. refer plans for additional reinforcing.
SLAB	150 thick insitu concrete slab reinforced with S82 @ 50mm top cover on min. compacted hardcore. HD12 trimmer bars to all edges, corners and openings. refer plans for additional reinforcing.

Invercargill City Council Building Consent Authority Approved Site Copy Approved for Issue 27/02/2020

2	25.10.19	CONSENT ISSUE	GPW
1	27.09.19	PEER REVIEW ISSUE	GPW
REV	DATE	AMENDMENT	BY


CLIENT: HWCP

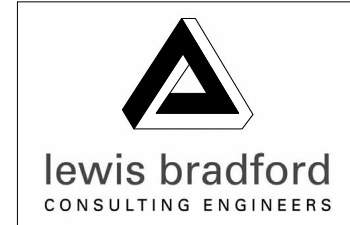

PROJECT: INVERCARGILL CENTRAL ZONE 1 ANCHOR

DRAWING TITLE: LEVEL 1 PART PLAN A

DRAWN:	GPW	SCALE:	1 : 100 at A1
ENGINEER:	EL/TSS	CHECKED:	-
118083-Z1-WD-ST 1112	REV. 2		

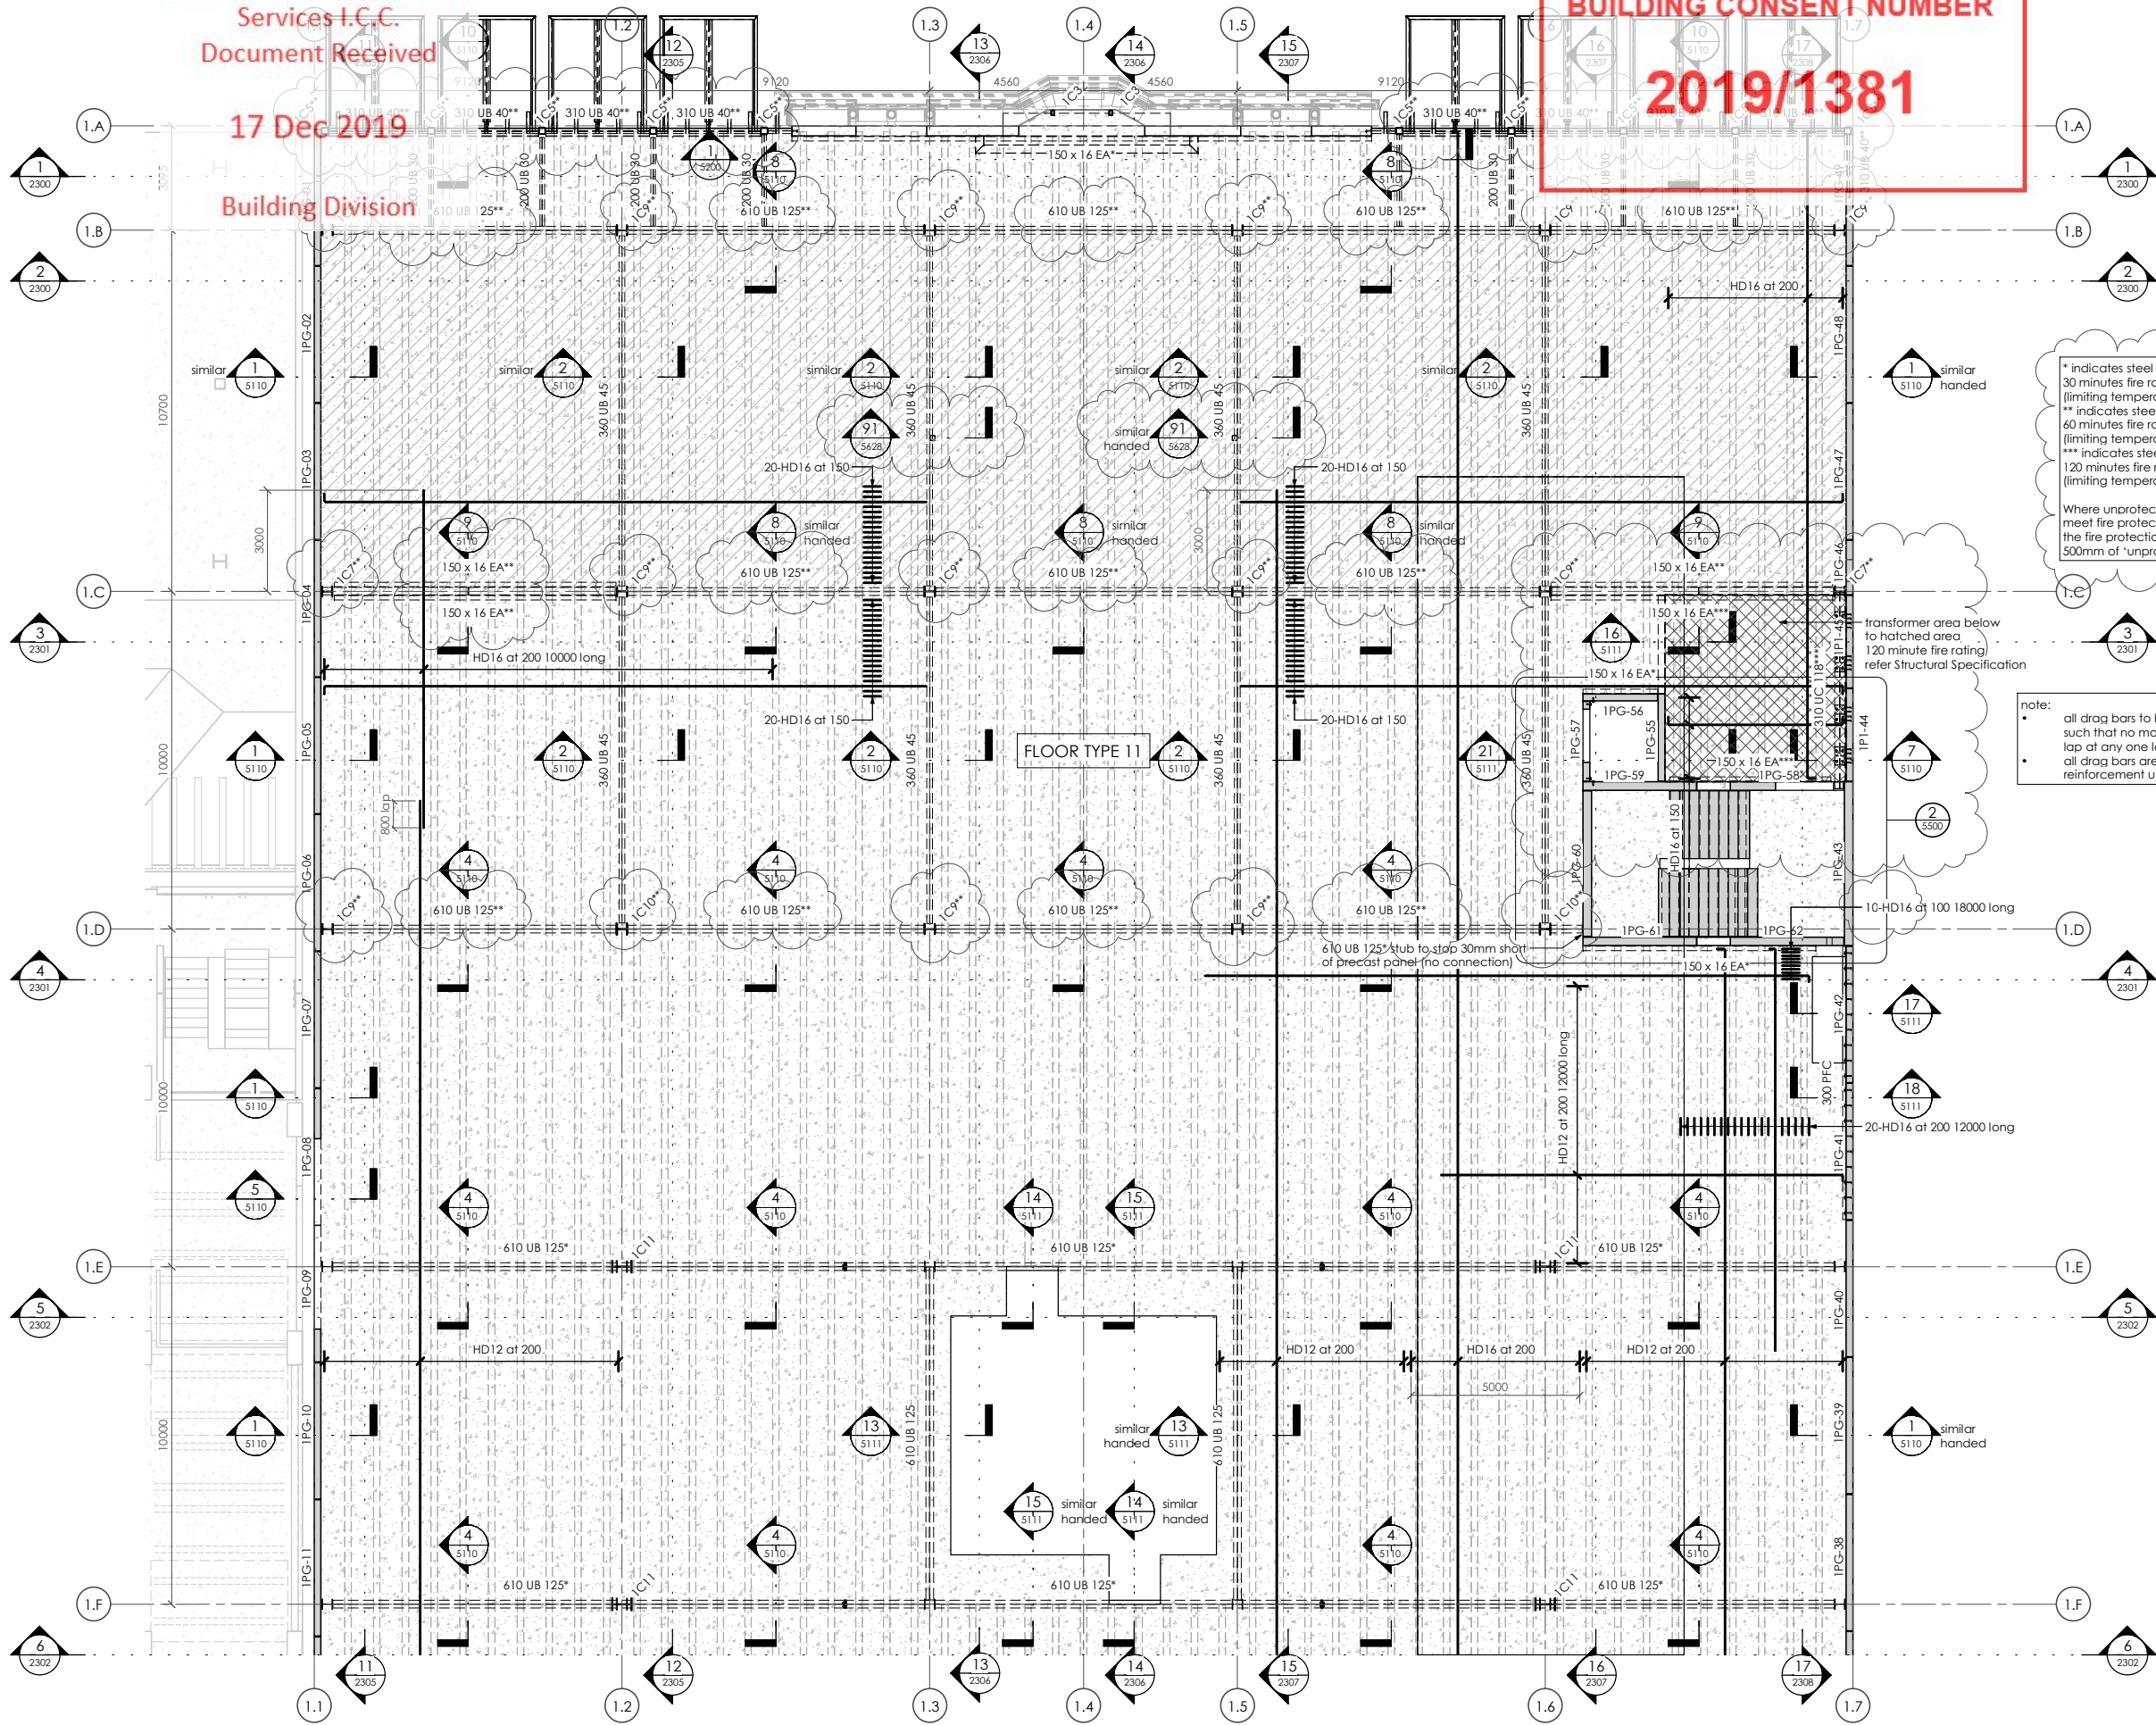

LEVEL 1 - PART PLAN A
1 : 100

17 Dec 2019

Building Division

BUILDING CONSENT NUMBER

2019/1381

THIS DRAWING AND ALL INFORMATION CONTAINED WITHIN IS THE PROPERTY OF LEWIS BRADFORD. ITS CONTENTS ARE CONFIDENTIAL AND MUST NOT BE REPRODUCED OR DISTRIBUTED TO ANY OTHER PERSON OR COMPANY UNLESS AGREED TO IN WRITING BY LEWIS BRADFORD

CONTRACTOR TO VERIFY ALL DIMENSIONS ON SITE REFER TO ARCHITECT'S DRAWING FOR ALL SETOUTS

NOTES:

Refer drawing 0002 for standard notes.
Refer also to Structural Specification.


COLUMN LEGEND

IC1	100 x 6 SHS
IC2	150 x 9 SHS
IC3	150 x 100 x 5 RHS
IC4	200 x 100 x 9 RHS
IC5**	200 x 9 SHS**
IC6	200 UB 30
IC7*	310 UC 118*
IC7**	310 UC 118**
IC8*	310 UC 137*
IC9**	310 UC 158**
IC10*	350 WC 197*
IC10**	350 WC 197**
IC11	600 WB 197
IC12	140 x 140 GL8 post

FLOOR LEGEND

FLOOR TYPE 11
90 thick insitu concrete slab reinforced with S82 reinforcement (300 interspan bars to hatched areas) reinforce with HD10 @ 200 crs. e.w. with 30 trimmer bars to all edges, corners and openings.
FLOOR TYPE 12
80-165 thick insitu topping on 25 timber infill on 250 interspan bars at 900 max. crs. (300 interspan bars to hatched areas) reinforce with HD10 at 200 crs. e.w. with 30 trimmer bars to all edges, corners and openings. refer plans for additional reinforcing.
SLAB TYPE 1A
150 thick insitu concrete slab reinforced with S82 reinforcement (300 interspan bars to hatched areas) reinforce with HD10 @ 200 crs. e.w. with 30 trimmer bars to all edges, corners and openings. refer plans for additional reinforcing.


Invercargill City Council
Building Consent Authority
Approved Site Copy
Approved for Issue
27/02/2020

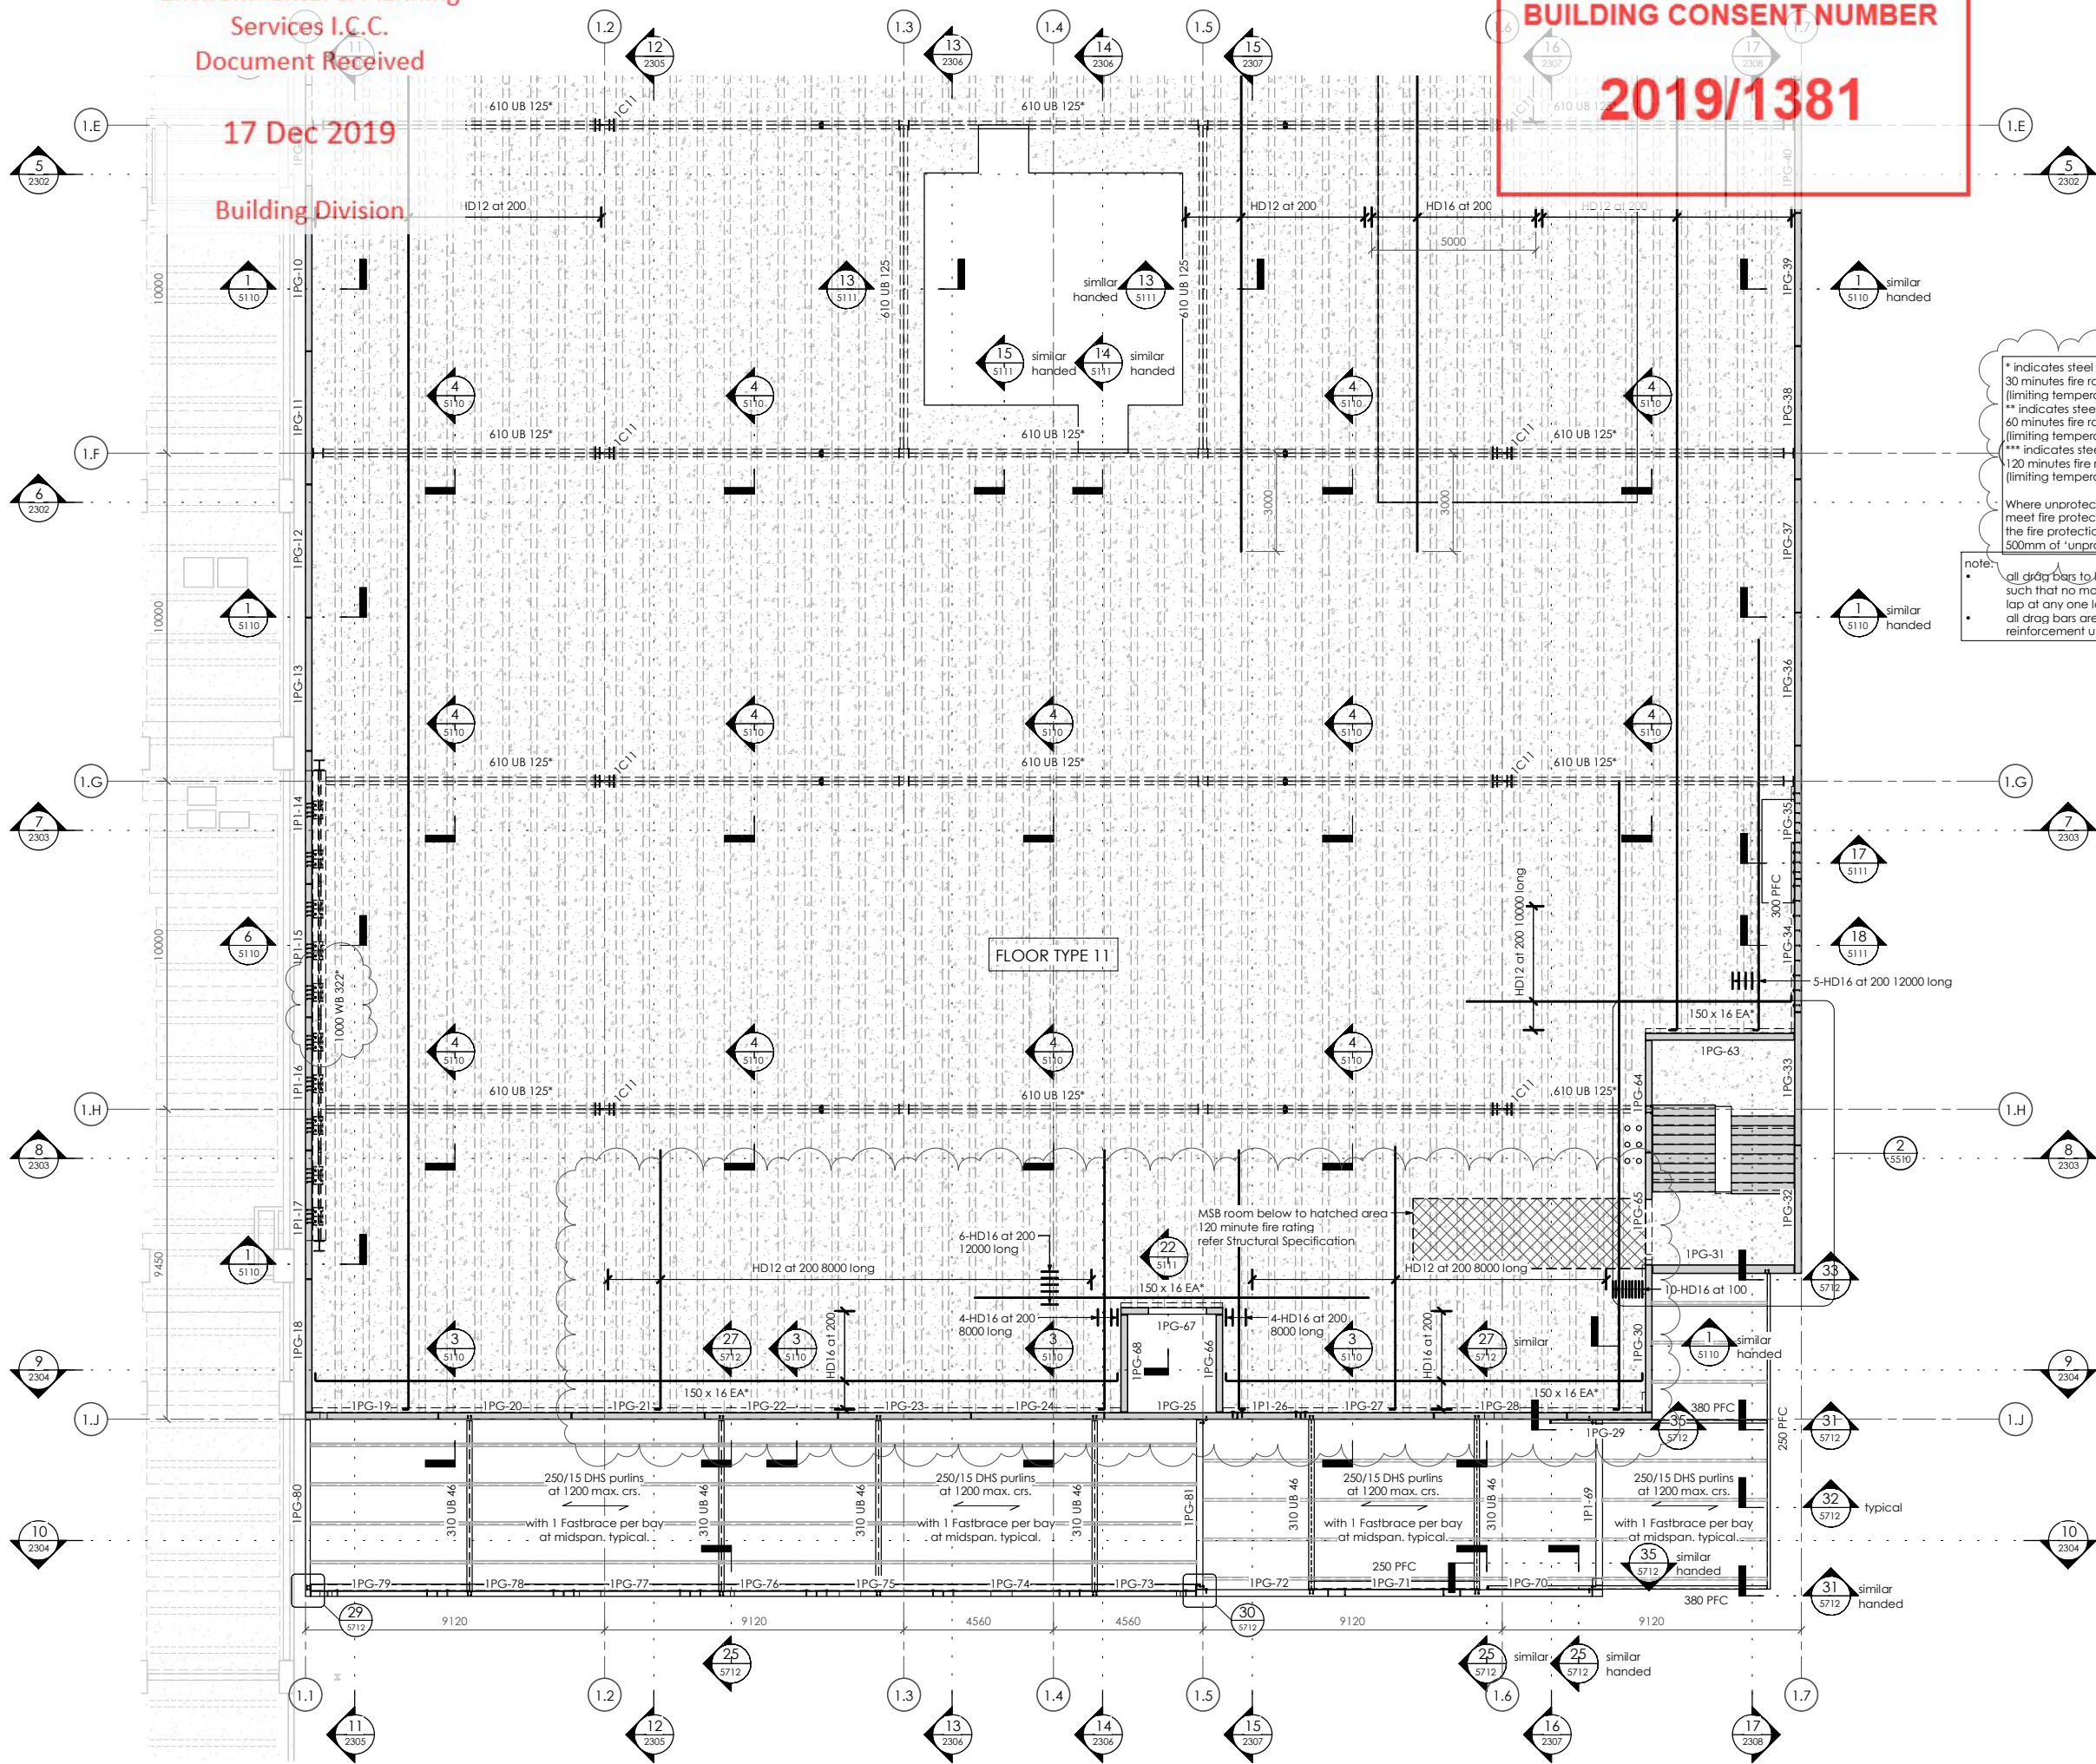

LEVEL 1 - PART PLAN B
1:100

REV	DATE	AMENDMENT	BY
2	25.10.19	CONSENT ISSUE	GPW
1	27.09.19	PEER REVIEW ISSUE	GPW

CLIENT:
HWCP

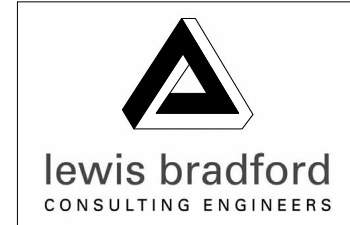

PROJECT:
**INVERCARGILL CENTRAL
ZONE 1 ANCHOR**

DRAWING TITLE:
**LEVEL 1
PART PLAN B**

DRAWN: GPW	SCALE: 1:100 at A1
ENGINEER: EL/TSS	
CHECKED: -	
118083-Z1-WD-ST 1113	REV. 2

17 Dec 2019

Building Division

BUILDING CONSENT NUMBER


2019/1381

THIS DRAWING AND ALL INFORMATION CONTAINED WITHIN IS THE PROPERTY OF LEWIS BRADFORD. ITS CONTENTS ARE CONFIDENTIAL AND MUST NOT BE REPRODUCED OR DISTRIBUTED TO ANY OTHER PERSON OR COMPANY UNLESS AGREED TO IN WRITING BY LEWIS BRADFORD

CONTRACTOR TO VERIFY ALL DIMENSIONS ON SITE REFER TO ARCHITECT'S DRAWING FOR ALL SETOUTS

NOTES :

Refer drawing 0002 for standard notes.
 Refer also to Structural Specification.

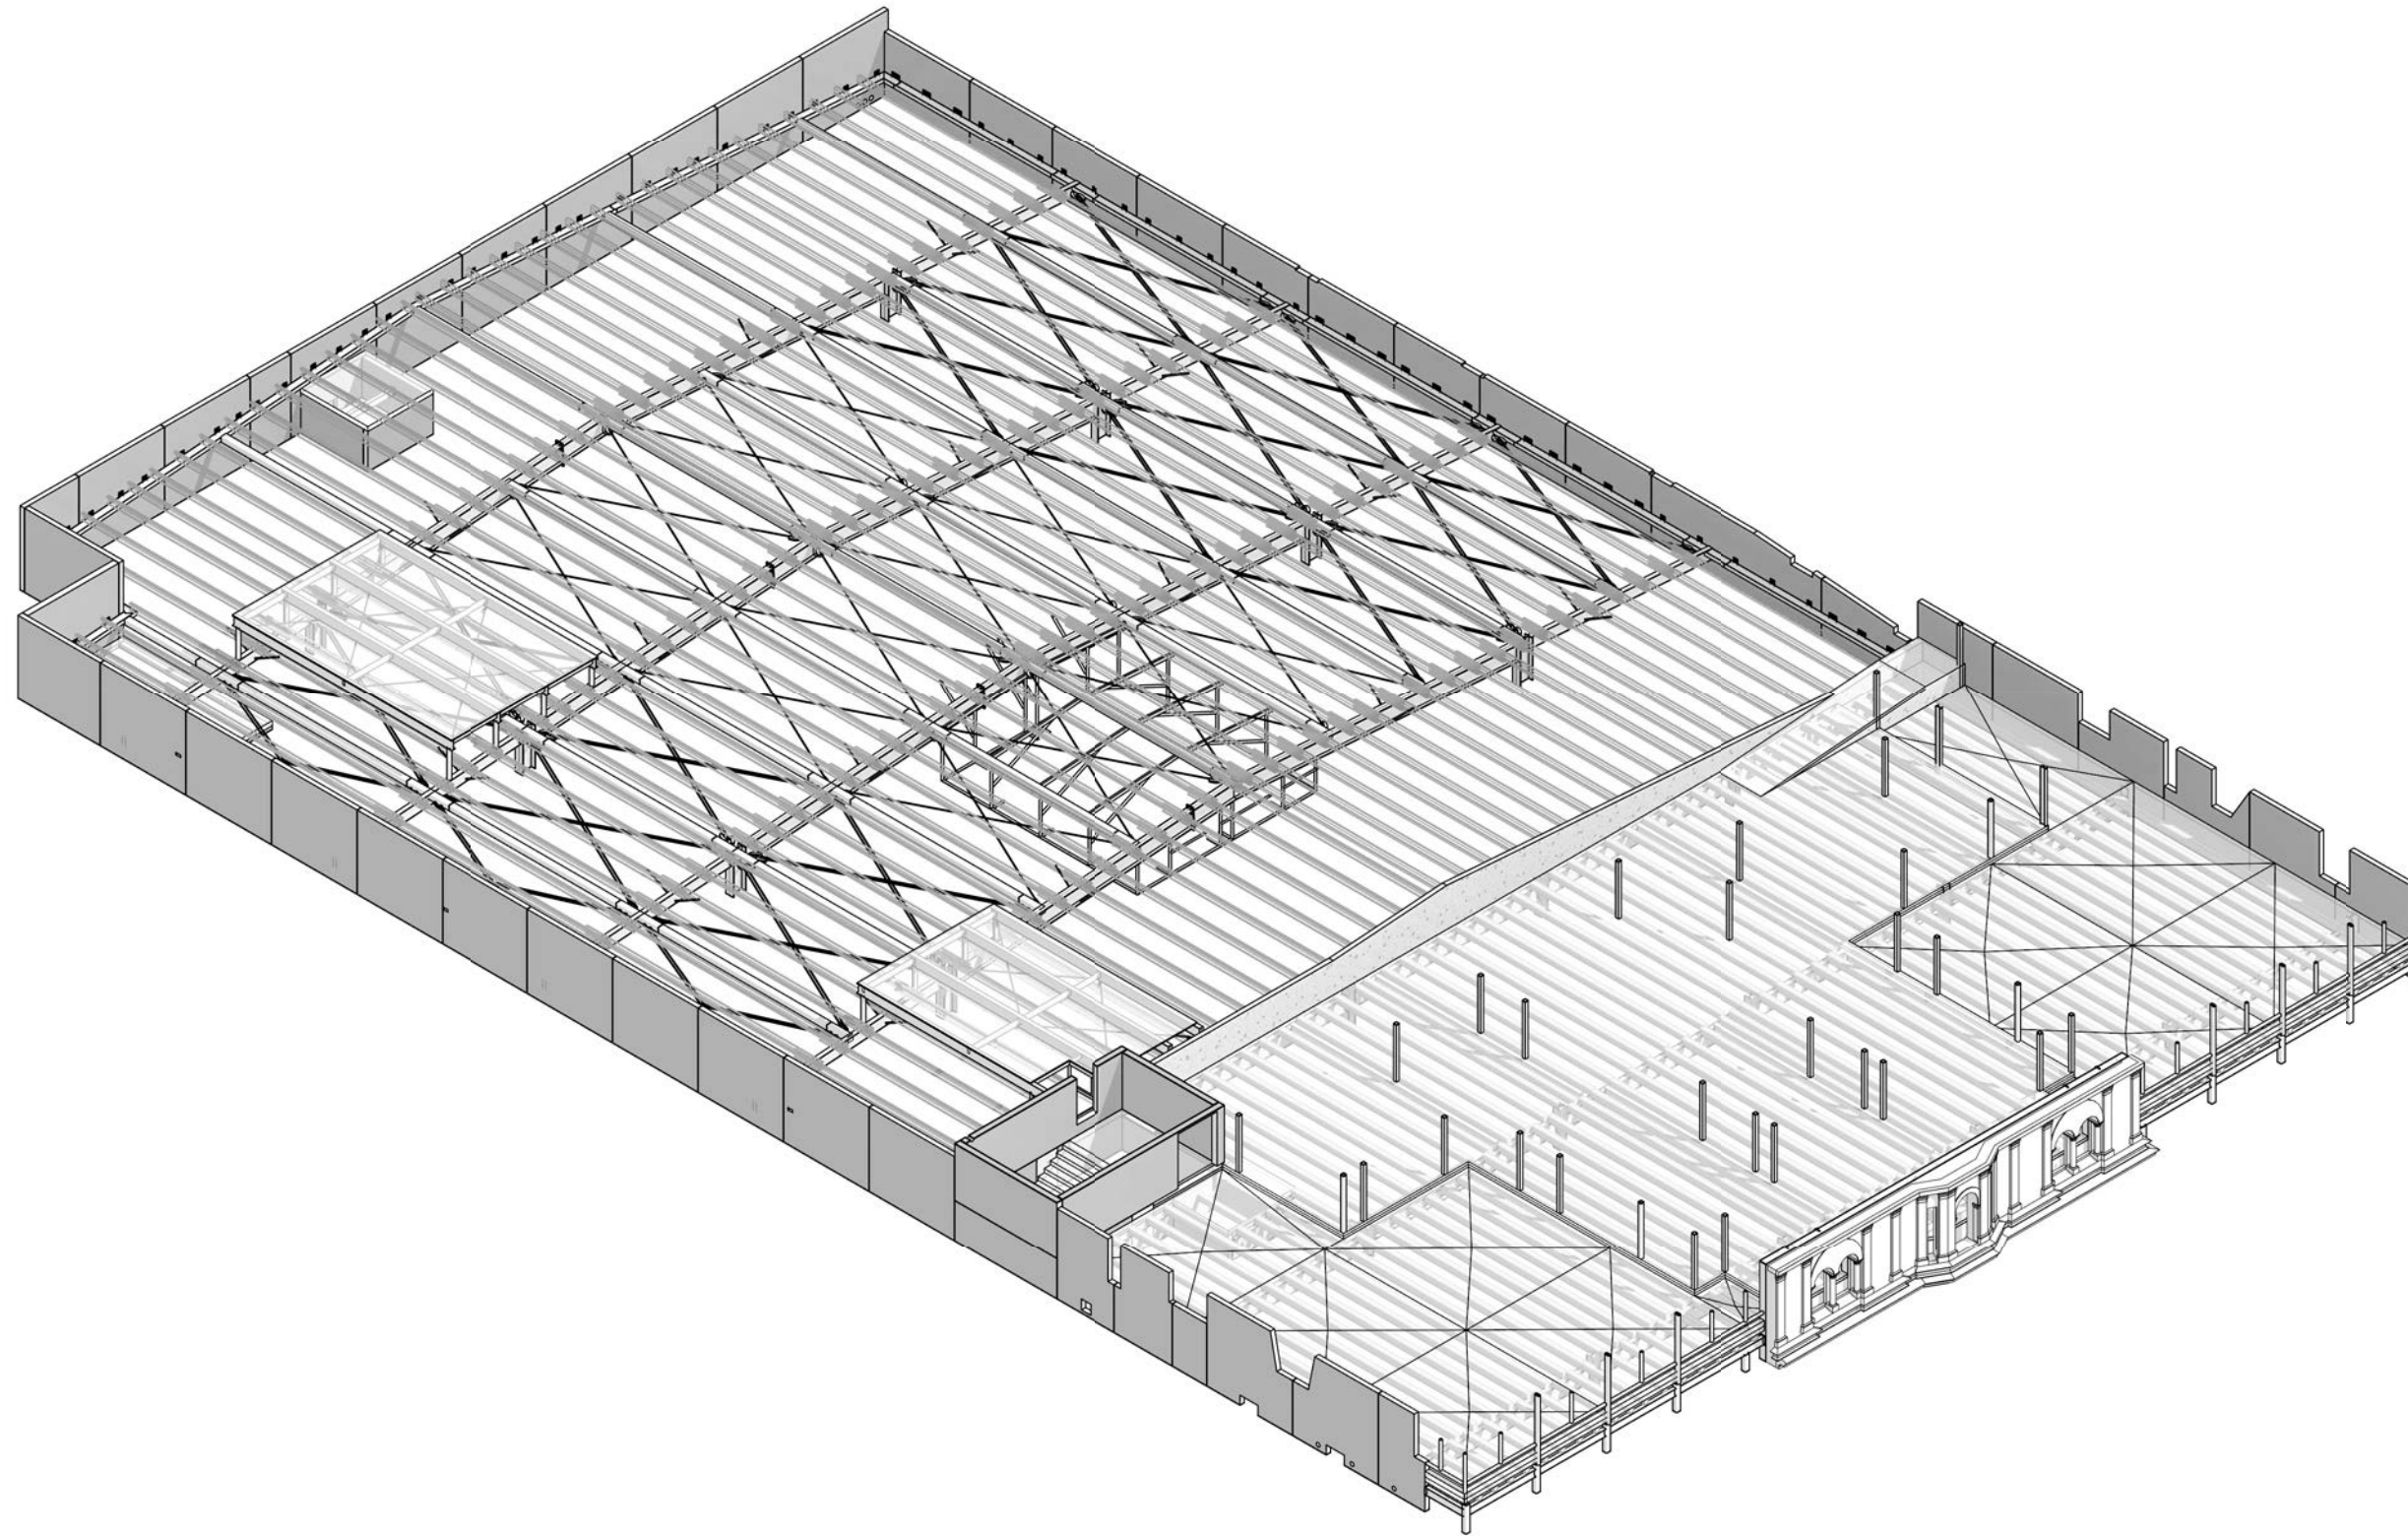


Invercargill City
 Council
 Building Consent
 Authority
 Approved Site Copy

Approved For Issue
 27/02/2020

2	25.10.19	CONSENT ISSUE	GPW
1	27.09.19	PEER REVIEW ISSUE	GPW
REV	DATE	AMENDMENT	BY

CLIENT:
HWCP

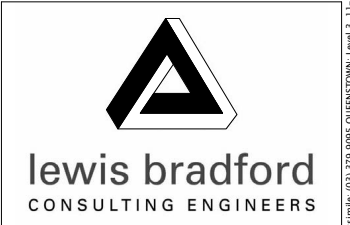

PROJECT:
**INVERCARGILL CENTRAL
 ZONE 1 ANCHOR**

DRAWING TITLE:
**LEVEL 2
 3D VIEW**

DRAWN: GPW	SCALE:
ENGINEER: EL/TSS	at A1
CHECKED: -	
118083-Z1-WD-ST 1120	REV. 2

17 Dec 2019

Building Division

BUILDING CONSENT NUMBER

2019/1381

THIS DRAWING AND ALL INFORMATION CONTAINED WITHIN IS THE PROPERTY OF LEWIS BRADFORD. ITS CONTENTS ARE CONFIDENTIAL AND MUST NOT BE REPRODUCED OR DISTRIBUTED TO ANY OTHER PERSON OR COMPANY UNLESS AGREED TO IN WRITING BY LEWIS BRADFORD

CONTRACTOR TO VERIFY ALL DIMENSIONS ON SITE REFER TO ARCHITECT'S DRAWING FOR ALL SETOUTS

NOTES:

Refer drawing 0002 for standard notes. Refer also to Structural Specification.

COLUMN LEGEND

IC1	100 x 6 SHS
IC2	150 x 9 SHS
IC3	150 x 100 x 5 RHS
IC4	200 x 100 x 9 RHS
IC5**	200 x 9 SHS**
IC6	200 UB 30
IC7*	310 UC 118*
IC7**	310 UC 118**
IC8*	310 UC 137*
IC9**	310 UC 158**
IC10*	350 WC 197*
IC10**	350 WC 197**
IC11	600 WB 197
IC12	140 x 140 GL8 post


FLOOR LEGEND

FLOOR TYPE 11	90 thick insitu topping on 25 timber infill (300 interspan ribs to hatched areas) reinforce with HD10 @ 100 crs. e.w. with 30 top and bottom trimmer bars to all edges, corners and openings.
FLOOR TYPE 12	80-165 thick insitu topping on 25 timber infill (250 interspan ribs at 900 max. crs. e.w. with 30 top and bottom trimmer bars to all edges, corners and openings. refer plans for additional reinforcing.
SLAB	150 thick insitu concrete slab reinforced with S82 @ 150mm top cover on min. compacted hardfill. HD12 trimmer bars to all edges, corners and openings. refer plans for additional reinforcing.

Approved for Issue
27/02/2020

2	25.10.19	CONSENT ISSUE	GPW
1	27.09.19	PEER REVIEW ISSUE	GPW
REV	DATE	AMENDMENT	BY


CLIENT:
HWCP

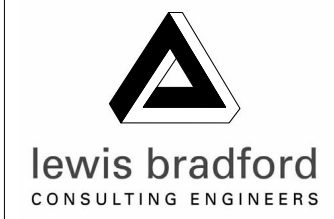

PROJECT:
INVERCARGILL CENTRAL ZONE 1 ANCHOR

DRAWING TITLE:
LEVEL 2 PART PLAN A

DRAWN:	GPW	SCALE:	1 : 100 at A1
ENGINEER:	EL/TSS		
CHECKED:	-		
118083-Z1-WD-ST 1122		REV.	2

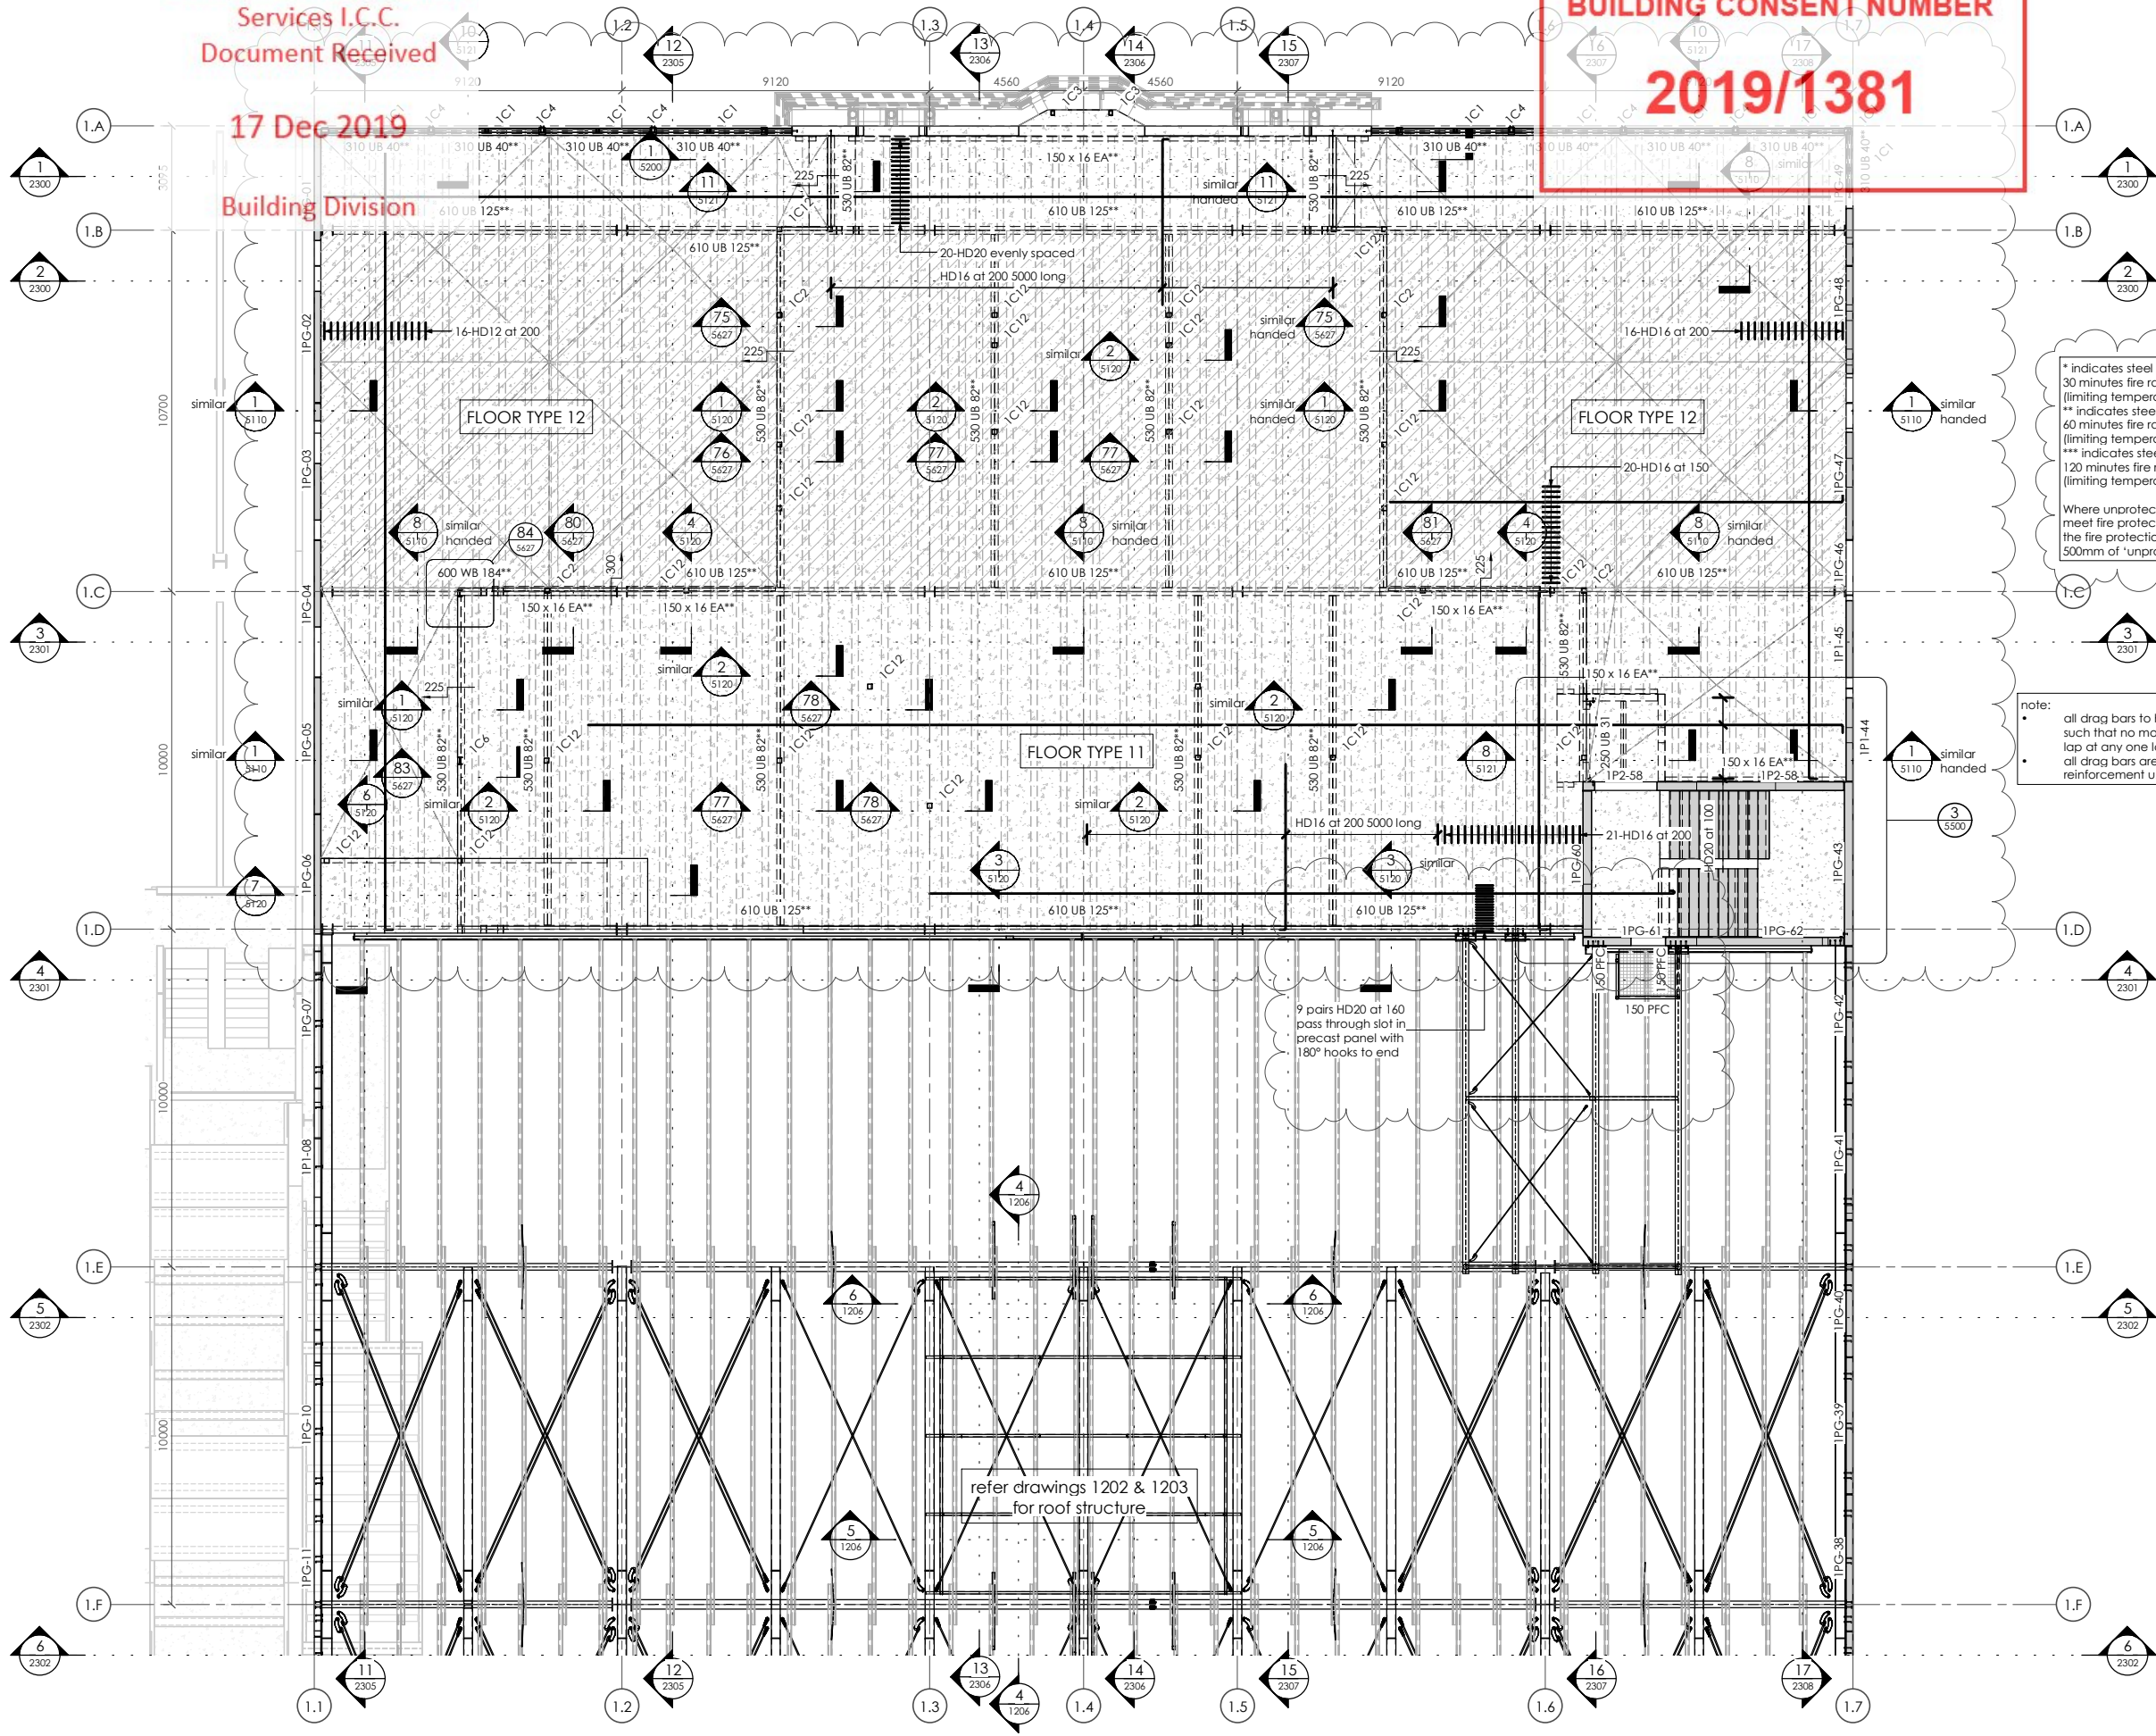


LEVEL 2 - PART PLAN A
1 : 100

17 Dec 2019

Building Division

BUILDING CONSENT NUMBER
2019/1381

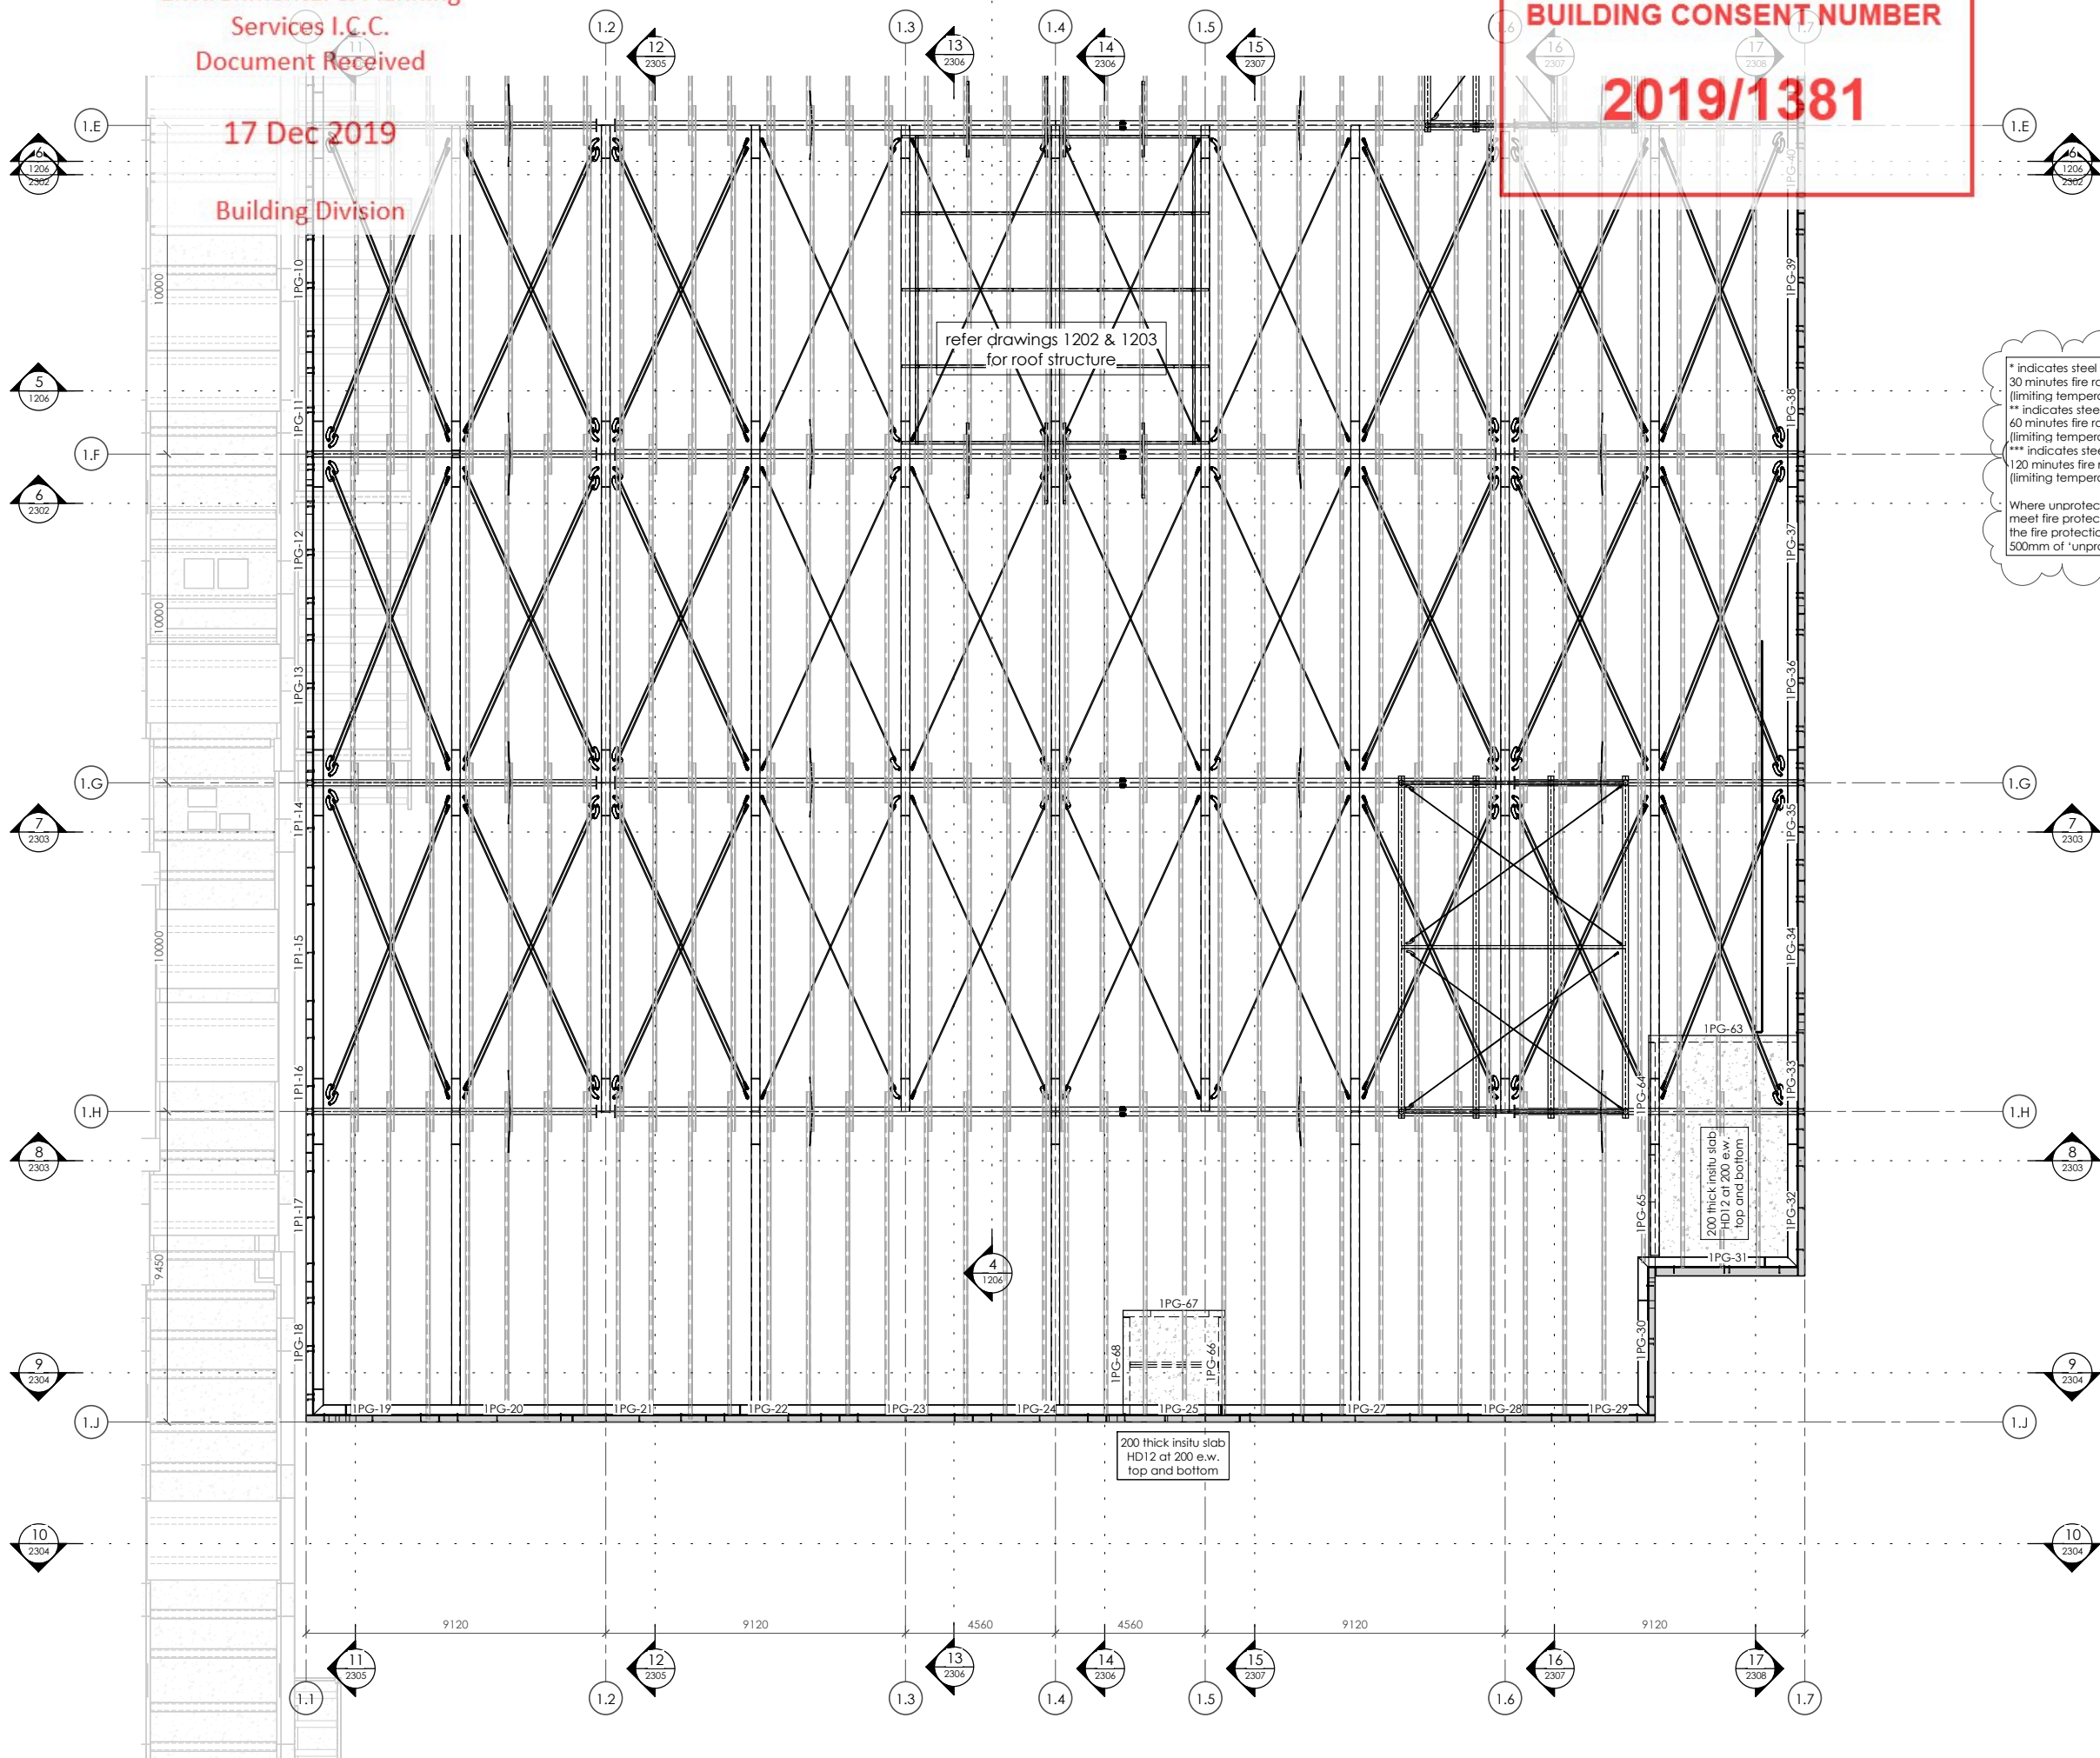

refer drawings 1202 & 1203
for roof structure

200 thick insitu slab
HD12 at 200 e.w.
top and bottom

PART PLAN KEY

* indicates steel member to have 30 minutes fire rated paint protection (limiting temperature 550°C)
** indicates steel member to have 60 minutes fire rated paint protection (limiting temperature 550°C)
*** indicates steel member to have 120 minutes fire rated paint protection (limiting temperature 550°C)

Where unprotected areas of steelwork meet fire protected elements overlap the fire protection onto the adjoining 500mm of 'unprotected' structural steel

THIS DRAWING AND ALL INFORMATION CONTAINED WITHIN IS THE PROPERTY OF LEWIS BRADFORD. ITS CONTENTS ARE CONFIDENTIAL AND MUST NOT BE REPRODUCED OR DISTRIBUTED TO ANY OTHER PERSON OR COMPANY UNLESS AGREED TO IN WRITING BY LEWIS BRADFORD

CONTRACTOR TO VERIFY ALL DIMENSIONS ON SITE REFER TO ARCHITECT'S DRAWING FOR ALL SETOUTS

NOTES:
Refer drawing 0002 for standard notes. Refer also to Structural Specification.

COLUMN LEGEND

1C1	100 x 6 SHS
1C2	150 x 9 SHS
1C3	150 x 100 x 5 RHS
1C4	200 x 100 x 9 RHS
1C5**	200 x 9 SHS**
1C6	200 UB 30
1C7*	310 UC 118*
1C7**	310 UC 118**
1C8*	310 UC 137*
1C9**	310 UC 158**
1C10*	350 WC 197*
1C10**	350 WC 197**
1C11	600 WB 197
1C12	140 x 140 GLB post

FLOOR LEGEND

TYPE 10 90 thick insitu topping on 25 timber infills (300 interspan ribs to hatched areas) reinforce with HD10 at 110 crs. e.w. with 30 top and bottom trimmer bars to all edges, corners and openings.

FLOOR TYPE 12 80-165 thick insitu topping on 25 timber infills (250 interspan ribs at 900 max. crs. e.w. to hatched areas) reinforce with HD10 at 200 crs. e.w. with 30 top and bottom trimmer bars to all edges, corners and openings. refer plans for additional reinforcing.


SLAB TYPE 1A 150 thick insitu concrete slab reinforced with S82 class 20mm top cover on 50mm min. compacted hardcore. HD12 trimmer bars to all edges, corners and openings. refer plans for additional reinforcing.

Approved for Issue
27/02/2020

Invercargill City Council
Building Consent Authority
Approved Site Copy

REV	DATE	AMENDMENT	BY
2	25.10.19	CONSENT ISSUE	GPW
1	27.09.19	PEER REVIEW ISSUE	GPW

CLIENT:
HWCP

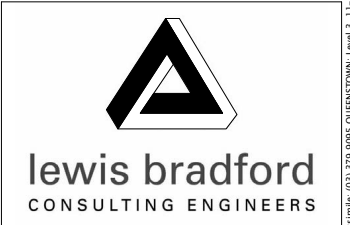

PROJECT:
**INVERCARGILL CENTRAL
ZONE 1 ANCHOR**

DRAWING TITLE:
**LEVEL 2
PART PLAN B**

DRAWN: GPW	SCALE: 1 : 100 at A1
ENGINEER: EL/TSS	
CHECKED: -	
118083-Z1-WD-ST 1123	REV. 2

LEVEL 2 - PART PLAN B
1 : 100

17 Dec 2019

Building Division

BUILDING CONSENT NUMBER


2019/1381

THIS DRAWING AND ALL INFORMATION CONTAINED WITHIN IS THE PROPERTY OF LEWIS BRADFORD. ITS CONTENTS ARE CONFIDENTIAL AND MUST NOT BE REPRODUCED OR DISTRIBUTED TO ANY OTHER PERSON OR COMPANY UNLESS AGREED TO IN WRITING BY LEWIS BRADFORD

CONTRACTOR TO VERIFY ALL DIMENSIONS ON SITE
REFER TO ARCHITECT'S DRAWING FOR ALL SETOUTS

NOTES :

Refer drawing 0002 for standard notes.
Refer also to Structural Specification.

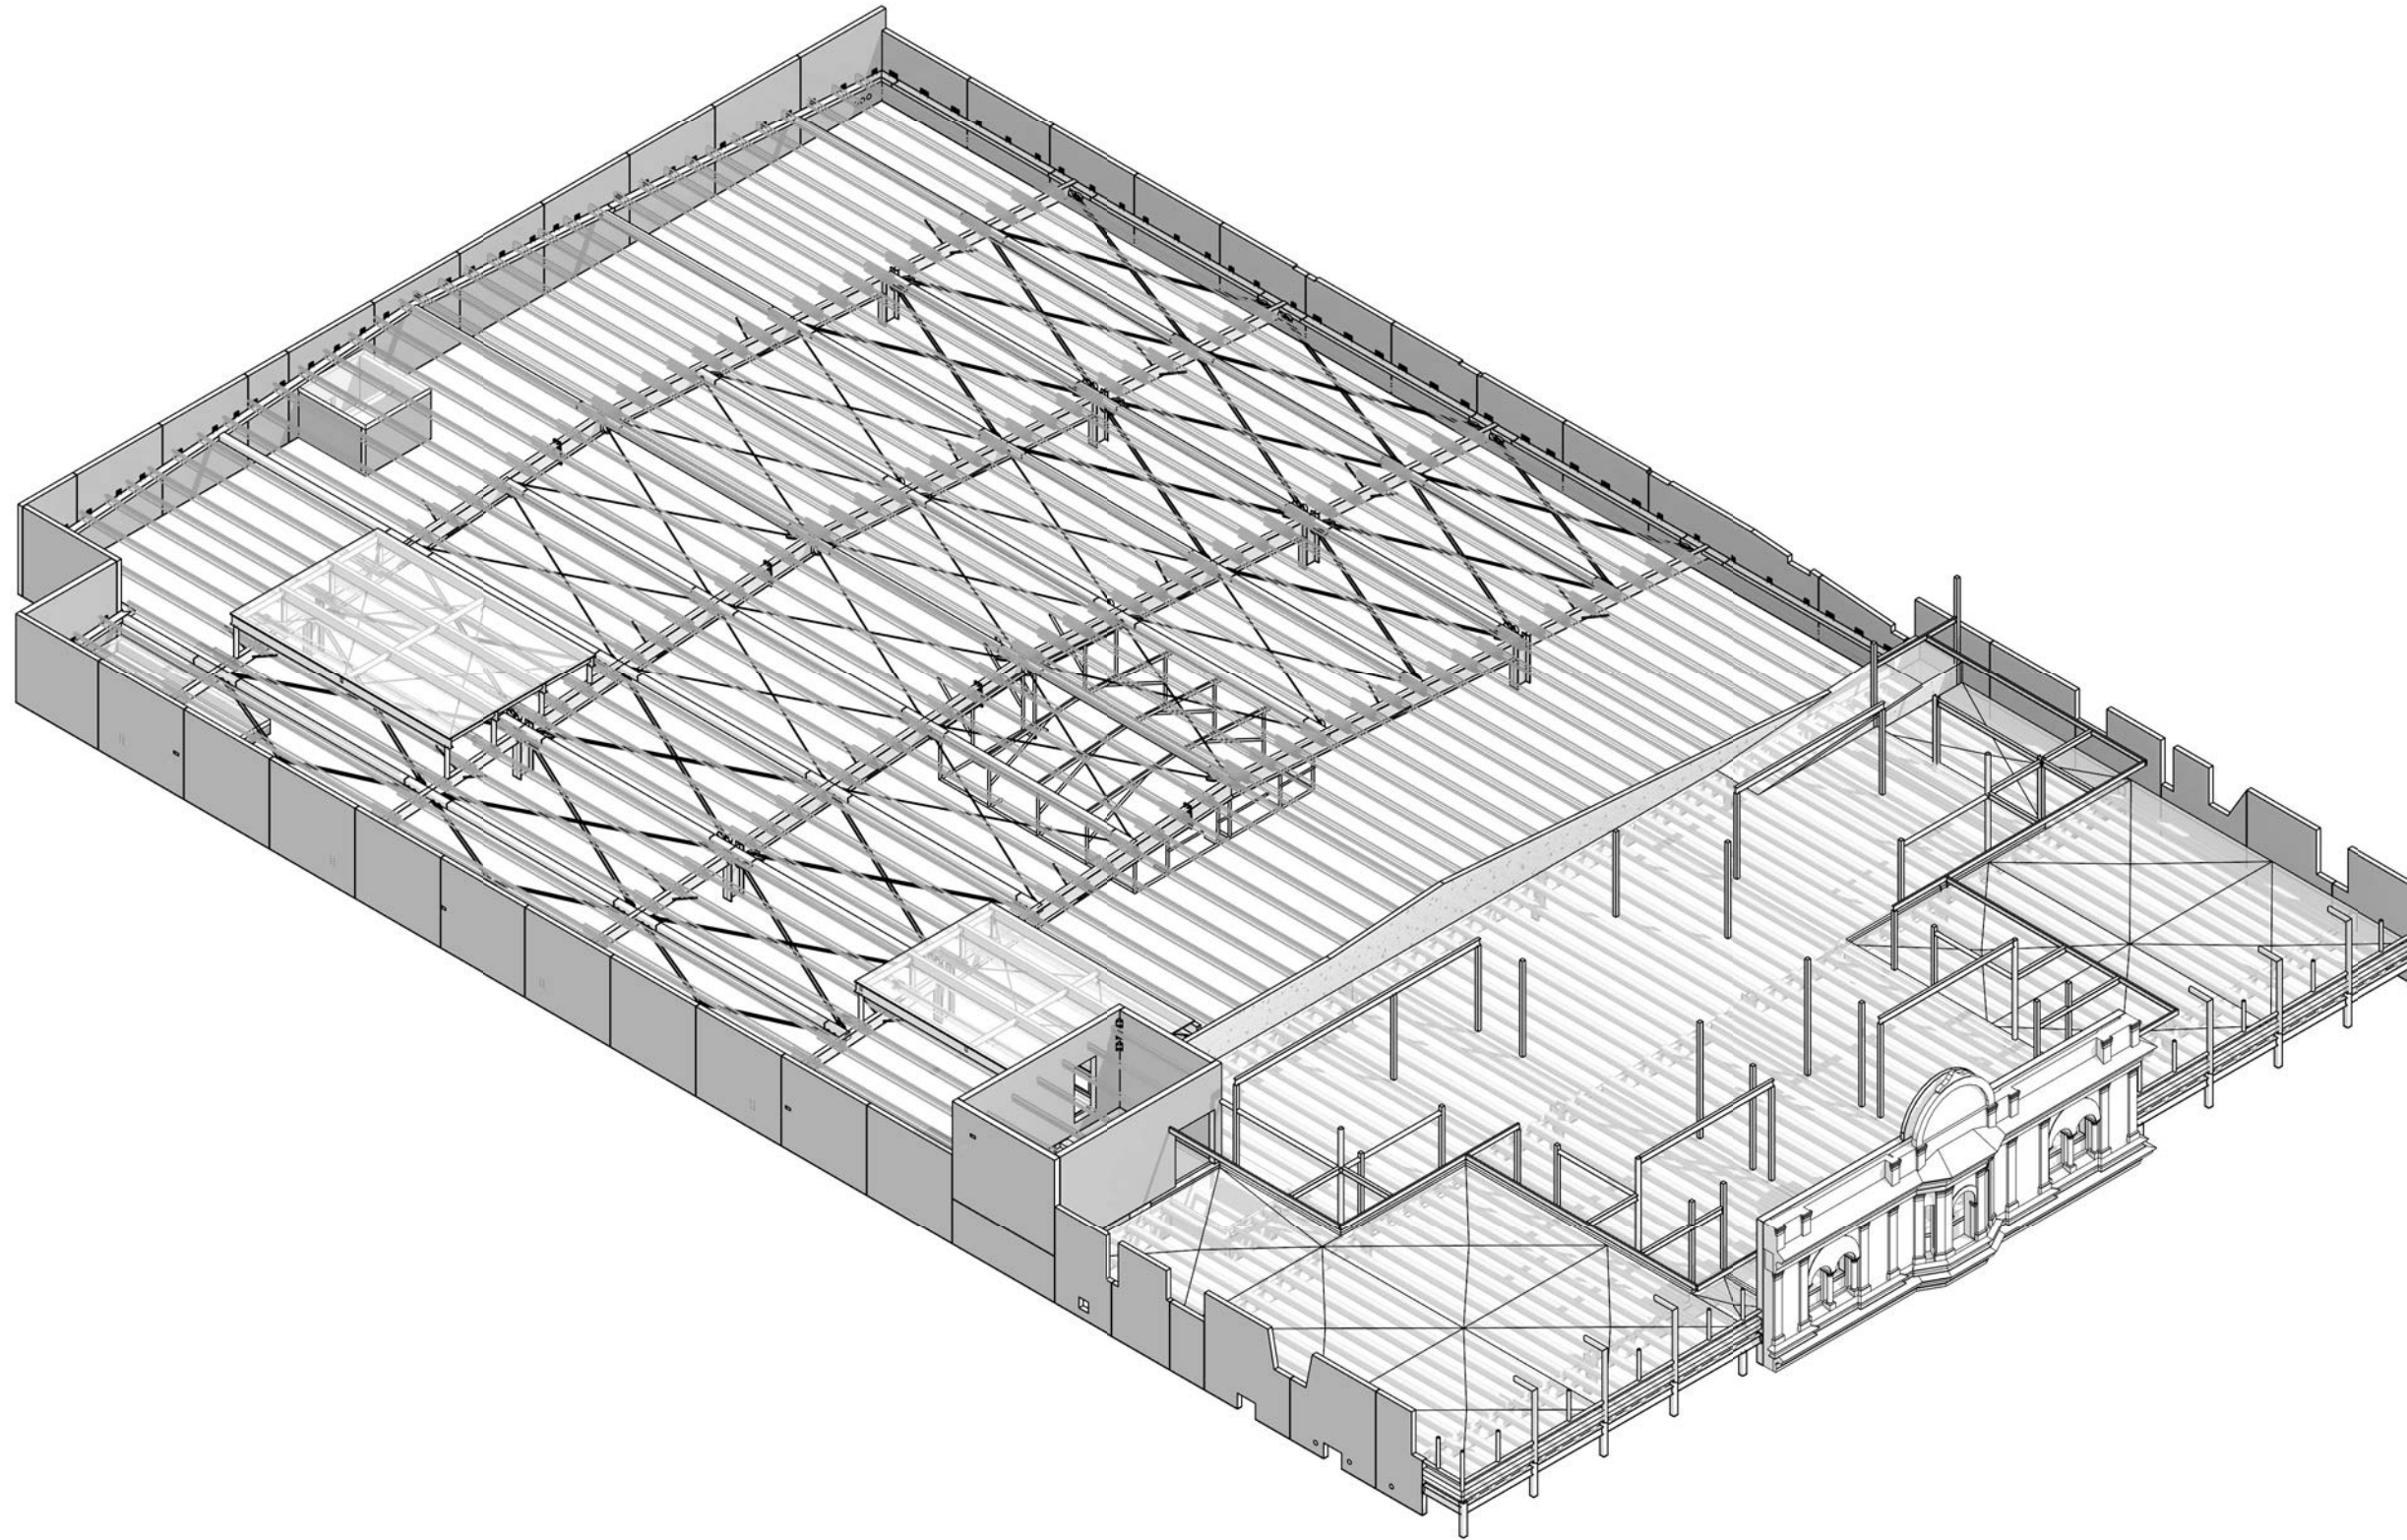


Invercargill City
Council
Building Consent
Authority
Approved Site Copy

Approved For Issue
27/02/2020

REV	DATE	AMENDMENT	BY
2	25.10.19	CONSENT ISSUE	GPW
1	27.09.19	PEER REVIEW ISSUE	GPW

CLIENT:
HWCP

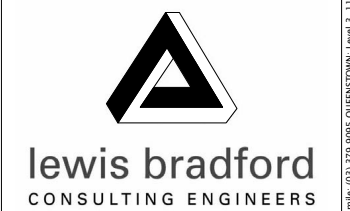


PROJECT:
**INVERCARGILL CENTRAL
ZONE 1 ANCHOR**

DRAWING TITLE:
**ROOF
3D VIEW**

DRAWN: GPW	SCALE:
ENGINEER: EL/TSS	at A1
CHECKED: -	
118083-Z1-WD-ST 1200	REV. 2

BUILDING CONSENT NUMBER
2019/1381

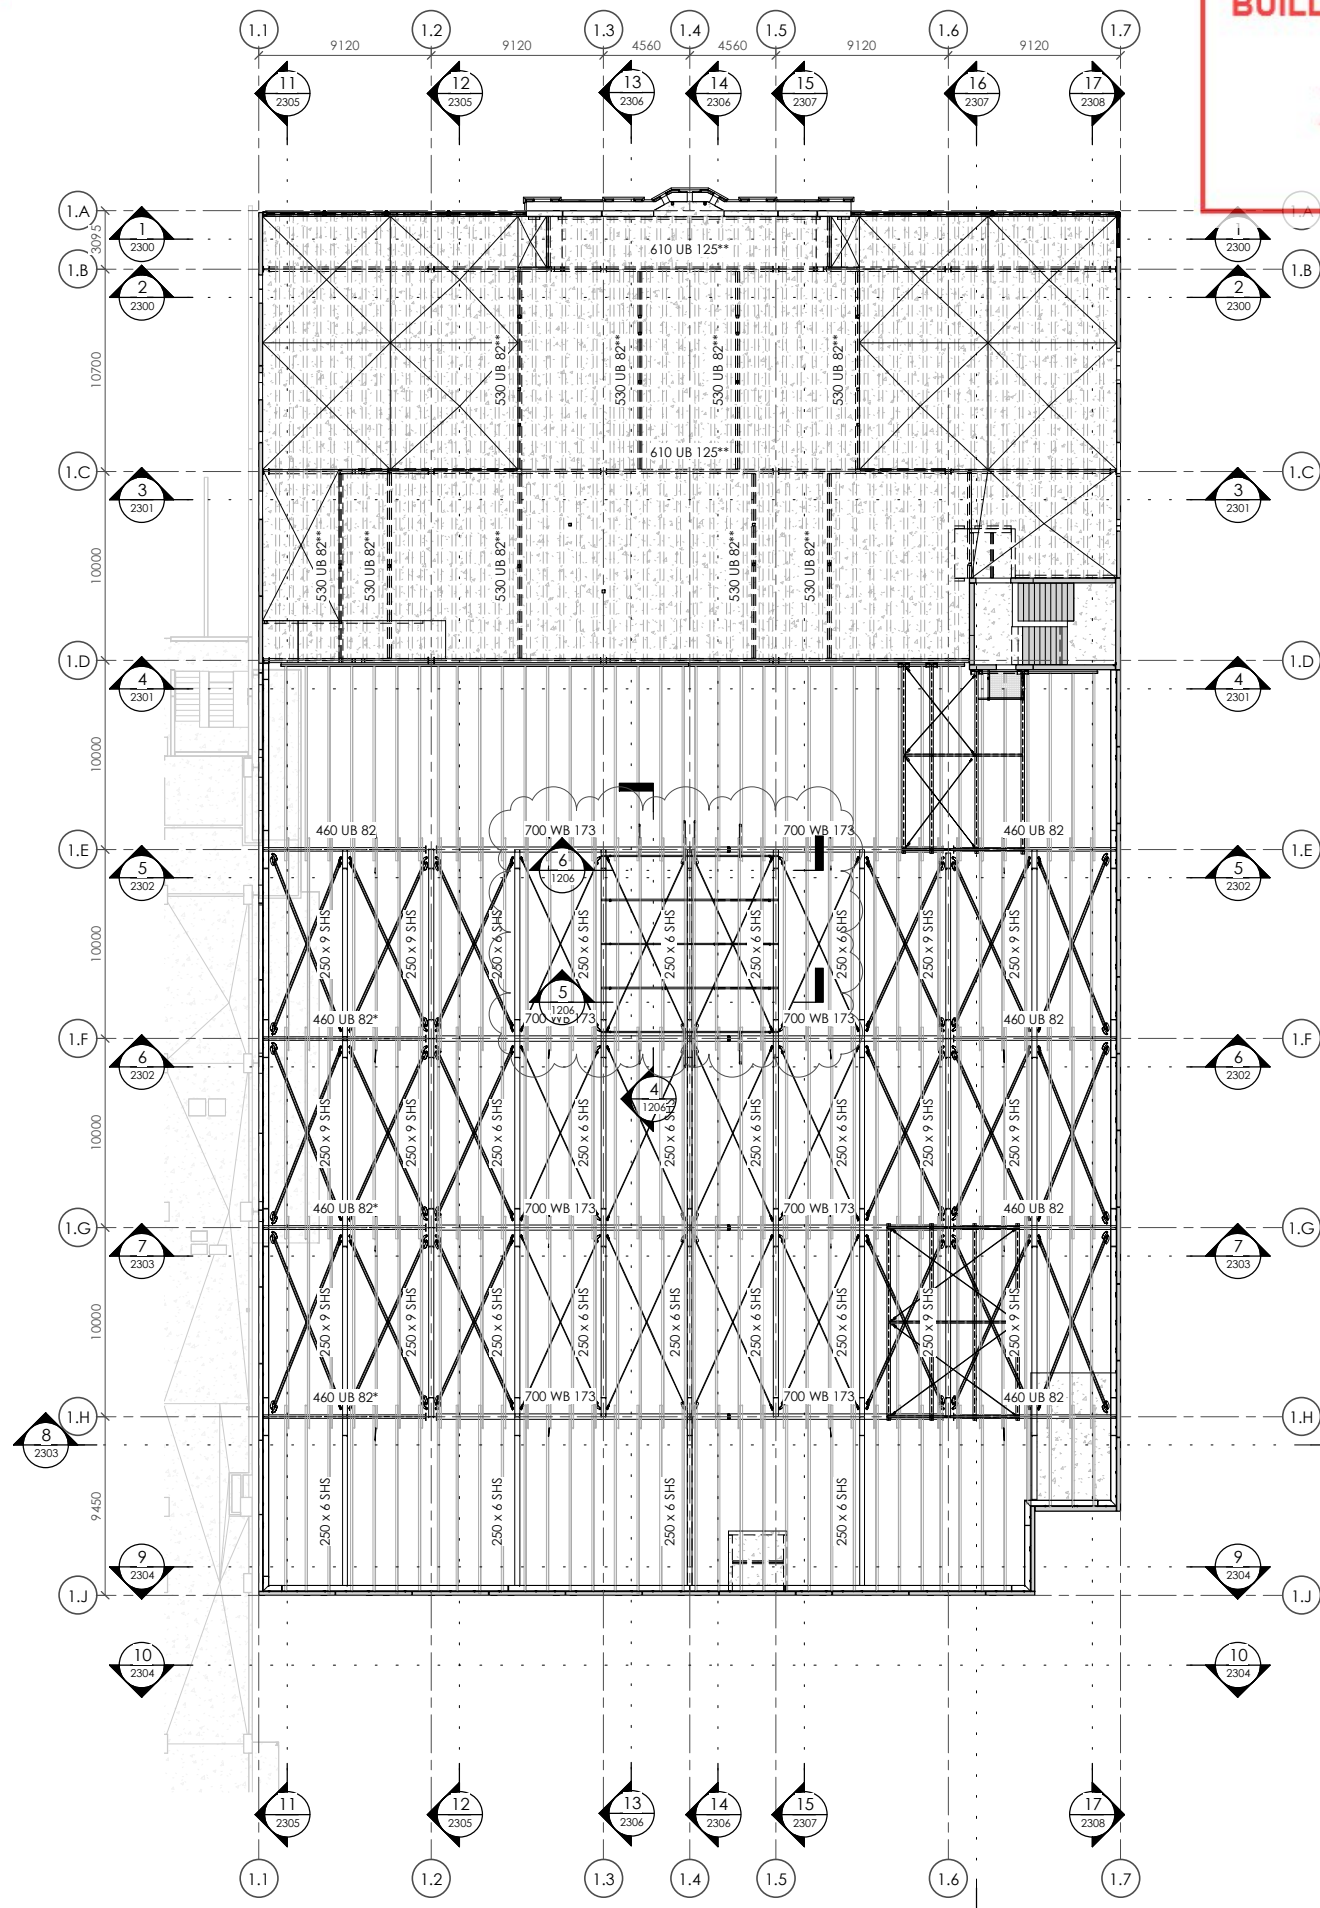

ROOF - OVERALL PLAN
 1 : 200

THIS DRAWING AND ALL INFORMATION CONTAINED WITHIN IS THE PROPERTY OF LEWIS BRADFORD. ITS CONTENTS ARE CONFIDENTIAL AND MUST NOT BE REPRODUCED OR DISTRIBUTED TO ANY OTHER PERSON OR COMPANY UNLESS AGREED TO IN WRITING BY LEWIS BRADFORD

CONTRACTOR TO VERIFY ALL DIMENSIONS ON SITE REFER TO ARCHITECT'S DRAWING FOR ALL SETOUTS

NOTES :

Refer drawing 0002 for standard notes.
 Refer also to Structural Specification.

COLUMN LEGEND

1C1	100 x 6 SHS
1C2	150 x 9 SHS
1C3	150 x 100 x 5 RHS
1C4	200 x 100 x 9 RHS
1C5**	200 x 9 SHS**
1C6	200 UB 30
1C7*	310 UC 118*
1C7**	310 UC 118**
1C8*	310 UC 137*
1C8**	310 UC 137**
1C9**	310 UC 158**
1C10*	350 WC 197*
1C10**	350 WC 197**
1C11	600 WB 197
1C12	140 x 140 GLB post

FLOOR LEGEND


FLC10B	90 thick insitu topping on 25 timber infill
TYPE 11	80-165 thick insitu topping on 25 timber infill (300 interspan ribs to hatched areas) reinforce with HD10 @ 200 crs. e.w. with 30 trimmer bars to all edges, corners and openings.
FLOOR	80-165 thick insitu topping on 25 timber infill (300 interspan ribs to hatched areas) reinforce with HD10 @ 200 crs. e.w. with 30 trimmer bars to all edges, corners and openings. refer plans for additional reinforcing.
TYPE 12	80-165 thick insitu topping on 25 timber infill (300 interspan ribs to hatched areas) reinforce with HD10 @ 200 crs. e.w. with 30 trimmer bars to all edges, corners and openings. refer plans for additional reinforcing.
SLAB	150 thick insitu concrete slab reinforced with SB2 @ 150mm top cover on min. compacted hardcore. HD12 trimmer bars to all edges, corners and openings. refer plans for additional reinforcing.
TYPE 1A	150 thick insitu concrete slab reinforced with SB2 @ 150mm top cover on min. compacted hardcore. HD12 trimmer bars to all edges, corners and openings. refer plans for additional reinforcing.

* indicates steel member to have 30 minutes fire rated paint protection (limiting temperature 550°C)
 ** indicates steel member to have 60 minutes fire rated paint protection (limiting temperature 550°C)
 *** indicates steel member to have 120 minutes fire rated paint protection (limiting temperature 550°C)
 Where unprotected areas of steelwork meet fire protected elements overlap the fire protection onto the adjoining 500mm of 'unprotected' structural steel

Invercargill City Council
 Building Consent Authority
 Approved Site Copy
 Approved for Issue
 27/02/2020

2	25.10.19	CONSENT ISSUE	GPW
1	27.09.19	PEER REVIEW ISSUE	GPW
REV	DATE	AMENDMENT	BY

CLIENT:
HWCP

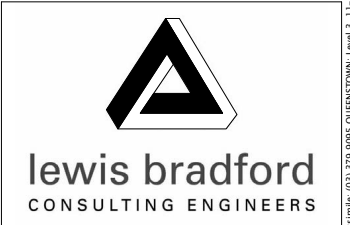

PROJECT:
INVERCARGILL CENTRAL ZONE 1 ANCHOR


DRAWING TITLE:
ROOF OVERALL PLAN

DRAWN:	GPW	SCALE:	1 : 200 at A1
ENGINEER:	EL/TSS		
CHECKED:	-		
118083-Z1-WD-ST 1201			REV. 2

17 Dec 2019

Building Division

BUILDING CONSENT NUMBER
2019/1381

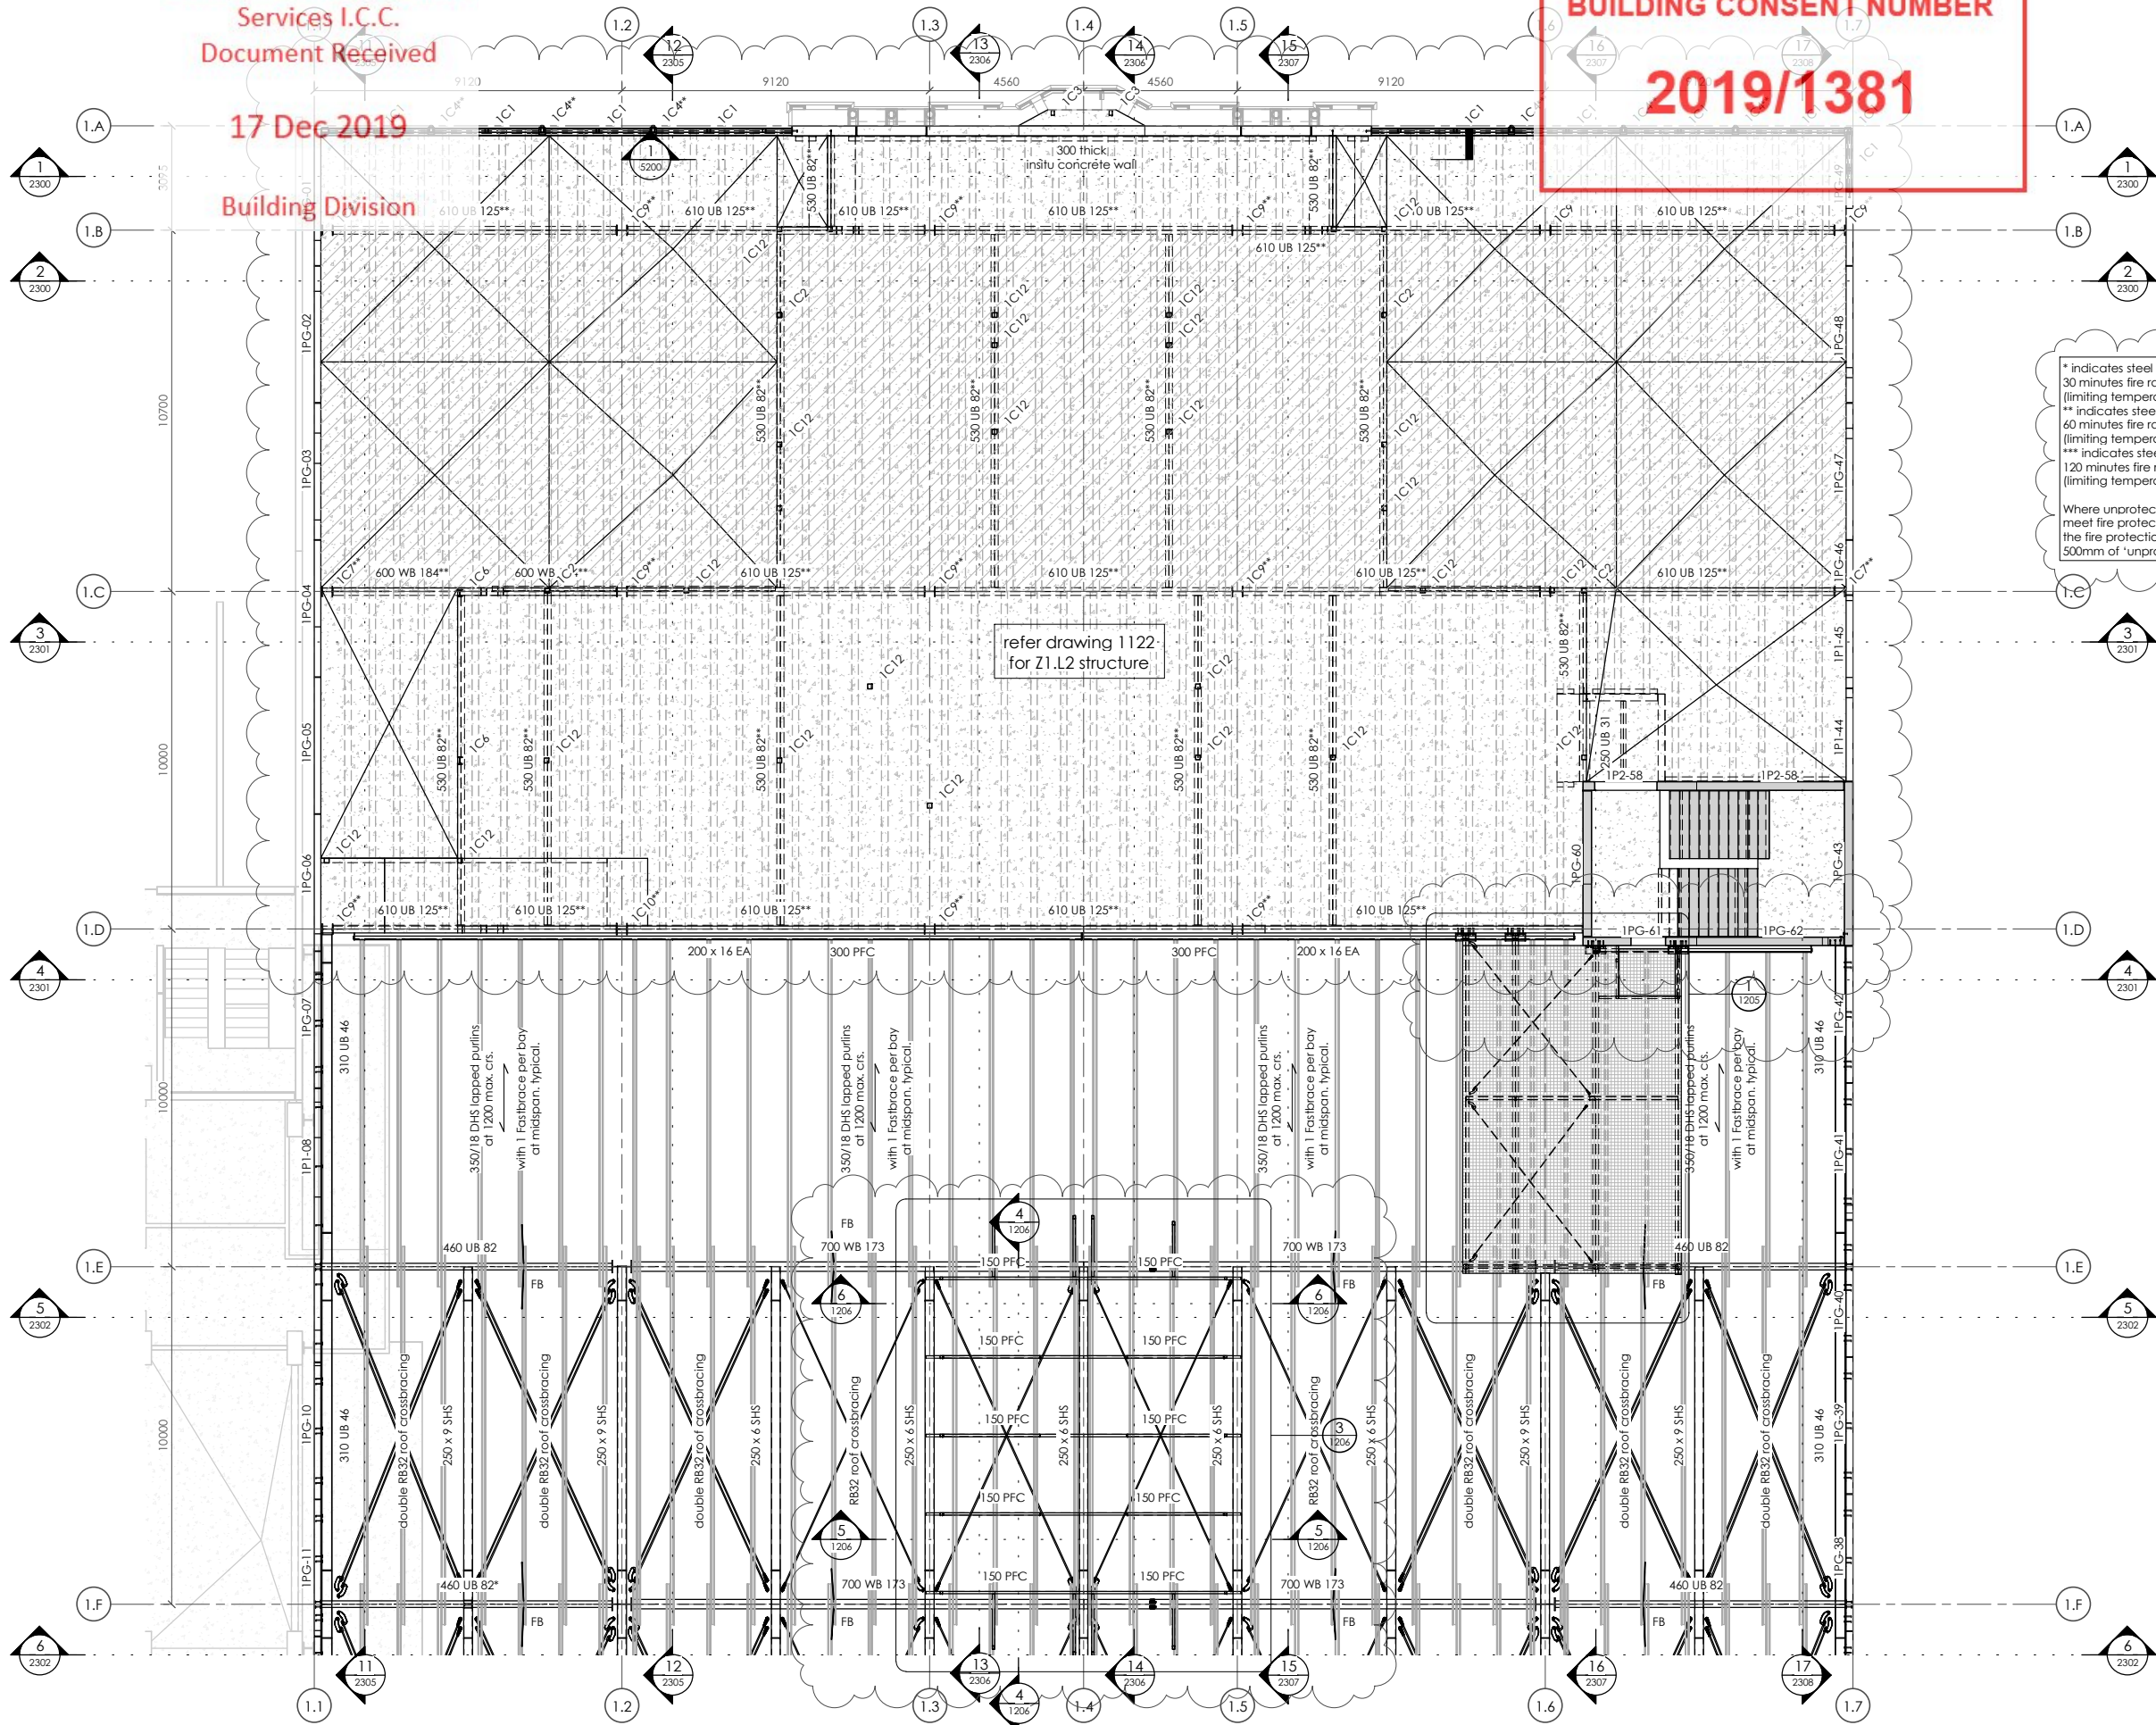

THIS DRAWING AND ALL INFORMATION CONTAINED WITHIN IS THE PROPERTY OF LEWIS BRADFORD. ITS CONTENTS ARE CONFIDENTIAL AND MUST NOT BE REPRODUCED OR DISTRIBUTED TO ANY OTHER PERSON OR COMPANY UNLESS AGREED TO IN WRITING BY LEWIS BRADFORD

CONTRACTOR TO VERIFY ALL DIMENSIONS ON SITE REFER TO ARCHITECT'S DRAWING FOR ALL SETOUTS

NOTES:
Refer drawing 0002 for standard notes. Refer also to Structural Specification.

COLUMN LEGEND

IC1	100 x 6 SHS
IC2	150 x 9 SHS
IC3	150 x 100 x 5 RHS
IC4	200 x 100 x 9 RHS
IC5**	200 x 9 SHS**
IC6	200 UB 30
IC7*	310 UC 118*
IC7**	310 UC 118**
IC8*	310 UC 137*
IC8**	310 UC 137**
IC9**	310 UC 158**
IC10*	350 WC 197*
IC10**	350 WC 197**
IC11	600 WB 197
IC12	140 x 140 GLB post

FLOOR LEGEND

FLOOR	90 thick insitu topping on 200mm crs. (300 interspan ribs to hatched areas) reinforce with HD10 @ 210 crs. e.w. with 30 top and bottom trimmer bars to all edges, corners and openings.
FLOOR TYPE 12	80-165 thick insitu topping on 25 timber infill @ 250 interspan ribs at 900 max. crs. (300 interspan ribs to hatched areas) reinforce with HD10 @ 200 crs. e.w. with 30 top and bottom trimmer bars to all edges, corners and openings. refer plans for additional reinforcing.
SLAB	150 thick insitu concrete slab reinforced with SF82 @ 50mm top cover on 150mm crs. (300 interspan ribs to hatched areas) min. compacted hardfill, HD12 trimmer bars to all edges, corners and openings. refer plans for additional reinforcing.


* indicates steel member to have 30 minutes fire rated paint protection (limiting temperature 550°C)
** indicates steel member to have 60 minutes fire rated paint protection (limiting temperature 550°C)
*** indicates steel member to have 120 minutes fire rated paint protection (limiting temperature 550°C)

Where unprotected areas of steelwork meet fire protected elements provide the fire protection onto the adjoining 500mm of 'unprotected' structural steel

Invercargill City Council
Building Consent Authority
Approved Site Copy
Approved for Issue
27/02/2020

2	25.10.19	CONSENT ISSUE	GPW
1	27.09.19	PEER REVIEW ISSUE	GPW
REV	DATE	AMENDMENT	BY

CLIENT:
HWCP

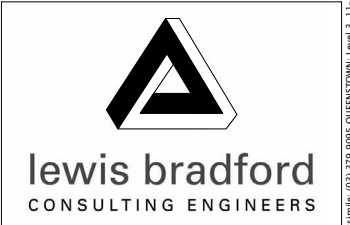

PROJECT:
**INVERCARGILL CENTRAL
ZONE 1 ANCHOR**

DRAWING TITLE:
**ROOF
PART PLAN A**

DRAWN:	GPW	SCALE:	1 : 100 at A1
ENGINEER:	EL/TSS		
CHECKED:	-		
118083-Z1-WD-ST 1202		REV.	2

ROOF - PART PLAN A
1 : 100

17 Dec 2019

Building Division

BUILDING CONSENT NUMBER
2019/1381

THIS DRAWING AND ALL INFORMATION CONTAINED WITHIN IS THE PROPERTY OF LEWIS BRADFORD. ITS CONTENTS ARE CONFIDENTIAL AND MUST NOT BE REPRODUCED OR DISTRIBUTED TO ANY OTHER PERSON OR COMPANY UNLESS AGREED TO IN WRITING BY LEWIS BRADFORD

CONTRACTOR TO VERIFY ALL DIMENSIONS ON SITE REFER TO ARCHITECT'S DRAWING FOR ALL SETOUTS

NOTES:
Refer drawing 0002 for standard notes.
Refer also to Structural Specification.

COLUMN LEGEND

1C1	100 x 6 SHS
1C2	150 x 9 SHS
1C3	150 x 100 x 5 RHS
1C4	200 x 100 x 9 RHS
1C5**	200 x 9 SHS**
1C6	200 UB 30
1C7*	310 UC 118*
1C7**	310 UC 118**
1C8*	310 UC 137*
1C8**	310 UC 137**
1C9**	310 UC 158**
1C10*	350 WC 197*
1C10**	350 WC 197**
1C11	600 WB 197
1C12	140 x 140 GL8 post

FLOOR LEGEND

Where unprotected areas of steelwork meet fire protected elements cavities the fire protection onto the adjoining 500mm of 'unprotected' structural steel

ROOF 90 thick insitu topping on 25 timber infills (300 interspan ribs to hatched areas) reinforce with HD10 @ 200 crs. e.w. with 30 trimmer bars to all edges, corners and openings.


FLOOR 80-165 thick insitu topping on 25 timber infills (300 interspan ribs to hatched areas) reinforce with HD10 @ 200 crs. e.w. with 30 trimmer bars to all edges, corners and openings. refer plans for additional reinforcing.

Approved for Issue
27/02/2020

Invercargill City Council
Building Consent Authority
Approved Site Copy

REV	DATE	AMENDMENT	BY
2	25.10.19	CONSENT ISSUE	GPW
1	27.09.19	PEER REVIEW ISSUE	GPW


CLIENT:
HWCP

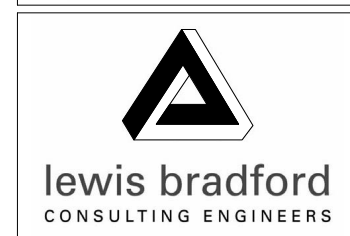

PROJECT:
INVERCARGILL CENTRAL ZONE 1 ANCHOR

DRAWING TITLE:
ROOF PART PLAN B

DRAWN: GPW	SCALE: 1 : 100 at A1
ENGINEER: EL/TSS	
CHECKED: -	
118083-Z1-WD-ST 1203	REV. 2

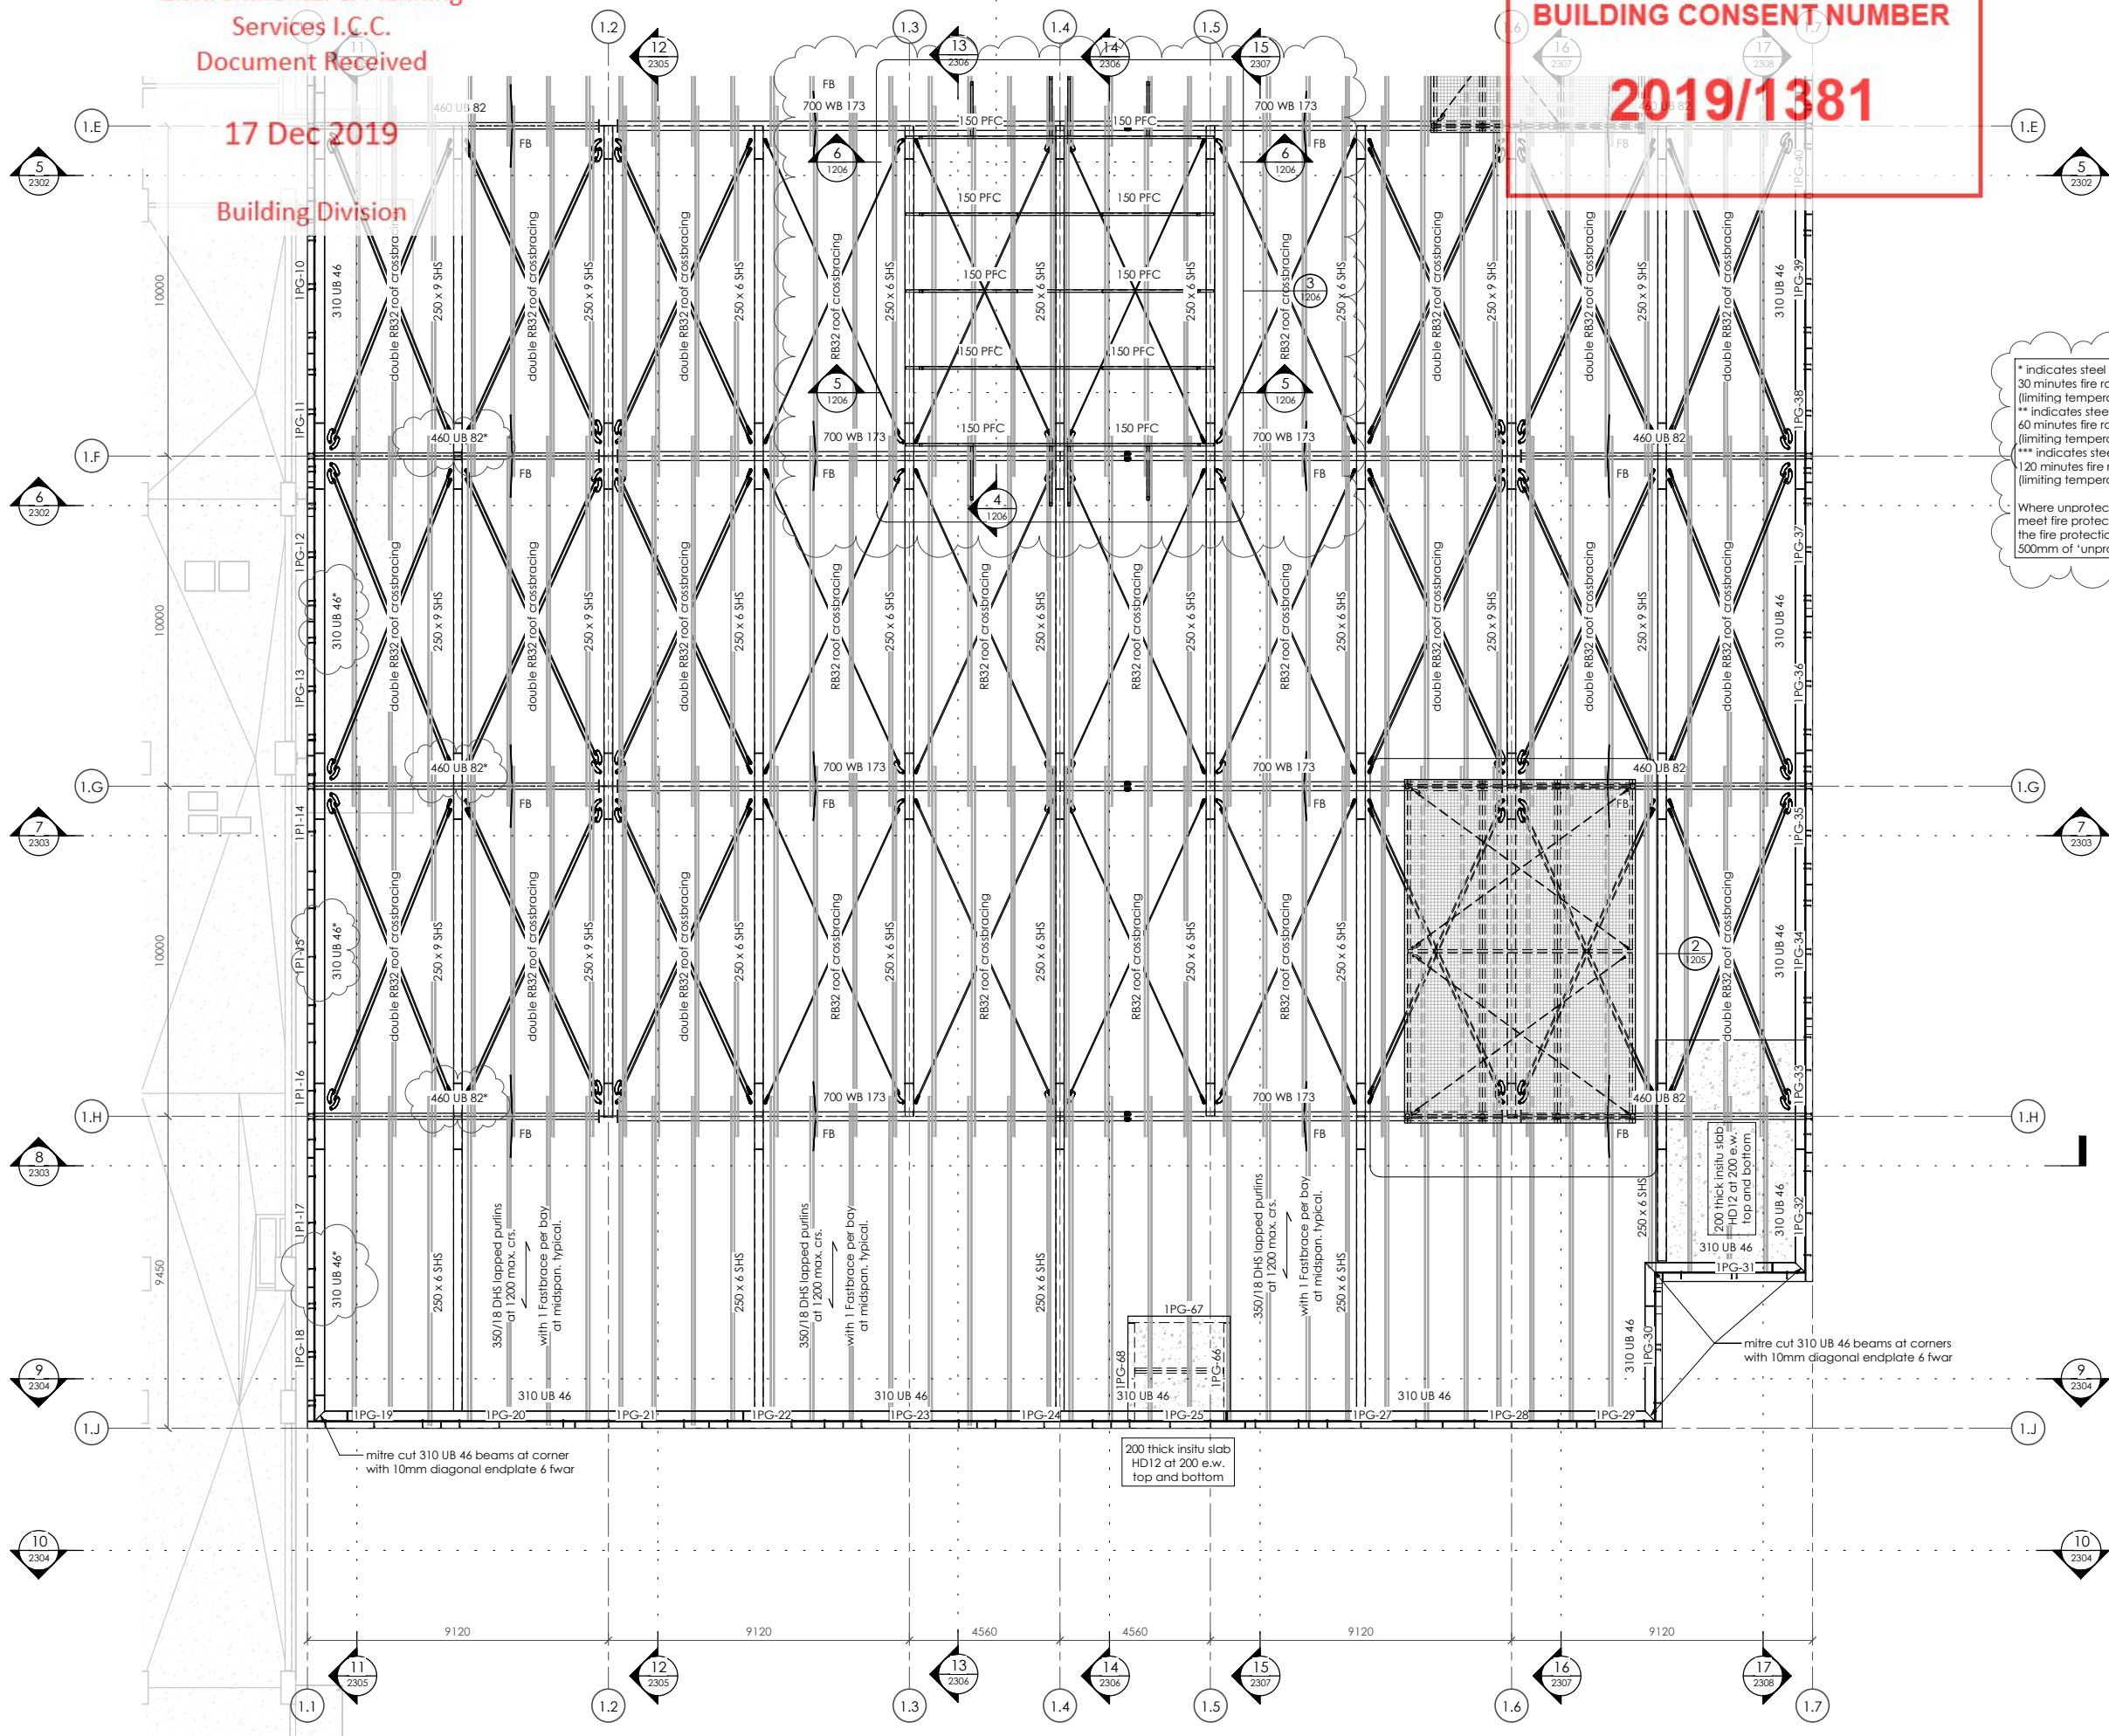

ROOF - PART PLAN B
1 : 100

17 Dec 2019

Building Division

BUILDING CONSENT NUMBER
2019/1381

THIS DRAWING AND ALL INFORMATION CONTAINED WITHIN IS THE PROPERTY OF LEWIS BRADFORD. ITS CONTENTS ARE CONFIDENTIAL AND MUST NOT BE REPRODUCED OR DISTRIBUTED TO ANY OTHER PERSON OR COMPANY UNLESS AGREED TO IN WRITING BY LEWIS BRADFORD

CONTRACTOR TO VERIFY ALL DIMENSIONS ON SITE REFER TO ARCHITECT'S DRAWING FOR ALL SETOUTS

NOTES:
Refer drawing 0002 for standard notes.
Refer also to Structural Specification.

COLUMN LEGEND

IC1	100 x 6 SHS
IC2	150 x 9 SHS
IC3	150 x 100 x 5 RHS
IC4	200 x 100 x 9 RHS
IC5**	200 x 9 SHS**
IC6	200 UB 30
IC7*	310 UC 118*
IC7**	310 UC 118**
IC8*	310 UC 137*
IC9**	310 UC 158**
IC10*	350 WC 197*
IC10**	350 WC 197**
IC11	600 WB 197
IC12	140 x 140 GL8 post

FLOOR LEGEND

FLY	90 thick insitu topping on 25 timber infills (300 interspan ribs to hatched areas) reinforce with HD10 @ 100 crs. e.w. with 30 timber chords and 2 trimmer bars to all edges, corners and openings.
FLOOR TYPE 12	80-165 thick insitu topping on 25 timber infills @ 250 interspan ribs at 900 max. crs. e.w. with 30 timber chords and 2 trimmer bars to all edges, corners and openings. reinforce with HD10 @ 200 crs. e.w. with 30 timber chords and 2 trimmer bars to all edges, corners and openings. refer plans for additional reinforcing.
SLAB TYPE 1A	150 thick insitu concrete slab reinforced with S82 @ 50mm top cover on min. compacted hardcore. HD12 trimmer bars to all edges, corners and openings. refer plans for additional reinforcing.

Approved for Issue
27/02/2020

REV	DATE	AMENDMENT	BY
2	25.10.19	CONSENT ISSUE	GPW
1	27.09.19	PEER REVIEW ISSUE	GPW

CLIENT:


HWCP



PROJECT:
**INVERCARGILL CENTRAL
ZONE 1 ANCHOR**

DRAWING TITLE:
**ROOF
CHILDCARE ROOF PLAN**

DRAWN: GPW	SCALE: 1 : 100 at A1
ENGINEER: EL/TSS	
CHECKED: -	
118083-Z1-WD-ST 1204	REV. 2

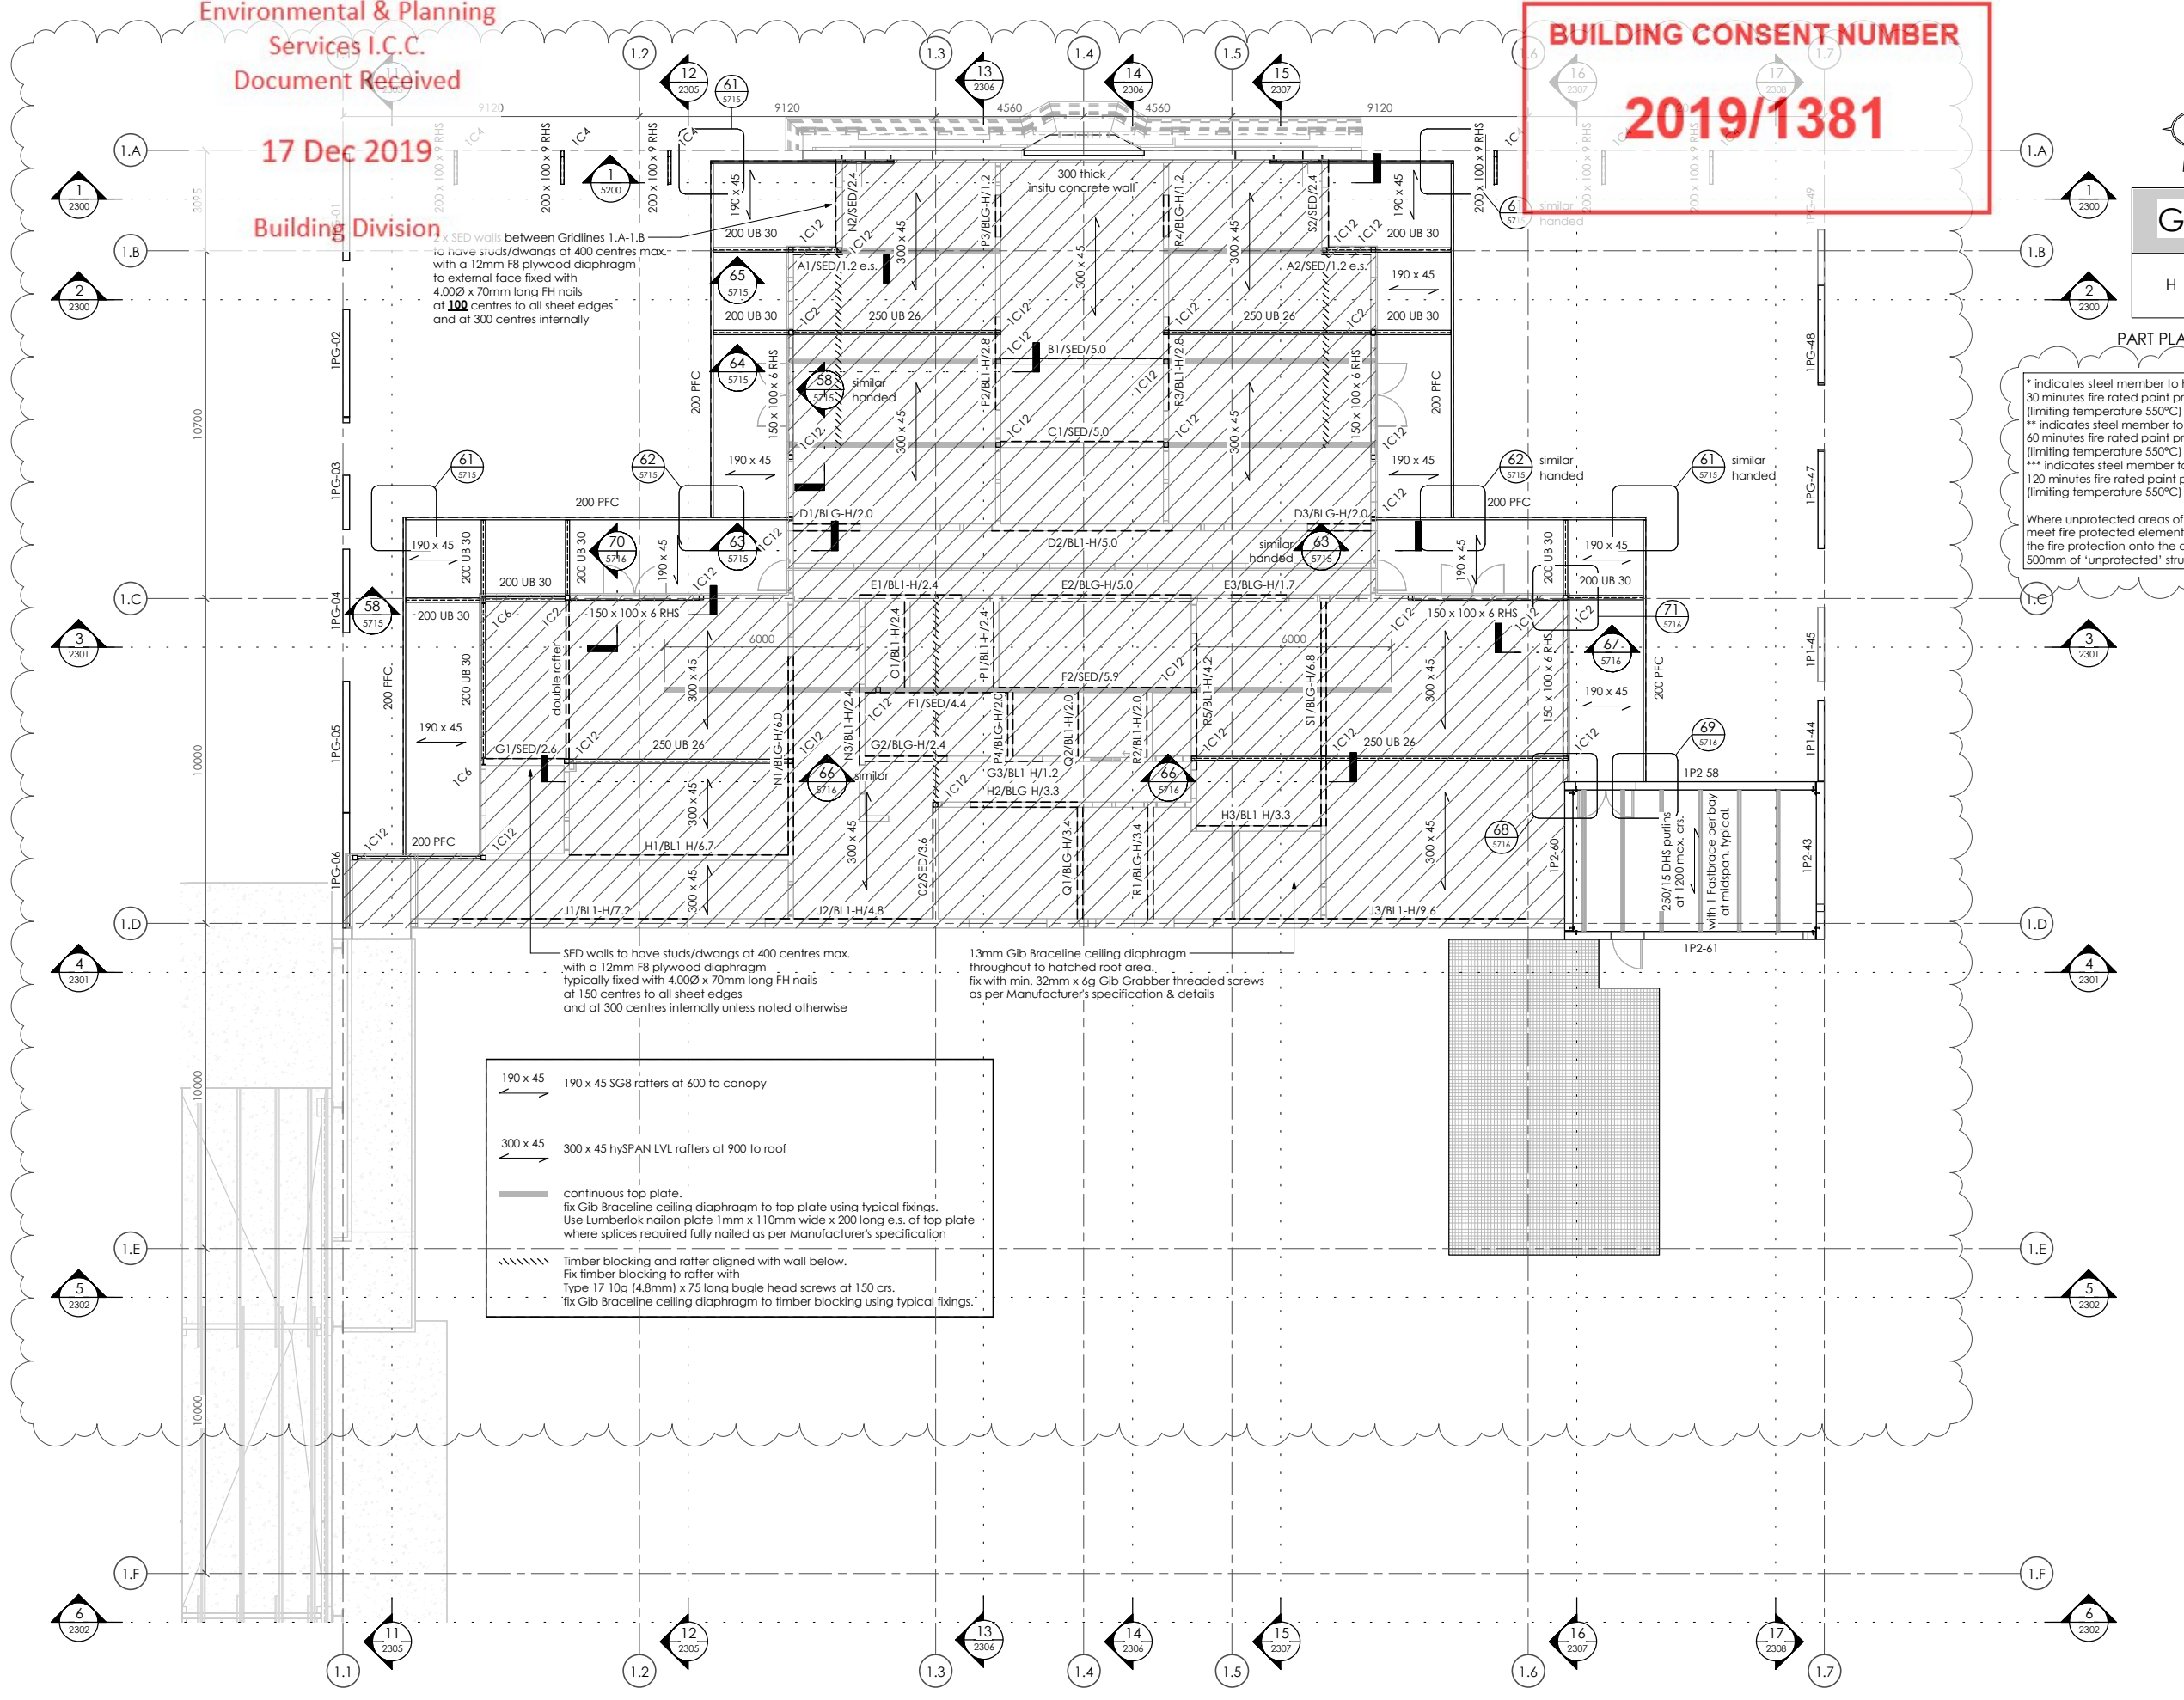

190 x 45 190 x 45 SG8 rafters at 600 to canopy
300 x 45 300 x 45 hySPAN LVL rafters at 900 to roof
continuous top plate.
fix Gib Bracelene ceiling diaphragm to top plate using typical fixings.
Use Lumberlok nailon plate 1mm x 110mm wide x 200 long e.s. of top plate where splices required fully nailed as per Manufacturer's specification
Timber blocking and rafter aligned with wall below.
Fix timber blocking to rafter with Type 17 10g (4.8mm) x 75 long bugle head screws at 150 crs.
fix Gib Bracelene ceiling diaphragm to timber blocking using typical fixings.



ROOF - CHILDCARE ROOF PLAN
1 : 100

17 Dec 2019

Building Division

BUILDING CONSENT NUMBER
2019/1381

MAXIMUM LIVE LOAD TO PLANT DECKS IS 250kg/m²

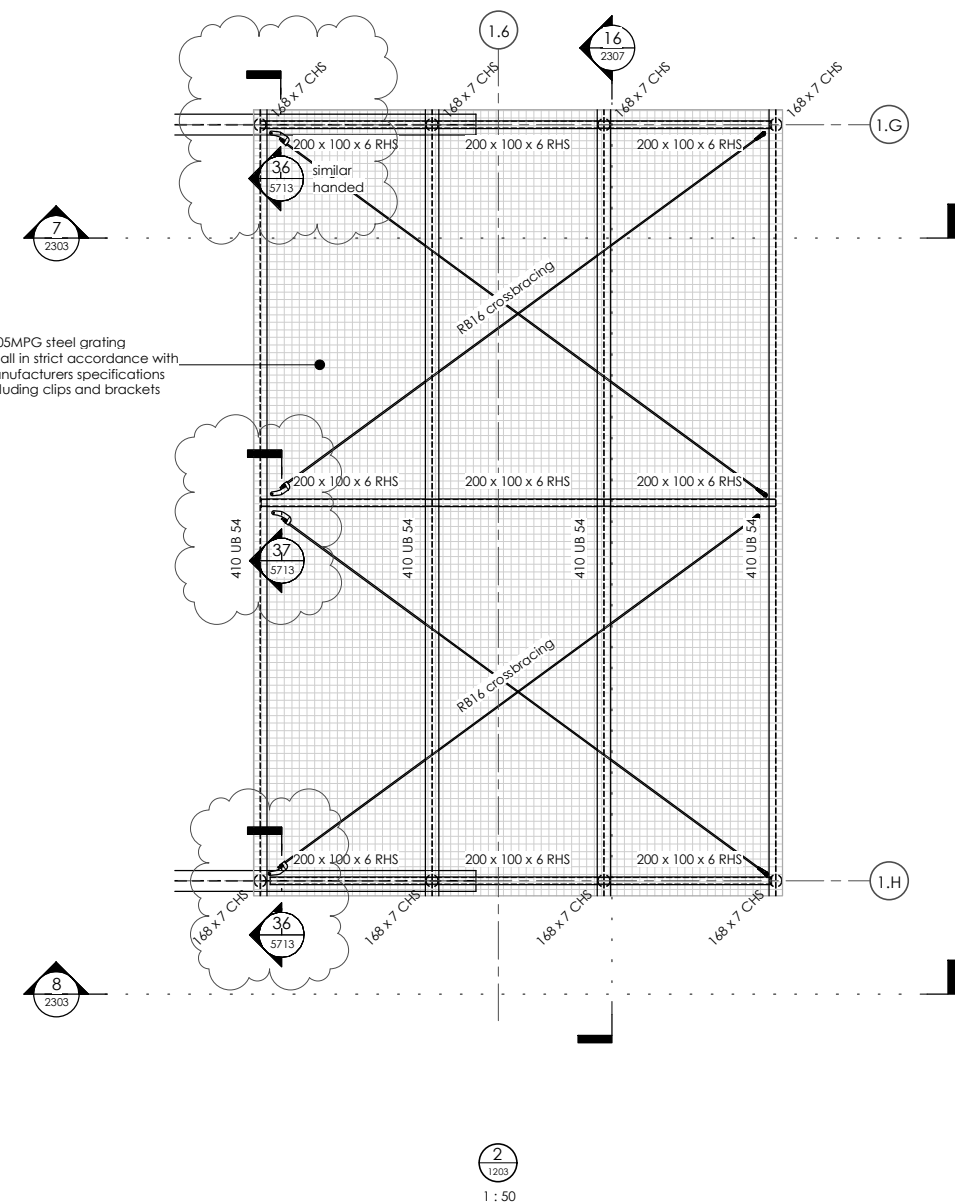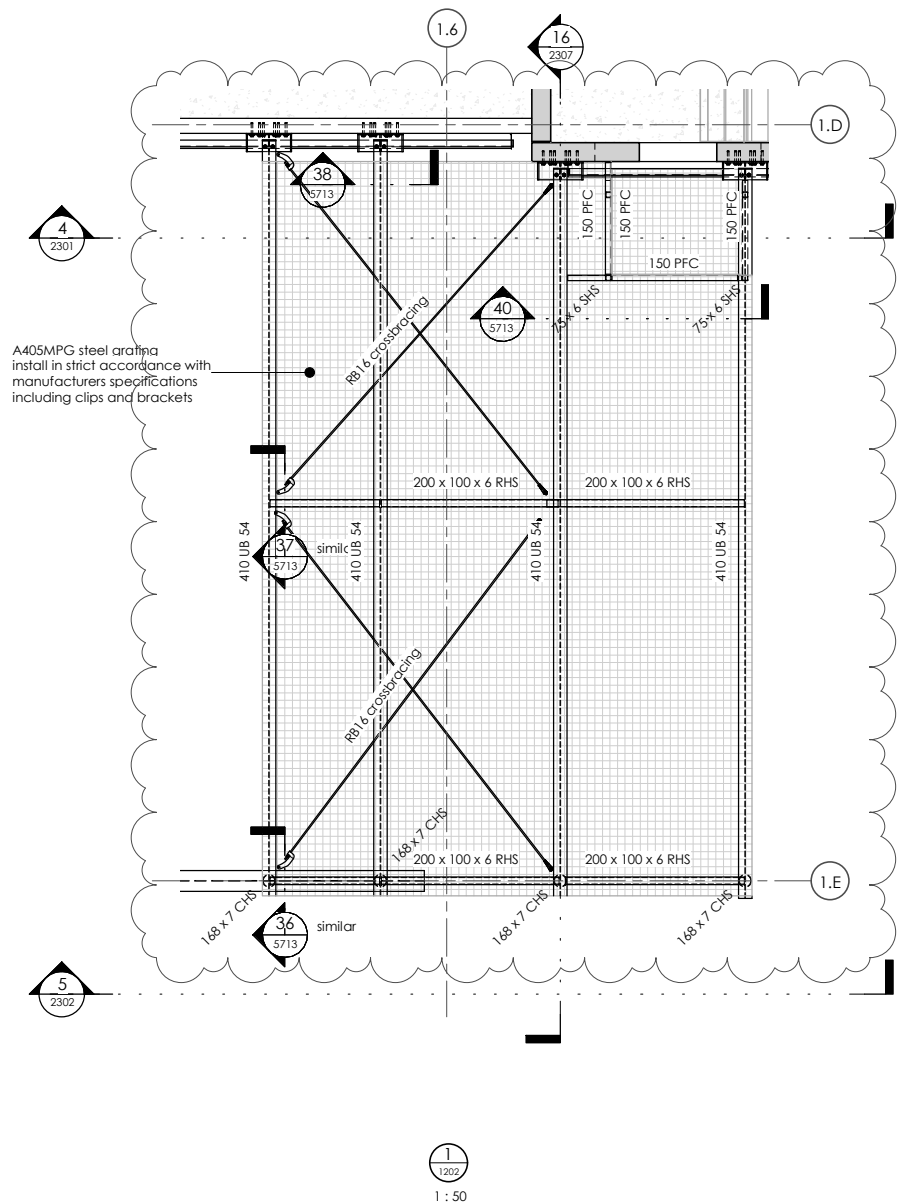

THIS DRAWING AND ALL INFORMATION CONTAINED WITHIN IS THE PROPERTY OF LEWIS BRADFORD. ITS CONTENTS ARE CONFIDENTIAL AND MUST NOT BE REPRODUCED OR DISTRIBUTED TO ANY OTHER PERSON OR COMPANY UNLESS AGREED TO IN WRITING BY LEWIS BRADFORD

CONTRACTOR TO VERIFY ALL DIMENSIONS ON SITE REFER TO ARCHITECT'S DRAWING FOR ALL SETOUTS

NOTES:
Refer drawing 0002 for standard notes.
Refer also to Structural Specification.

Invercargill City
Council
Building Consent
Authority
Approved Site Copy

Approved For Issue
27/02/2020

REV	DATE	AMENDMENT	BY
2	25.10.19	CONSENT ISSUE	GPW
1	27.09.19	PEER REVIEW ISSUE	GPW

CLIENT:
HWCP

lewis bradford
CONSULTING ENGINEERS

PROJECT:
**INVERCARGILL CENTRAL
ZONE 1 ANCHOR**

DRAWING TITLE:
**ROOF
PLANT DECK PLANS**

DRAWN: GPW	SCALE: 1 : 50 at A1
ENGINEER: EL/TSS	
CHECKED: -	
118083-Z1-WD-ST 1205	REV. 2

17 Dec 2019



Building Division

BUILDING CONSENT NUMBER
2019/1381

THIS DRAWING AND ALL INFORMATION CONTAINED WITHIN IS THE PROPERTY OF LEWIS BRADFORD. ITS CONTENTS ARE CONFIDENTIAL AND MUST NOT BE REPRODUCED OR DISTRIBUTED TO ANY OTHER PERSON OR COMPANY UNLESS AGREED TO IN WRITING BY LEWIS BRADFORD

CONTRACTOR TO VERIFY ALL DIMENSIONS ON SITE REFER TO ARCHITECT'S DRAWING FOR ALL SETOUTS

NOTES:
Refer drawing 0002 for standard notes.
Refer also to Structural Specification.

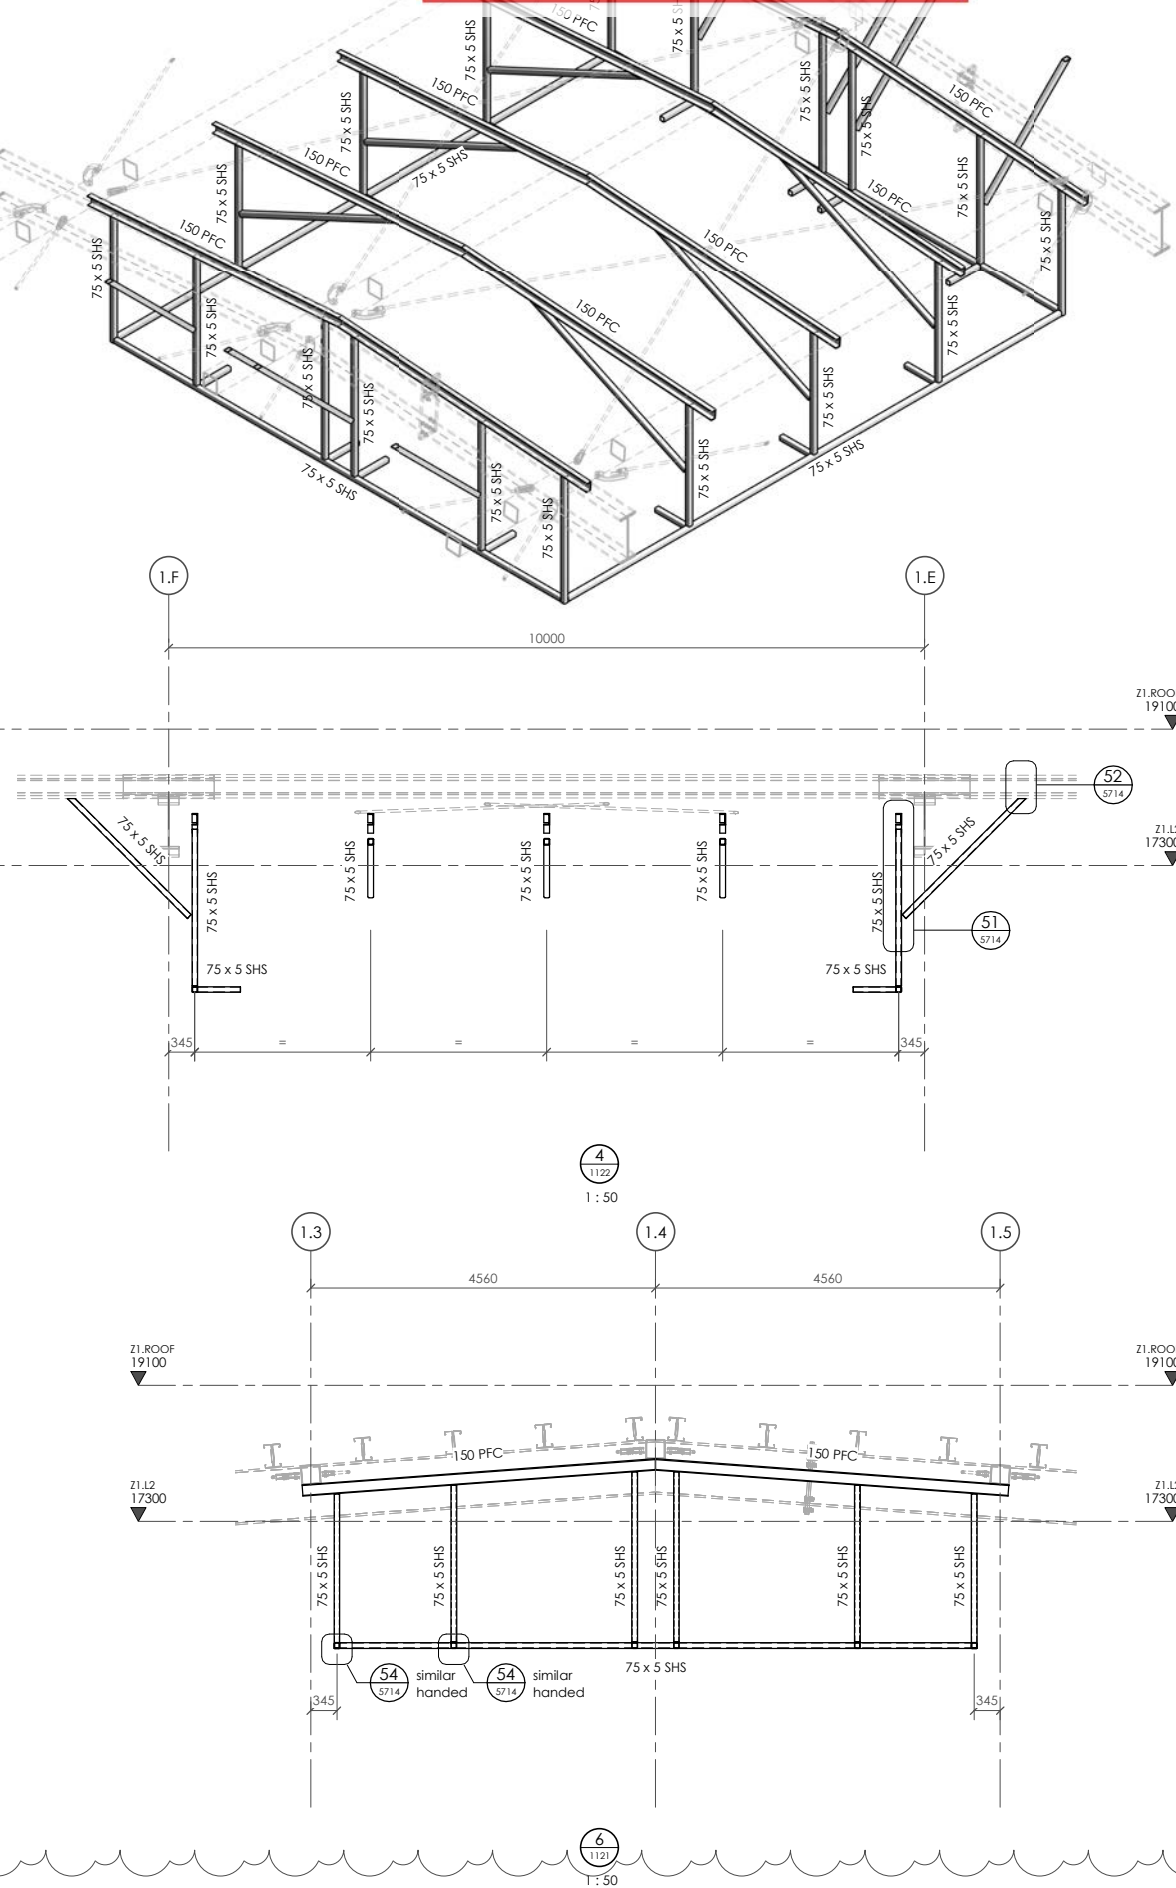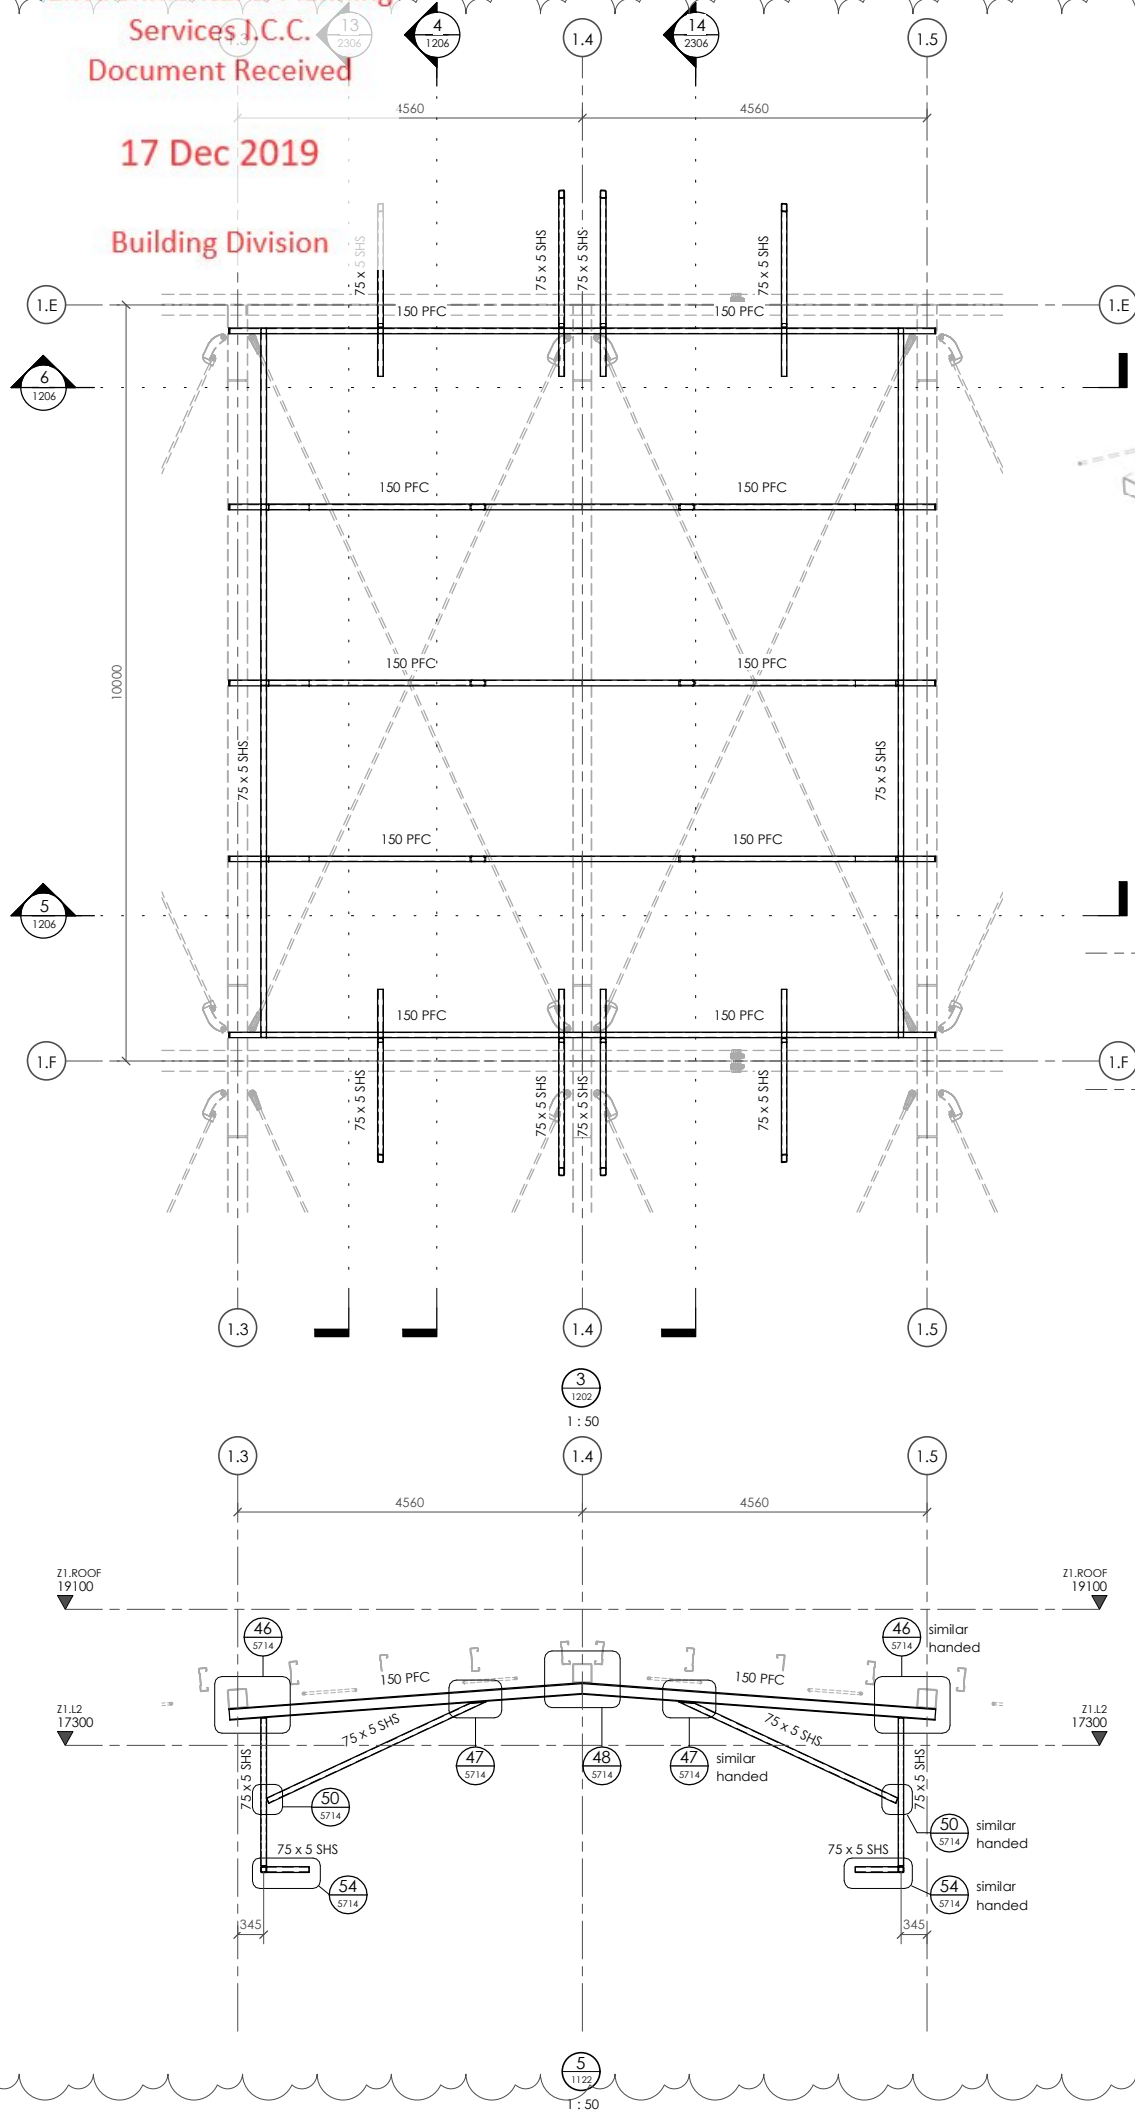


Invercargill City Council
Building Consent Authority
Approved Site Copy

Approved For Issue
27/02/2020

REV	DATE	CONSENT ISSUE	AMENDMENT	GPW
1	25.10.19	CONSENT ISSUE		GPW

CLIENT:
HWCP

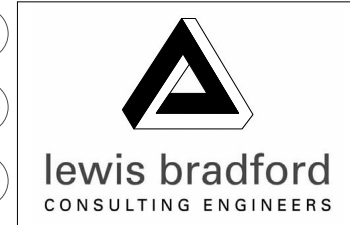

PROJECT:
INVERCARGILL CENTRAL ZONE 1 ANCHOR



DRAWING TITLE:
ROOF CENTRAL CEILING STRUCTURE

DRAWN: GPW	SCALE: 1 : 50 at A1
ENGINEER: EL/TSS	
CHECKED: -	
118083-Z1-WD-ST 1206	REV. 1

17 Dec 2019

Building Division

BUILDING CONSENT NUMBER
2019/1381

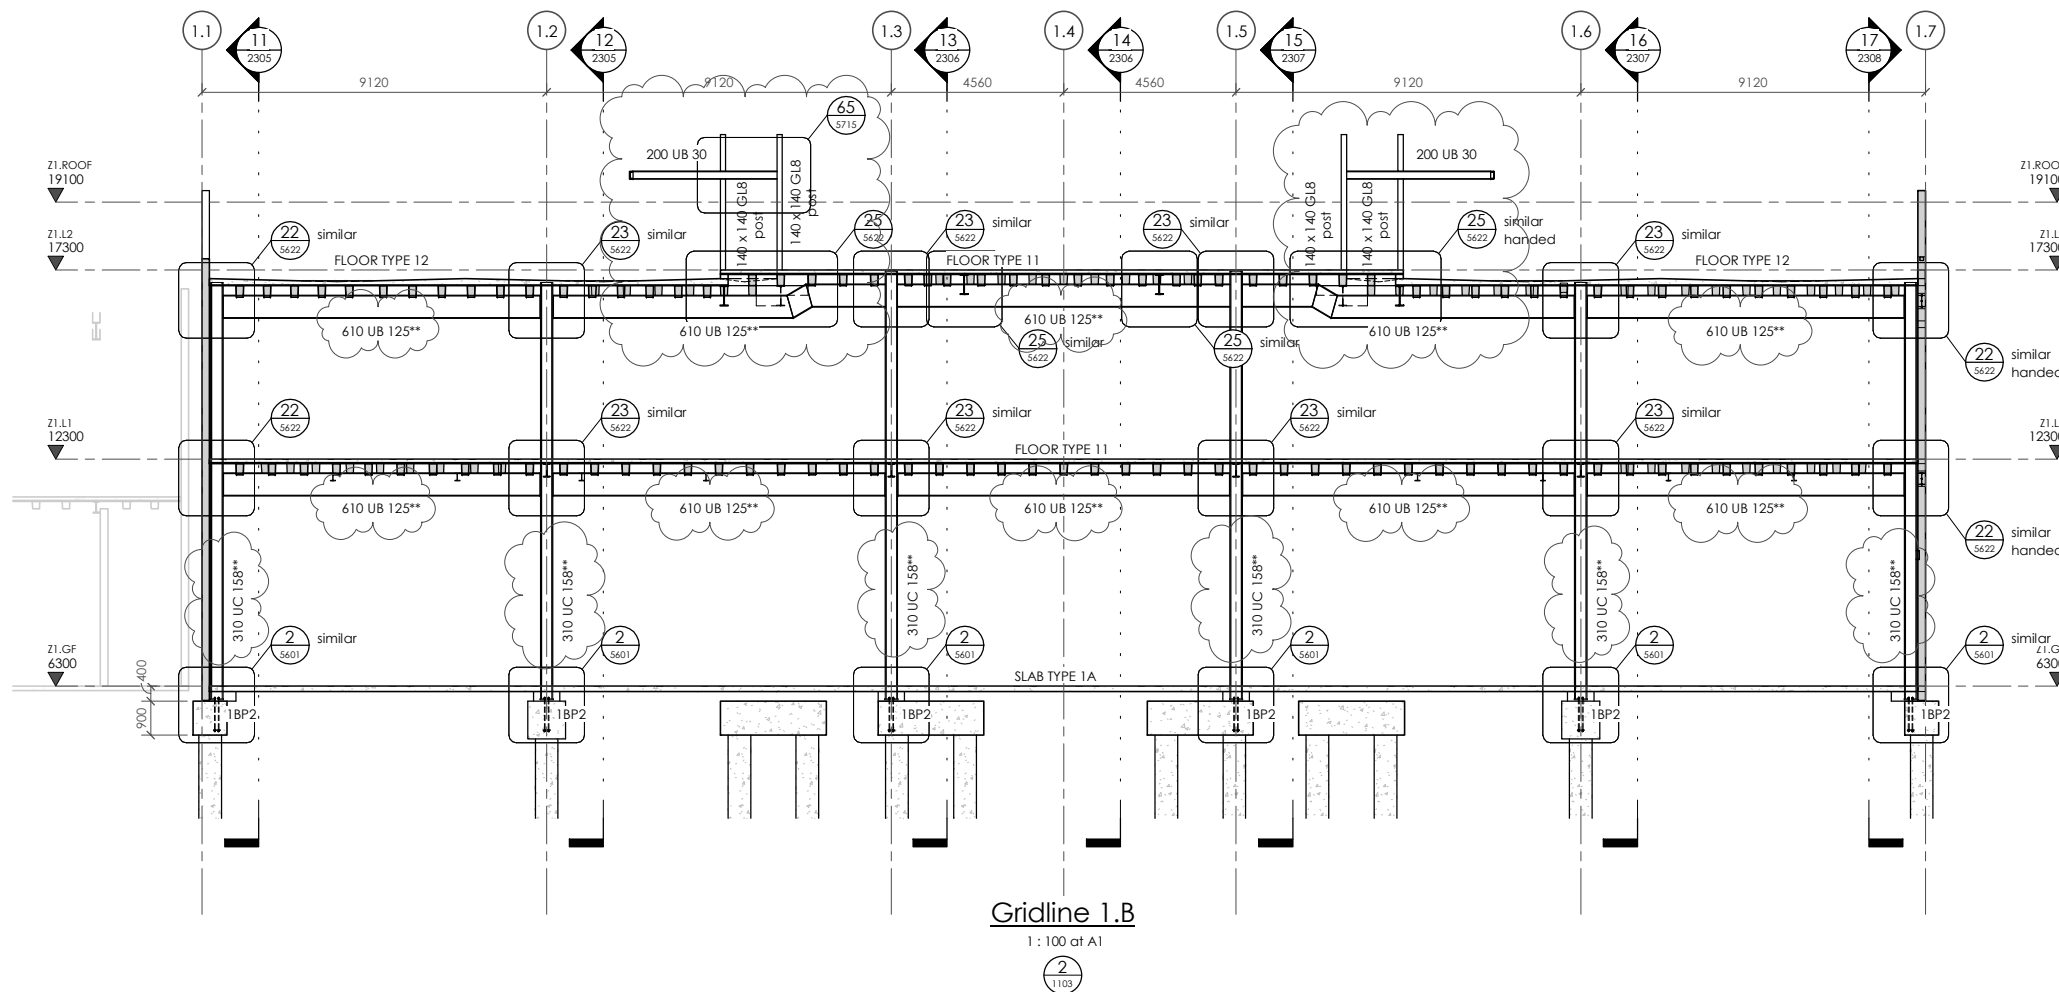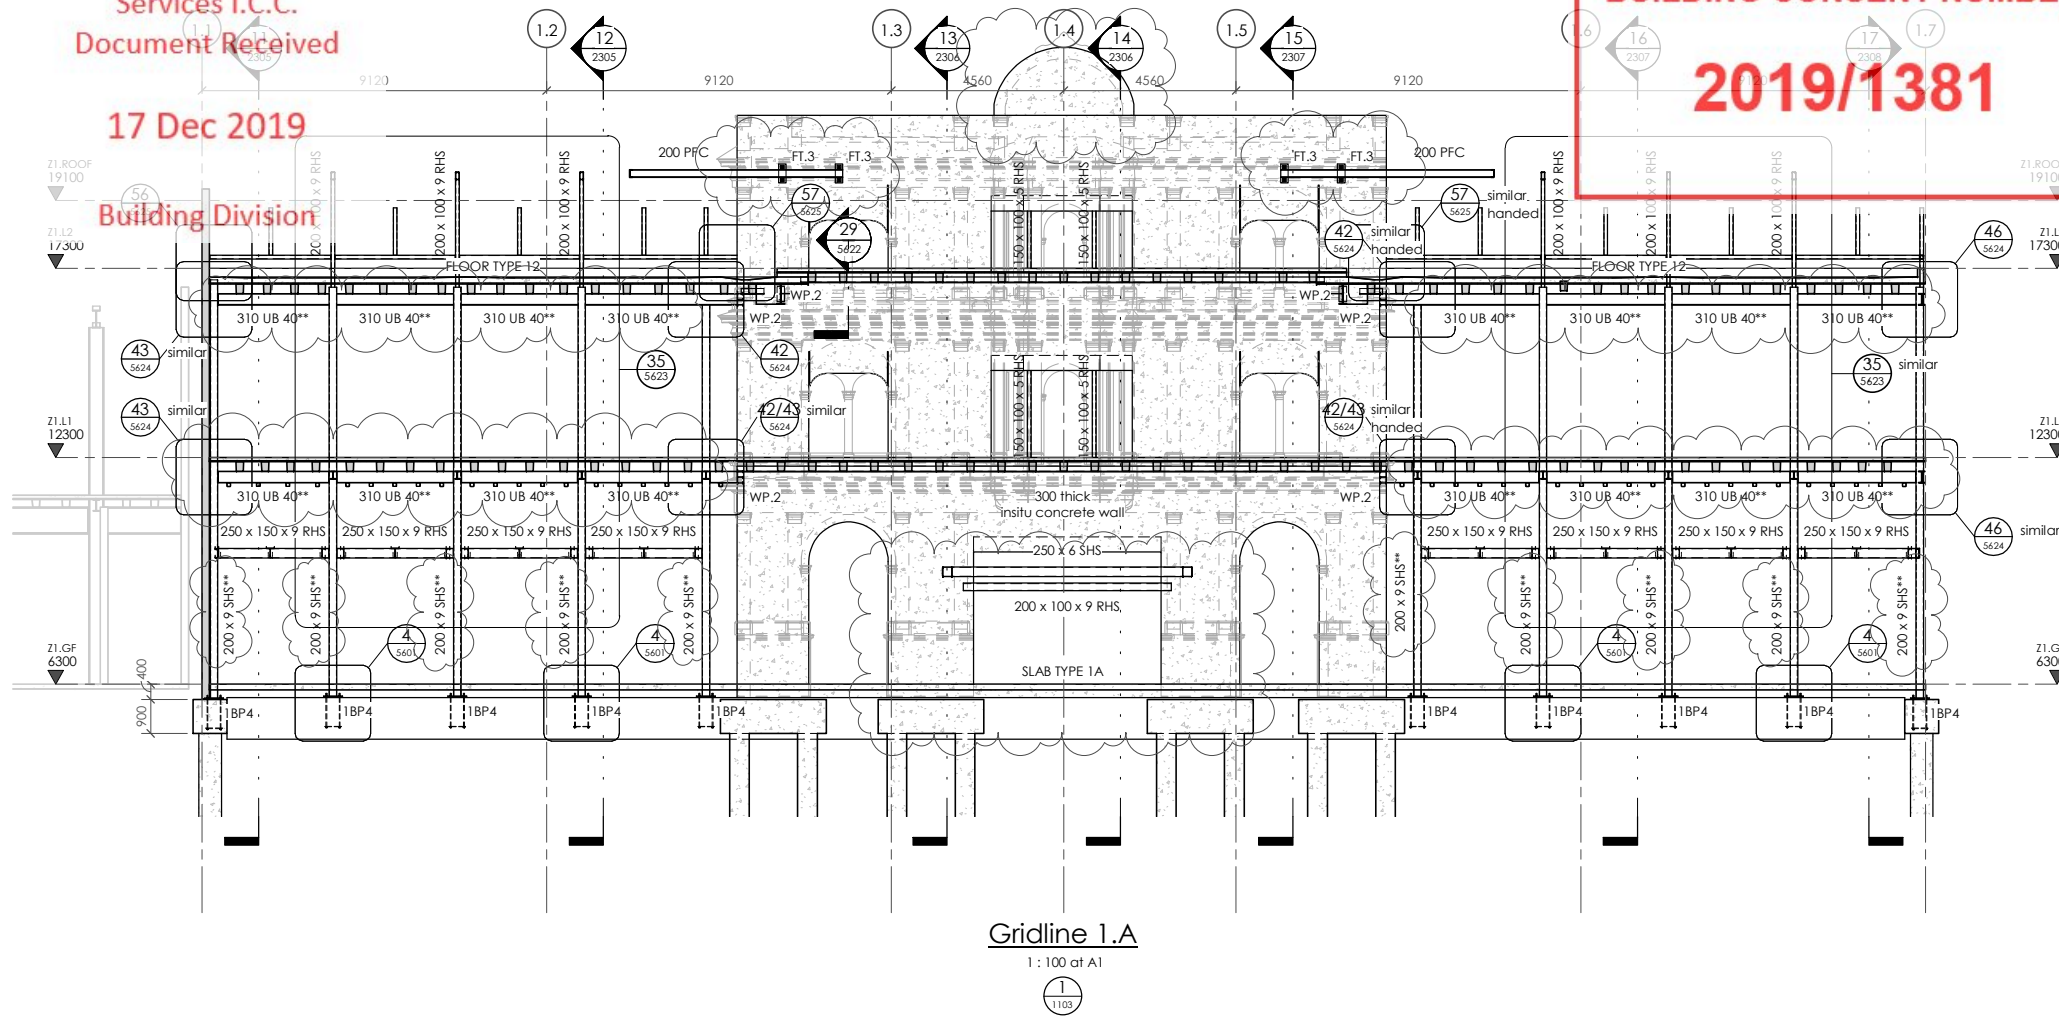

THIS DRAWING AND ALL INFORMATION CONTAINED WITHIN IS THE PROPERTY OF LEWIS BRADFORD. ITS CONTENTS ARE CONFIDENTIAL AND MUST NOT BE REPRODUCED OR DISTRIBUTED TO ANY OTHER PERSON OR COMPANY UNLESS AGREED TO IN WRITING BY LEWIS BRADFORD

CONTRACTOR TO VERIFY ALL DIMENSIONS ON SITE REFER TO ARCHITECT'S DRAWING FOR ALL SETOUTS

NOTES:
Refer drawing 0002 for standard notes. Refer also to Structural Specification.

- * indicates steel member to have 30 minutes fire rated paint protection (limiting temperature 550°C)
- ** indicates steel member to have 60 minutes fire rated paint protection (limiting temperature 550°C)
- *** indicates steel member to have 120 minutes fire rated paint protection (limiting temperature 550°C)


Where unprotected areas of steelwork meet fire protected elements overlap the fire protection onto the adjoining 500mm of 'unprotected' structural steel

Invercargill City Council
Building Consent Authority
Approved Site Copy

Approved For Issue
27/02/2020

REV	DATE	AMENDMENT	BY
2	25.10.19	CONSENT ISSUE	GPW
1	27.09.19	PEER REVIEW ISSUE	GPW

CLIENT:
HWCP

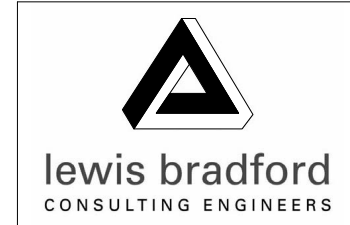

PROJECT:
INVERCARGILL CENTRAL ZONE 1 ANCHOR



DRAWING TITLE:
FRAME ELEVATIONS GRIDLINES 1.A & 1.B

DRAWN: GPW	SCALE: 1: 100 at A1
ENGINEER: EL/TSS	
CHECKED: -	
118083-Z1-WD-ST 2300	REV. 2

17 Dec 2019

Building Division

BUILDING CONSENT NUMBER
2019/1381

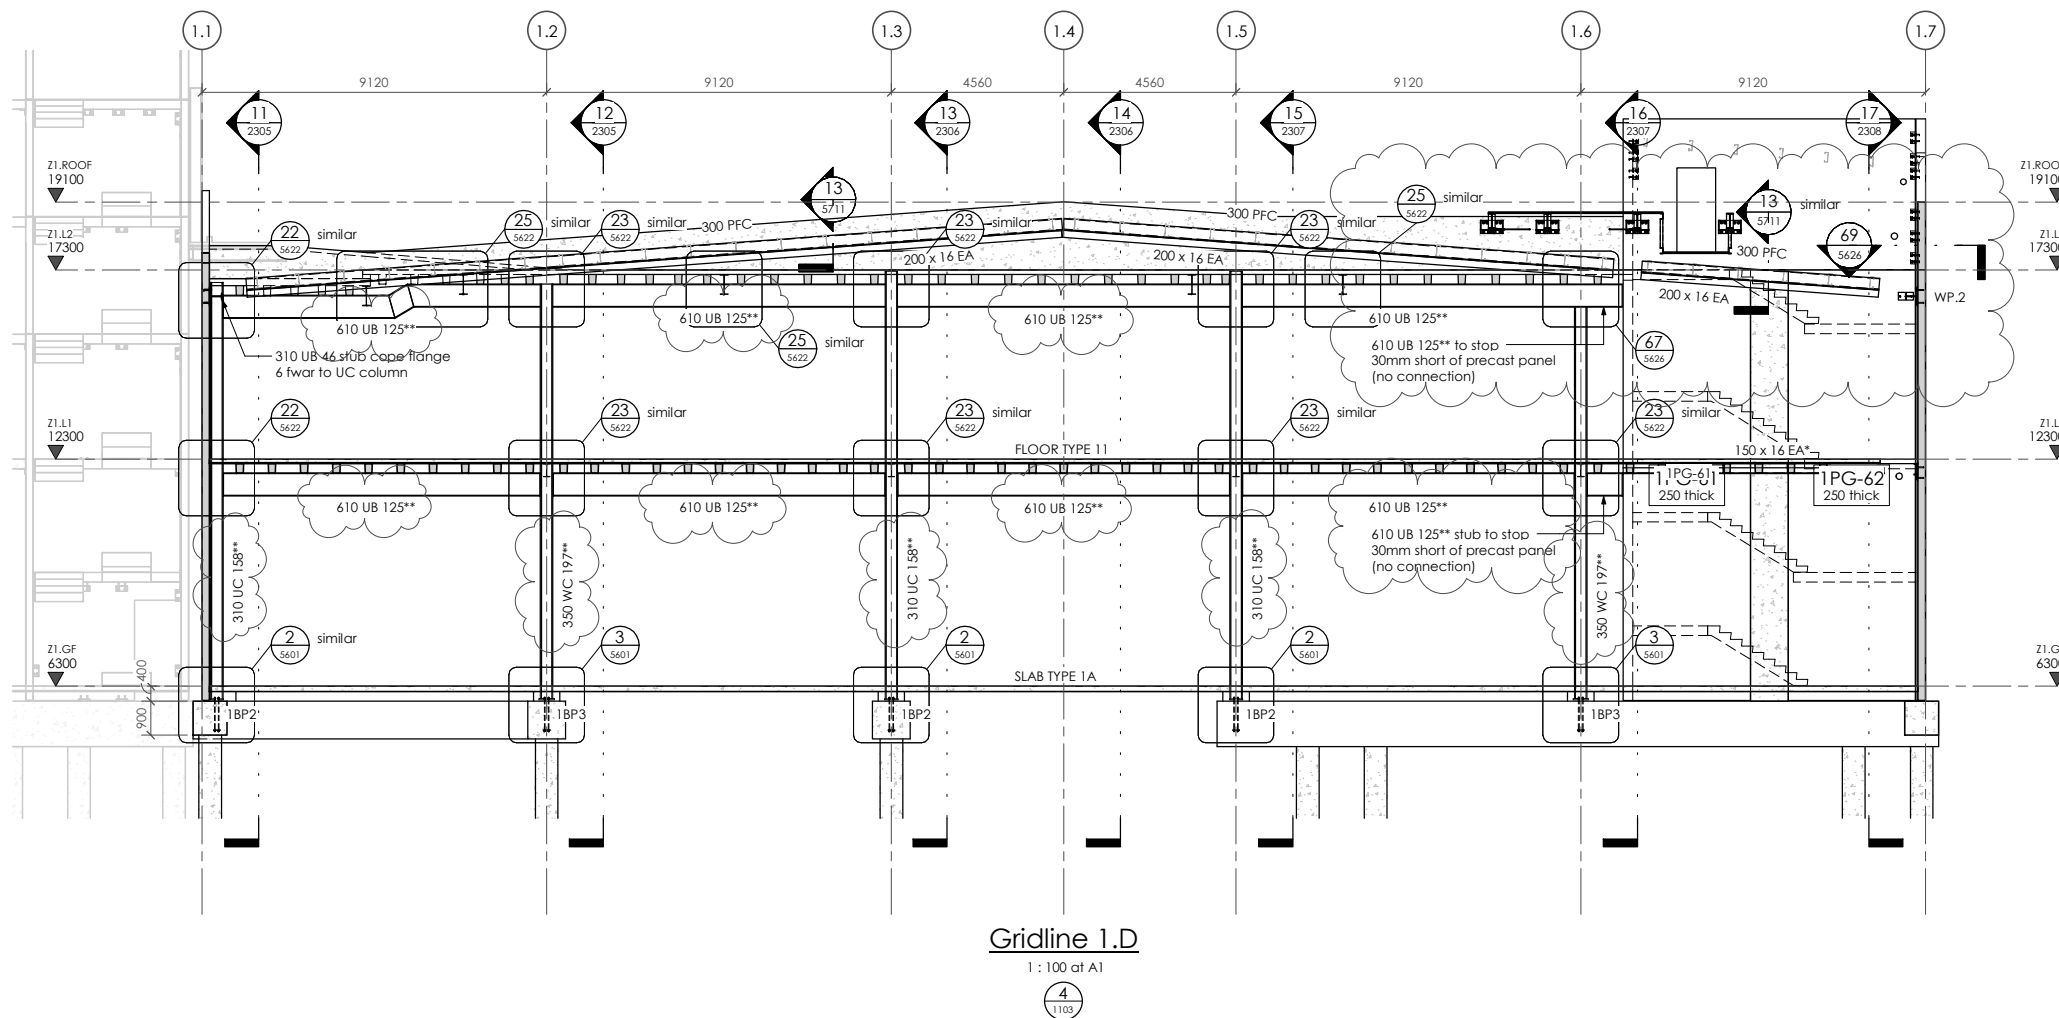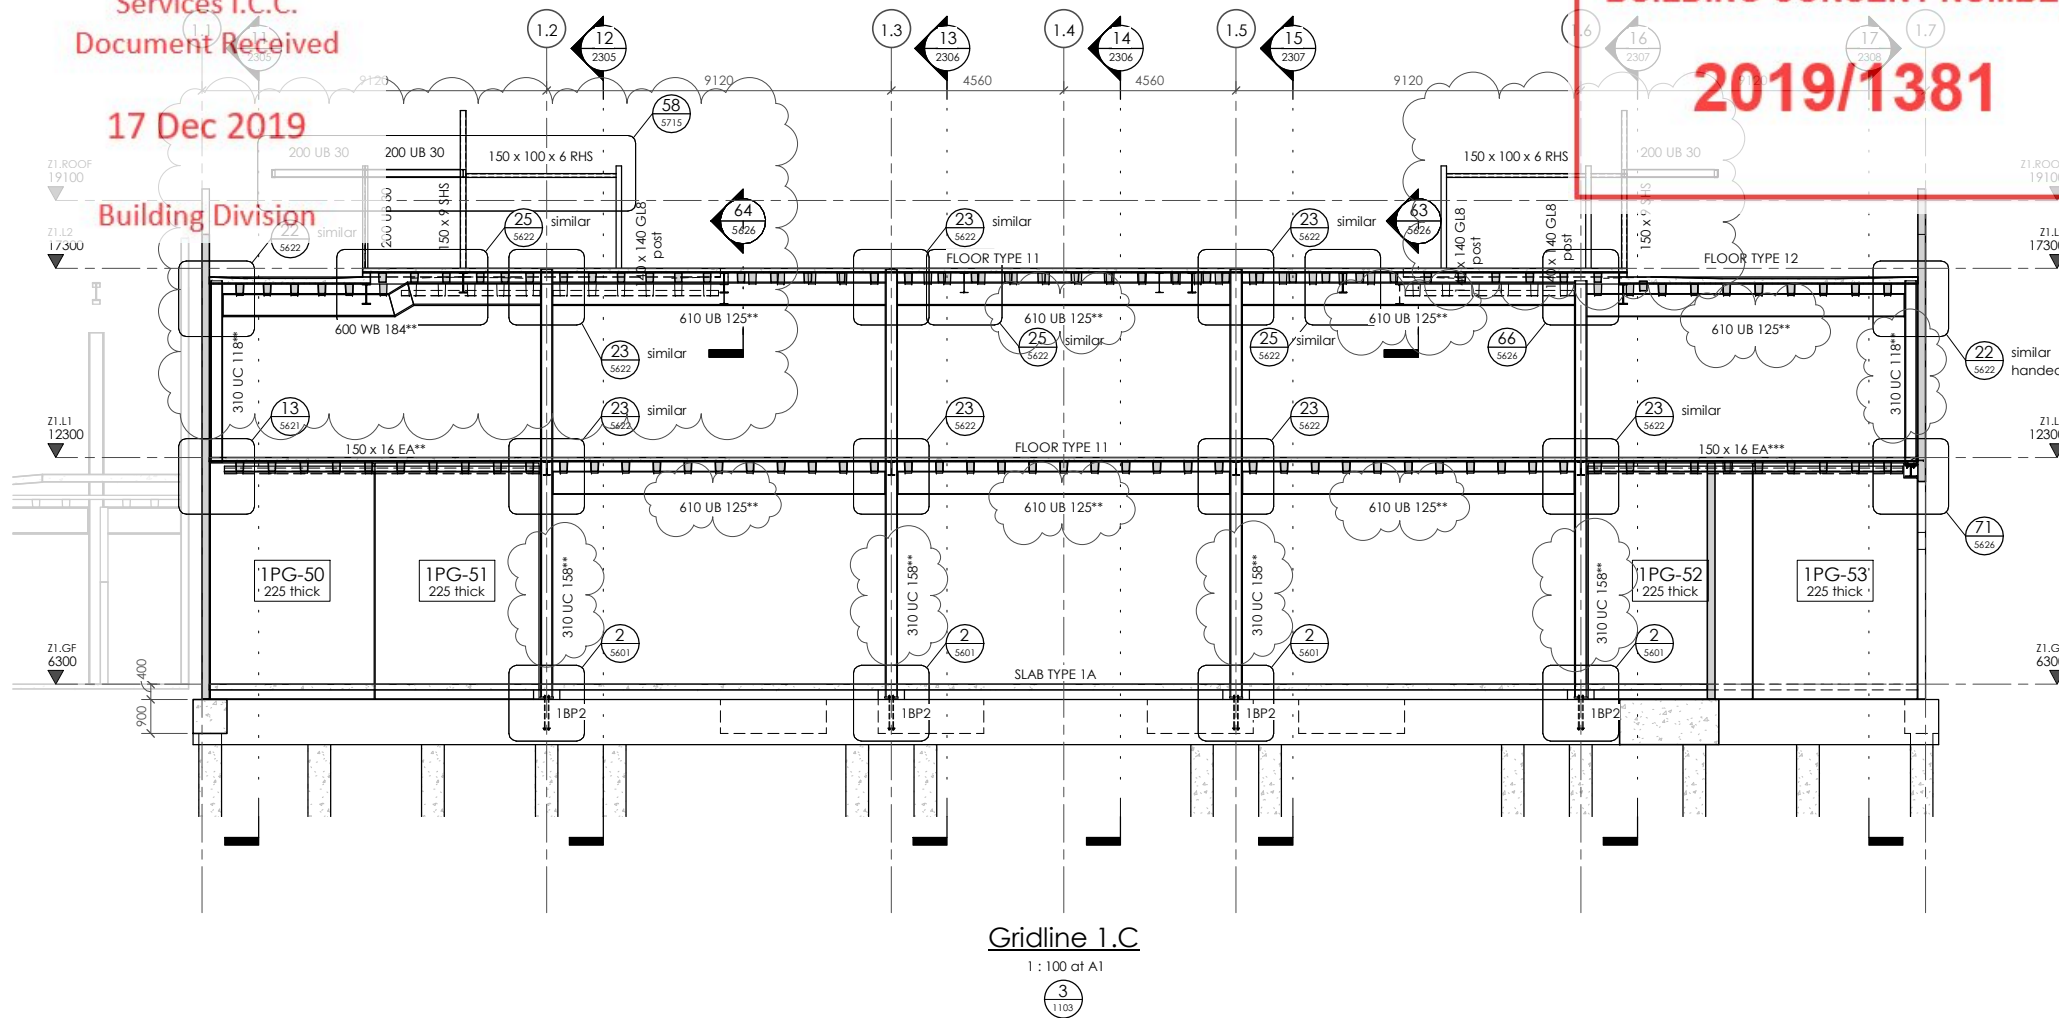

THIS DRAWING AND ALL INFORMATION CONTAINED WITHIN IS THE PROPERTY OF LEWIS BRADFORD. ITS CONTENTS ARE CONFIDENTIAL AND MUST NOT BE REPRODUCED OR DISTRIBUTED TO ANY OTHER PERSON OR COMPANY UNLESS AGREED TO IN WRITING BY LEWIS BRADFORD

CONTRACTOR TO VERIFY ALL DIMENSIONS ON SITE REFER TO ARCHITECT'S DRAWING FOR ALL SETOUTS

NOTES:
Refer drawing 0002 for standard notes. Refer also to Structural Specification.

- * indicates steel member to have 30 minutes fire rated paint protection (limiting temperature 550°C)
- ** indicates steel member to have 60 minutes fire rated paint protection (limiting temperature 550°C)
- *** indicates steel member to have 120 minutes fire rated paint protection (limiting temperature 550°C)


Where unprotected areas of steelwork meet fire protected elements overlap the fire protection onto the adjoining 500mm of 'unprotected' structural steel

Invercargill City Council
Building Consent Authority
Approved Site Copy

Approved For Issue
27/02/2020

REV	DATE	AMENDMENT	BY
2	25.10.19	CONSENT ISSUE	GPW
1	27.09.19	PEER REVIEW ISSUE	GPW

CLIENT:
HWCP

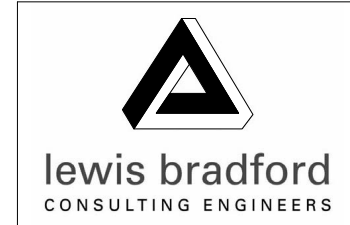

PROJECT:
**INVERCARGILL CENTRAL
ZONE 1 ANCHOR**


DRAWING TITLE:
**FRAME ELEVATIONS
GRIDLINES 1.C & 1.D**

DRAWN: GPW	SCALE: 1 : 100 at A1
ENGINEER: EL/TSS	
CHECKED: -	
118083-Z1-WD-ST 2301	REV. 2

17 Dec 2019


Building Division

BUILDING CONSENT NUMBER
2019/1381

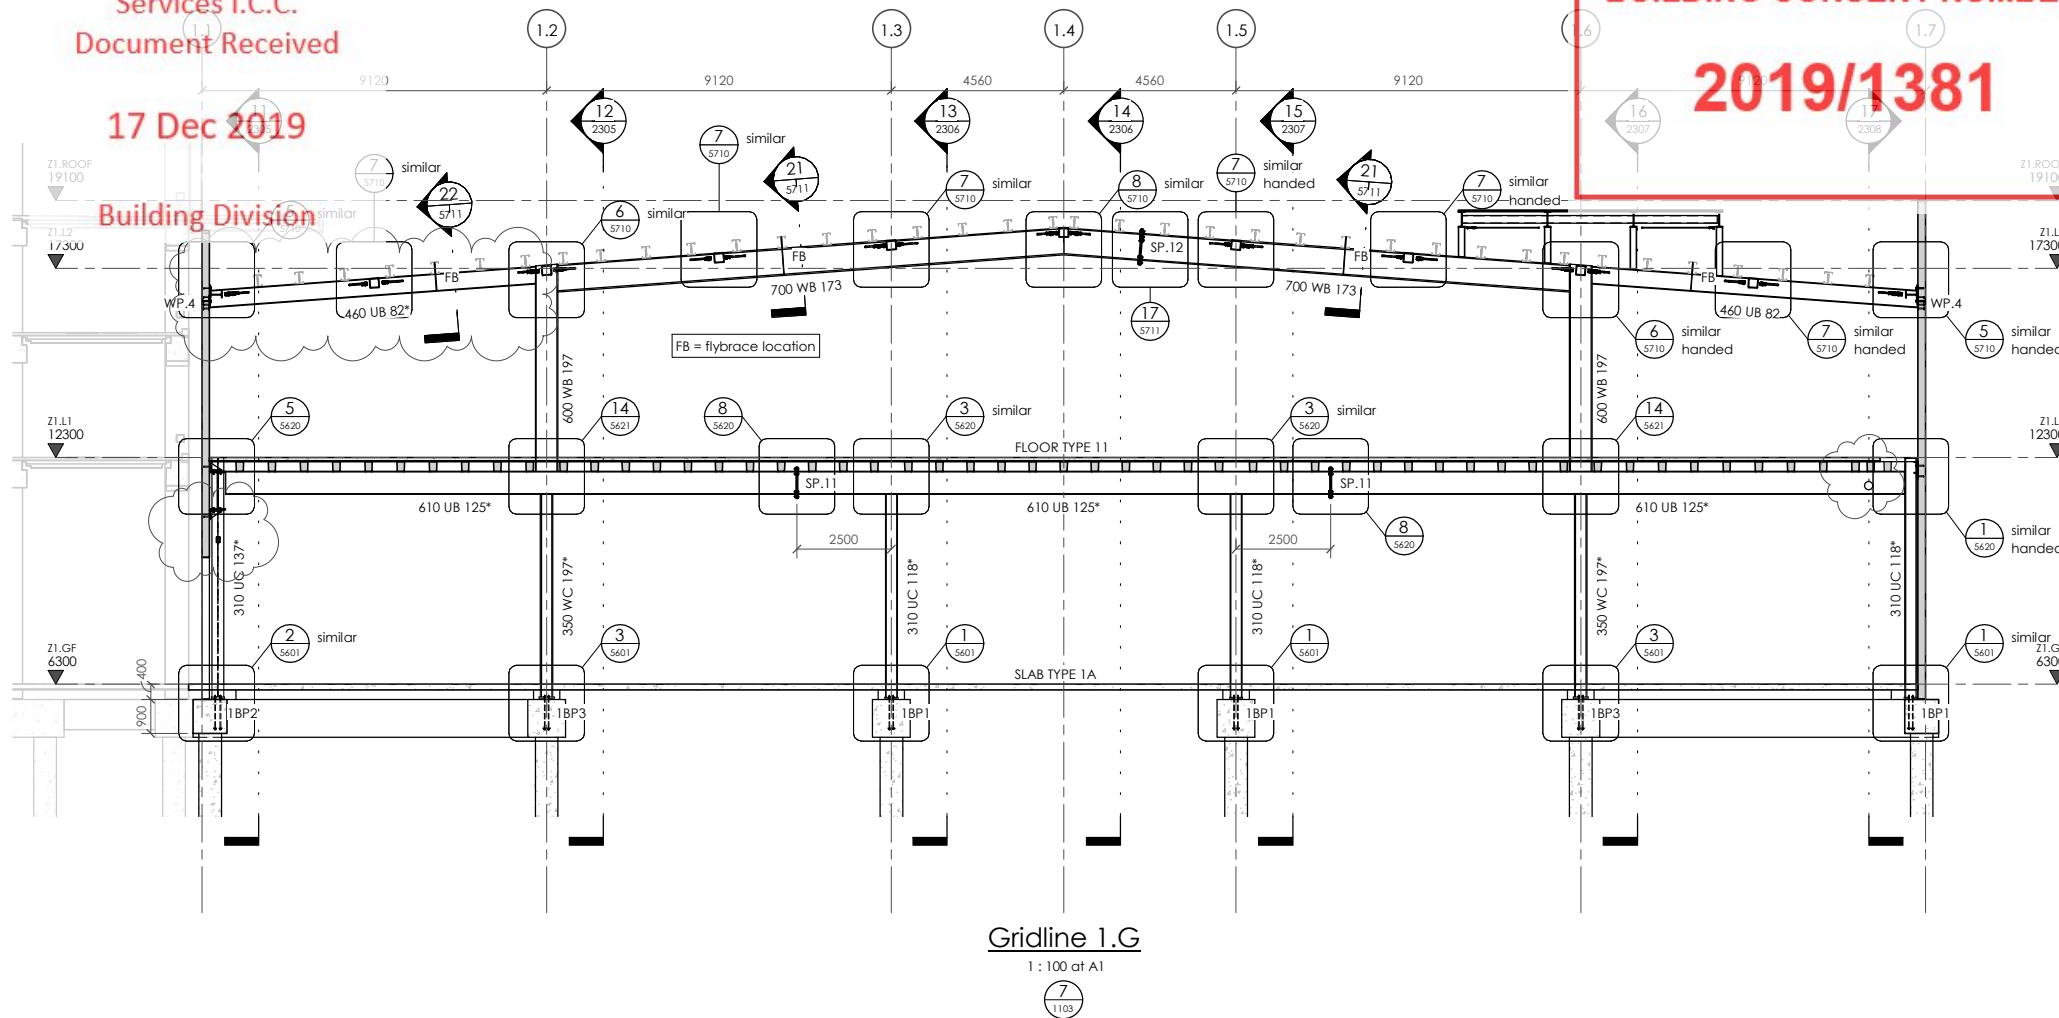

Gridline 1.G
1 : 100 at A1

7
1103

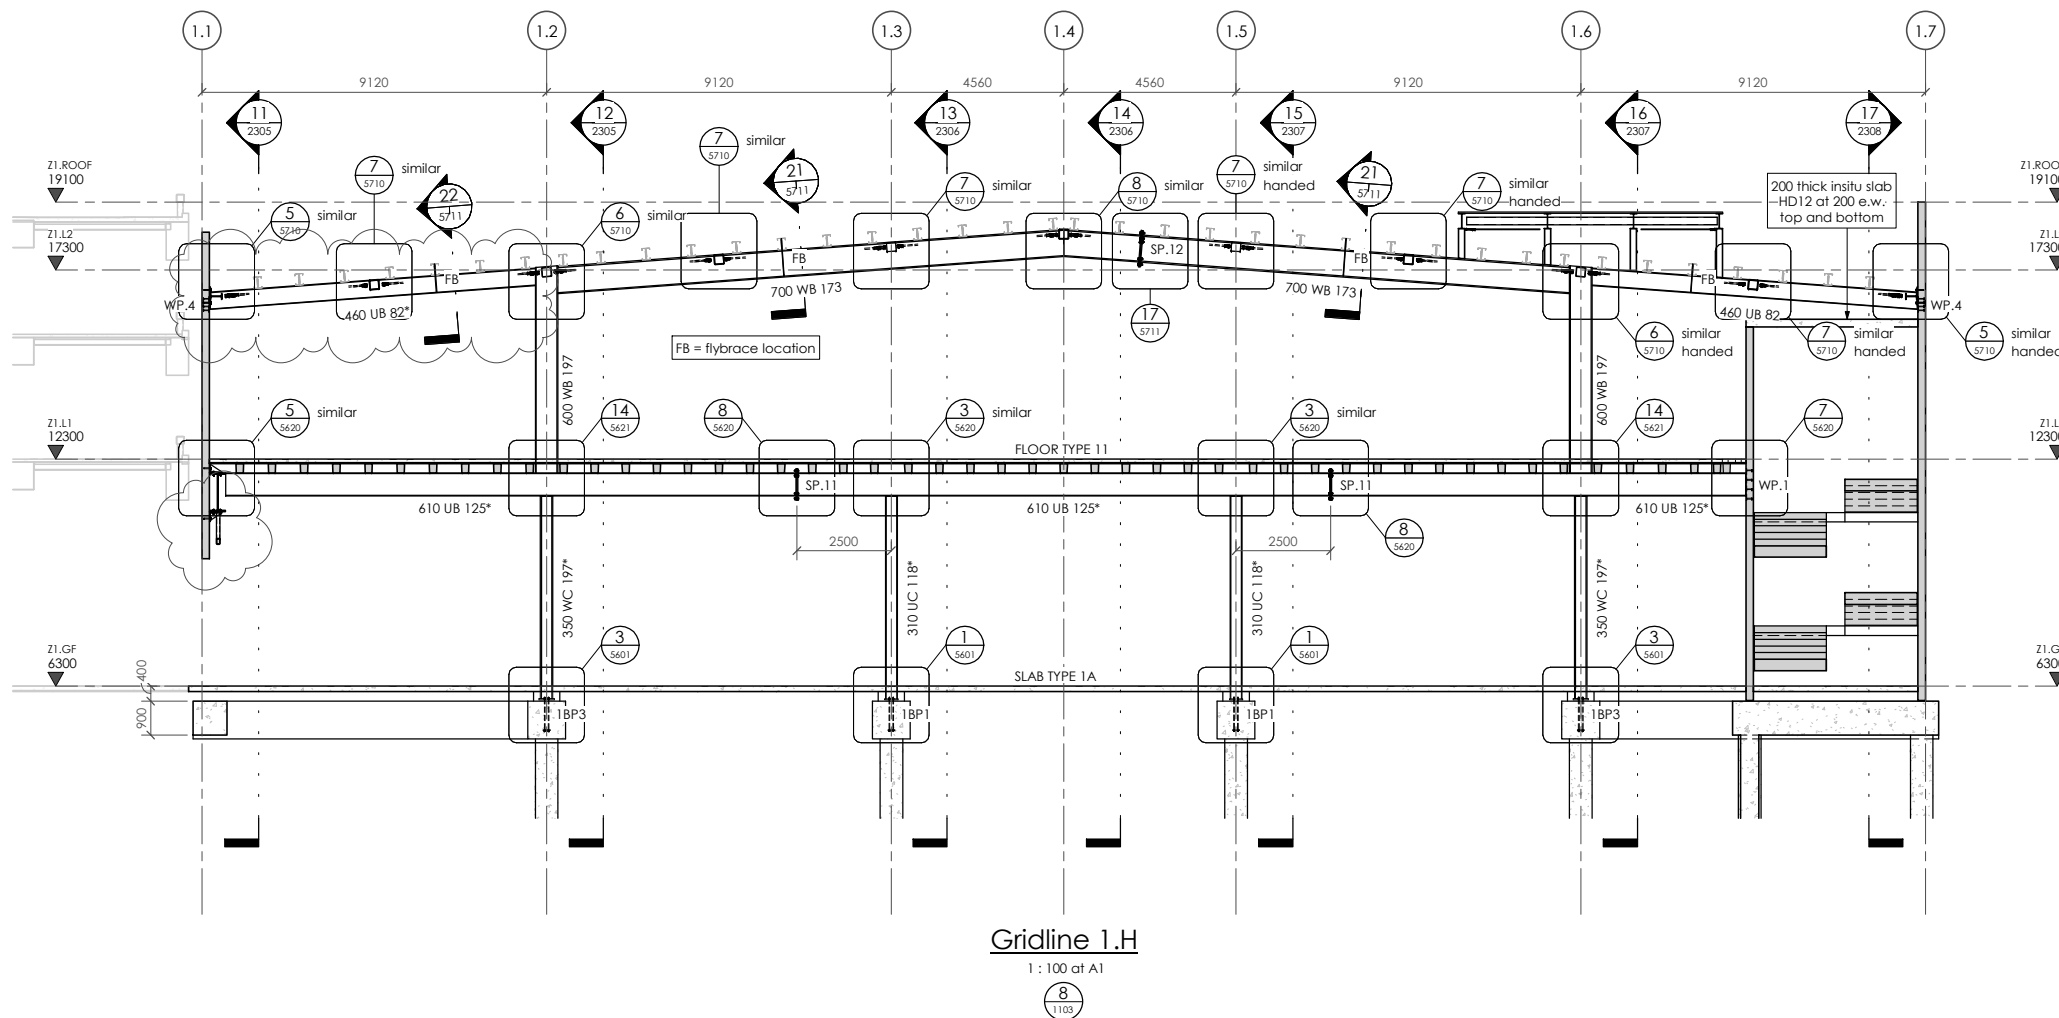

Gridline 1.H
1 : 100 at A1

8
1103

THIS DRAWING AND ALL INFORMATION CONTAINED WITHIN IS THE PROPERTY OF LEWIS BRADFORD. ITS CONTENTS ARE CONFIDENTIAL AND MUST NOT BE REPRODUCED OR DISTRIBUTED TO ANY OTHER PERSON OR COMPANY UNLESS AGREED TO IN WRITING BY LEWIS BRADFORD

CONTRACTOR TO VERIFY ALL DIMENSIONS ON SITE REFER TO ARCHITECT'S DRAWING FOR ALL SETOUTS

NOTES:


- Refer drawing 0002 for standard notes. Refer also to Structural Specification.
- * indicates steel member to have 30 minutes fire rated point protection (limiting temperature 550°C)
- ** indicates steel member to have 60 minutes fire rated point protection (limiting temperature 550°C)
- *** indicates steel member to have 120 minutes fire rated point protection (limiting temperature 550°C)
- Where unprotected areas of steelwork meet fire protected elements overlap the fire protection onto the adjoining 500mm of 'unprotected' structural steel

Invercargill City Council
Building Consent Authority
Approved Site Copy

Approved For Issue
27/02/2020

2	25.10.19	CONSENT ISSUE	GPW
1	27.09.19	PEER REVIEW ISSUE	GPW
REV	DATE	AMENDMENT	BY

CLIENT:
HWCP

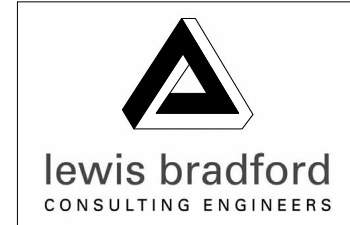

PROJECT:
INVERCARGILL CENTRAL ZONE 1 ANCHOR


DRAWING TITLE:
FRAME ELEVATIONS GRIDLINES 1.G & 1.H

DRAWN:	GPW	SCALE:	1 : 100 at A1
ENGINEER:	EL/TSS	CHECKED:	-
118083-Z1-WD-ST 2303			REV. 2


17 Dec 2019

Building Division

BUILDING CONSENT NUMBER
2019/1381

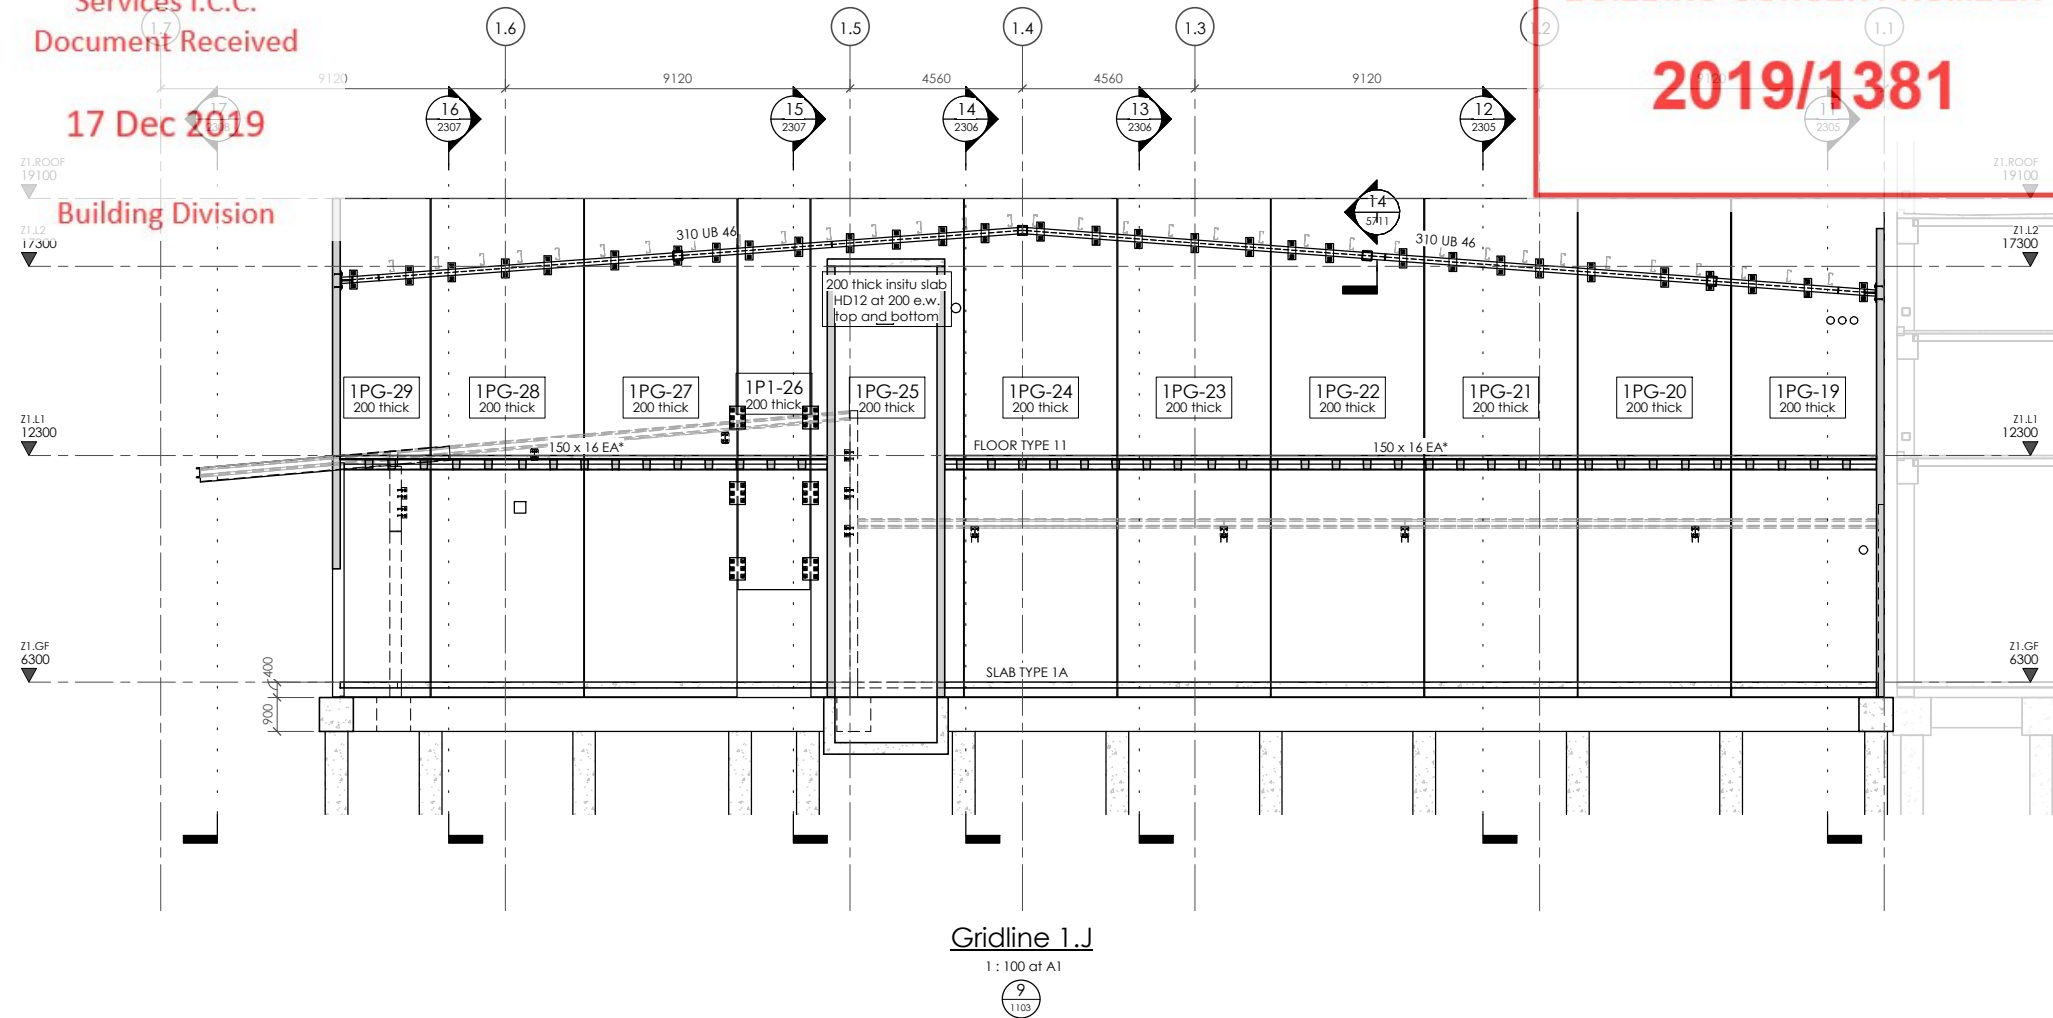

Gridline 1.J
1: 100 at A1

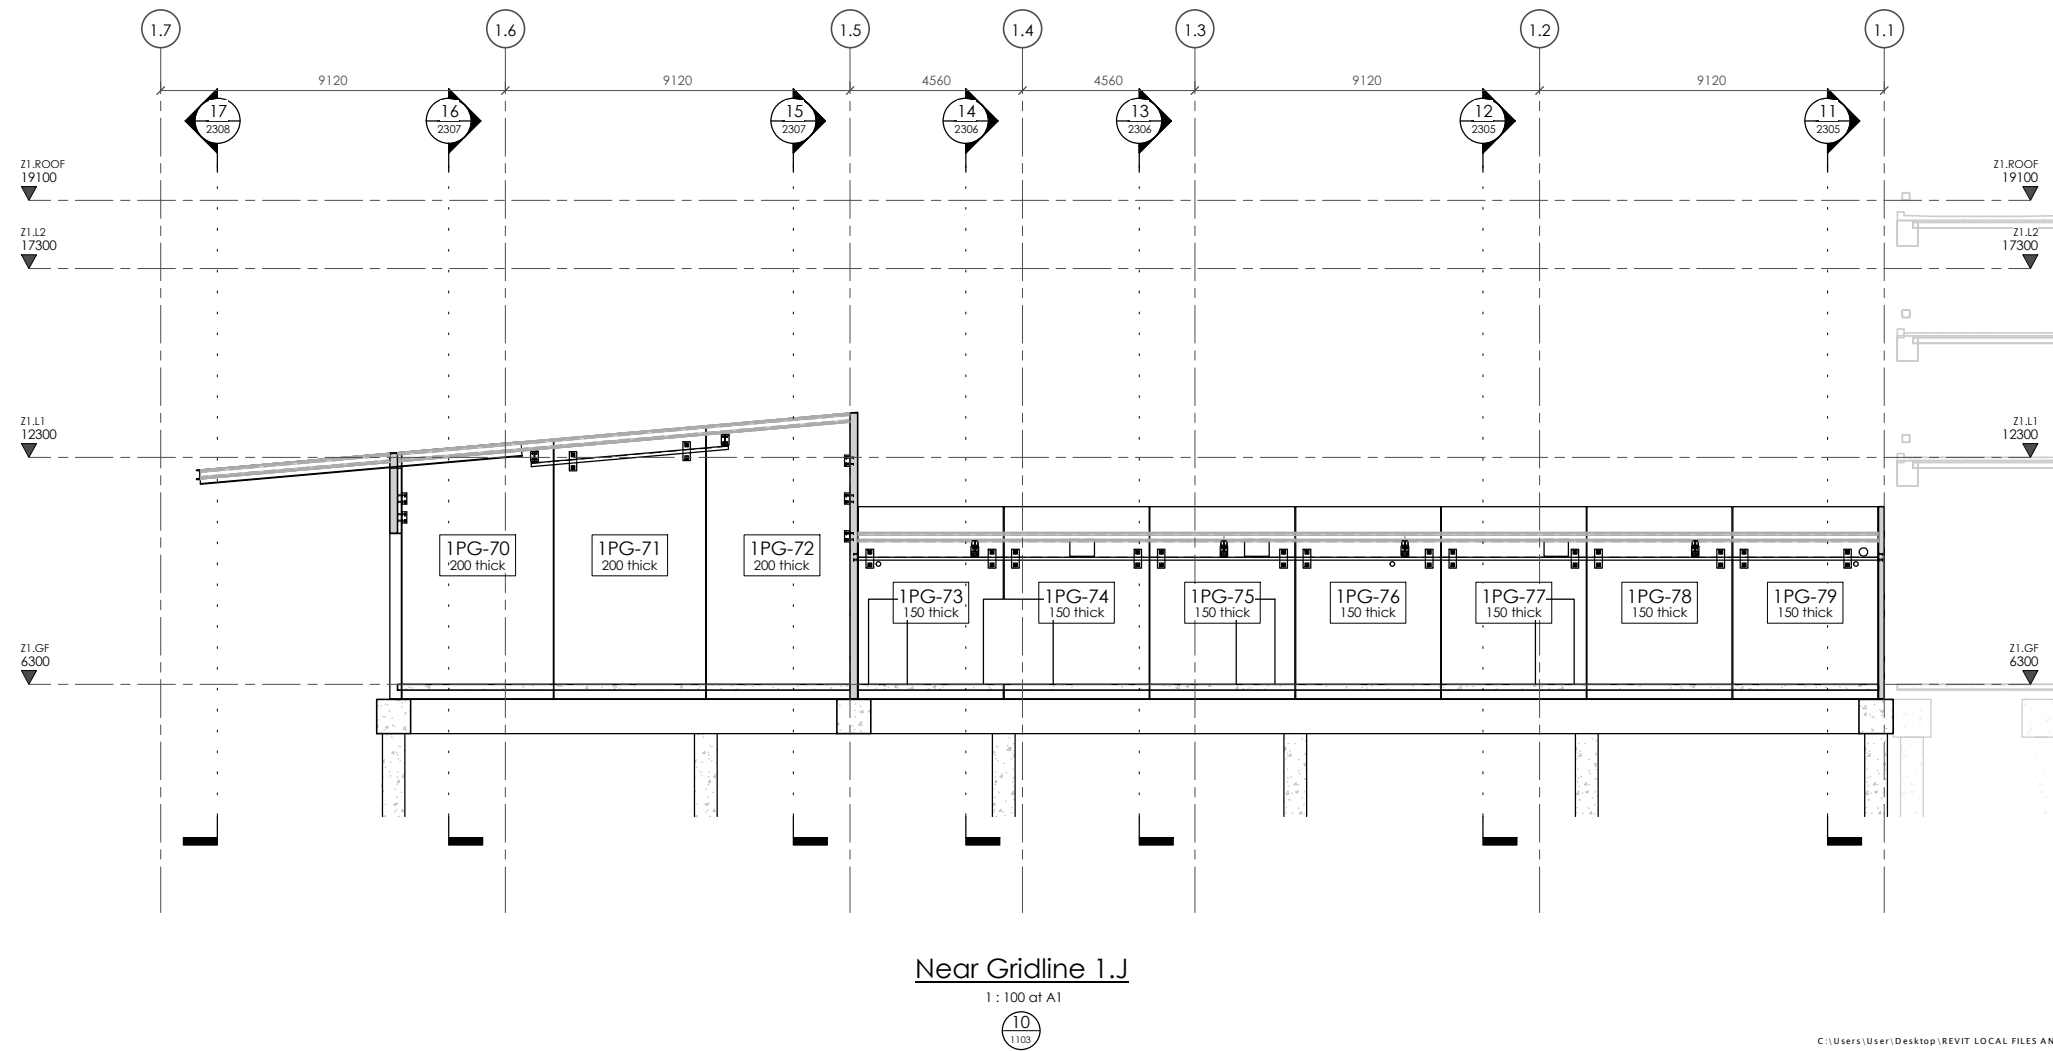

Near Gridline 1.J
1: 100 at A1

THIS DRAWING AND ALL INFORMATION CONTAINED WITHIN IS THE PROPERTY OF LEWIS BRADFORD. ITS CONTENTS ARE CONFIDENTIAL AND MUST NOT BE REPRODUCED OR DISTRIBUTED TO ANY OTHER PERSON OR COMPANY UNLESS AGREED TO IN WRITING BY LEWIS BRADFORD

CONTRACTOR TO VERIFY ALL DIMENSIONS ON SITE REFER TO ARCHITECT'S DRAWING FOR ALL SETOUTS

NOTES:
Refer drawing 0002 for standard notes.
Refer also to Structural Specification.


* indicates steel member to have 30 minutes fire rated point protection (limiting temperature 550°C)
** indicates steel member to have 60 minutes fire rated point protection (limiting temperature 550°C)
*** indicates steel member to have 120 minutes fire rated point protection (limiting temperature 550°C)
Where unprotected areas of steelwork meet fire protected elements overlap the fire protection onto the adjoining 500mm of 'unprotected' structural steel

Invercargill City Council
Building Consent Authority
Approved Site Copy

Approved For Issue
27/02/2020

REV	DATE	AMENDMENT	BY
2	25.10.19	CONSENT ISSUE	GPW
1	27.09.19	PEER REVIEW ISSUE	GPW

CLIENT:
HWCP

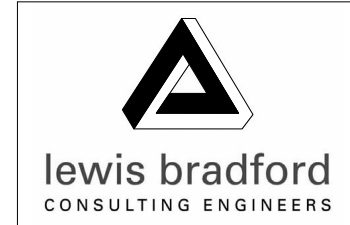

PROJECT:
INVERCARGILL CENTRAL ZONE 1 ANCHOR

DRAWING TITLE:
FRAME ELEVATIONS GRIDLINE 1 J

DRAWN: GPW	SCALE: 1 : 100 at A1
ENGINEER: EL/TSS	
CHECKED: -	
118083-Z1-WD-ST 2304	REV. 2

17 Dec 2019

BUILDING CONSENT NUMBER
2019/1381

THIS DRAWING AND ALL INFORMATION CONTAINED WITHIN IS THE PROPERTY OF LEWIS BRADFORD. ITS CONTENTS ARE CONFIDENTIAL AND MUST NOT BE REPRODUCED OR DISTRIBUTED TO ANY OTHER PERSON OR COMPANY UNLESS AGREED TO IN WRITING BY LEWIS BRADFORD.

CONTRACTOR TO VERIFY ALL DIMENSIONS ON SITE REFER TO ARCHITECT'S DRAWING FOR ALL SETOUTS


NOTES :

Refer drawing 0002 for standard notes. Refer also to Structural Specification.


* indicates steel member to have 30 minutes fire rated point protection (limiting temperature 550°C)
** indicates steel member to have 60 minutes fire rated point protection (limiting temperature 550°C)
*** indicates steel member to have 120 minutes fire rated point protection (limiting temperature 550°C)
Where unprotected areas of steelwork meet fire protected elements overlap the fire protection onto the adjoining 500mm of 'unprotected' structural steel

Invercargill City Council
Building Consent Authority
Approved Site Copy

Approved For Issue
27/02/2020

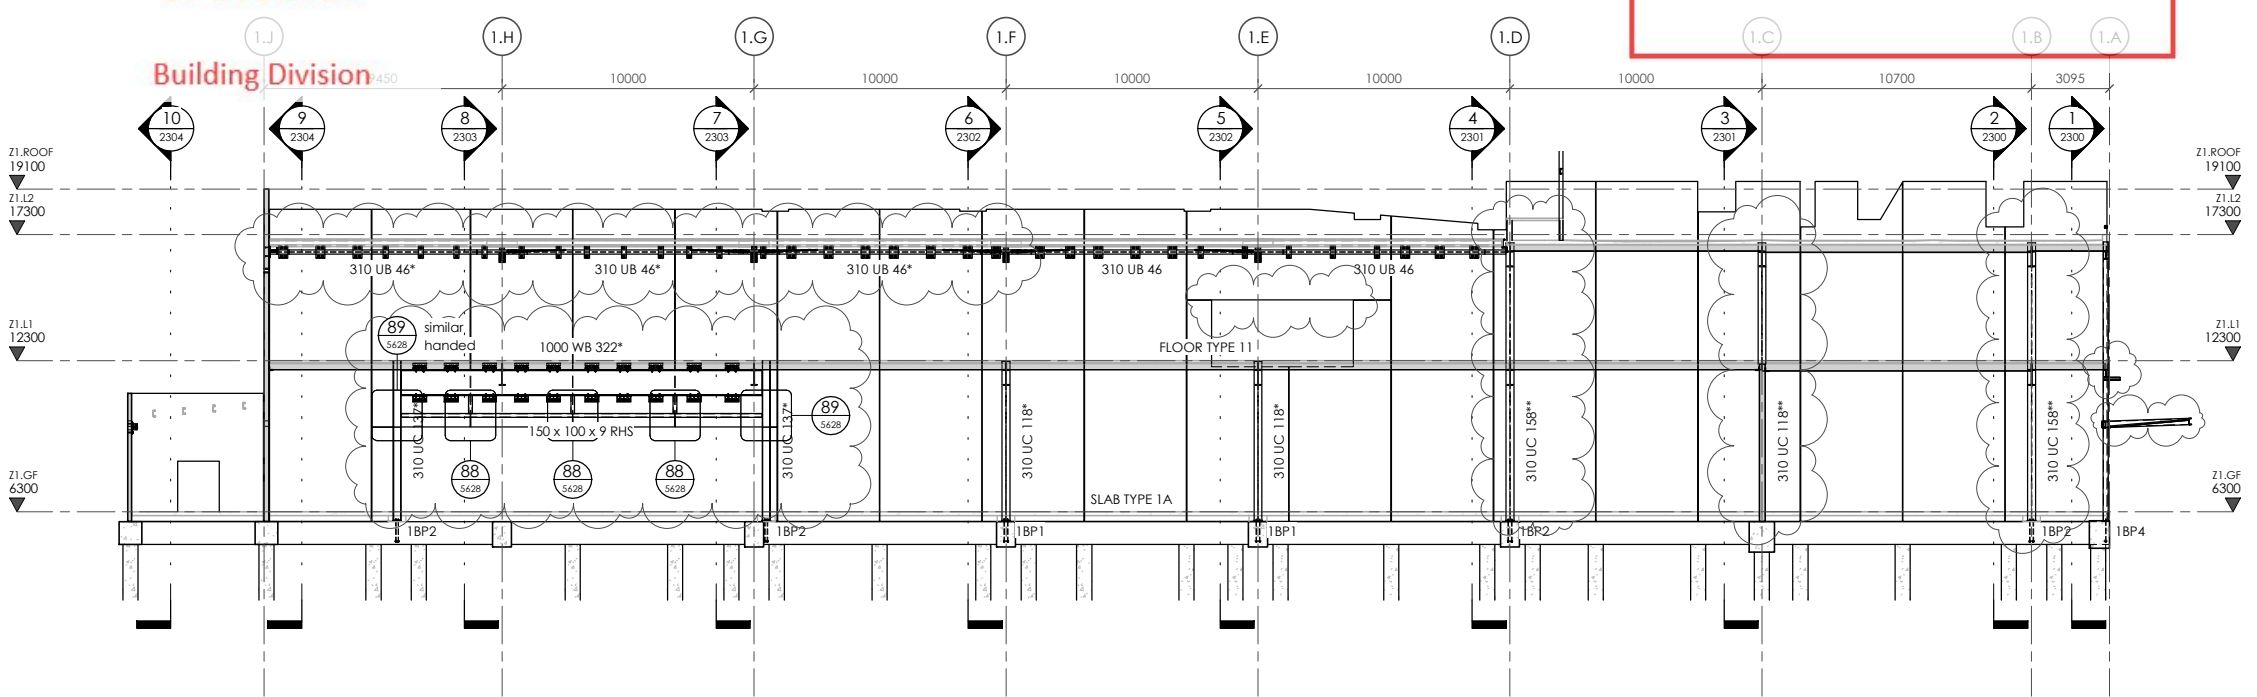


Gridline 1.1
1 : 150 at A1
11
1103

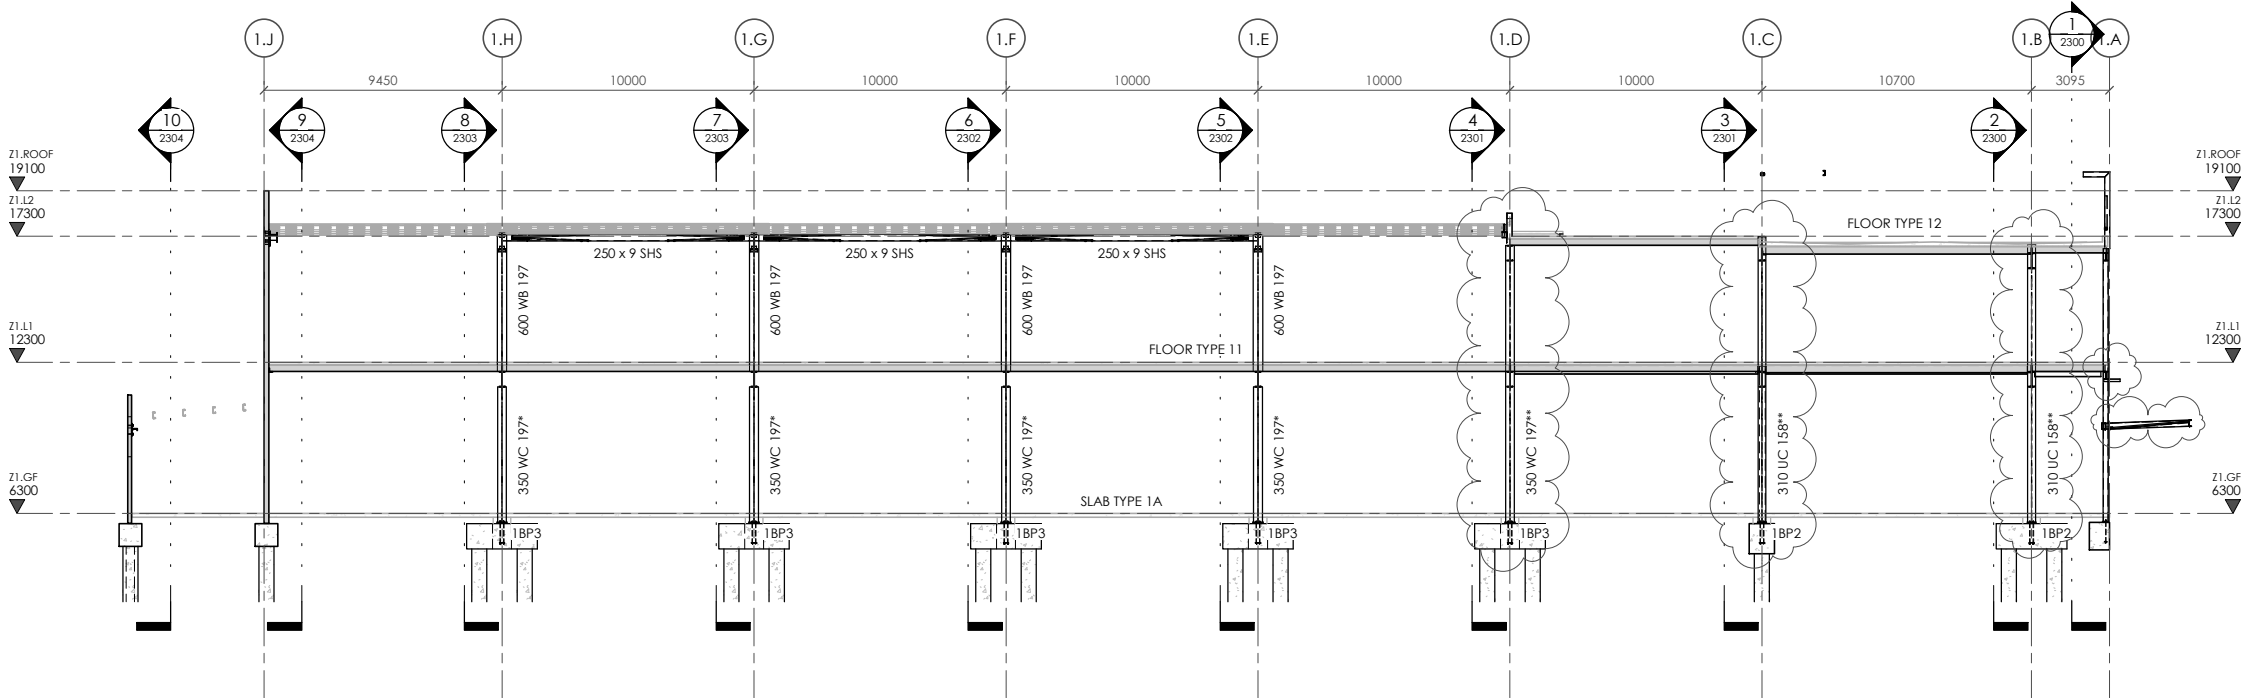

Gridline 1.2
1 : 150 at A1
12
1103

2	25.10.19	CONSENT ISSUE	GPW
1	27.09.19	PEER REVIEW ISSUE	GPW
REV	DATE	AMENDMENT	BY

CLIENT:
HWCP

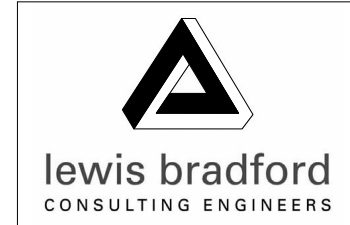

PROJECT:
INVERCARGILL CENTRAL ZONE 1 ANCHOR

DRAWING TITLE:
FRAME ELEVATIONS GRIDLINES 1.1 & 1.2

DRAWN: GPW	SCALE: 1 : 150 at A1
ENGINEER: EL/TSS	
CHECKED: -	
118083-Z1-WD-ST 2305	REV. 2

17 Dec 2019

BUILDING CONSENT NUMBER
2019/1381

THIS DRAWING AND ALL INFORMATION CONTAINED WITHIN IS THE PROPERTY OF LEWIS BRADFORD. ITS CONTENTS ARE CONFIDENTIAL AND MUST NOT BE REPRODUCED OR DISTRIBUTED TO ANY OTHER PERSON OR COMPANY UNLESS AGREED TO IN WRITING BY LEWIS BRADFORD.

CONTRACTOR TO VERIFY ALL DIMENSIONS ON SITE REFER TO ARCHITECT'S DRAWING FOR ALL SETOUTS


NOTES :

Refer drawing 0002 for standard notes. Refer also to Structural Specification.

* indicates steel member to have 30 minutes fire rated point protection (limiting temperature 550°C)
** indicates steel member to have 60 minutes fire rated point protection (limiting temperature 550°C)
*** indicates steel member to have 120 minutes fire rated point protection (limiting temperature 550°C)
Where unprotected areas of steelwork meet fire protected elements overlap the fire protection onto the adjoining 500mm of 'unprotected' structural steel

Invercargill City Council
Building Consent Authority
Approved Site Copy


Approved For Issue
27/02/2020

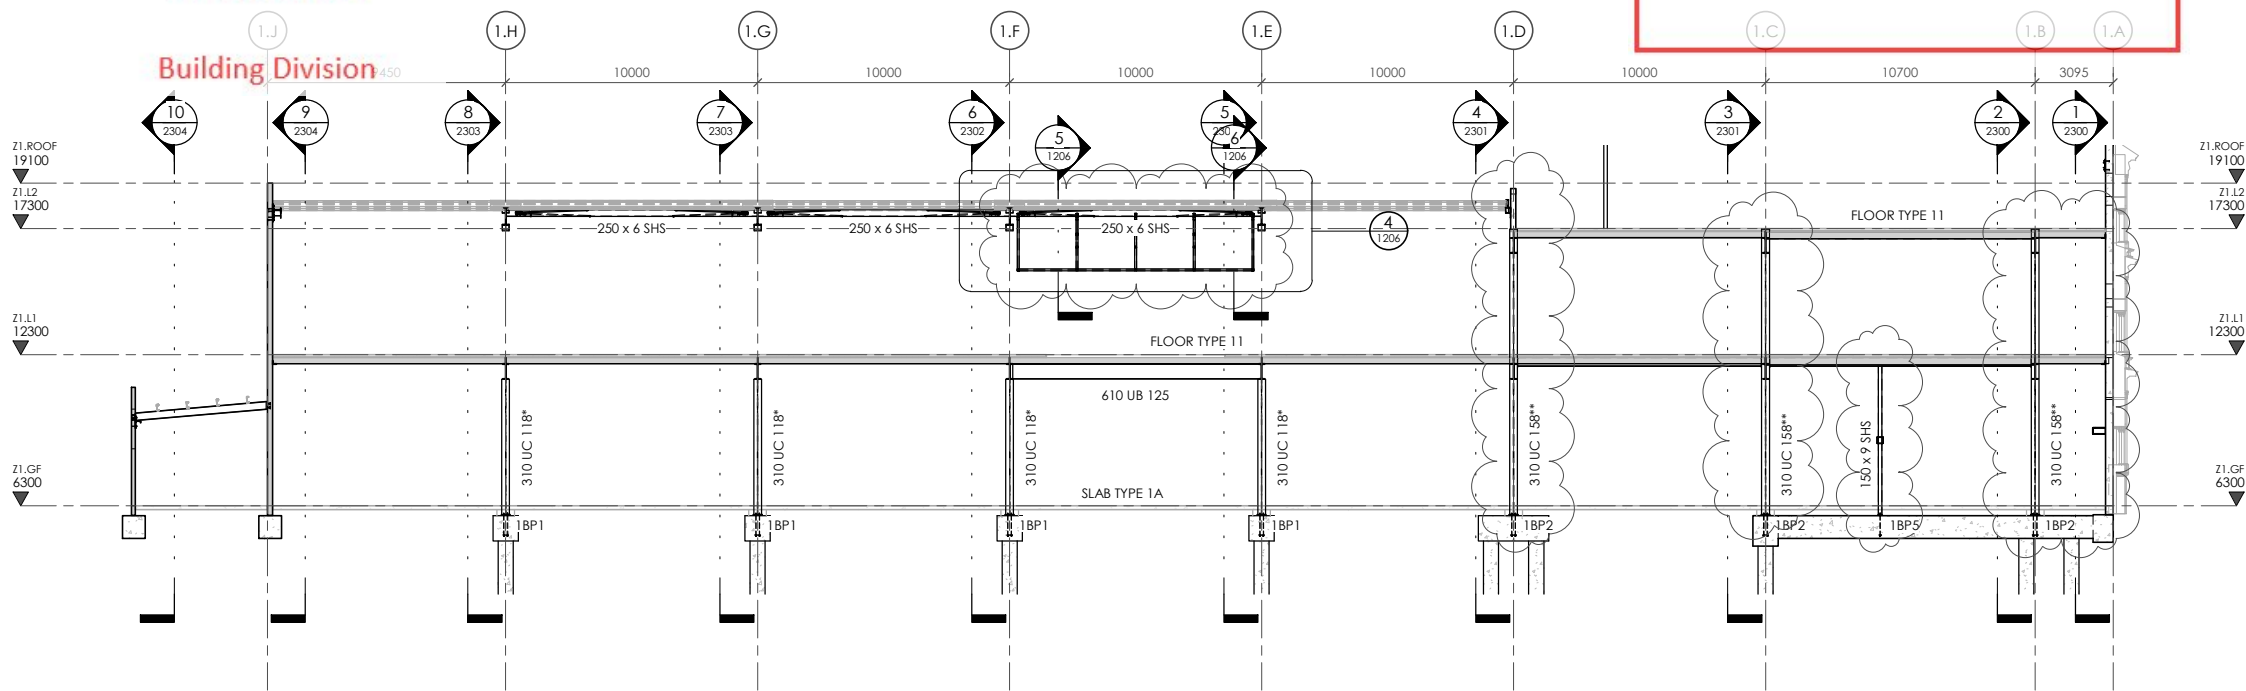

Gridline 1.3

1 : 150 at A1

13
1105

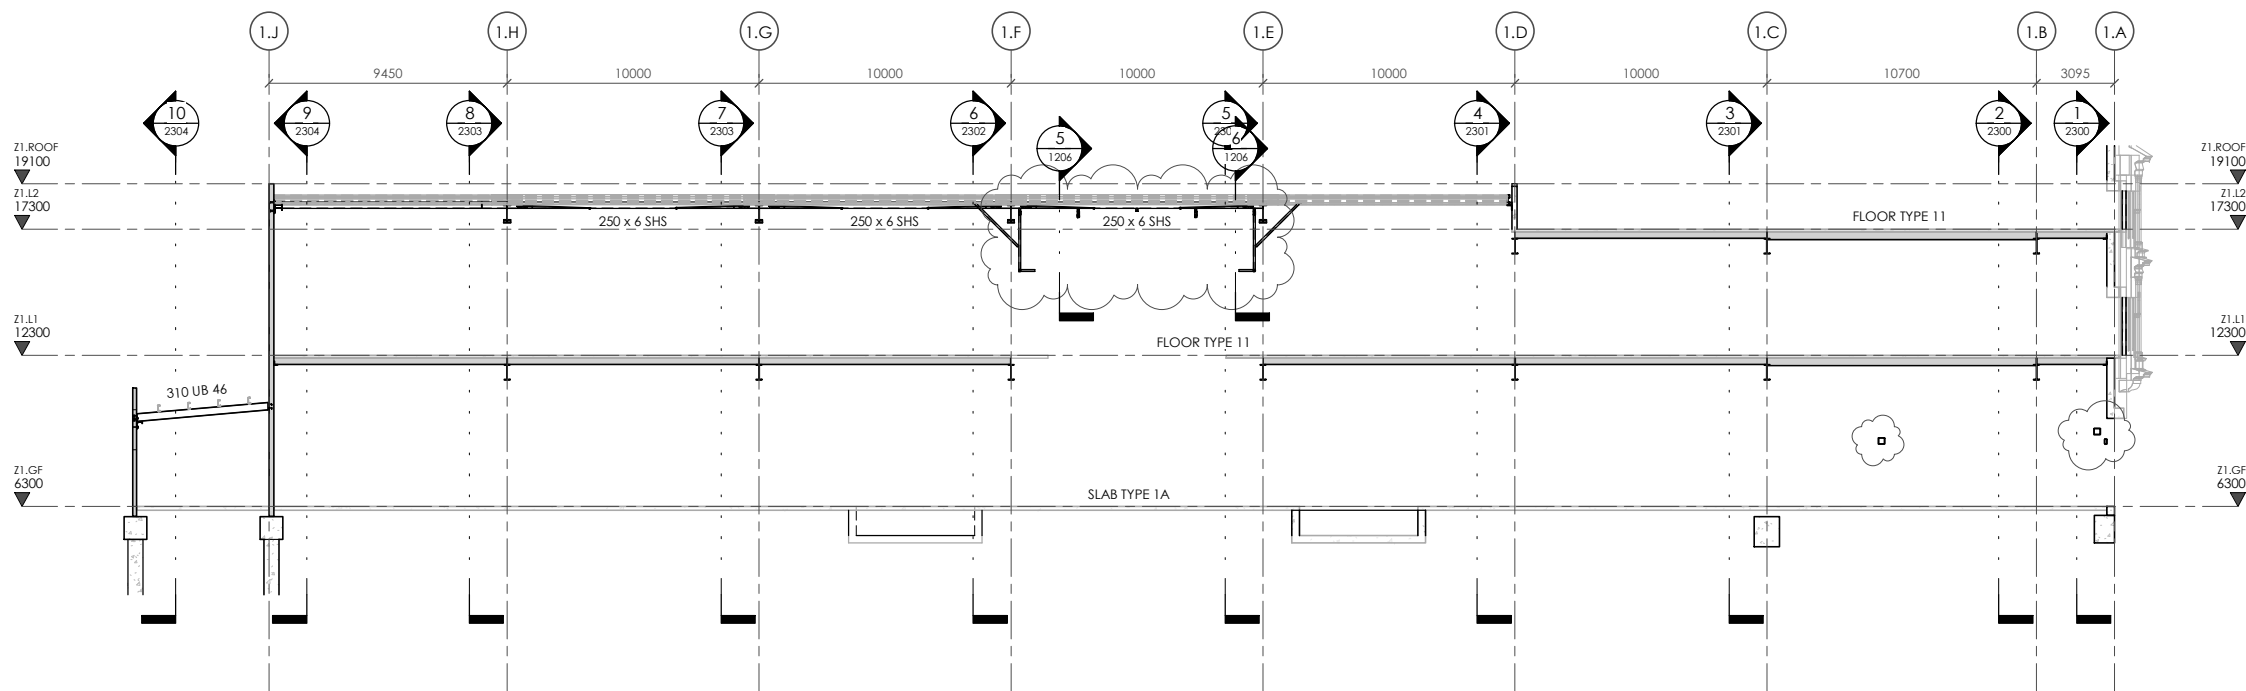


Gridline 1.4

1 : 150 at A1

14
1105

2	25.10.19	CONSENT ISSUE	GPW
1	27.09.19	PEER REVIEW ISSUE	GPW
REV	DATE	AMENDMENT	BY

CLIENT:
HWCP

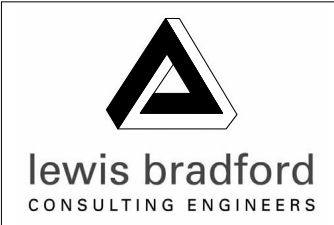

PROJECT:
INVERCARGILL CENTRAL ZONE 1 ANCHOR

DRAWING TITLE:
FRAME ELEVATIONS GRIDLINES 1.3 & 1.4

DRAWN: GPW	SCALE: 1 : 150 at A1
ENGINEER: EL/TSS	
CHECKED: -	
118083-Z1-WD-ST 2306	REV. 2

17 Dec 2019

BUILDING CONSENT NUMBER
2019/1381

THIS DRAWING AND ALL INFORMATION CONTAINED WITHIN IS THE PROPERTY OF LEWIS BRADFORD. ITS CONTENTS ARE CONFIDENTIAL AND MUST NOT BE REPRODUCED OR DISTRIBUTED TO ANY OTHER PERSON OR COMPANY UNLESS AGREED TO IN WRITING BY LEWIS BRADFORD.


CONTRACTOR TO VERIFY ALL DIMENSIONS ON SITE REFER TO ARCHITECT'S DRAWING FOR ALL SETOUTS

NOTES :
Refer drawing 0002 for standard notes. Refer also to Structural Specification.


* indicates steel member to have 30 minutes fire rated paint protection (limiting temperature 550°C)
** indicates steel member to have 60 minutes fire rated paint protection (limiting temperature 550°C)
*** indicates steel member to have 120 minutes fire rated paint protection (limiting temperature 550°C)
Where unprotected areas of steelwork meet fire protected elements overlap the fire protection onto the adjoining 500mm of 'unprotected' structural steel

Invercargill City Council
Building Consent Authority
Approved Site Copy

Approved For Issue
27/02/2020

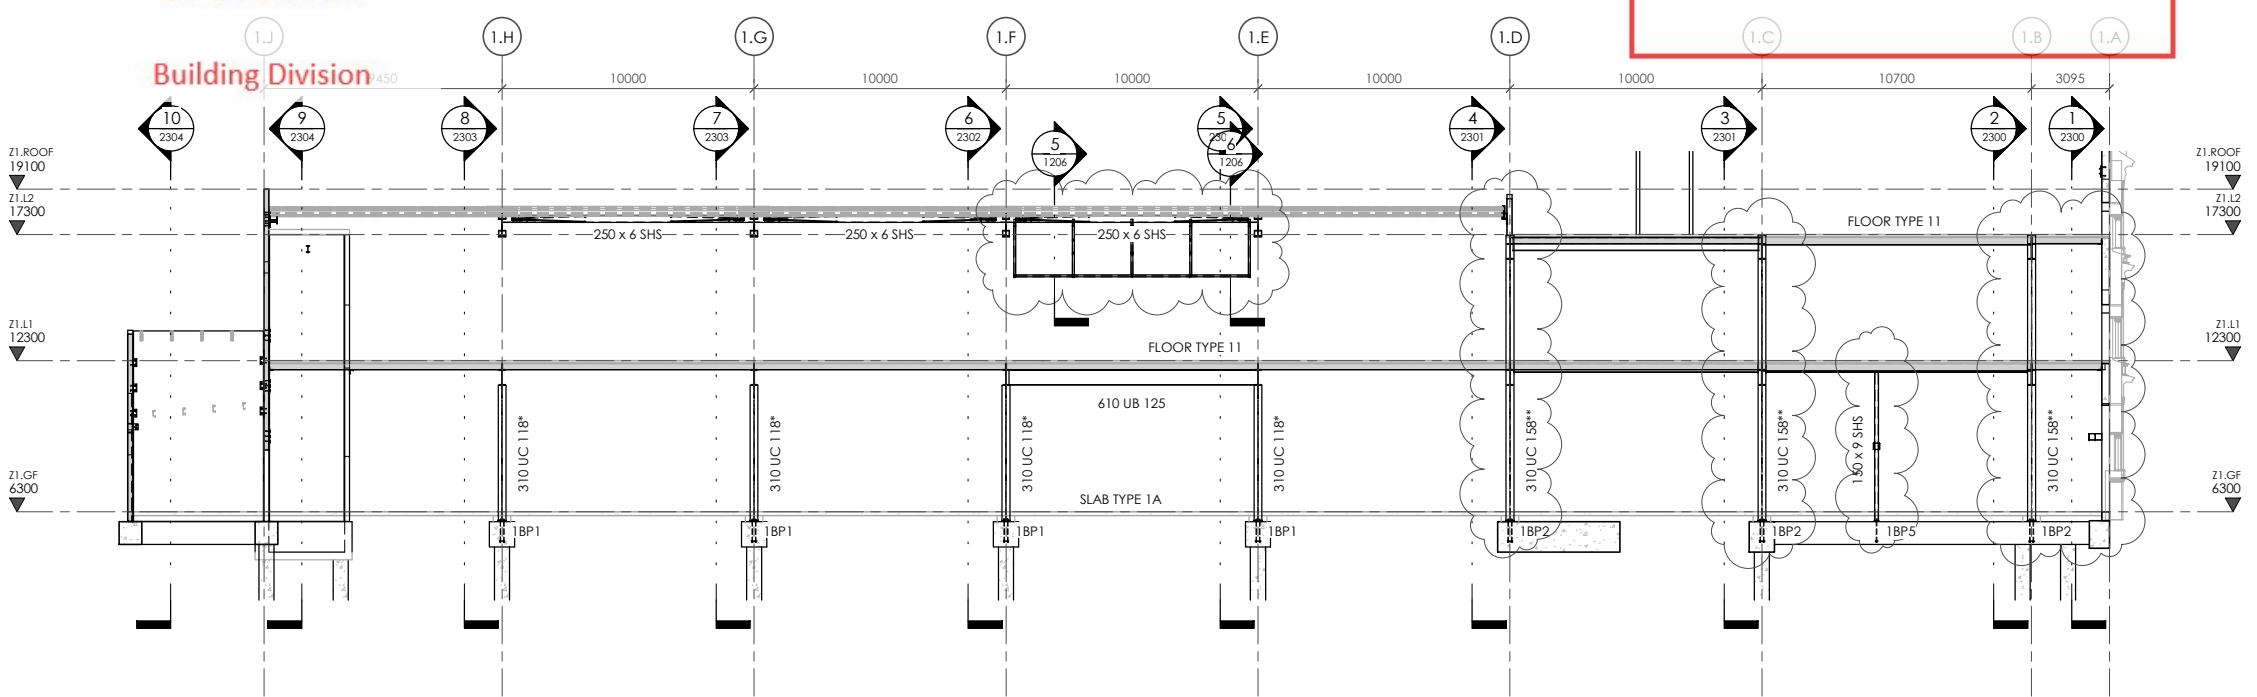


Gridline 1.5
1 : 150 at A1
15
1105

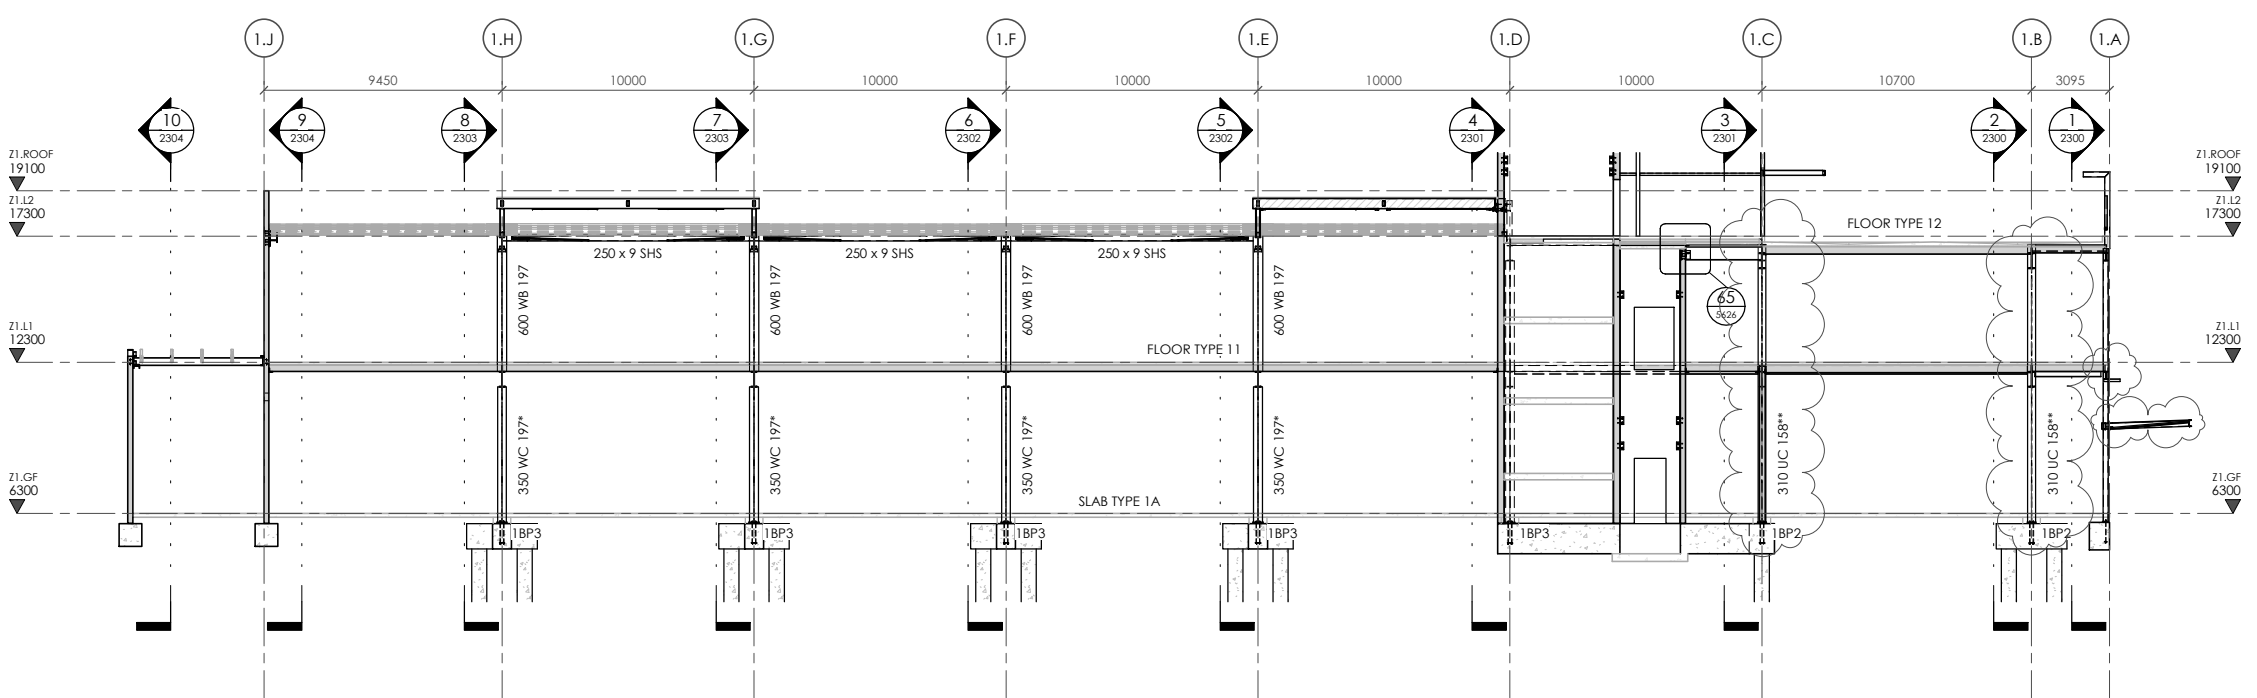

Gridline 1.6
1 : 150 at A1
16
1105

2	25.10.19	CONSENT ISSUE	GPW
1	27.09.19	PEER REVIEW ISSUE	GPW
REV	DATE	AMENDMENT	BY

CLIENT:
HWCP

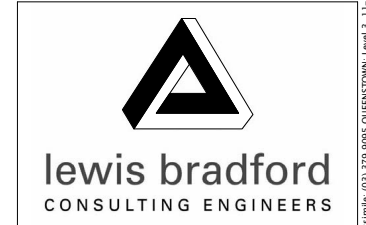

PROJECT:
INVERCARGILL CENTRAL ZONE 1 ANCHOR

DRAWING TITLE:
FRAME ELEVATIONS GRIDLINES 1.5 & 1.6

DRAWN: GPW	SCALE: 1 : 150 at A1
ENGINEER: EL/TSS	
CHECKED: -	
118083-Z1-WD-ST 2307	REV. 2

17 Dec 2019

BUILDING CONSENT NUMBER
2019/1381

THIS DRAWING AND ALL INFORMATION CONTAINED WITHIN IS THE PROPERTY OF LEWIS BRADFORD. ITS CONTENTS ARE CONFIDENTIAL AND MUST NOT BE REPRODUCED OR DISTRIBUTED TO ANY OTHER PERSON OR COMPANY UNLESS AGREED TO IN WRITING BY LEWIS BRADFORD

CONTRACTOR TO VERIFY ALL DIMENSIONS ON SITE REFER TO ARCHITECT'S DRAWING FOR ALL SETOUTS

NOTES :

Refer drawing 0002 for standard notes. Refer also to Structural Specification.

- * indicates steel member to have 30 minutes fire rated paint protection (limiting temperature 550°C)
 - ** indicates steel member to have 60 minutes fire rated paint protection (limiting temperature 550°C)
 - *** indicates steel member to have 120 minutes fire rated paint protection (limiting temperature 550°C)
- Where unprotected areas of steelwork meet fire protected elements overlap the fire protection onto the adjoining 500mm of 'unprotected' structural steel

**Invercargill City Council
Building Consent Authority
Approved Site Copy**

**Approved For Issue
27/02/2020**

REV	DATE	AMENDMENT	BY
2	25.10.19	CONSENT ISSUE	GPW
1	27.09.19	PEER REVIEW ISSUE	GPW


CLIENT:
HWCP

lewis bradford
CONSULTING ENGINEERS

PROJECT:
**INVERCARGILL CENTRAL
ZONE 1 ANCHOR**

DRAWING TITLE:
**FRAME ELEVATIONS
GRIDLINE 1.7**


DRAWN: GPW	SCALE: 1 : 150 at A1
ENGINEER: EL/TSS	
CHECKED: -	
118083-Z1-WD-ST 2308	REV. 2

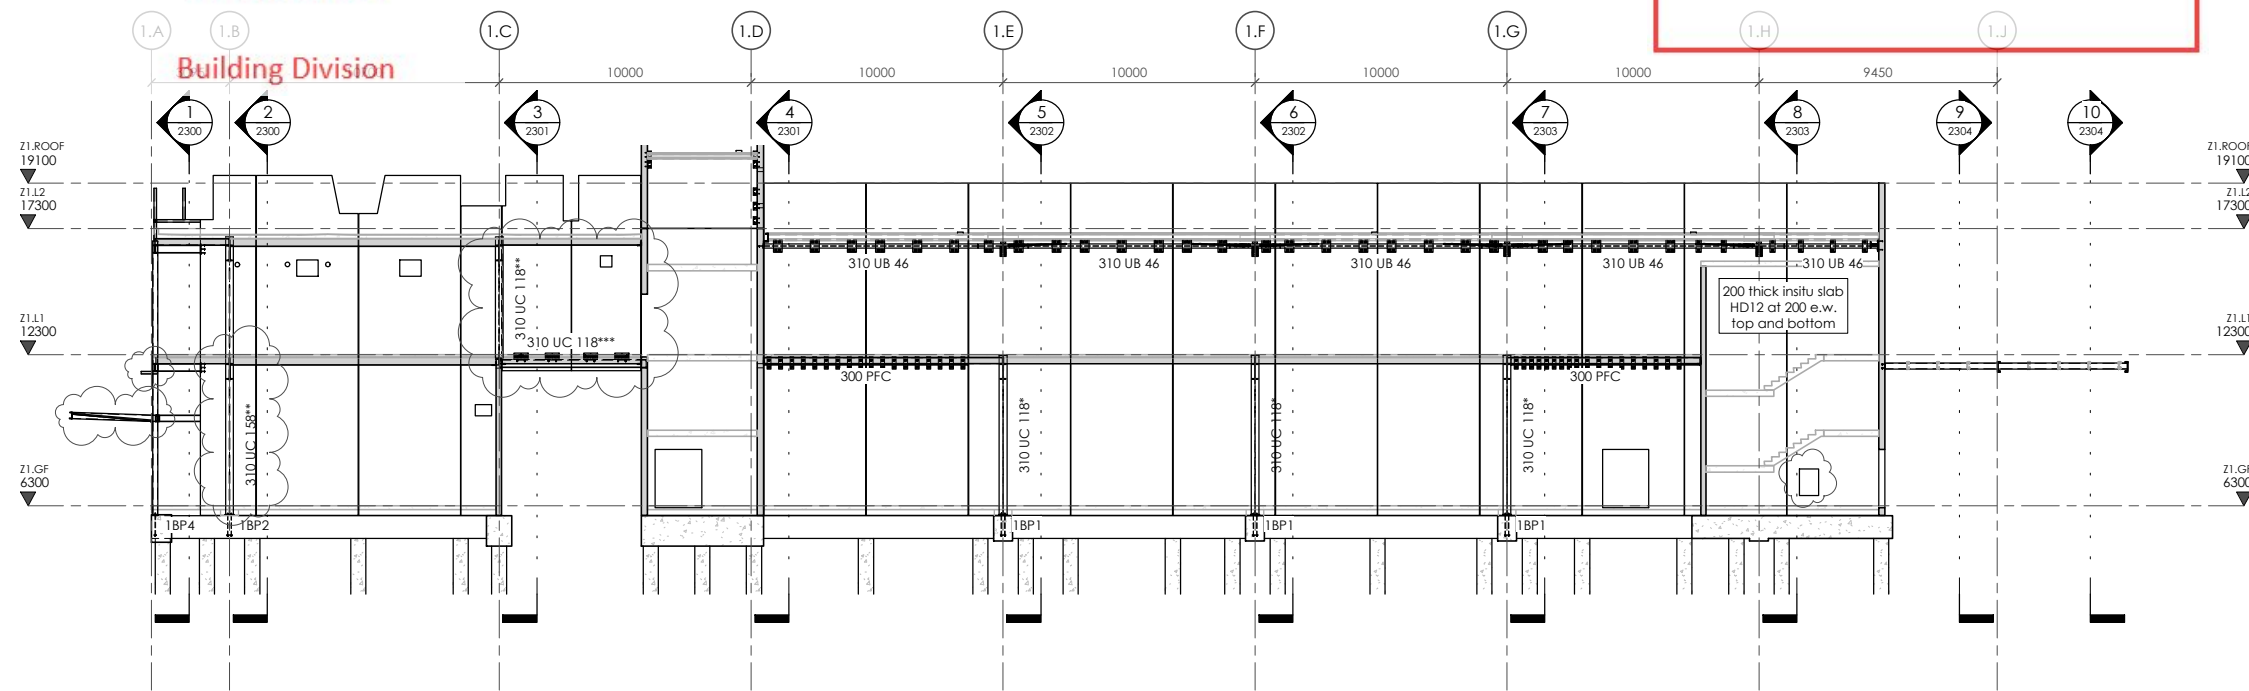

Gridline 1.7
1 : 150 at A1
17/1103

17 Dec 2019

Building Division

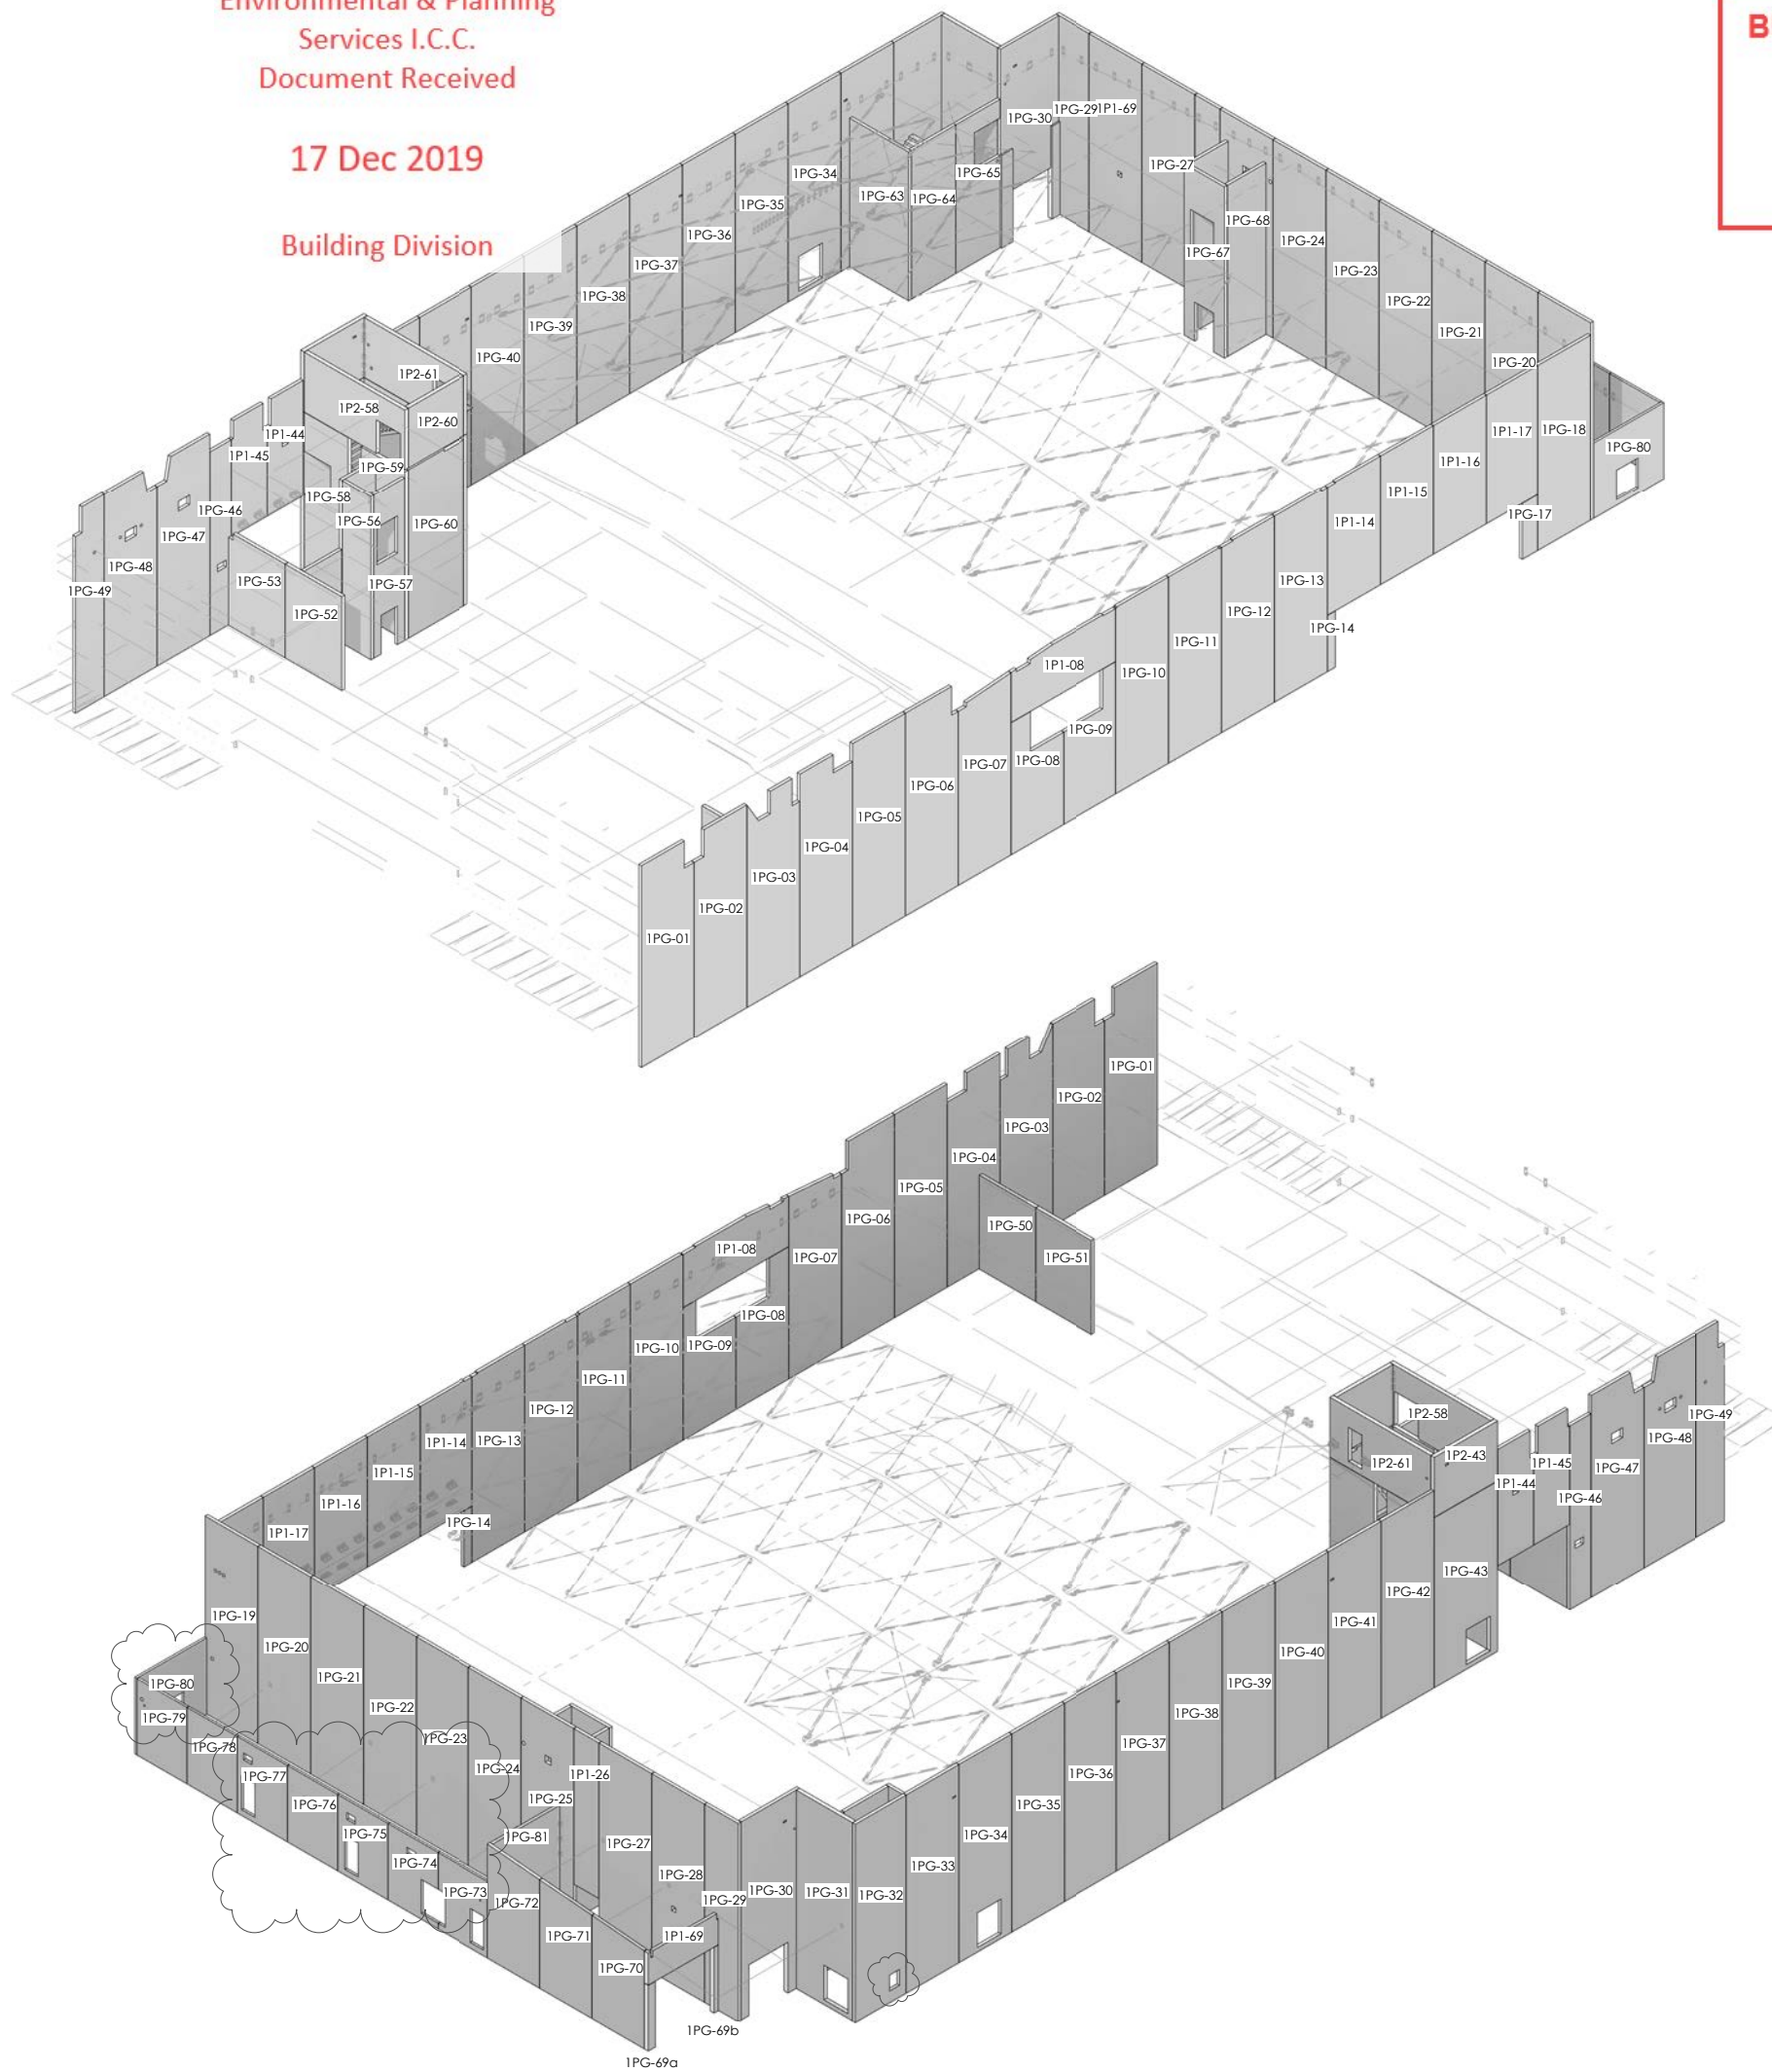

BUILDING CONSENT NUMBER

2019/1381

Panel Reference	Width	Length	Height	Volume	Mass
1PG-01	200	4040	13485	10.63 m³	26042.23 kg
1PG-02	200	4040	13485	10.63 m³	26042.23 kg
1PG-03	200	4040	13485	10.28 m³	25191.26 kg
1PG-04	200	4040	13485	10.54 m³	25824.67 kg
1PG-05	200	4040	13485	10.90 m³	26694.91 kg
1PG-06	200	4040	12385	10.70 m³	26224.32 kg
1PG-07	200	4040	12385	9.62 m³	23580.26 kg
1PG-08	200	4040	8795	5.74 m³	14073.37 kg
1PG-09	200	4040	8795	5.47 m³	13412.38 kg
1PG-10	200	4040	12385	10.01 m³	24514.43 kg
1PG-11	200	4040	12385	10.00 m³	24511.69 kg
1PG-12	200	4040	12385	9.99 m³	24487.68 kg
1PG-13	200	4040	12385	10.00 m³	24502.43 kg
1PG-14	200	592	3734	0.44 m³	1083.07 kg
1PG-17	200	1165	3734	0.87 m³	2131.38 kg
1PG-18	200	4040	12385	10.01 m³	24517.35 kg
1PG-19	200	4040	13185	10.63 m³	26036.22 kg
1PG-20	200	4040	13185	10.65 m³	26101.03 kg
1PG-21	200	4040	13185	10.65 m³	26101.03 kg
1PG-22	200	4040	13185	10.65 m³	26101.03 kg
1PG-23	200	4040	13185	10.65 m³	26101.03 kg
1PG-24	200	4040	13185	10.65 m³	26101.03 kg
1PG-25	200	4040	13185	10.60 m³	25977.75 kg
1PG-27	200	4040	13185	10.65 m³	26101.03 kg
1PG-28	200	4040	13185	10.64 m³	26056.93 kg
1PG-29	200	2582	13185	6.81 m³	16680.75 kg
1PG-30	200	4480	13185	9.78 m³	23950.95 kg
1PG-30	100	4480	6165	0.91 m³	2235.43 kg
1PG-31	250	4310	13185	13.14 m³	32198.85 kg
1PG-32	200	3891	13185	10.10 m³	24743.65 kg
1PG-33	200	4040	13185	10.65 m³	26089.76 kg
1PG-34	200	4040	13185	9.81 m³	24044.06 kg
1PG-35	200	4040	13185	10.65 m³	26101.03 kg
1PG-36	200	4040	13185	10.65 m³	26101.03 kg
1PG-37	200	4040	13185	10.65 m³	26089.76 kg
1PG-38	200	4040	13185	10.65 m³	26101.03 kg
1PG-39	200	4040	13185	10.65 m³	26101.03 kg
1PG-40	200	4040	13185	10.65 m³	26101.03 kg
1PG-41	200	4040	13185	10.65 m³	26089.76 kg
1PG-42	200	4040	13185	10.65 m³	26101.03 kg
1PG-43	250	4850	11385	12.74 m³	31212.67 kg
1PG-46	200	1615	12285	3.91 m³	9578.41 kg
1PG-47	200	4040	13485	10.52 m³	25770.03 kg
1PG-48	200	4040	13485	10.51 m³	25745.09 kg
1PG-49	200	2195	13485	5.74 m³	14057.43 kg
1PG-50	225	4340	6235	6.09 m³	14916.77 kg
1PG-51	225	4340	6235	6.09 m³	14916.77 kg
1PG-52	225	4340	6235	6.09 m³	14916.77 kg
1PG-53	225	4340	6235	6.06 m³	14840.34 kg
1PG-54	200	2899	6235	3.62 m³	8856.88 kg
1PG-55	200	2580	10885	5.58 m³	13661.59 kg
1PG-56	200	2205	10885	4.80 m³	11760.70 kg
1PG-57	200	2360	10885	3.71 m³	9095.49 kg
1PG-58	250	3363	11385	8.27 m³	20268.00 kg
1PG-59	250	3363	11385	9.47 m³	23210.92 kg
1PG-60	250	4310	11385	12.09 m³	29608.98 kg
1PG-61	250	3363	11385	9.57 m³	23447.76 kg
1PG-62	250	3363	11385	9.57 m³	23434.67 kg
1PG-63	200	4530	9885	8.96 m³	21941.73 kg
1PG-64	200	3400	9885	6.72 m³	16468.41 kg
1PG-65	200	3400	9885	5.73 m³	14031.01 kg
1PG-66	200	2960	11385	6.74 m³	16512.80 kg
1PG-67	200	3100	11385	5.42 m³	13282.80 kg
1PG-68	200	2960	11385	6.74 m³	16512.80 kg
1PG-69a	300	550	4370	0.72 m³	1766.57 kg
1PG-69b	300	330	4370	0.43 m³	1059.94 kg
1PG-70	200	4005	7485	5.36 m³	13137.77 kg
1PG-71	200	4005	7485	5.64 m³	13827.38 kg
1PG-72	200	4005	7485	5.93 m³	14527.93 kg
1PG-73	150	3836	5085	2.40 m³	5875.95 kg
1PG-74	150	3836	5085	2.44 m³	5985.85 kg
1PG-75	150	3836	5085	2.54 m³	6212.22 kg
1PG-76	150	3836	5085	2.92 m³	7163.79 kg
1PG-77	150	3836	5085	2.54 m³	6212.22 kg
1PG-78	150	3836	5085	2.93 m³	7167.94 kg
1PG-79	150	3836	5085	2.92 m³	7149.81 kg
1PG-80	150	5380	5085	3.61 m³	8835.18 kg
1PG-81	200	5160	7565	7.81 m³	19127.85 kg
1PI-14	200	4040	8636	6.97 m³	17076.01 kg
1PI-15	200	4040	8636	6.98 m³	17096.42 kg
1PI-16	200	4040	8636	6.98 m³	17096.42 kg
1PI-17	200	3905	8636	6.74 m³	16525.13 kg
1PI-26	200	1908	10346	3.95 m³	9672.51 kg
1PI-44	200	2740	7735	4.10 m³	10045.31 kg
1PI-45	200	2740	7735	4.09 m³	10024.88 kg
1PI-69	200	5380	2115	2.25 m³	5524.41 kg
1PI-69	100	550	2115	0.10 m³	250.57 kg
1PI-69	100	330	1714	0.06 m³	138.54 kg
1PI-08	200	8100	3590	5.67 m³	13892.57 kg
1P2-43	250	4850	3985	4.83 m³	11823.76 kg
1P2-58	250	7725	3985	6.66 m³	16320.80 kg
1P2-60	250	4310	3985	4.29 m³	10519.90 kg
1P2-61	250	7725	3985	7.11 m³	17417.49 kg
Grand total:	93				

THIS DRAWING AND ALL INFORMATION CONTAINED WITHIN IS THE PROPERTY OF LEWIS BRADFORD. ITS CONTENTS ARE CONFIDENTIAL AND MUST NOT BE REPRODUCED OR DISTRIBUTED TO ANY OTHER PERSON OR COMPANY UNLESS AGREED TO IN WRITING BY LEWIS BRADFORD

CONTRACTOR TO VERIFY ALL DIMENSIONS ON SITE REFER TO ARCHITECT'S DRAWING FOR ALL SETOUTS

NOTES:
Refer drawing 0002 for standard notes.
Refer also to Structural Specification.
Refer also 5300 & 5310 series drawings for precast panel details
Xypex additive to be added to all precast panels on Gridlines 1.1, 1.7 & 1.J and precast panels 1PG-30 & 1PG31 to southeastern re-entrant corner

Invercargill City Council
Building Consent Authority
Approved Site Copy

Approved For Issue
27/02/2020

REV	DATE	AMENDMENT	BY
2	25.10.19	CONSENT ISSUE	GPW
1	27.09.19	PEER REVIEW ISSUE	GPW

CLIENT:
HWCP

lewis bradford
CONSULTING ENGINEERS

PROJECT:
INVERCARGILL CENTRAL ZONE 1 ANCHOR

DRAWING TITLE:
PRECAST PANEL 3D VIEW

DRAWN:	GPW	SCALE:	at A1
ENGINEER:	EL/TSS		
CHECKED:	-		
118083-Z1-WD-ST 2400			REV. 2

BUILDING CONSENT NUMBER
2019/1381

THIS DRAWING AND ALL INFORMATION CONTAINED WITHIN IS THE PROPERTY OF LEWIS BRADFORD. ITS CONTENTS ARE CONFIDENTIAL AND MUST NOT BE REPRODUCED OR DISTRIBUTED TO ANY OTHER PERSON OR COMPANY UNLESS AGREED TO IN WRITING BY LEWIS BRADFORD

CONTRACTOR TO VERIFY ALL DIMENSIONS ON SITE REFER TO ARCHITECT'S DRAWING FOR ALL SETOUTS

NOTES :


- Refer drawing 0002 for standard notes. Refer also to Structural Specification.
- Refer also 5300 & 5310 series drawings for precast panel details
- Xypex additive to be added to all precast panels on Gridlines 1.1, 1.7 & 1.J and precast panels 1PG-30 & 1PG-31 to southeastern re-entrant corner

Invercargill City Council Building Consent Authority Approved Site Copy

Approved For Issue 27/02/2020

REV	DATE	AMENDMENT	BY
2	25.10.19	CONSENT ISSUE	GPW
1	27.09.19	PEER REVIEW ISSUE	GPW


CLIENT:
HWCP

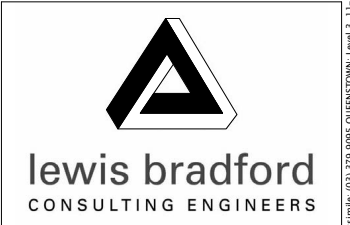

PROJECT:
INVERCARGILL CENTRAL ZONE 1 ANCHOR

DRAWING TITLE:
PRECAST PANEL PLANS GROUND FLOOR FIRST FLOOR

DRAWN: GPW	SCALE: 1 : 200 at A1
ENGINEER: EL/TSS	
CHECKED: -	
118083-Z1-WD-ST 2401	REV. 2

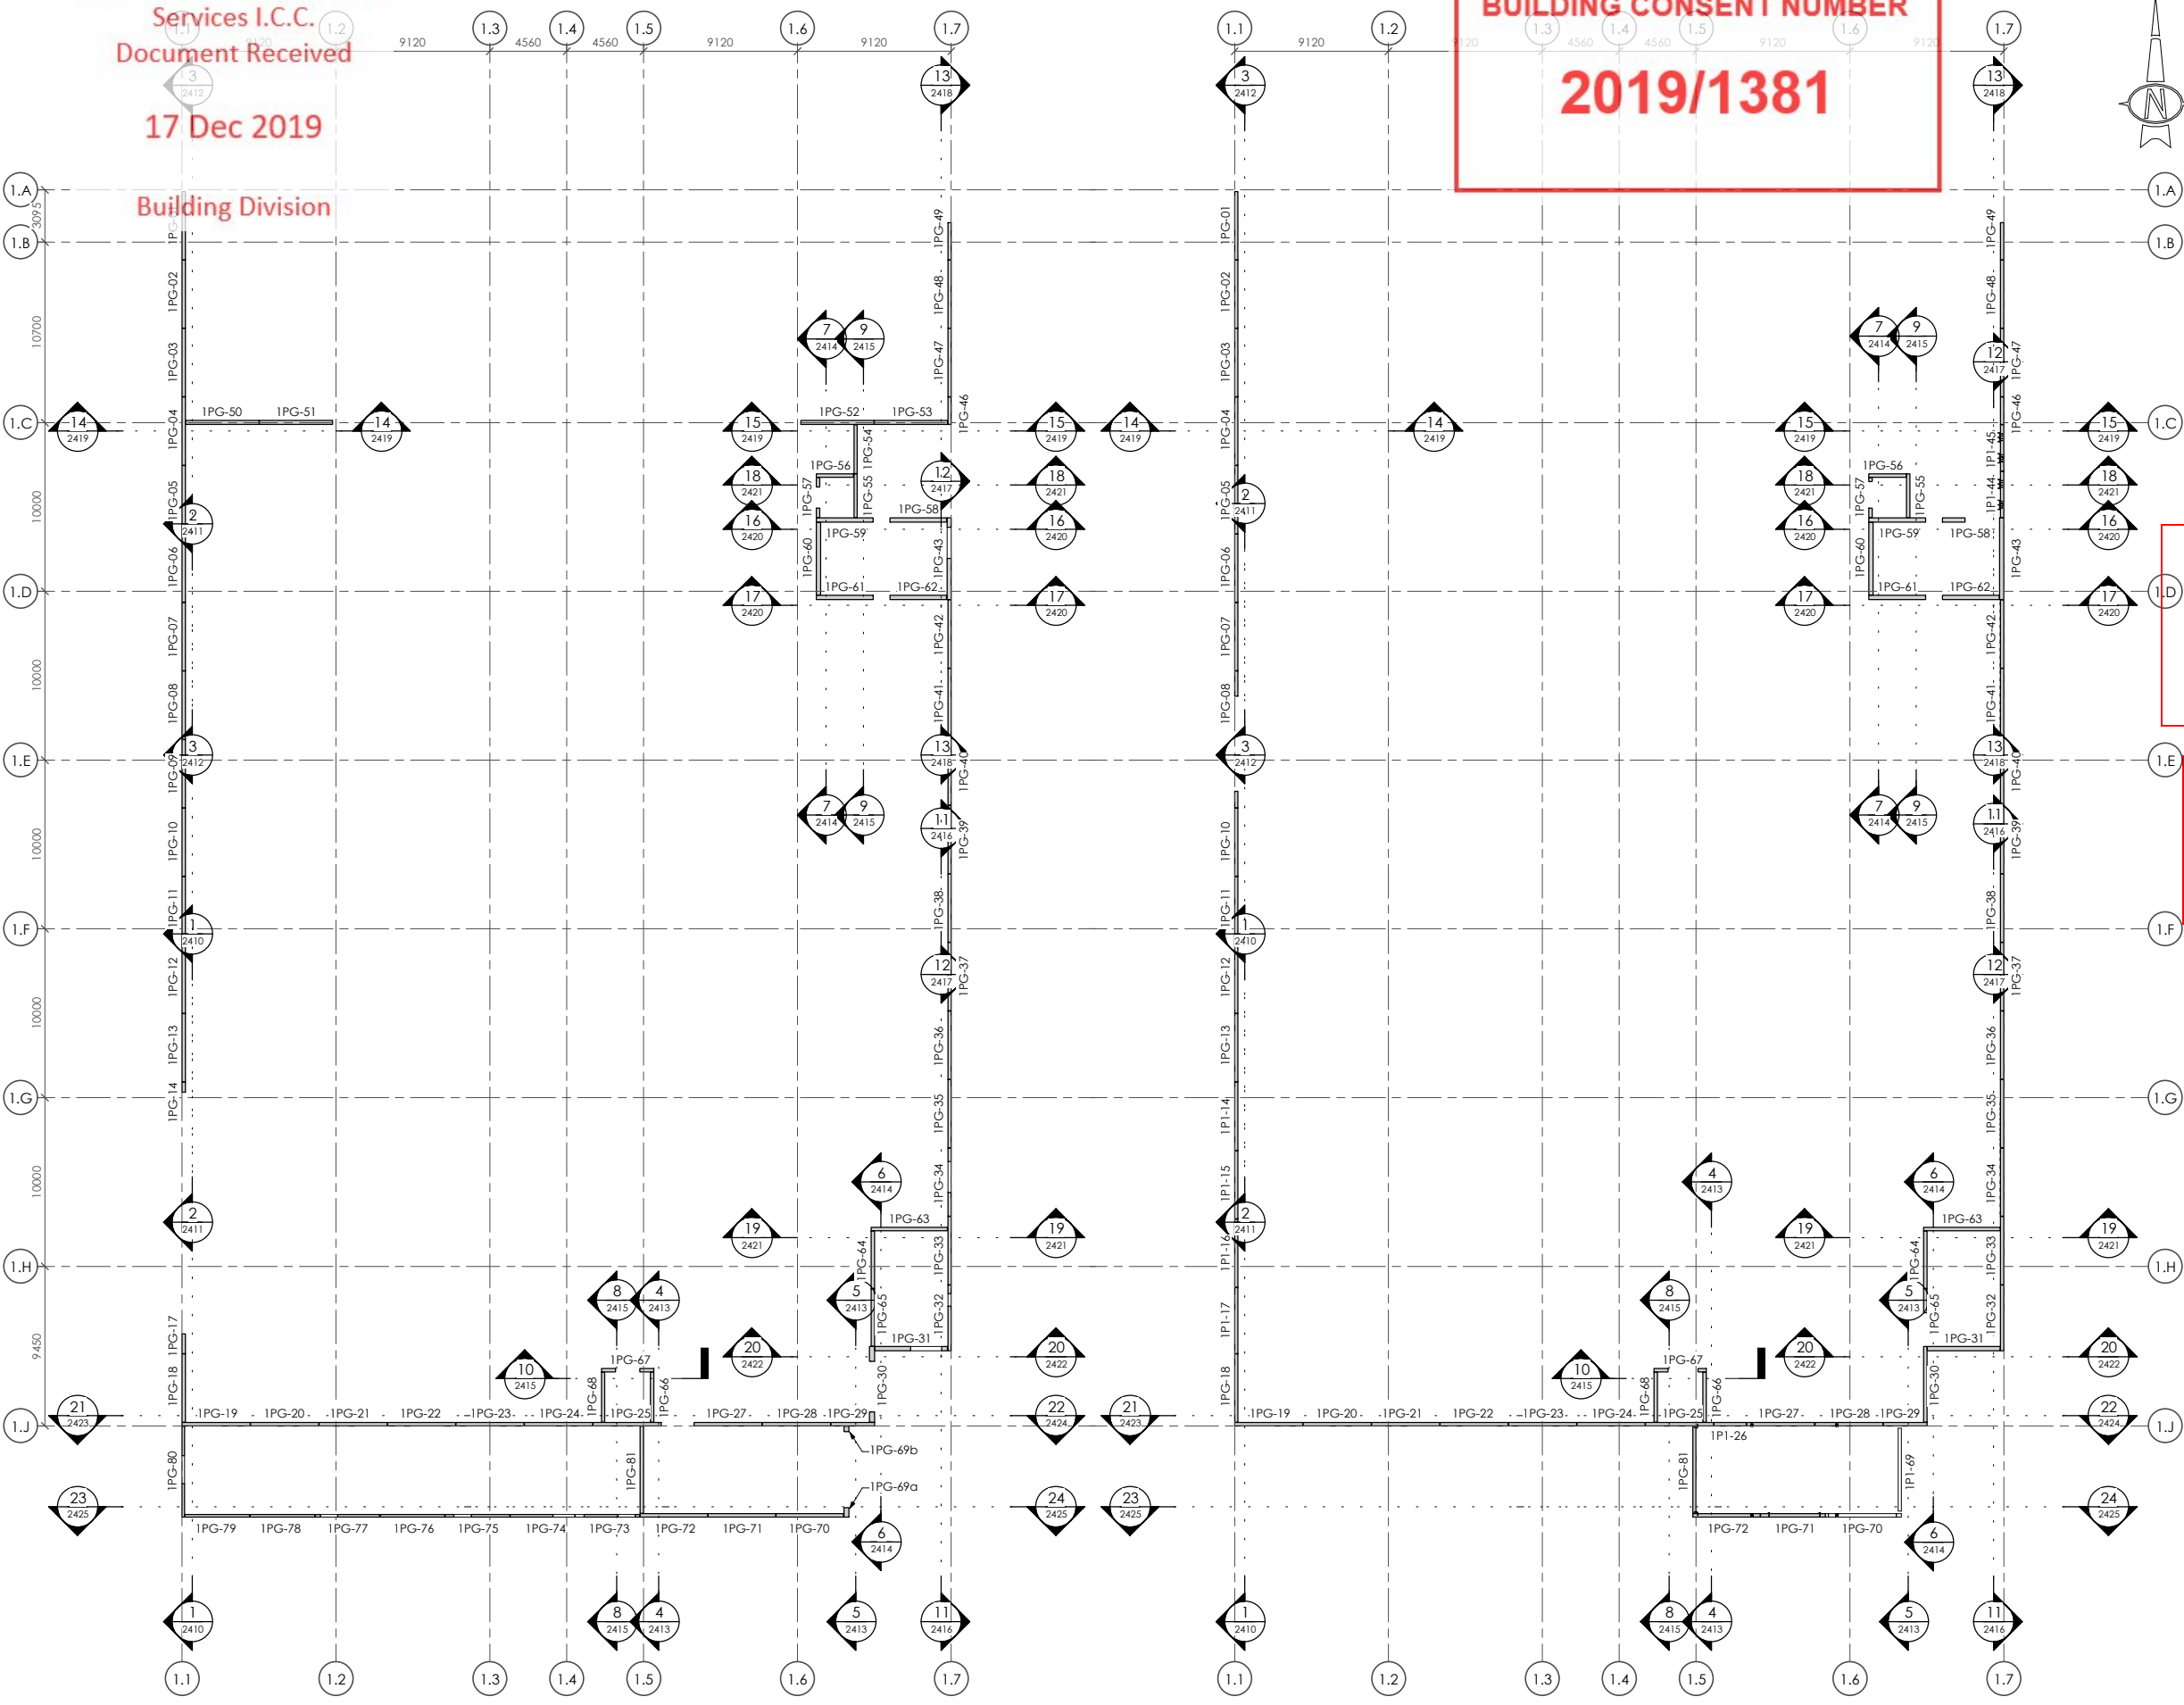

GROUND FLOOR - PRECAST PANEL PLAN
1 : 200

LEVEL 1 - PRECAST PANEL PLAN
1 : 200

17 Dec 2019

Building Division

BUILDING CONSENT NUMBER
2019/1381


THIS DRAWING AND ALL INFORMATION CONTAINED WITHIN IS THE PROPERTY OF LEWIS BRADFORD. ITS CONTENTS ARE CONFIDENTIAL AND MUST NOT BE REPRODUCED OR DISTRIBUTED TO ANY OTHER PERSON OR COMPANY UNLESS AGREED TO IN WRITING BY LEWIS BRADFORD

CONTRACTOR TO VERIFY ALL DIMENSIONS ON SITE REFER TO ARCHITECT'S DRAWING FOR ALL SETOUTS

NOTES :
Refer drawing 0002 for standard notes. Refer also to Structural Specification.
Refer also 5300 & 5310 series drawings for precast panel details
Xypex additive to be added to all precast panels on Gridlines 1.1, 1.7 & 1.J and precast panels 1PG-30 & 1PG31 to southeastern re-entrant corner

**Invercargill City Council
Building Consent Authority
Approved Site Copy**

**Approved For Issue
27/02/2020**

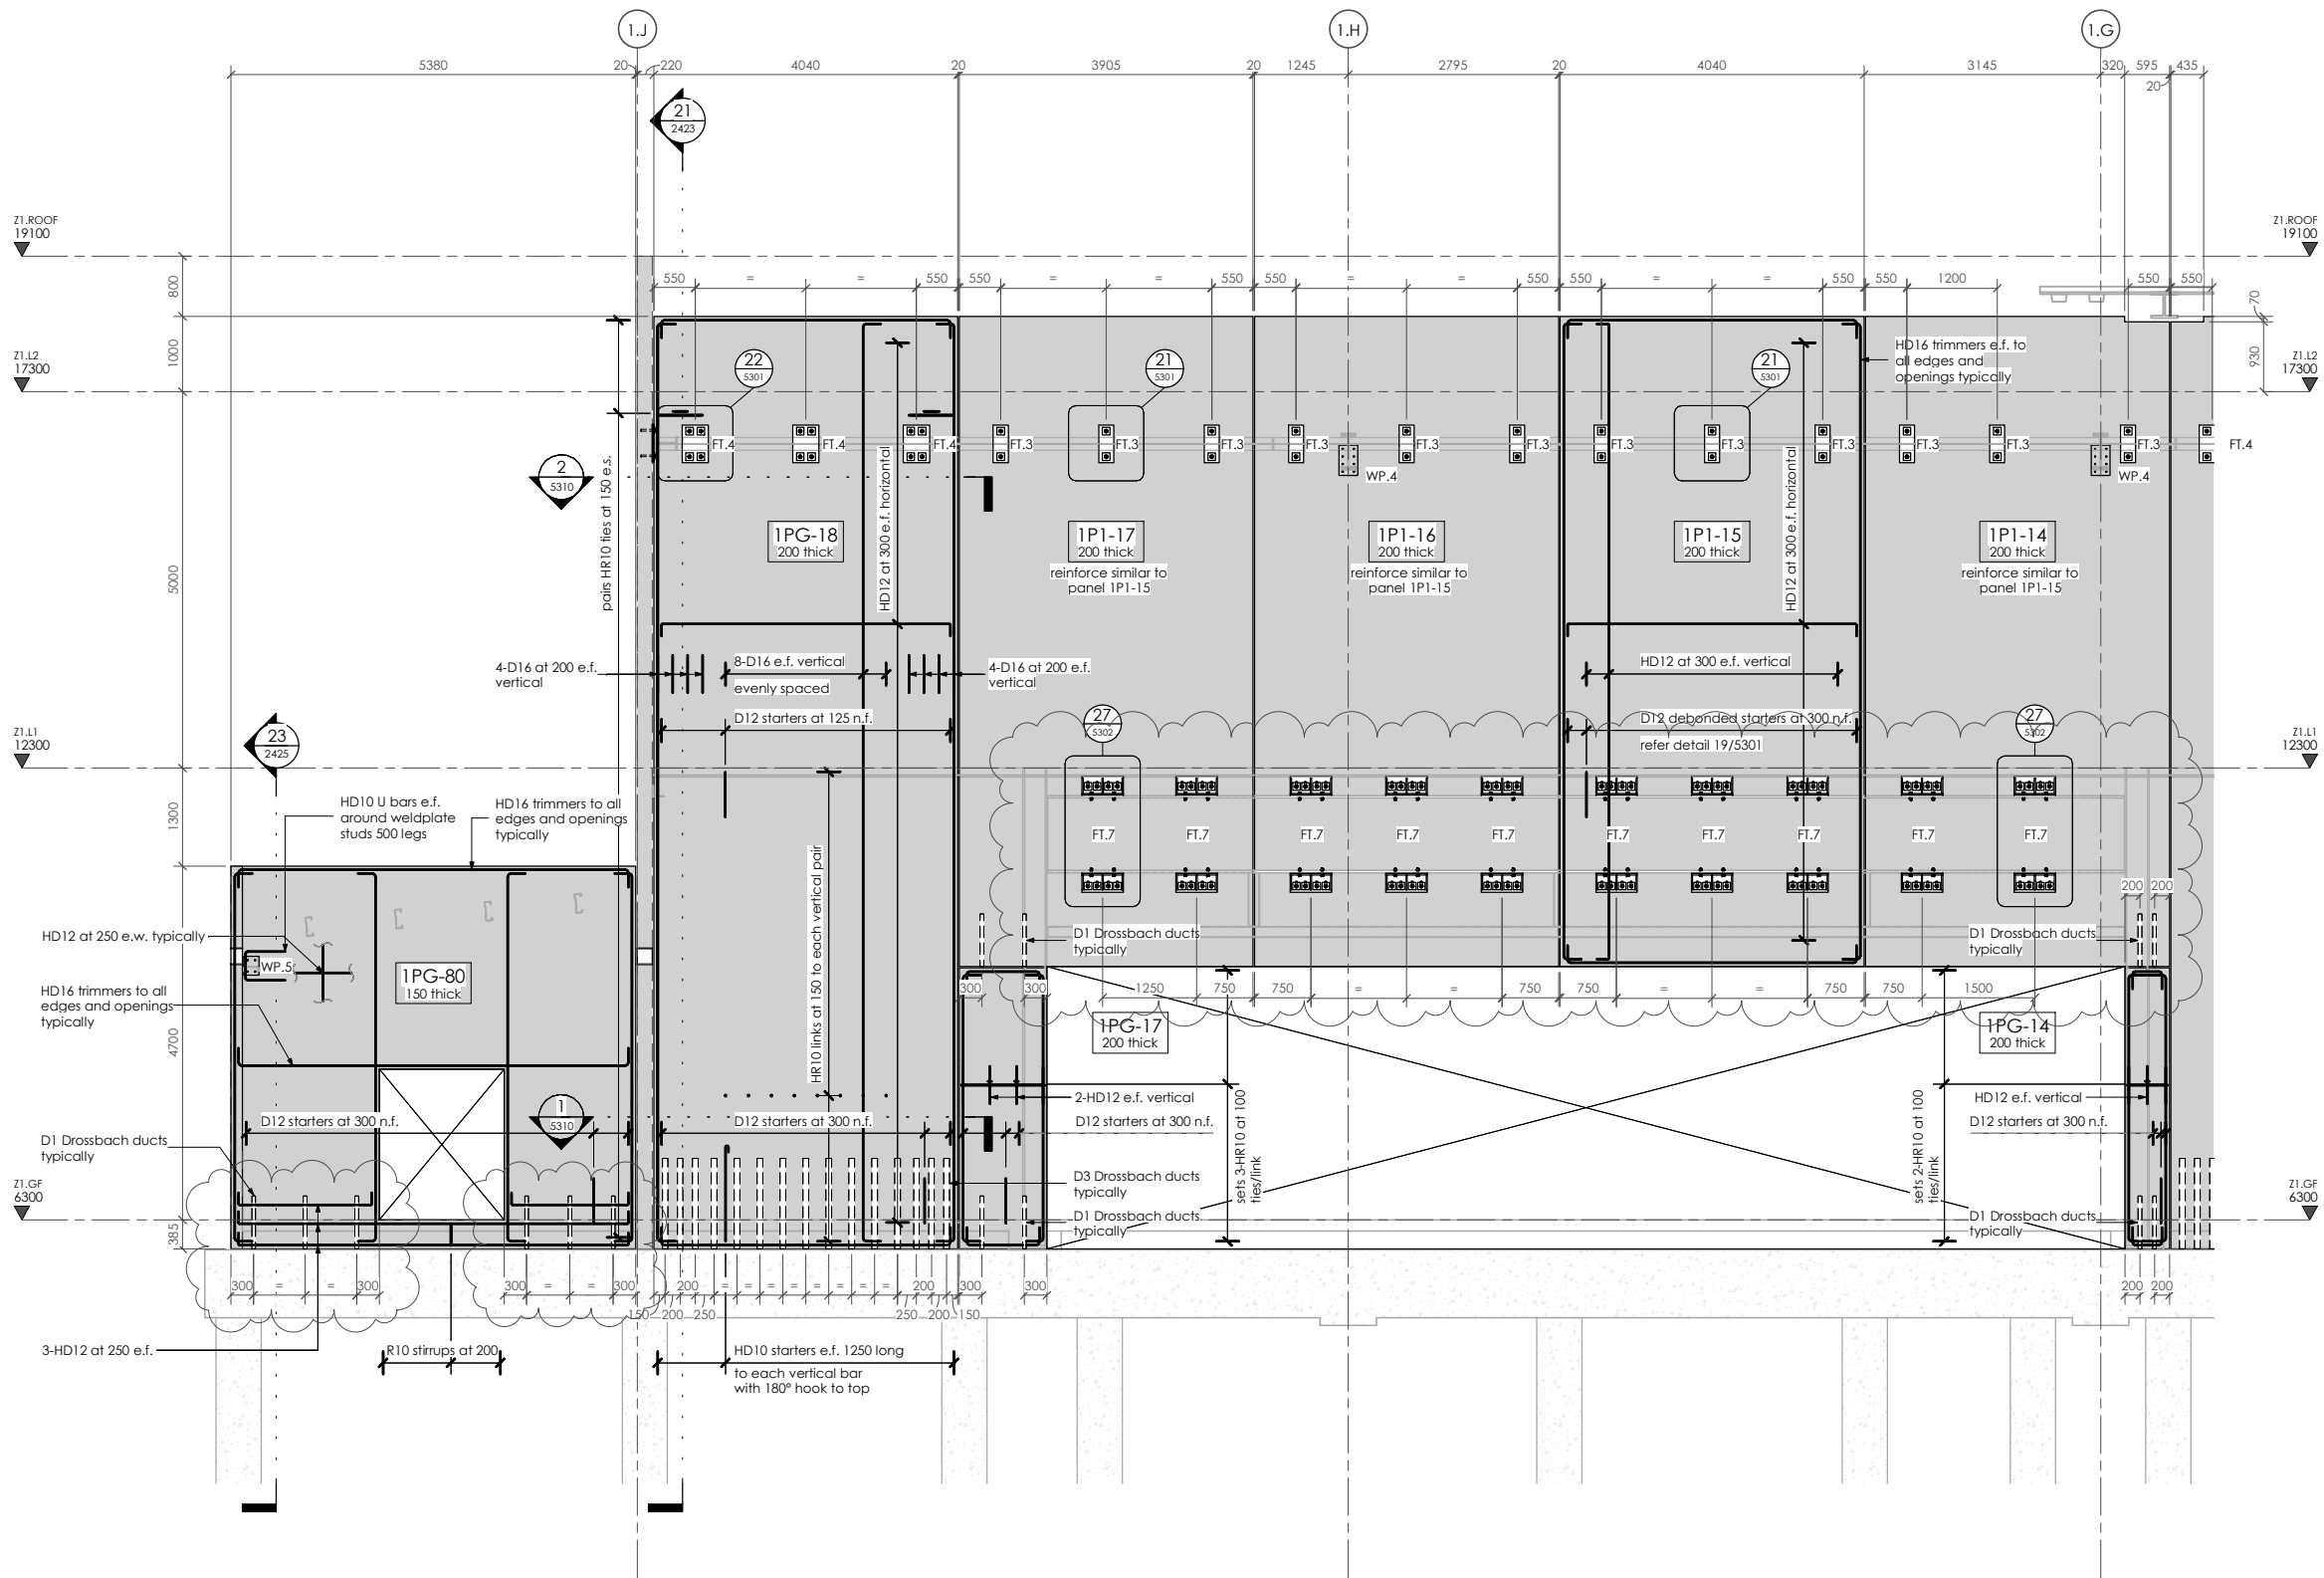


PANEL ELEVATIONS - Gridline 1.1 - Part 1

1 : 50 at A1
1/2401

2	25.10.19	CONSENT ISSUE	GPW
1	27.09.19	PEER REVIEW ISSUE	GPW
REV	DATE	AMENDMENT	BY

CLIENT:
HWCP

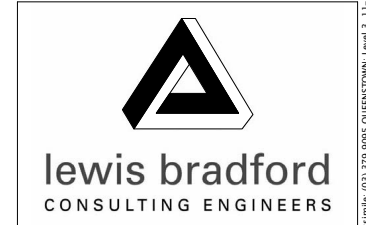

PROJECT:
**INVERCARGILL CENTRAL
ZONE 1 ANCHOR**

DRAWING TITLE:
**PRECAST PANEL
ELEVATIONS
GRIDLINE 1.1 - PART 1**

DRAWN: GPW	SCALE: 1 : 50 at A1
ENGINEER: EL/TSS	
CHECKED: -	
118083-Z1-WD-ST 2410	REV. 2

17 Dec 2019

Building Division


BUILDING CONSENT NUMBER
2019/1381

THIS DRAWING AND ALL INFORMATION CONTAINED WITHIN IS THE PROPERTY OF LEWIS BRADFORD. ITS CONTENTS ARE CONFIDENTIAL AND MUST NOT BE REPRODUCED OR DISTRIBUTED TO ANY OTHER PERSON OR COMPANY UNLESS AGREED TO IN WRITING BY LEWIS BRADFORD

CONTRACTOR TO VERIFY ALL DIMENSIONS ON SITE REFER TO ARCHITECT'S DRAWING FOR ALL SETOUTS

NOTES :

- Refer drawing 0002 for standard notes. Refer also to Structural Specification.
- Refer also 5300 & 5310 series drawings for precast panel details
- Xypex additive to be added to all precast panels on Gridlines 1.1, 1.7 & 1.J and precast panels 1PG-30 & 1PG31 to southeastern re-entrant corner

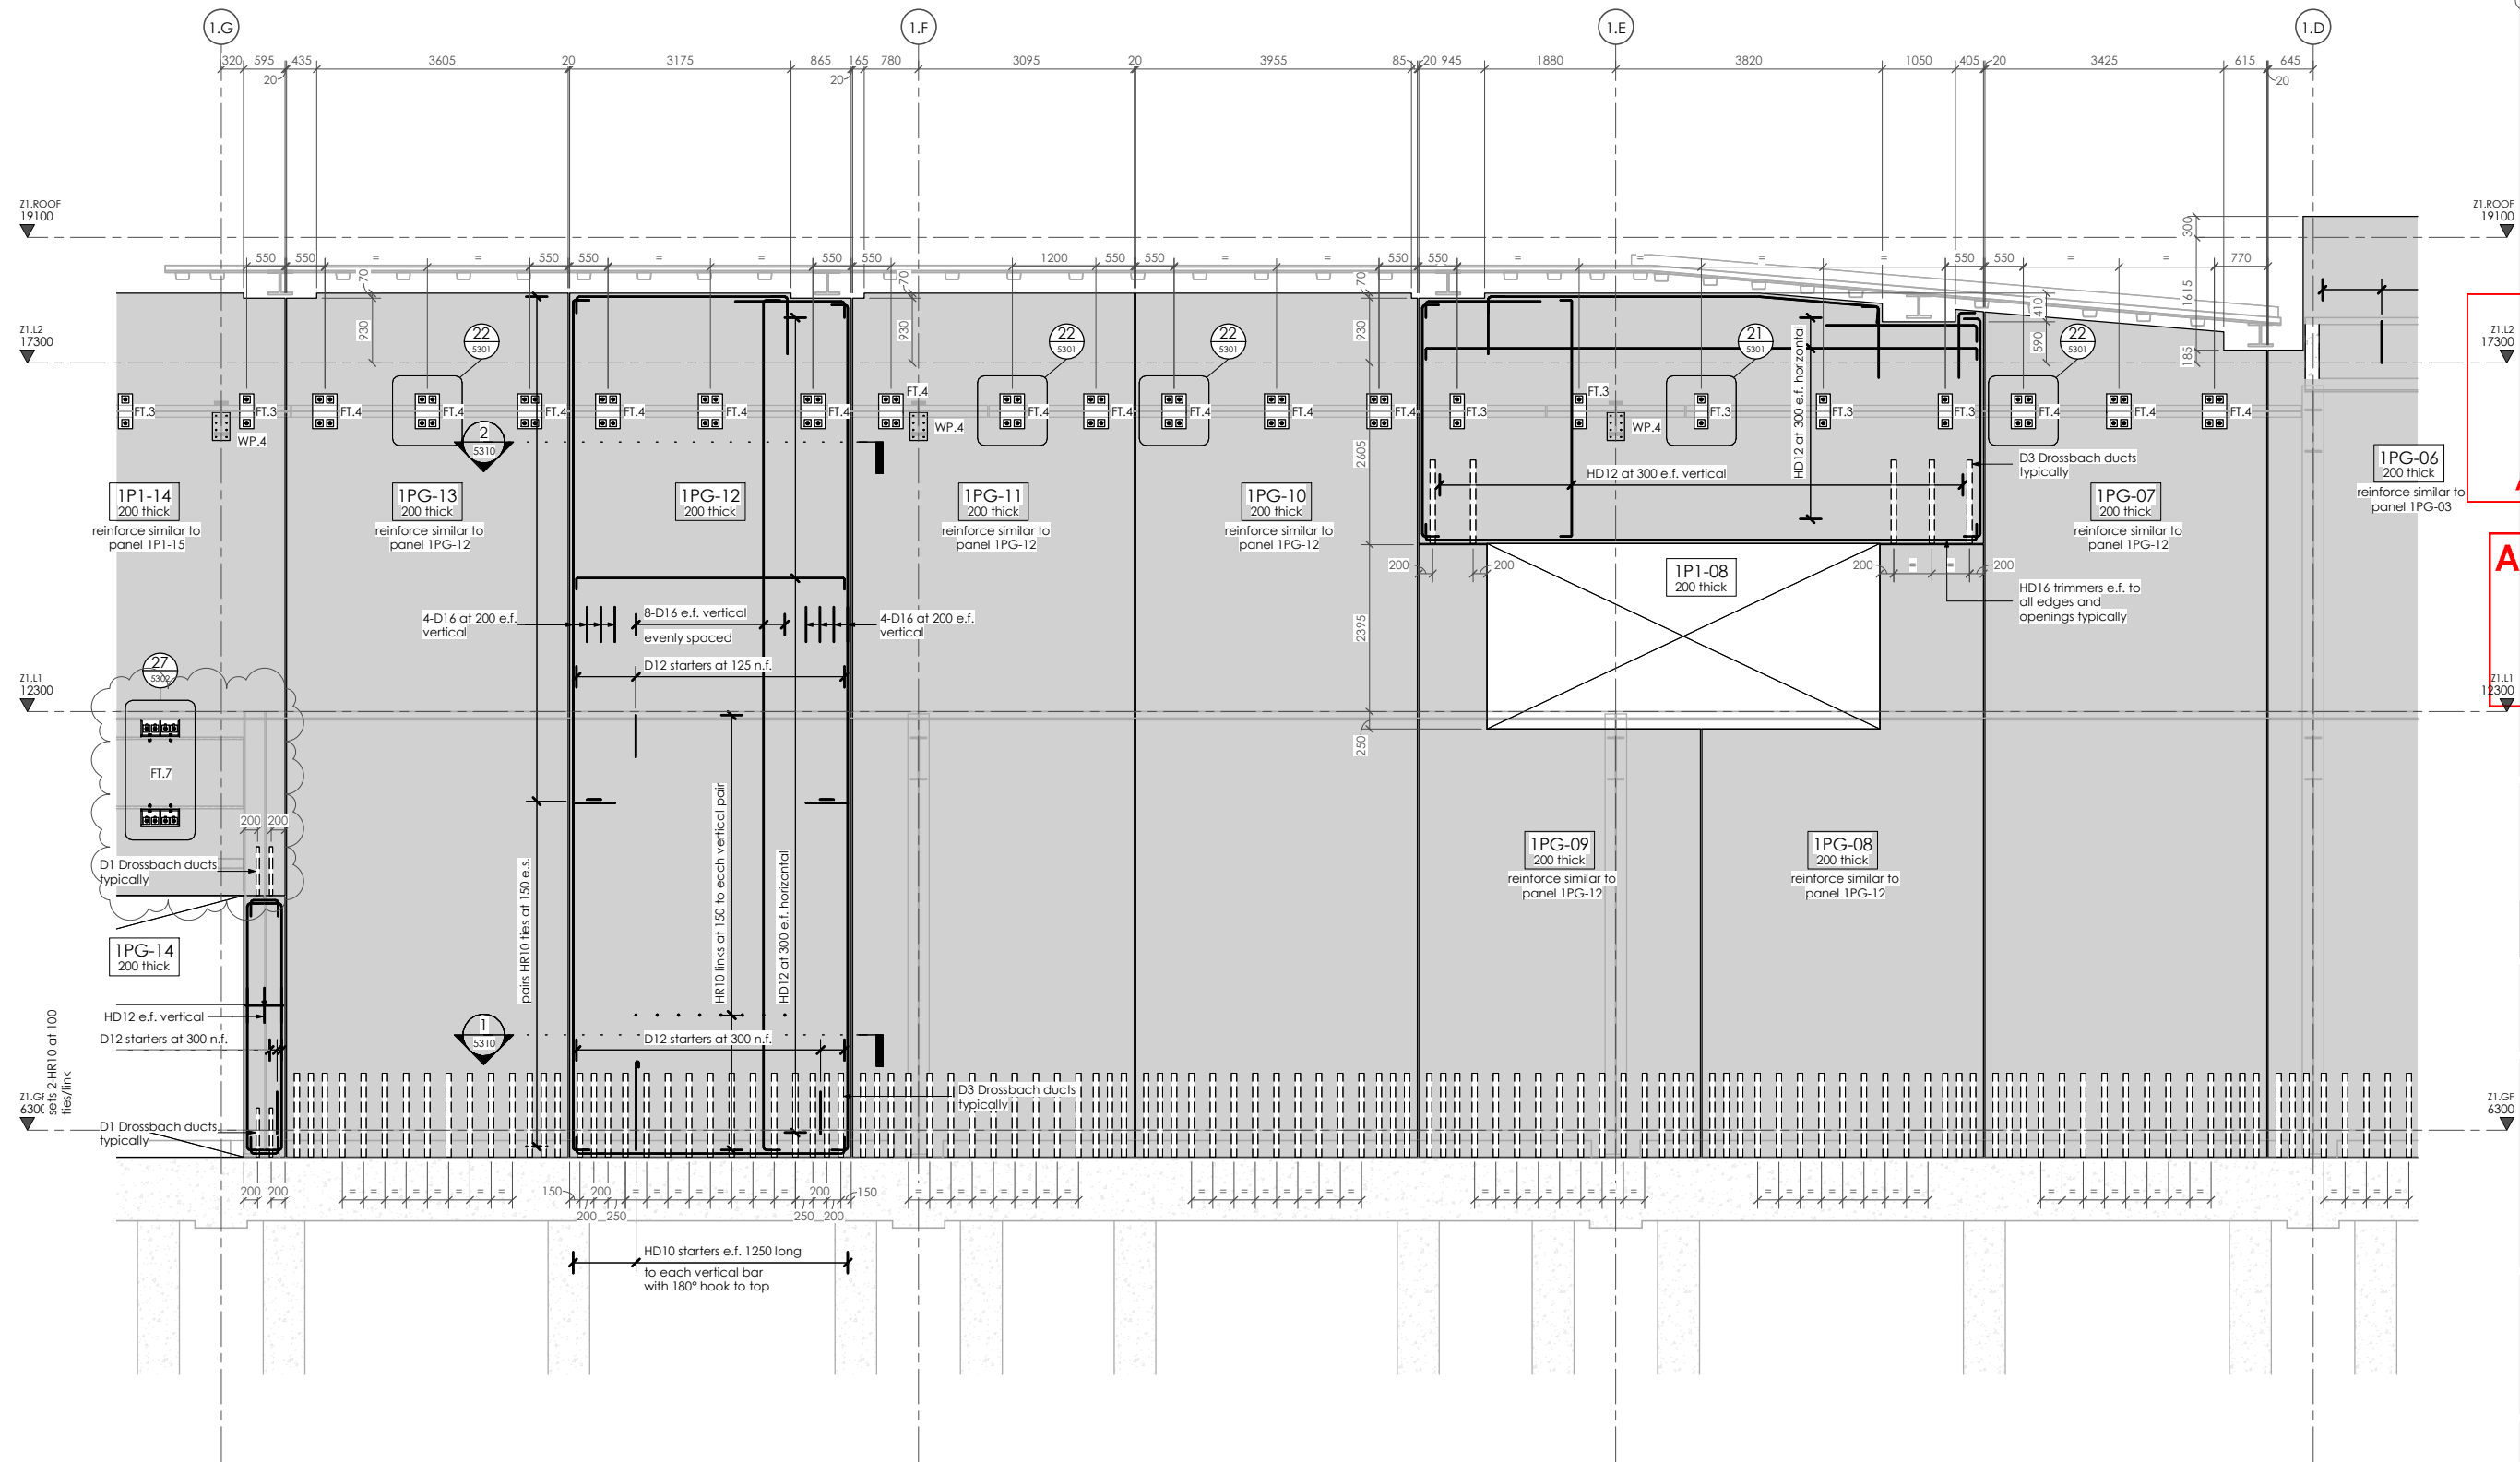


**Invercargill City Council
Building Consent Authority
Approved Site Copy**

**Approved For Issue
27/02/2020**

REV	DATE	AMENDMENT	BY
2	25.10.19	CONSENT ISSUE	GPW
1	27.09.19	PEER REVIEW ISSUE	GPW

CLIENT:
HWCP

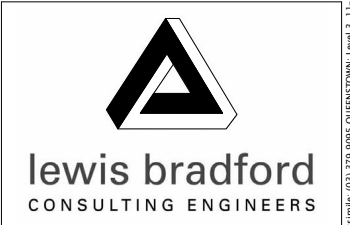

PROJECT:
**INVERCARGILL CENTRAL
ZONE 1 ANCHOR**

DRAWING TITLE:
**PRECAST PANEL
ELEVATIONS
GRIDLINE 1.1 - PART 2**

DRAWN: GPW	SCALE: 1 : 50 at A1
ENGINEER: EL/TSS	
CHECKED: -	
118083-Z1-WD-ST 2411	REV. 2

PANEL ELEVATIONS - Gridline 1.1 - Part 2

1 : 50 at A1
2
2401

17 Dec 2019


Building Division

BUILDING CONSENT NUMBER
2019/1381

THIS DRAWING AND ALL INFORMATION CONTAINED WITHIN IS THE PROPERTY OF LEWIS BRADFORD. ITS CONTENTS ARE CONFIDENTIAL AND MUST NOT BE REPRODUCED OR DISTRIBUTED TO ANY OTHER PERSON OR COMPANY UNLESS AGREED TO IN WRITING BY LEWIS BRADFORD

CONTRACTOR TO VERIFY ALL DIMENSIONS ON SITE REFER TO ARCHITECT'S DRAWING FOR ALL SETOUTS

NOTES :
Refer drawing 0002 for standard notes.
Refer also to Structural Specification.
Refer also 5300 & 5310 series drawings for precast panel details
Xypex additive to be added to all precast panels on Gridlines 1.1, 1.7 & 1.J and precast panels 1PG-30 & 1PG31 to southeastern re-entrant corner

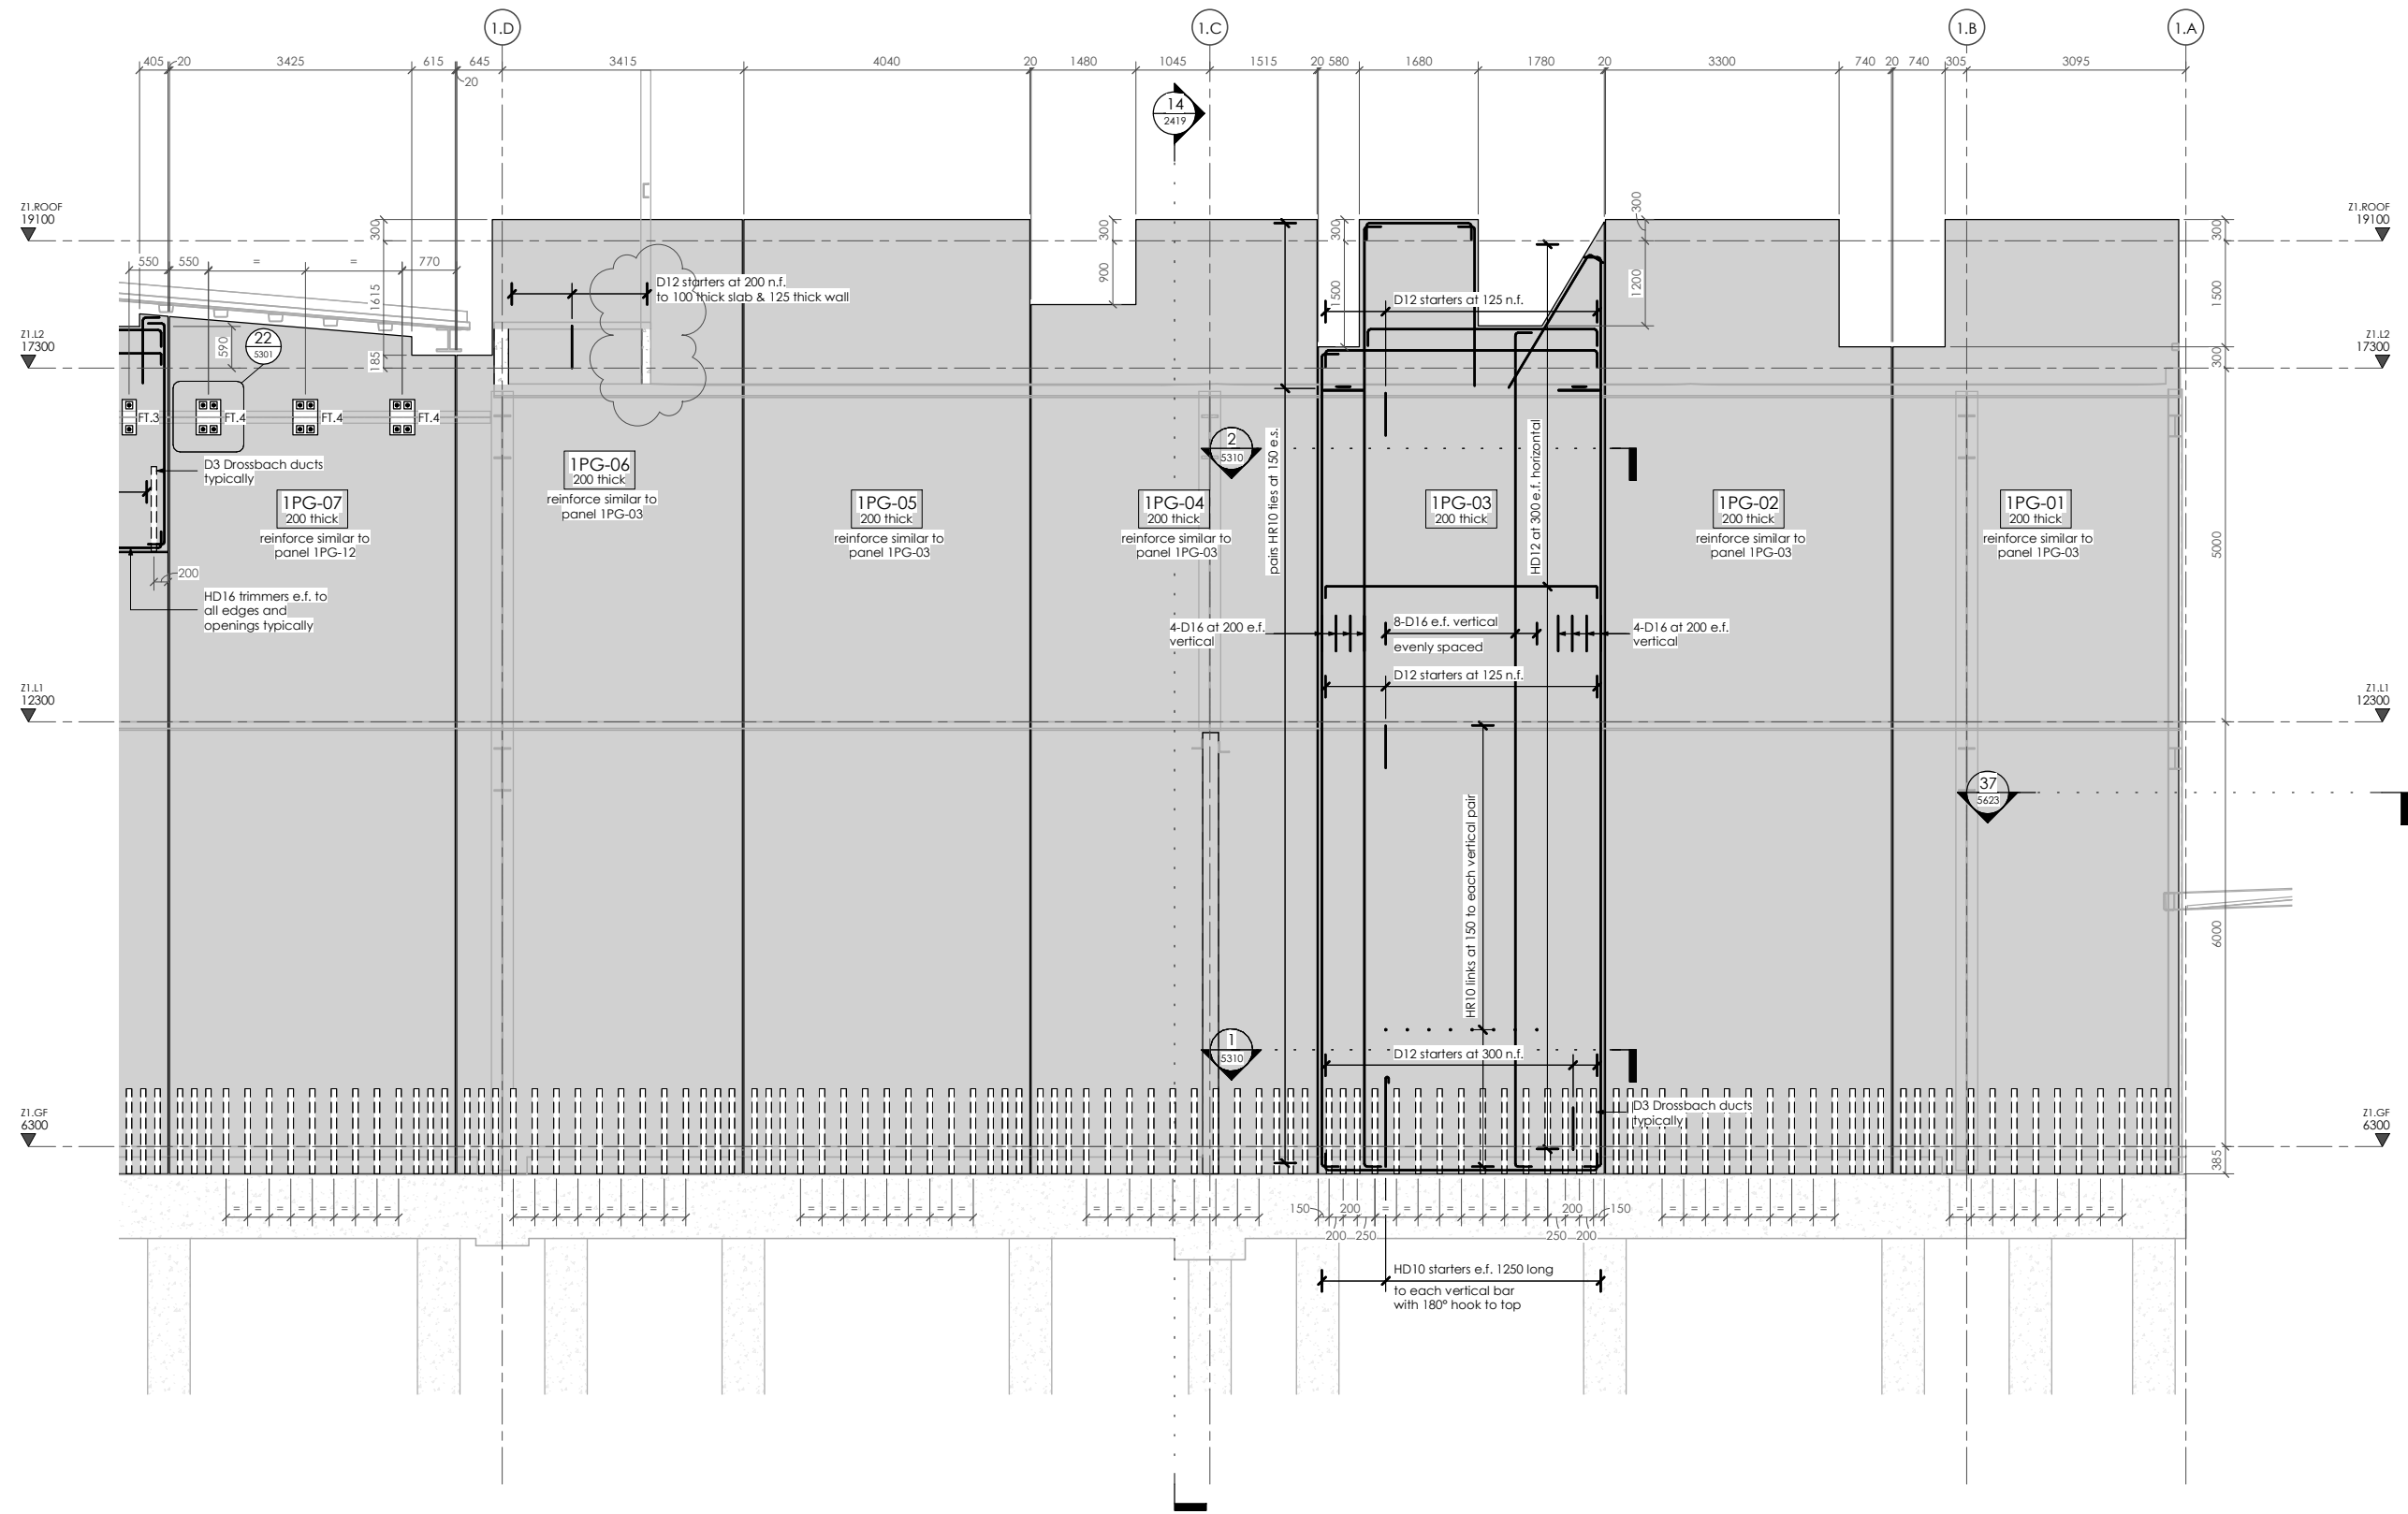


Invercargill City Council
Building Consent Authority
Approved Site Copy

Approved For Issue
27/02/2020

REV	DATE	AMENDMENT	BY
2	25.10.19	CONSENT ISSUE	GPW
1	27.09.19	PEER REVIEW ISSUE	GPW

CLIENT:
HWCP

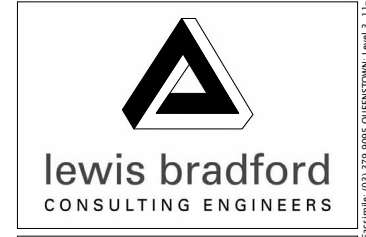

PROJECT:
INVERCARGILL CENTRAL ZONE 1 ANCHOR

DRAWING TITLE:
PRECAST PANEL ELEVATIONS GRIDLINE 1.1 - PART 3

DRAWN: GPW	SCALE: 1 : 50 at A1
ENGINEER: EL/TSS	
CHECKED: -	
118083-Z1-WD-ST 2412	REV. 2

PANEL ELEVATIONS - Gridline 1.1 - Part 3

1 : 50 at A1
3
2401

17 Dec 2019


Building Division

BUILDING CONSENT NUMBER
2019/1381

THIS DRAWING AND ALL INFORMATION CONTAINED WITHIN IS THE PROPERTY OF LEWIS BRADFORD. ITS CONTENTS ARE CONFIDENTIAL AND MUST NOT BE REPRODUCED OR DISTRIBUTED TO ANY OTHER PERSON OR COMPANY UNLESS AGREED TO IN WRITING BY LEWIS BRADFORD

CONTRACTOR TO VERIFY ALL DIMENSIONS ON SITE REFER TO ARCHITECT'S DRAWING FOR ALL SETOUTS

NOTES :
Refer drawing 0002 for standard notes. Refer also to Structural Specification.
Refer also 5300 & 5310 series drawings for precast panel details
Xypex additive to be added to all precast panels on Gridlines 1.1, 1.7 & 1.J and precast panels 1PG-30 & 1PG31 to southeastern re-entrant corner

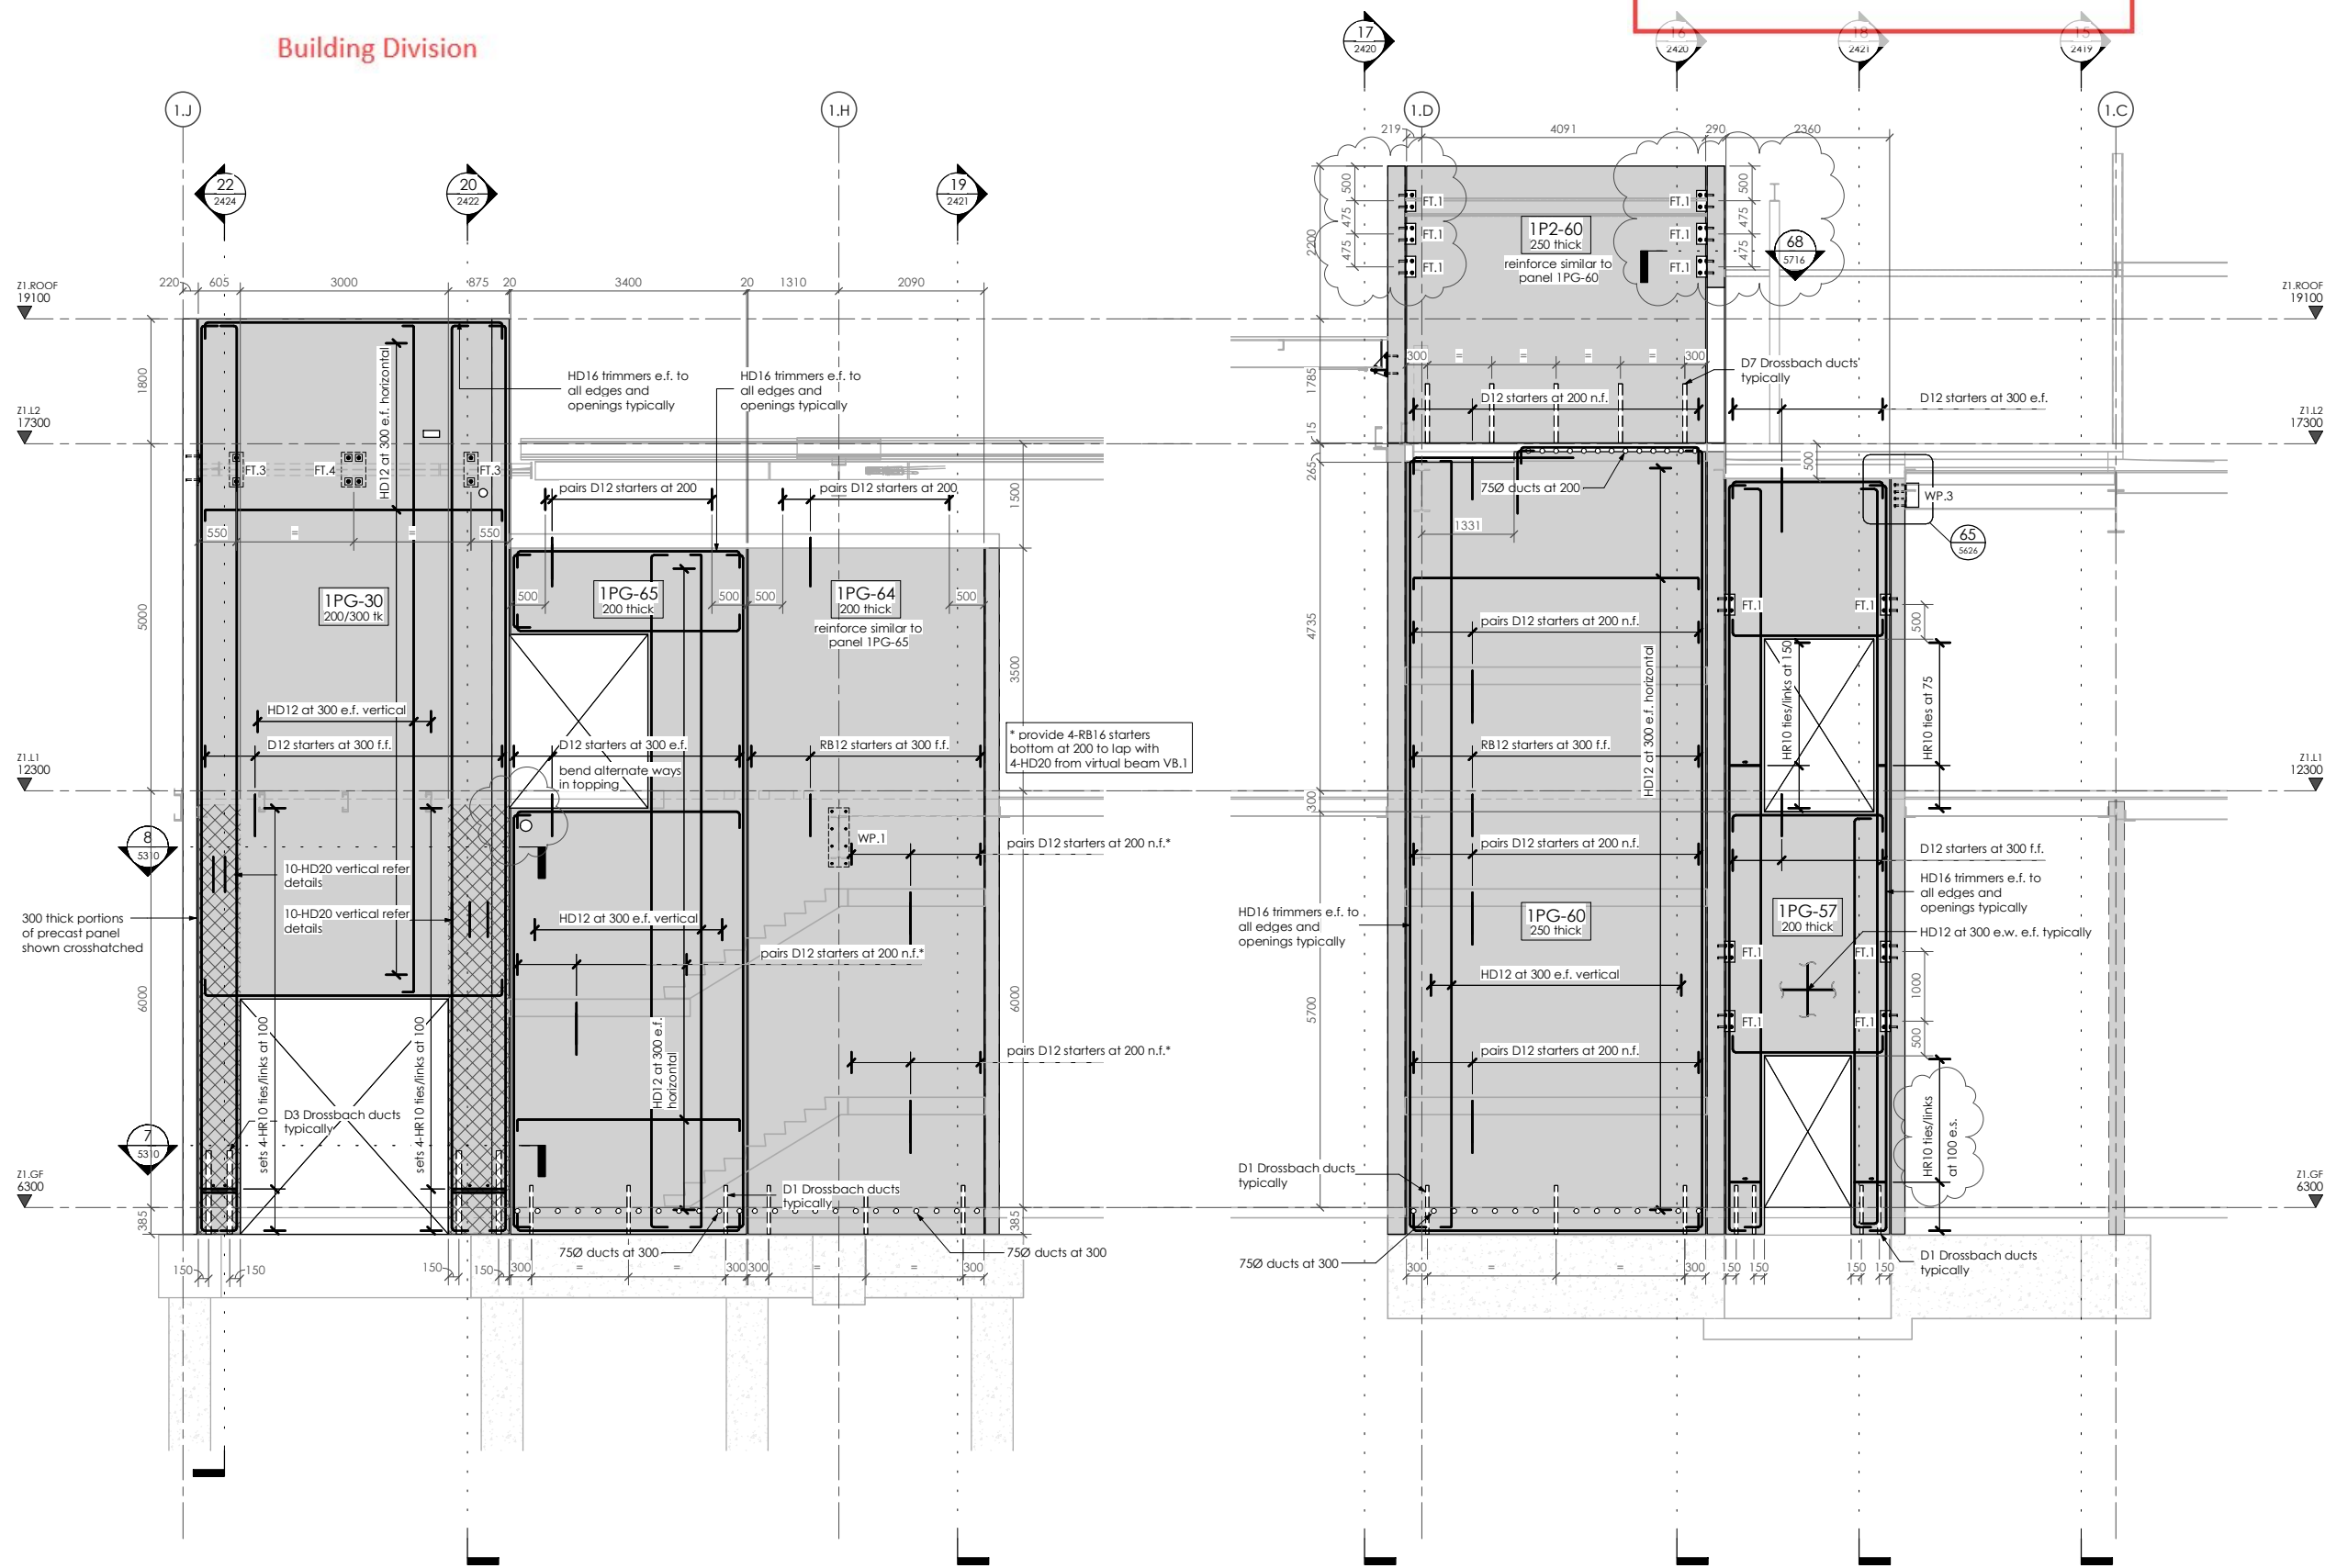

PANEL ELEVATIONS - Near Gridline 1.6

1 : 50 at A1
6
2421

PANEL ELEVATIONS - Gridline 1.6


1 : 50 at A1
7
2421

Invercargill City Council
Building Consent Authority
Approved Site Copy

Approved For Issue
27/02/2020

REV	DATE	AMENDMENT	BY
2	25.10.19	CONSENT ISSUE	GPW
1	27.09.19	PEER REVIEW ISSUE	GPW

CLIENT:
HWCP

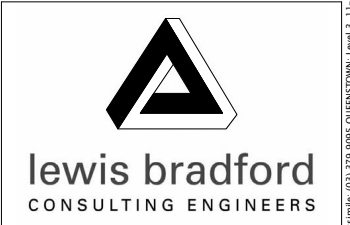

PROJECT:
INVERCARGILL CENTRAL ZONE 1 ANCHOR

DRAWING TITLE:
PRECAST PANEL ELEVATIONS NEAR GRIDLINE 1.6

DRAWN: GPW	SCALE: 1 : 50 at A1
ENGINEER: EL/TSS	
CHECKED: -	
118083-Z1-WD-ST 2414	REV. 2

17 Dec 2019


Building Division

BUILDING CONSENT NUMBER
2019/1381

THIS DRAWING AND ALL INFORMATION CONTAINED WITHIN IS THE PROPERTY OF LEWIS BRADFORD. ITS CONTENTS ARE CONFIDENTIAL AND MUST NOT BE REPRODUCED OR DISTRIBUTED TO ANY OTHER PERSON OR COMPANY UNLESS AGREED TO IN WRITING BY LEWIS BRADFORD


CONTRACTOR TO VERIFY ALL DIMENSIONS ON SITE REFER TO ARCHITECT'S DRAWING FOR ALL SETOUTS

NOTES:
Refer drawing 0002 for standard notes. Refer also to Structural Specification.
Refer also 5300 & 5310 series drawings for precast panel details
Xypex additive to be added to all precast panels on Gridlines 1.1, 1.7 & 1.J and precast panels 1PG-30 & 1PG31 to southeastern re-entrant corner

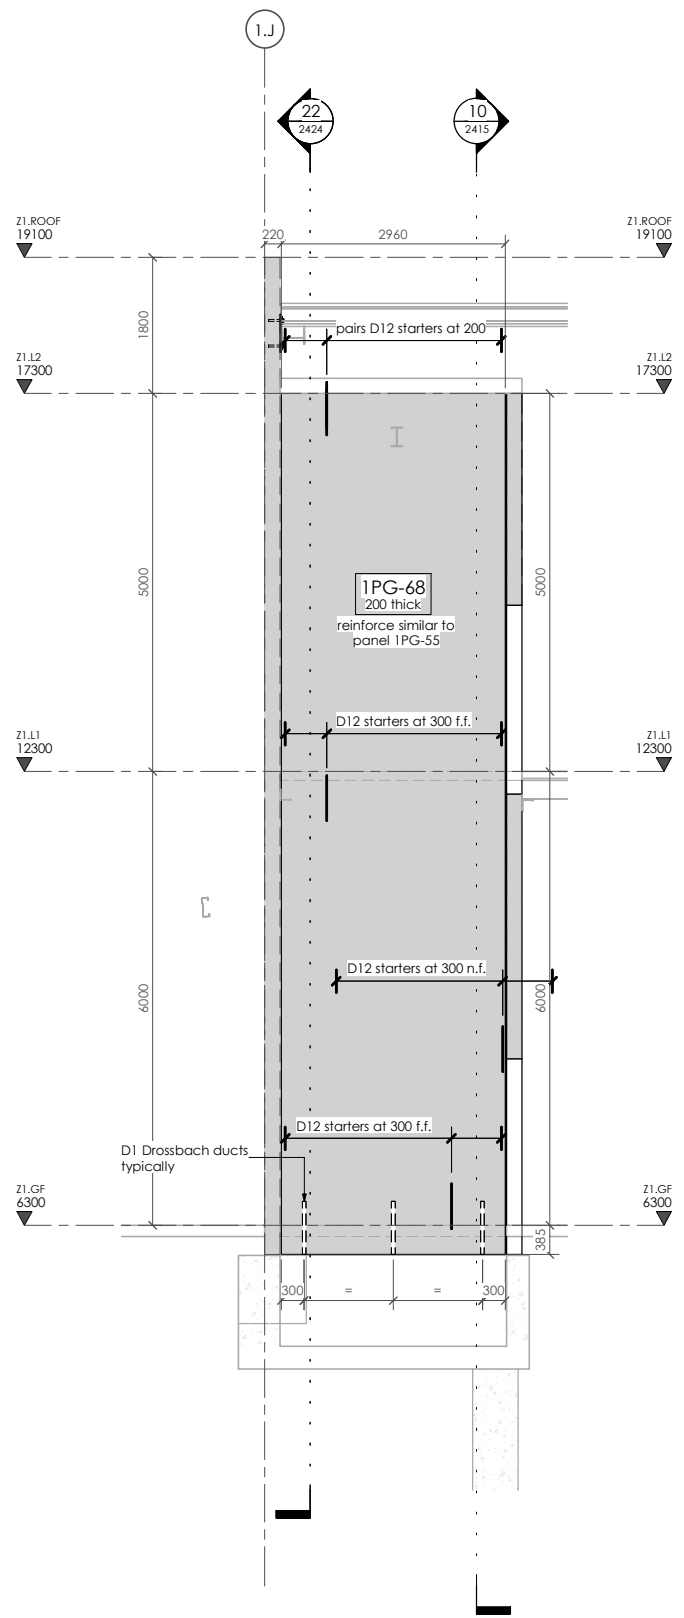


PANEL ELEVATIONS - Near Gridline 1.4

1 : 50 at A1
8
2424

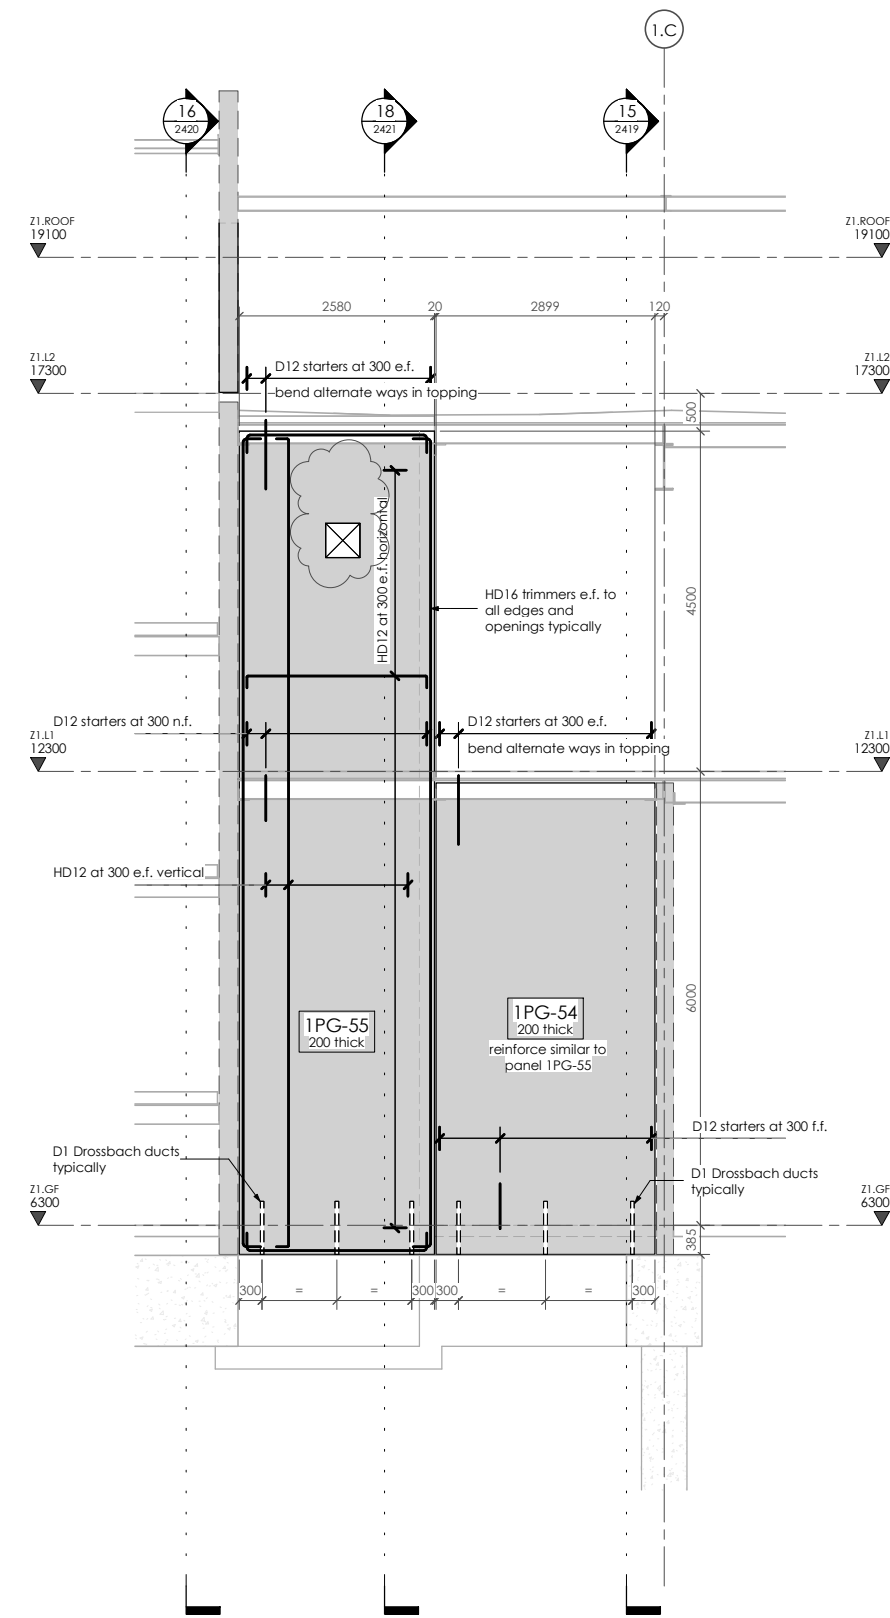

PANEL ELEVATIONS - Near Gridline 1.7

1 : 50 at A1
9
2421

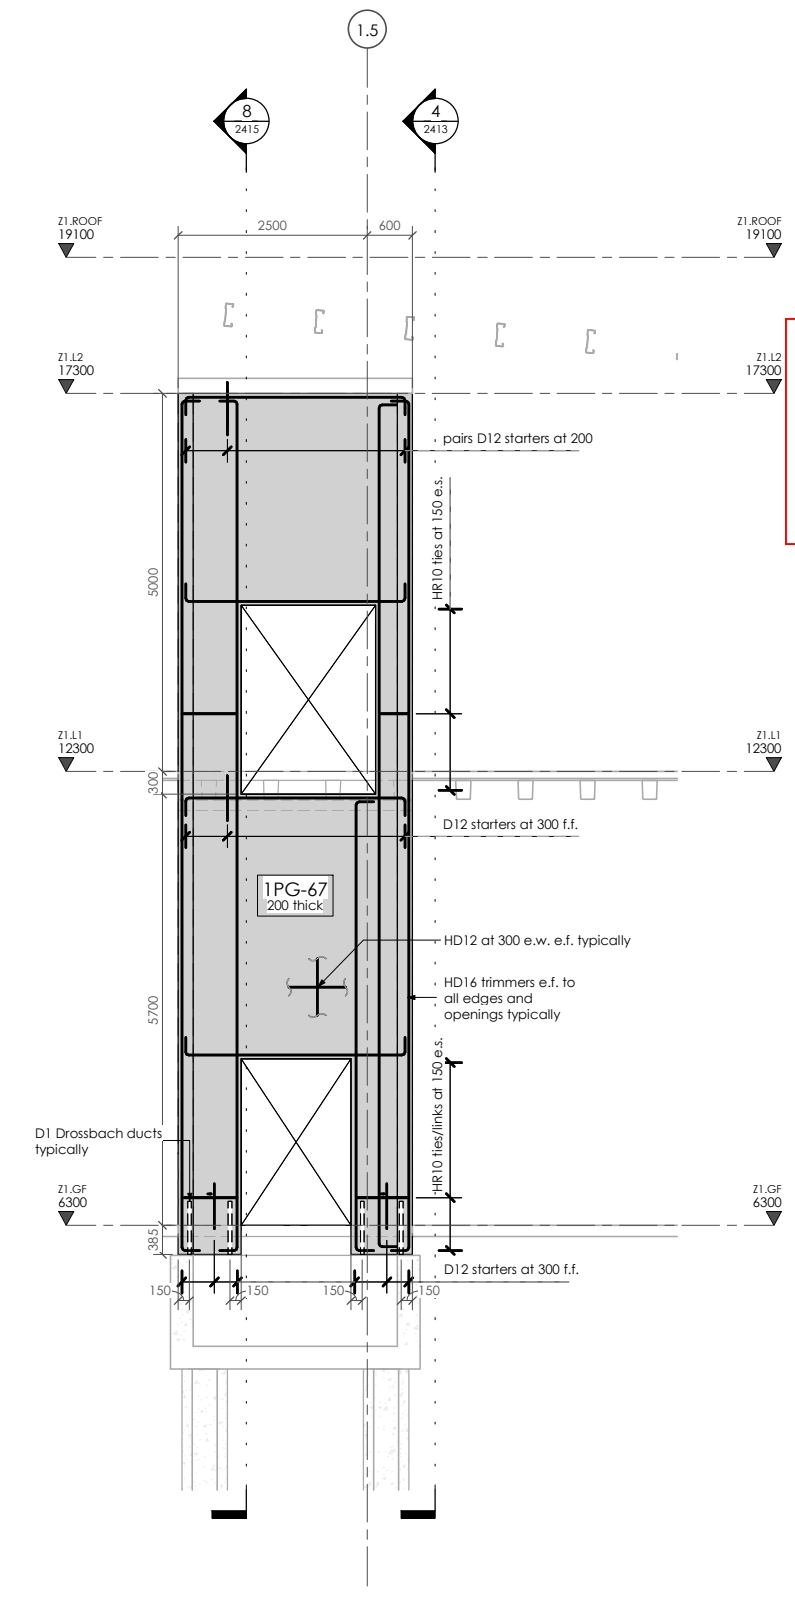

PANEL ELEVATIONS - Near Gridline 1.J


1 : 50 at A1
10
2415

Invercargill City
Council
Building Consent
Authority
Approved Site Copy

Approved For Issue
27/02/2020

REV	DATE	AMENDMENT	BY
2	25.10.19	CONSENT ISSUE	GPW
1	27.09.19	PEER REVIEW ISSUE	GPW

CLIENT:
HWCP

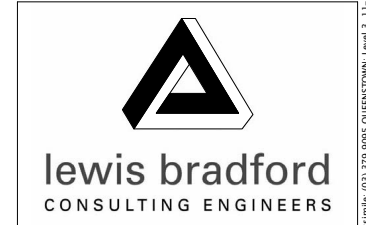

PROJECT:
**INVERCARGILL CENTRAL
ZONE 1 ANCHOR**

DRAWING TITLE:
**PRECAST PANEL
ELEVATIONS
NEAR GRIDLINE 1.4, 1.7
and 1.J**

DRAWN: GPW	SCALE: 1 : 50 at A1
ENGINEER: EL/TSS	
CHECKED: -	
118083-Z1-WD-ST 2415	REV. 2

17 Dec 2019


Building Division

BUILDING CONSENT NUMBER
2019/1381

THIS DRAWING AND ALL INFORMATION CONTAINED WITHIN IS THE PROPERTY OF LEWIS BRADFORD. ITS CONTENTS ARE CONFIDENTIAL AND MUST NOT BE REPRODUCED OR DISTRIBUTED TO ANY OTHER PERSON OR COMPANY UNLESS AGREED TO IN WRITING BY LEWIS BRADFORD

CONTRACTOR TO VERIFY ALL DIMENSIONS ON SITE REFER TO ARCHITECT'S DRAWING FOR ALL SETOUTS

NOTES:
Refer drawing 0002 for standard notes. Refer also to Structural Specification.
Refer also 5300 & 5310 series drawings for precast panel details
Xypex additive to be added to all precast panels on Gridlines 1.1, 1.7 & 1.J and precast panels 1PG-30 & 1PG31 to southeastern re-entrant corner

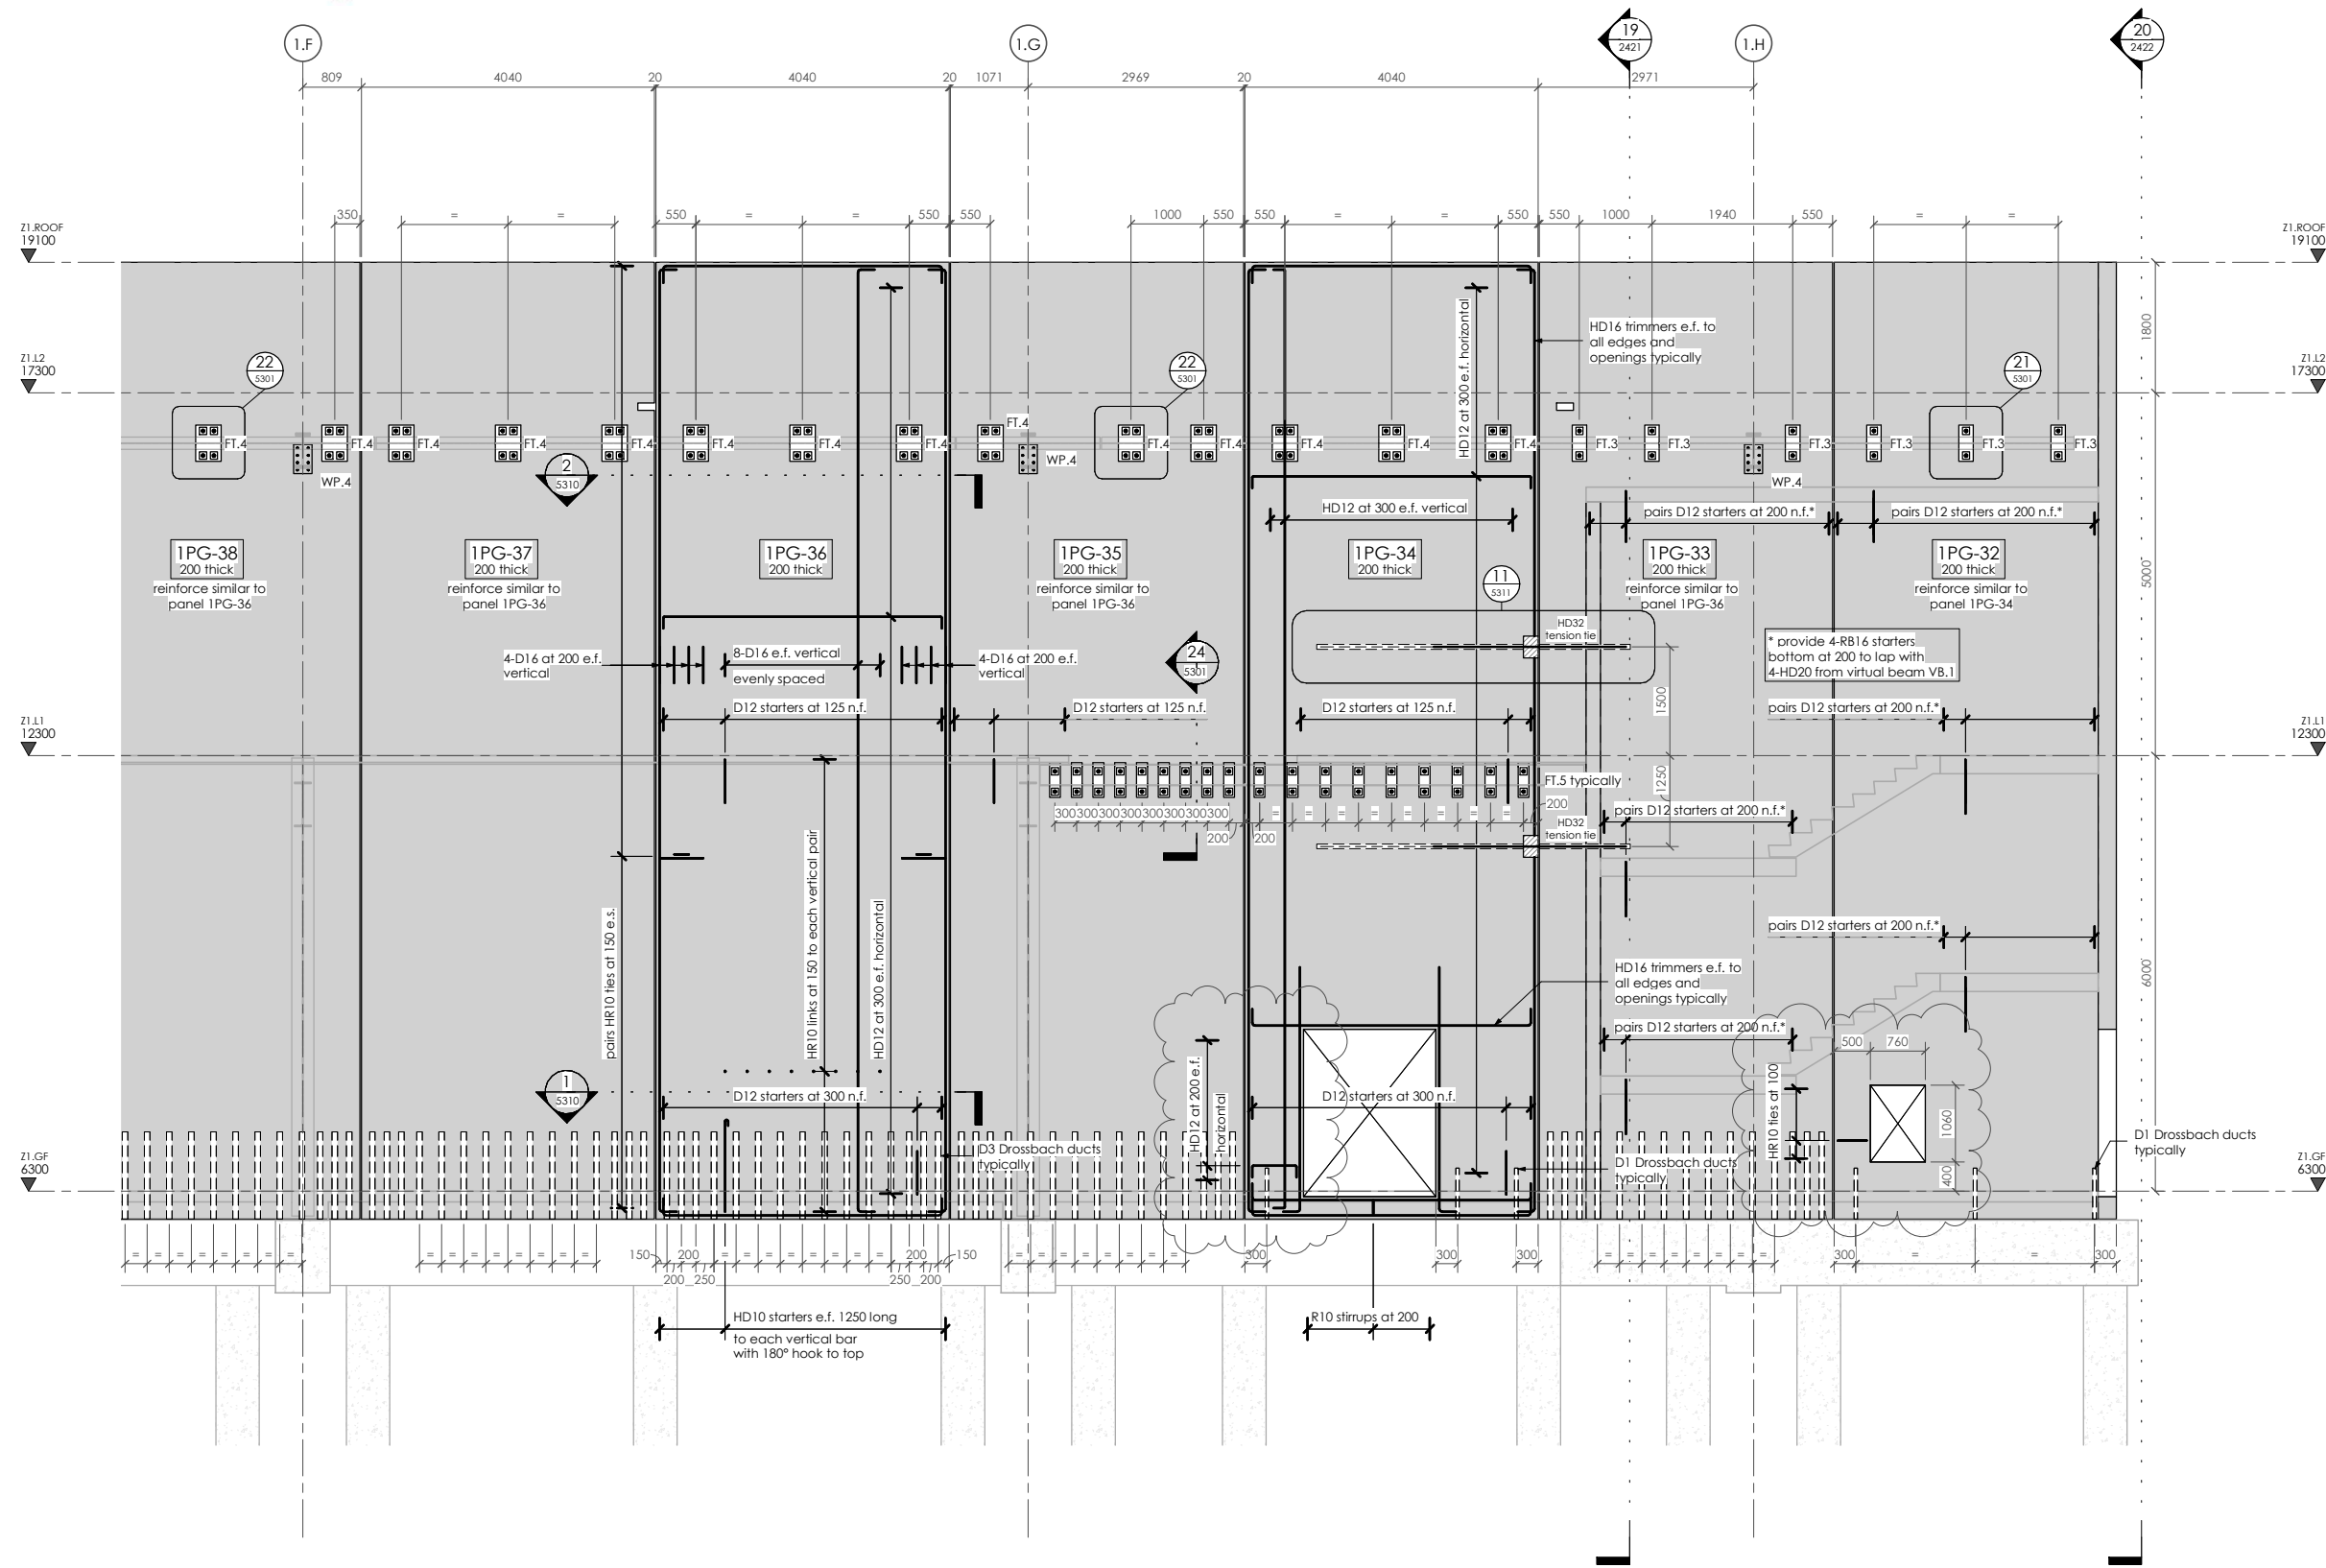

PANEL ELEVATIONS - Gridline 1.7 - Part 1


1 : 50 at A1
11
2401

Invercargill City
Council
Building Consent
Authority
Approved Site Copy

Approved For Issue
27/02/2020

REV	DATE	AMENDMENT	BY
2	25.10.19	CONSENT ISSUE	GPW
1	27.09.19	PEER REVIEW ISSUE	GPW

CLIENT:
HWCP

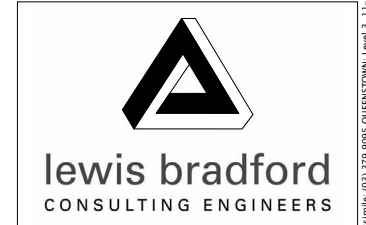

PROJECT:
**INVERCARGILL CENTRAL
ZONE 1 ANCHOR**

DRAWING TITLE:
**PRECAST PANEL
ELEVATIONS
GRIDLINE 1.7 - PART 1**

DRAWN: GPW	SCALE: 1 : 50 at A1
ENGINEER: EL/TSS	
CHECKED: -	
118083-Z1-WD-ST 2416	REV. 2

17 Dec 2019

Building Division

BUILDING CONSENT NUMBER
2019/1381

THIS DRAWING AND ALL INFORMATION CONTAINED WITHIN IS THE PROPERTY OF LEWIS BRADFORD. ITS CONTENTS ARE CONFIDENTIAL AND MUST NOT BE REPRODUCED OR DISTRIBUTED TO ANY OTHER PERSON OR COMPANY UNLESS AGREED TO IN WRITING BY LEWIS BRADFORD


CONTRACTOR TO VERIFY ALL DIMENSIONS ON SITE REFER TO ARCHITECT'S DRAWING FOR ALL SETOUTS

NOTES :

Refer drawing 0002 for standard notes. Refer also to Structural Specification.

Refer also 5300 & 5310 series drawings for precast panel details

Xypex additive to be added to all precast panels on Gridlines 1.1, 1.7 & 1.J and precast panels 1PG-30 & 1PG31 to southeastern re-entrant corner

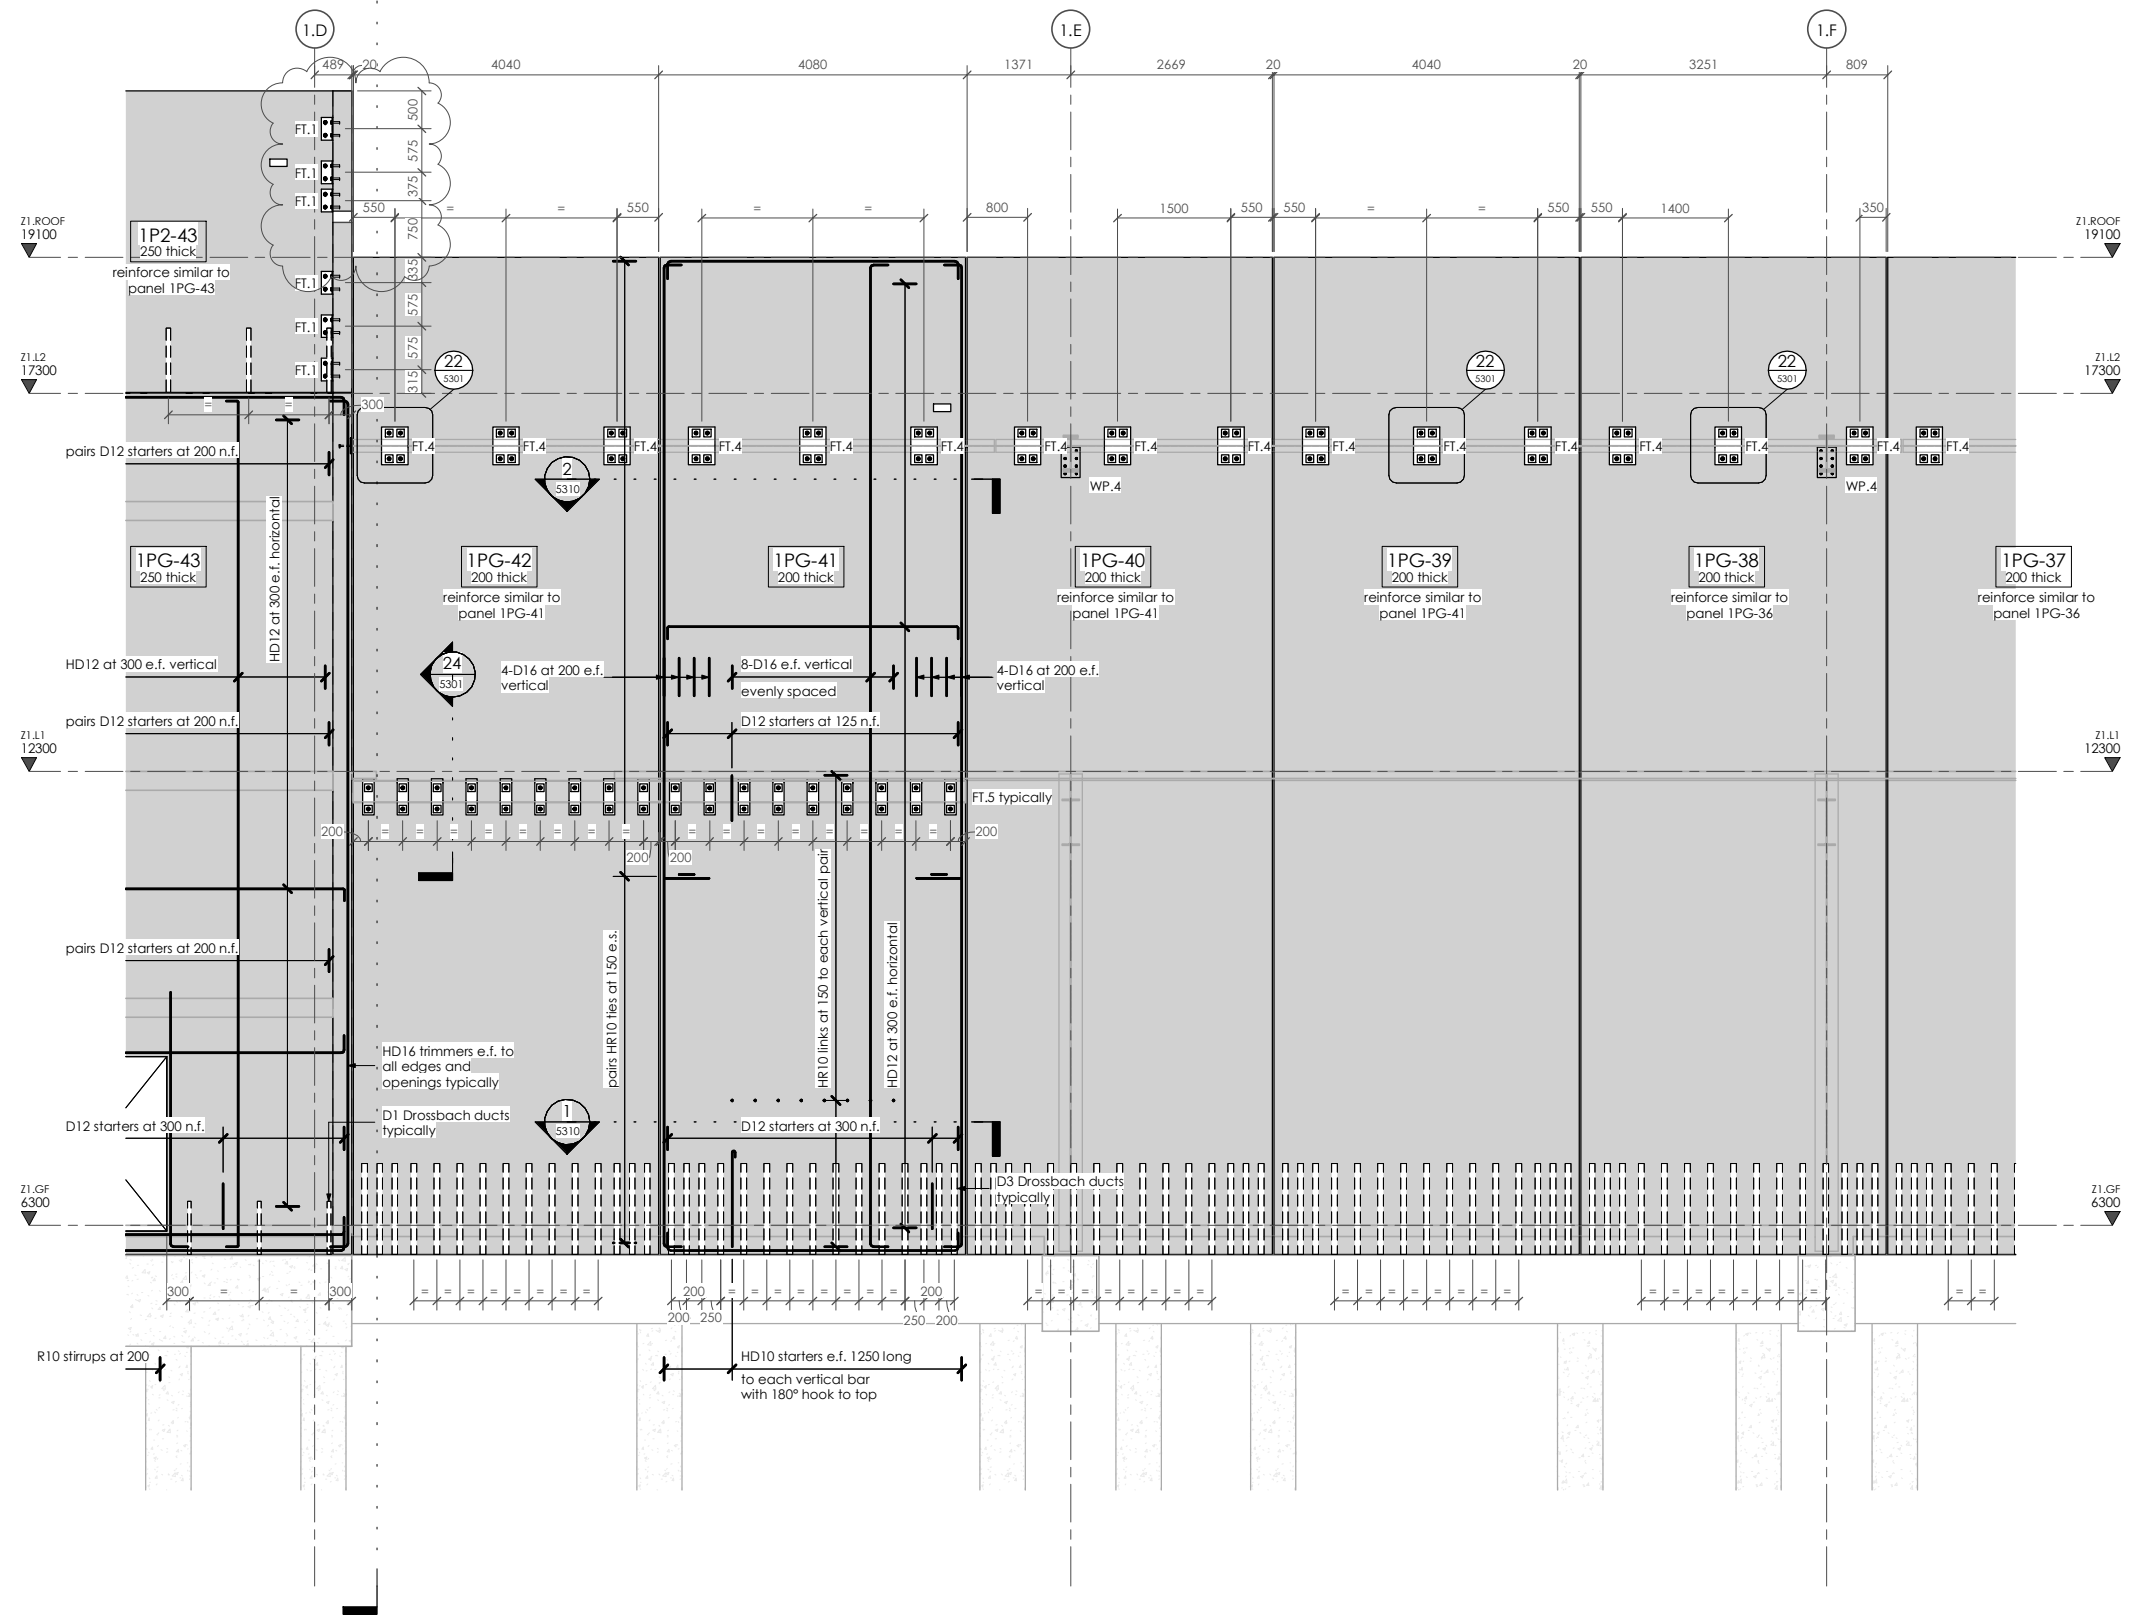

Invercargill City
Council
Building Consent
Authority
Approved Site Copy

Approved For Issue
27/02/2020

REV	DATE	AMENDMENT	BY
2	25.10.19	CONSENT ISSUE	GPW
1	27.09.19	PEER REVIEW ISSUE	GPW

CLIENT:
HWCP

lewis bradford
CONSULTING ENGINEERS

PROJECT:
**INVERCARGILL CENTRAL
ZONE 1 ANCHOR**

DRAWING TITLE:
**PRECAST PANEL
ELEVATIONS
GRIDLINE 1.7 - PART 2**

DRAWN: GPW	SCALE: 1 : 50 at A1
ENGINEER: EL/TSS	
CHECKED: -	
118083-Z1-WD-ST 2417	REV. 2

PANEL ELEVATIONS - Gridline 1.7 - Part 2

1 : 50 at A1
12
2401

17 Dec 2019


Building Division

BUILDING CONSENT NUMBER
2019/1381

THIS DRAWING AND ALL INFORMATION CONTAINED WITHIN IS THE PROPERTY OF LEWIS BRADFORD. ITS CONTENTS ARE CONFIDENTIAL AND MUST NOT BE REPRODUCED OR DISTRIBUTED TO ANY OTHER PERSON OR COMPANY UNLESS AGREED TO IN WRITING BY LEWIS BRADFORD

CONTRACTOR TO VERIFY ALL DIMENSIONS ON SITE REFER TO ARCHITECT'S DRAWING FOR ALL SETOUTS

NOTES:
Refer drawing 0002 for standard notes. Refer also to Structural Specification.
Refer also 5300 & 5310 series drawings for precast panel details
Xypex additive to be added to all precast panels on Gridlines 1.1, 1.7 & 1.J and precast panels 1PG-30 & 1PG31 to southeastern re-entrant corner

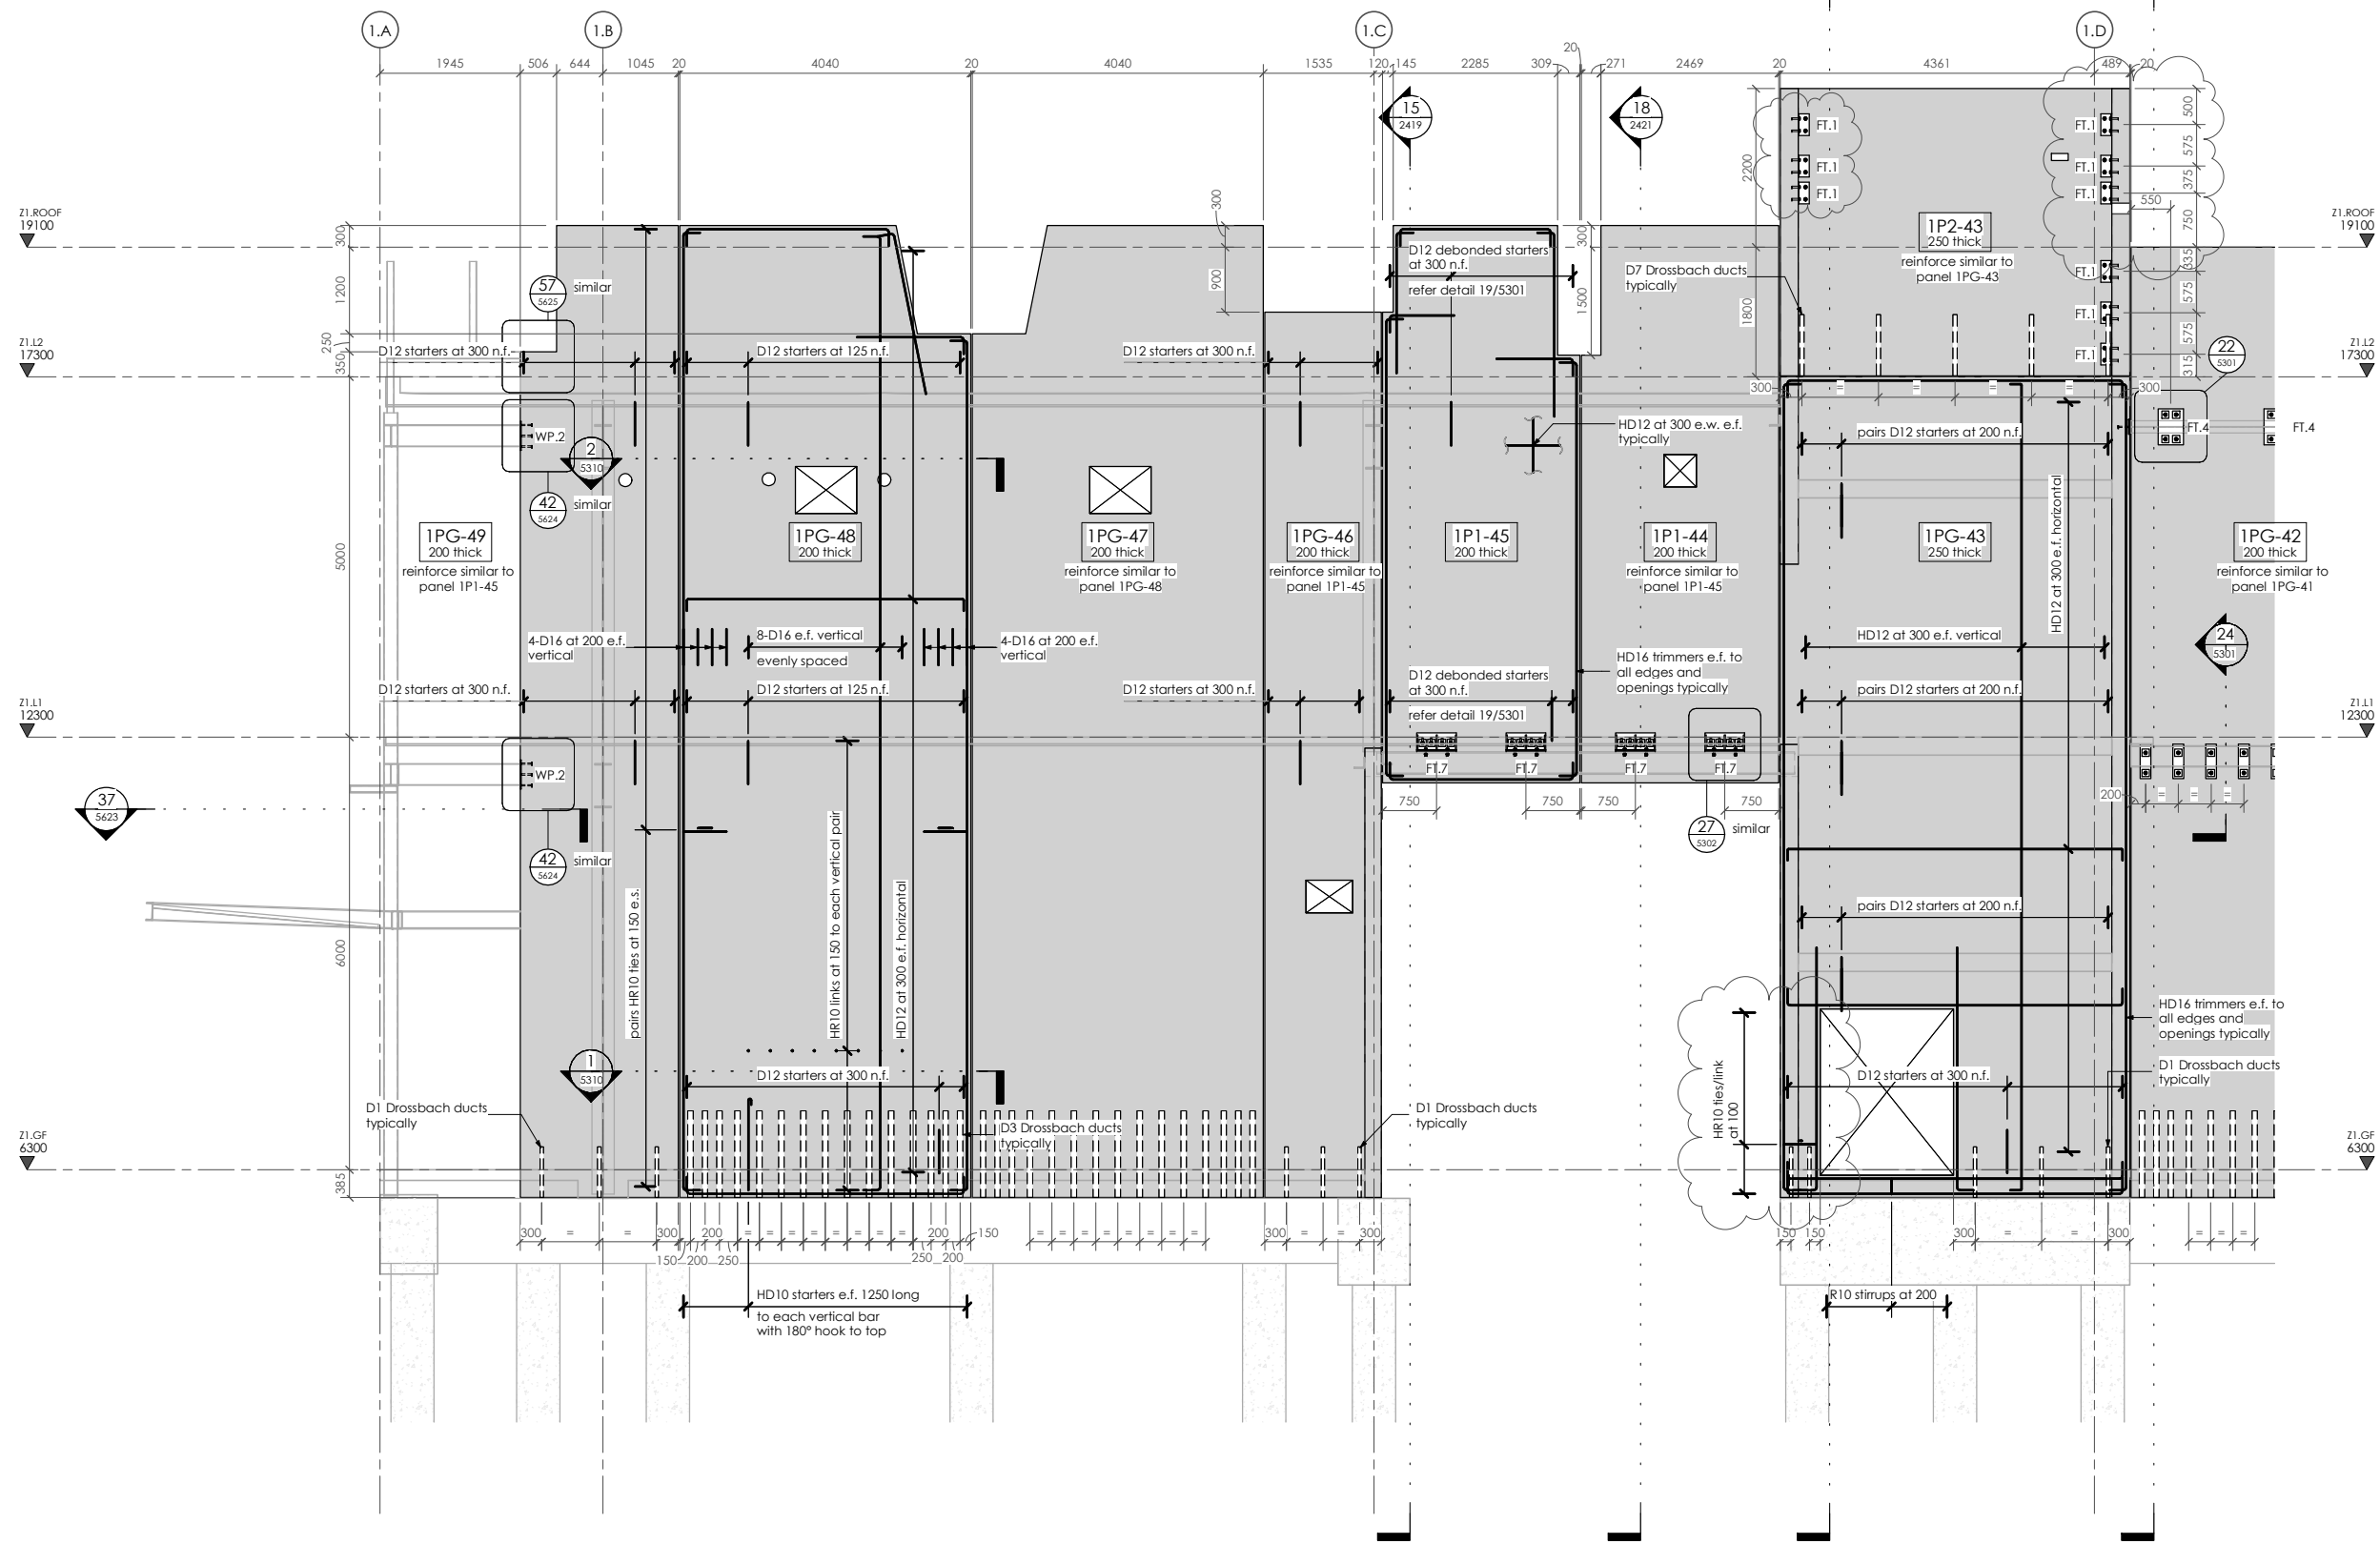


Invercargill City Council
Building Consent Authority
Approved Site Copy

Approved For Issue
27/02/2020

REV	DATE	AMENDMENT	BY
2	25.10.19	CONSENT ISSUE	GPW
1	27.09.19	PEER REVIEW ISSUE	GPW

CLIENT:
HWCP

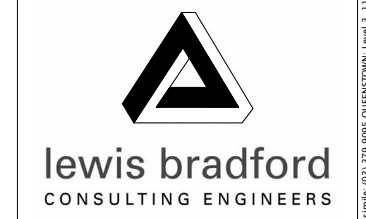

PROJECT:
INVERCARGILL CENTRAL ZONE 1 ANCHOR

DRAWING TITLE:
PRECAST PANEL ELEVATIONS GRIDLINE 1.7 - PART 3

DRAWN: GPW	SCALE: 1 : 50 at A1
ENGINEER: EL/TSS	
CHECKED: -	
118083-Z1-WD-ST 2418	REV. 2

PANEL ELEVATIONS - Gridline 1.7 - Part 3

1 : 50 at A1
13/2401

17 Dec 2019

Building Division

BUILDING CONSENT NUMBER
2019/1381

THIS DRAWING AND ALL INFORMATION CONTAINED WITHIN IS THE PROPERTY OF LEWIS BRADFORD. ITS CONTENTS ARE CONFIDENTIAL AND MUST NOT BE REPRODUCED OR DISTRIBUTED TO ANY OTHER PERSON OR COMPANY UNLESS AGREED TO IN WRITING BY LEWIS BRADFORD


CONTRACTOR TO VERIFY ALL DIMENSIONS ON SITE REFER TO ARCHITECT'S DRAWING FOR ALL SETOUTS

NOTES :

Refer drawing 0002 for standard notes. Refer also to Structural Specification.

Refer also 5300 & 5310 series drawings for precast panel details

Xypex additive to be added to all precast panels on Gridlines 1.1, 1.7 & 1.J and precast panels 1PG-30 & 1PG31 to southeastern re-entrant corner

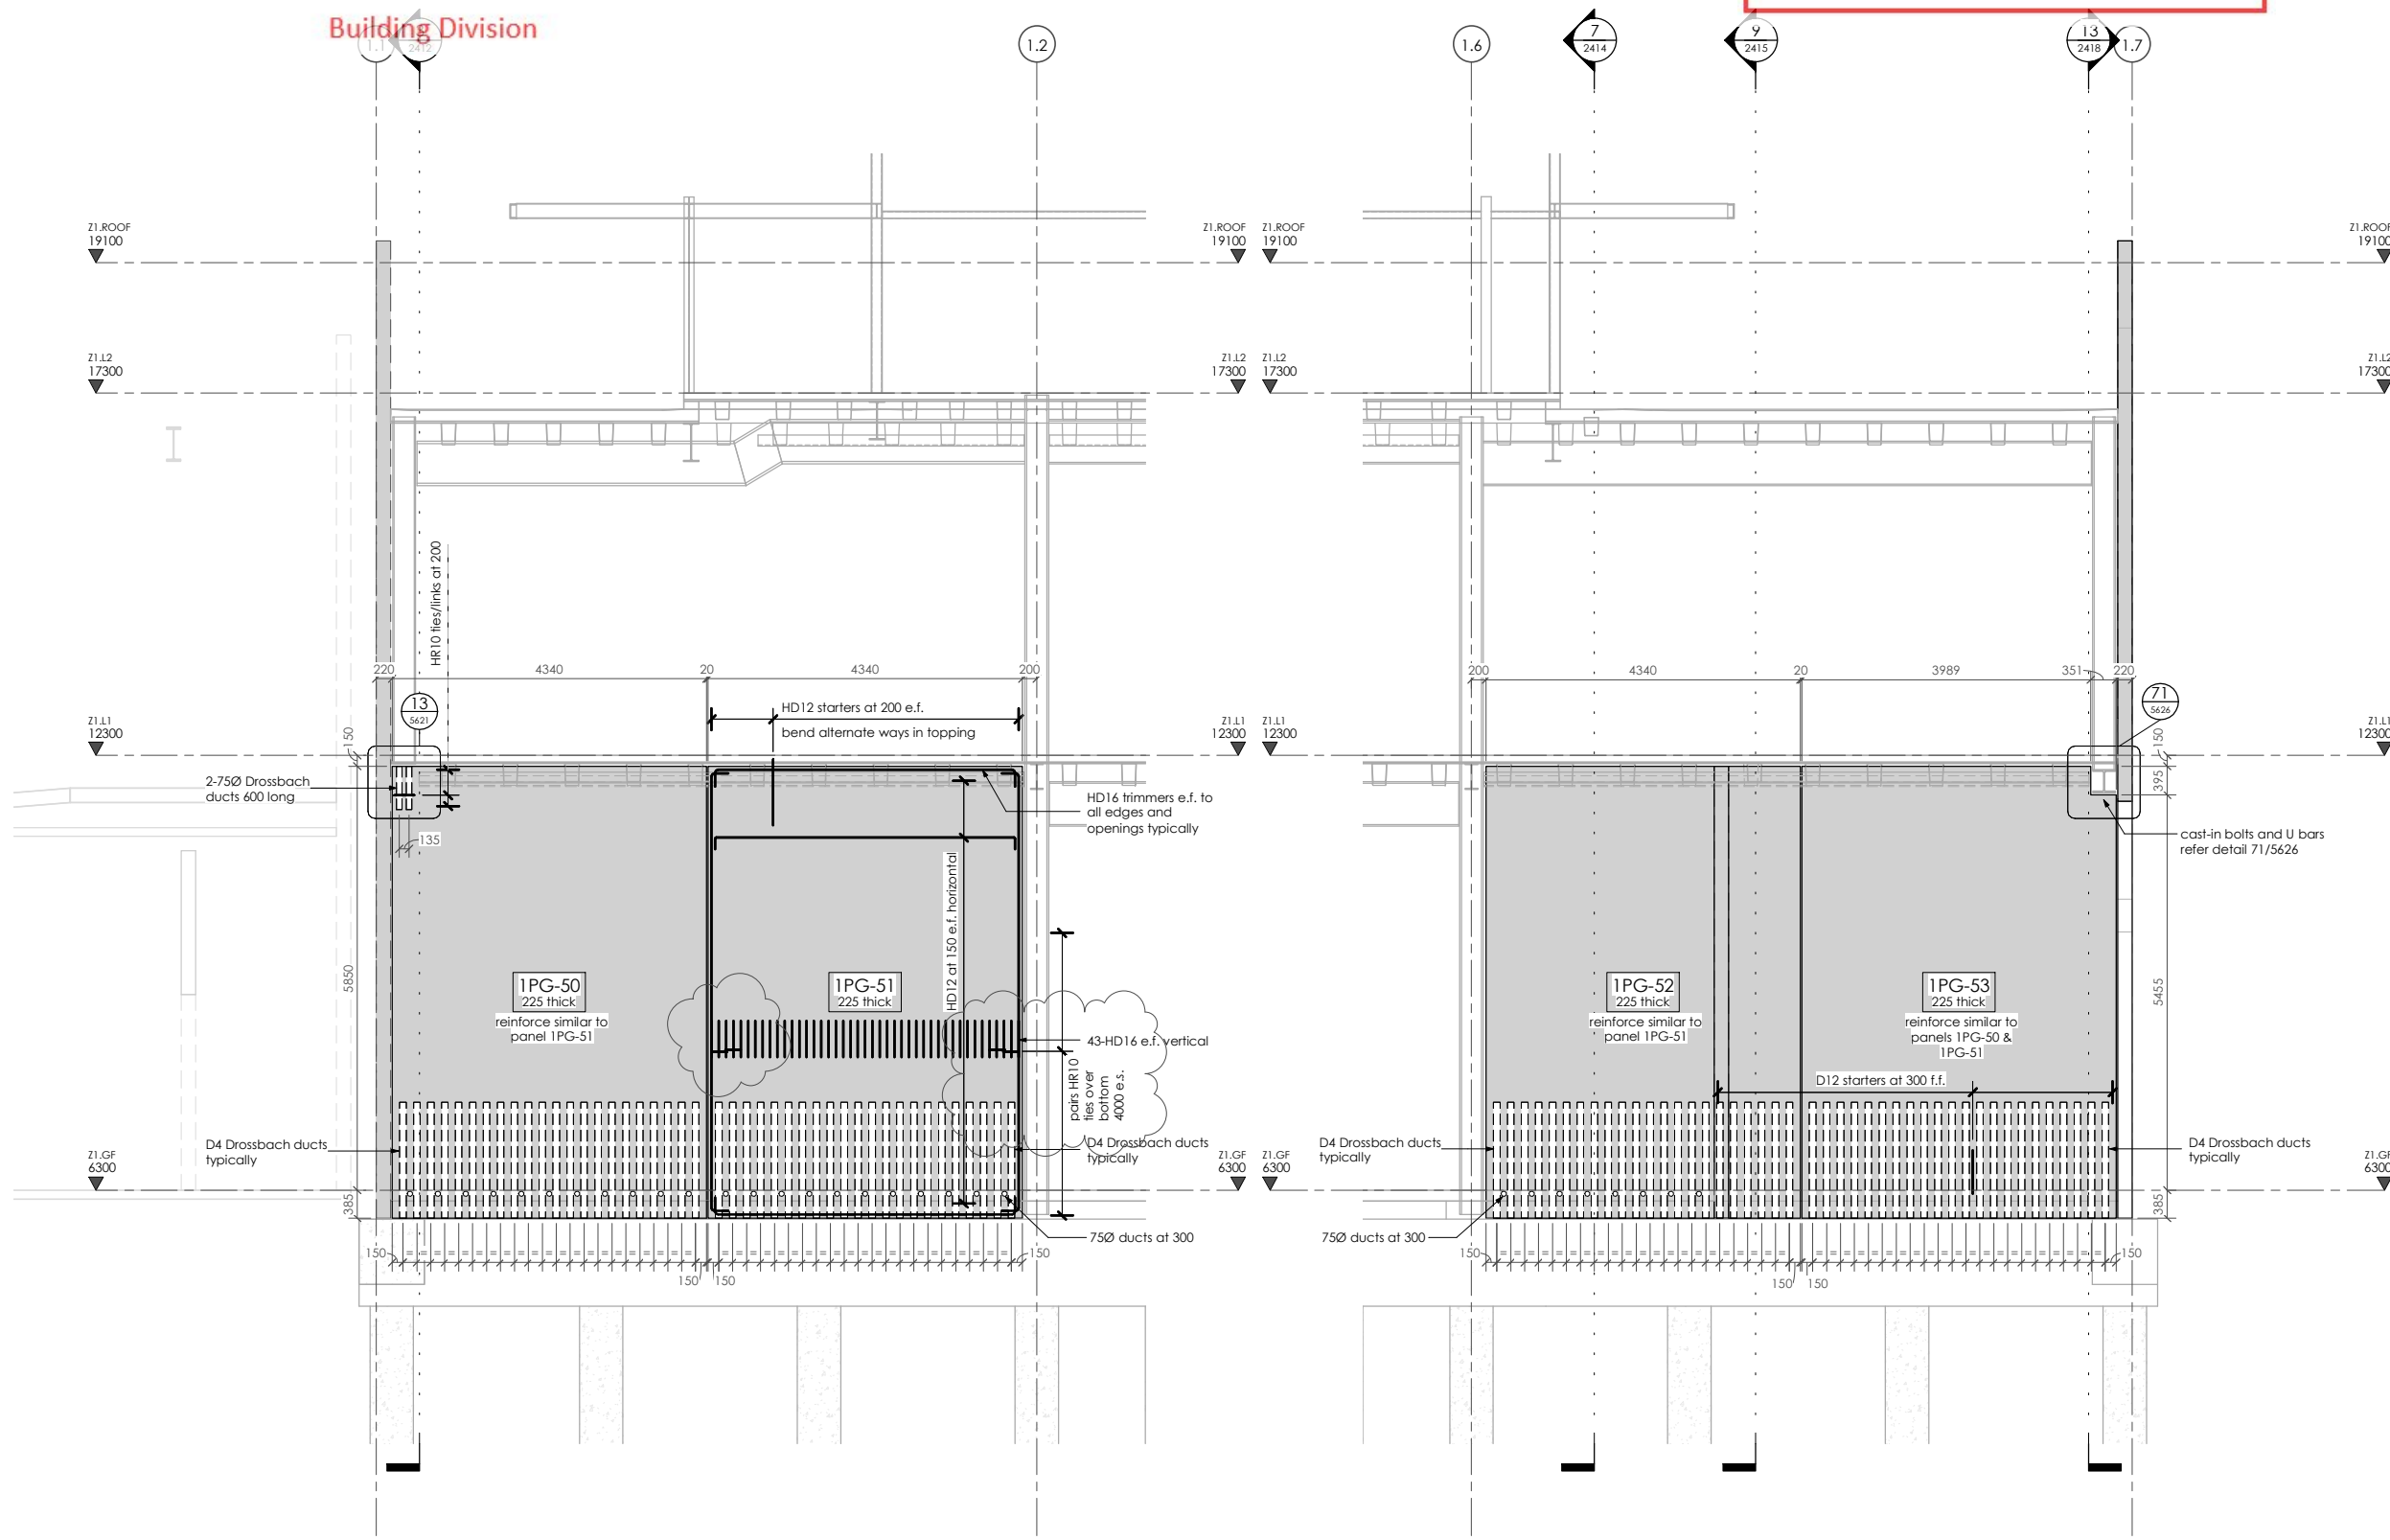


Invercargill City
Council
Building Consent
Authority
Approved Site Copy

Approved For Issue
27/02/2020

2	25.10.19	CONSENT ISSUE	GPW
1	27.09.19	PEER REVIEW ISSUE	GPW
REV	DATE	AMENDMENT	BY

CLIENT:
HWCP

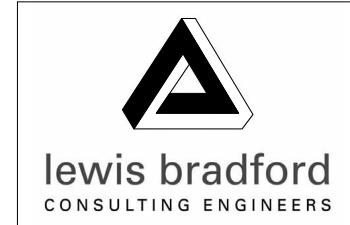

PROJECT:
**INVERCARGILL CENTRAL
ZONE 1 ANCHOR**

DRAWING TITLE:
**PRECAST PANEL
ELEVATIONS
GRIDLINE 1.C**

DRAWN: GPW	SCALE: 1 : 50 at A1
ENGINEER: EL/TSS	
CHECKED: -	

118083-Z1-WD-ST 2419 REV. 2

PANEL ELEVATIONS - Gridline 1.C
1 : 50 at A1

PANEL ELEVATIONS - Gridline 1.C
1 : 50 at A1

17 Dec 2019


Building Division

BUILDING CONSENT NUMBER
2019/1381

THIS DRAWING AND ALL INFORMATION CONTAINED WITHIN IS THE PROPERTY OF LEWIS BRADFORD. ITS CONTENTS ARE CONFIDENTIAL AND MUST NOT BE REPRODUCED OR DISTRIBUTED TO ANY OTHER PERSON OR COMPANY UNLESS AGREED TO IN WRITING BY LEWIS BRADFORD


CONTRACTOR TO VERIFY ALL DIMENSIONS ON SITE REFER TO ARCHITECT'S DRAWING FOR ALL SETOUTS

NOTES:
Refer drawing 0002 for standard notes. Refer also to Structural Specification.
Refer also 5300 & 5310 series drawings for precast panel details
Xypex additive to be added to all precast panels on Gridlines 1.1, 1.7 & 1.J and precast panels 1PG-30 & 1PG31 to southeastern re-entrant corner

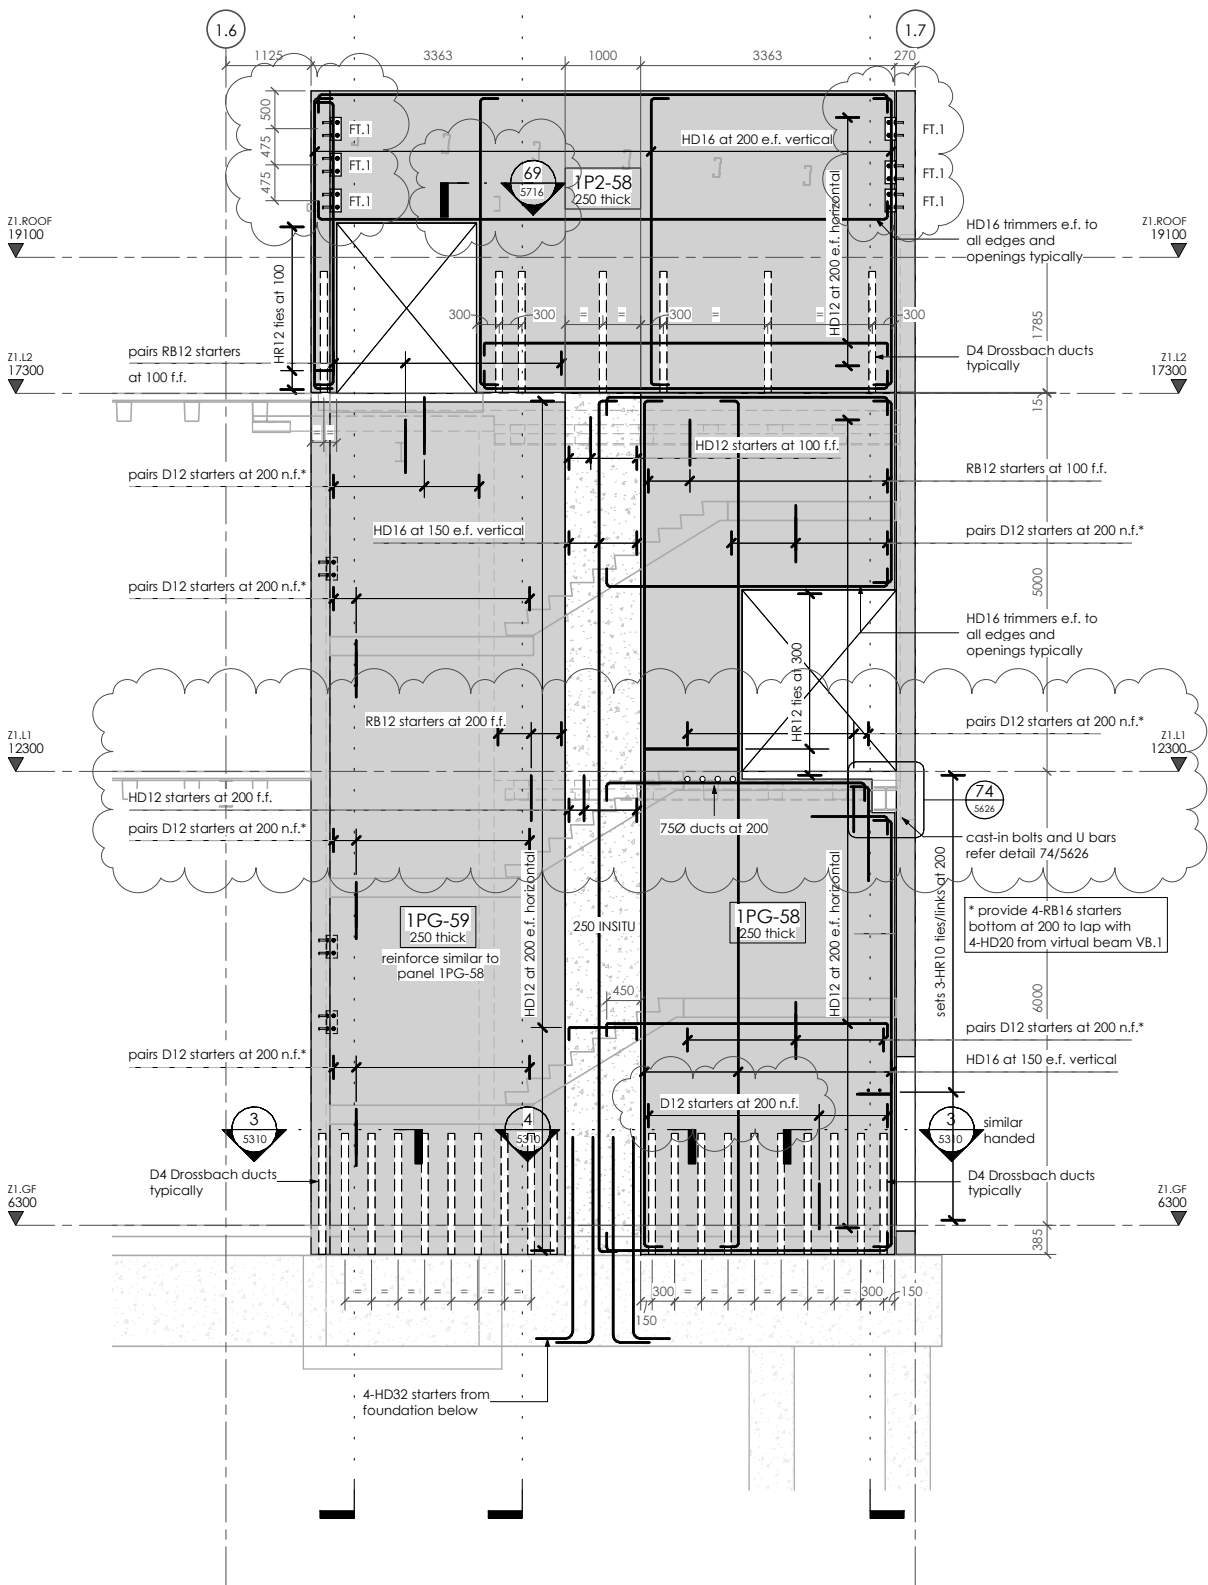

PANEL ELEVATIONS - Near Gridline 1.D

1 : 50 at A1
16
2401

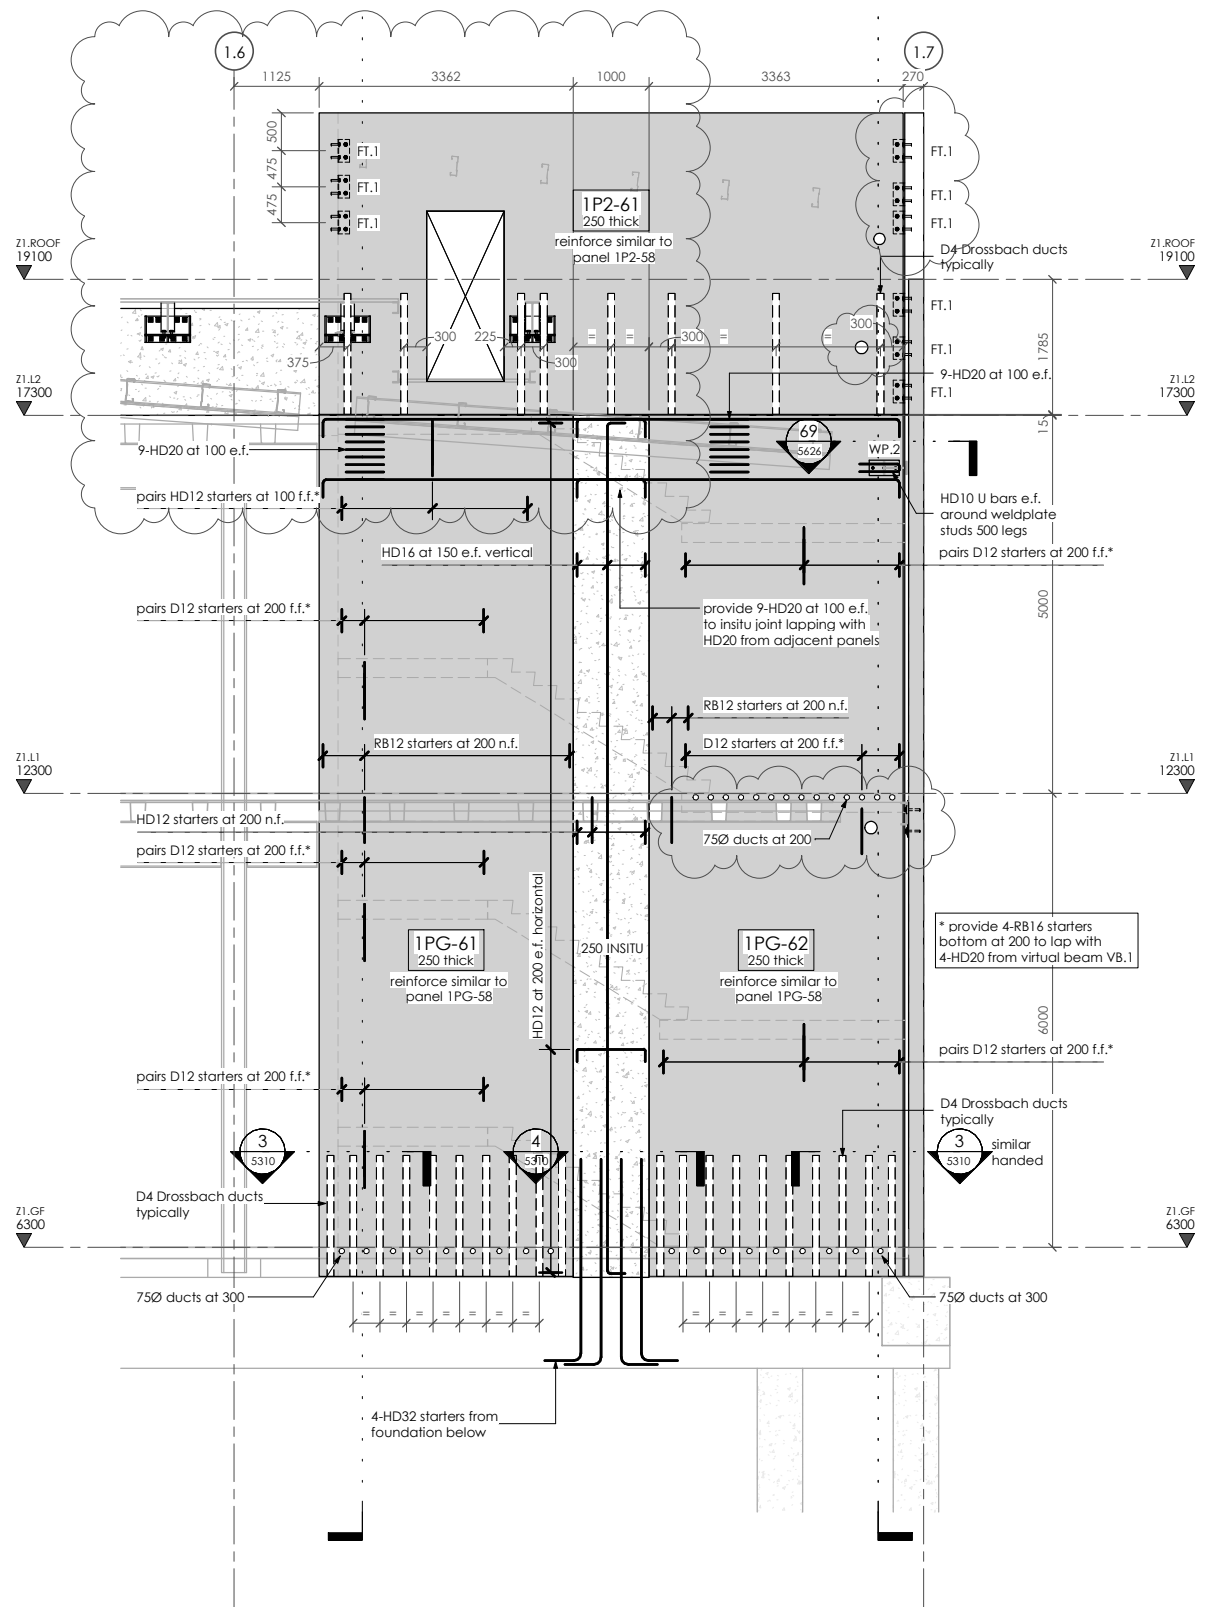

PANEL ELEVATIONS - Gridline 1.D


1 : 50 at A1
17
2401

Invercargill City
Council
Building Consent
Authority
Approved Site Copy

Approved For Issue
27/02/2020

REV	DATE	AMENDMENT	BY
2	25.10.19	CONSENT ISSUE	GPW
1	27.09.19	PEER REVIEW ISSUE	GPW

CLIENT:
HWCP

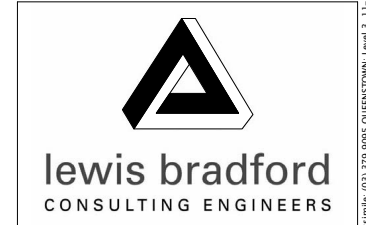

PROJECT:
**INVERCARGILL CENTRAL
ZONE 1 ANCHOR**

DRAWING TITLE:
**PRECAST PANEL
ELEVATIONS
NEAR GRIDLINE 1.D**

DRAWN: GPW	SCALE: 1 : 50 at A1
ENGINEER: EL/TSS	
CHECKED: -	

118083-Z1-WD-ST 2420
REV. 2

17 Dec 2019


Building Division

BUILDING CONSENT NUMBER
2019/1381

THIS DRAWING AND ALL INFORMATION CONTAINED WITHIN IS THE PROPERTY OF LEWIS BRADFORD. ITS CONTENTS ARE CONFIDENTIAL AND MUST NOT BE REPRODUCED OR DISTRIBUTED TO ANY OTHER PERSON OR COMPANY UNLESS AGREED TO IN WRITING BY LEWIS BRADFORD

CONTRACTOR TO VERIFY ALL DIMENSIONS ON SITE REFER TO ARCHITECT'S DRAWING FOR ALL SETOUTS


NOTES :
Refer drawing 0002 for standard notes. Refer also to Structural Specification.
Refer also 5300 & 5310 series drawings for precast panel details
Xypex additive to be added to all precast panels on Gridlines 1.1, 1.7 & 1.J and precast panels 1PG-30 & 1PG31 to southeastern re-entrant corner

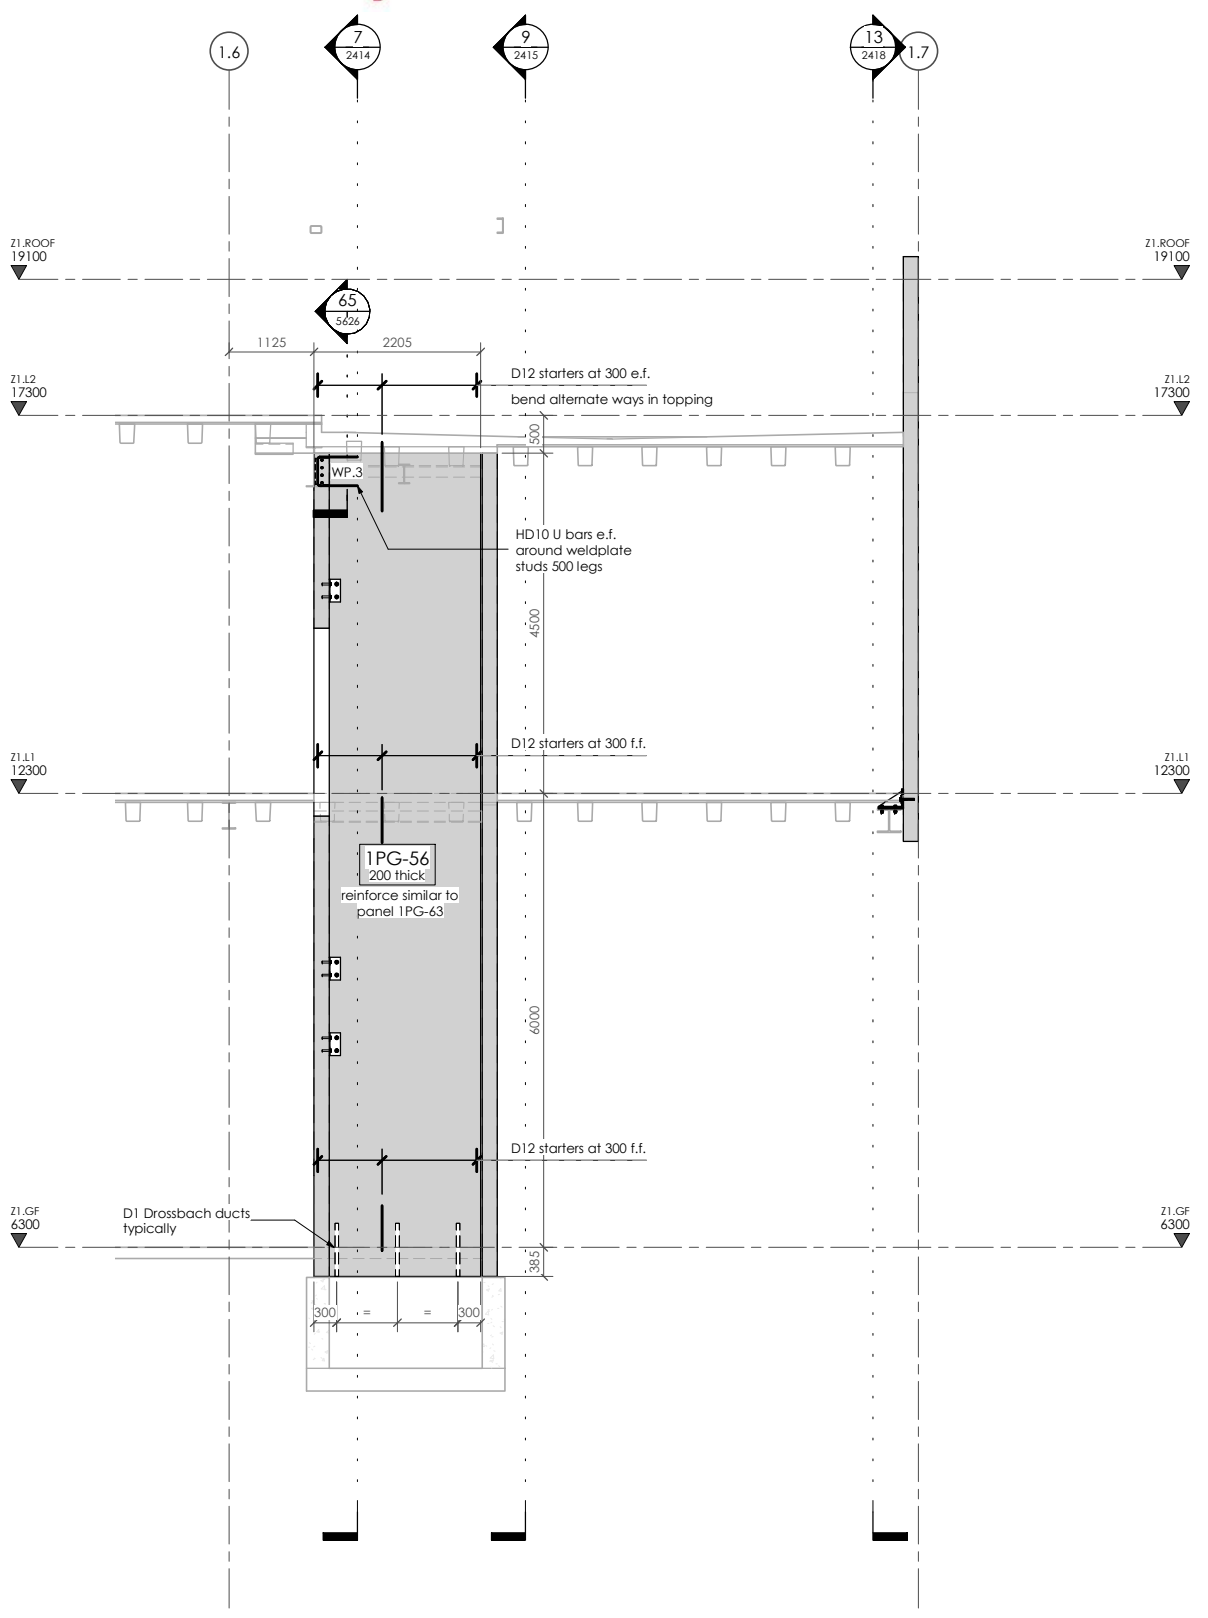

PANEL ELEVATIONS - Near Gridline 1.C

1 : 50 of A1

18
2401

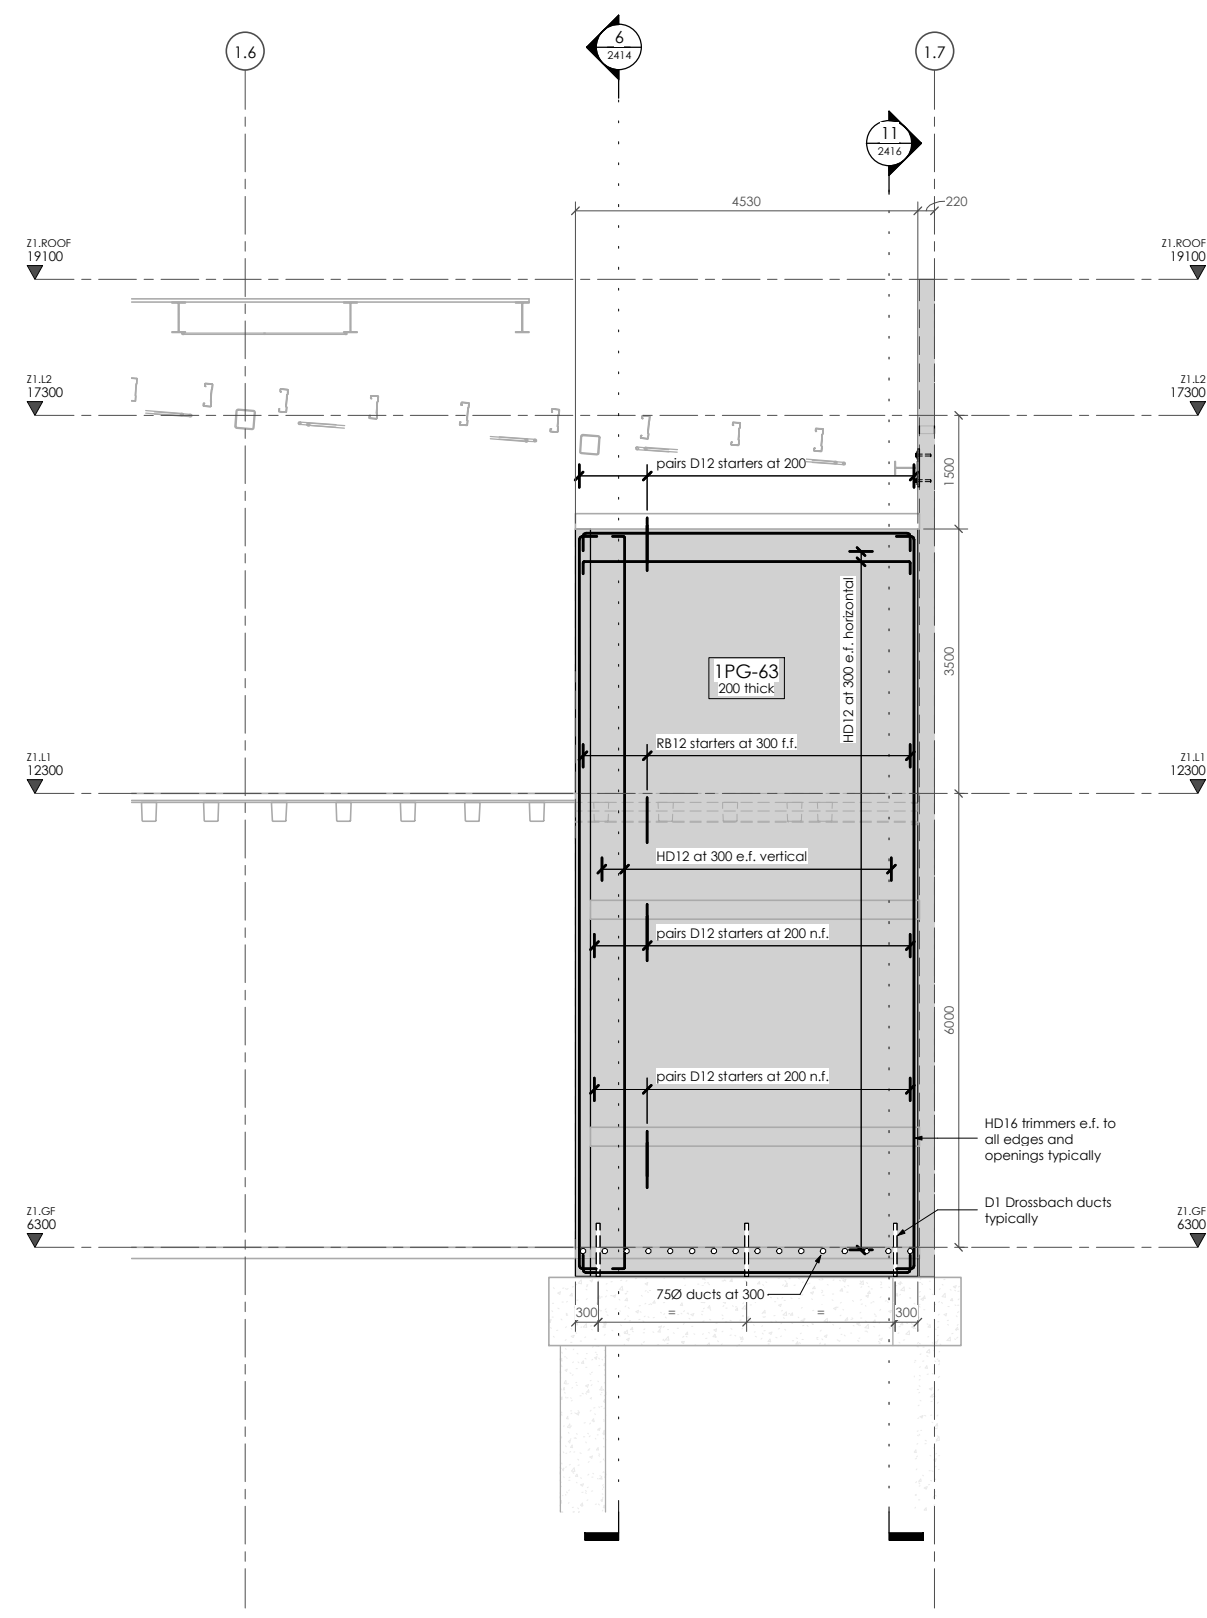

PANEL ELEVATIONS - Near Gridline 1.G

1 : 50 of A1


19
2401

Invercargill City
Council
Building Consent
Authority
Approved Site Copy

Approved For Issue
27/02/2020

REV	DATE	AMENDMENT	BY
2	25.10.19	CONSENT ISSUE	GPW
1	27.09.19	PEER REVIEW ISSUE	GPW

CLIENT:
HWCP

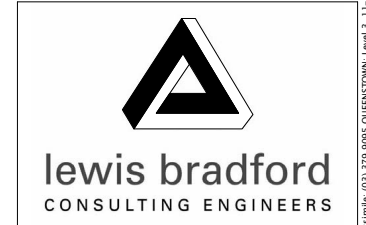

PROJECT:
**INVERCARGILL CENTRAL
ZONE 1 ANCHOR**

DRAWING TITLE:
**PRECAST PANEL
ELEVATIONS
NEAR GRIDLINE 1.C AND
1.G**

DRAWN: GPW	SCALE: 1 : 50 at A1
ENGINEER: EL/TSS	
CHECKED: -	
118083-Z1-WD-ST 2421	REV. 2

17 Dec 2019


Building Division

BUILDING CONSENT NUMBER
2019/1381

THIS DRAWING AND ALL INFORMATION CONTAINED WITHIN IS THE PROPERTY OF LEWIS BRADFORD. ITS CONTENTS ARE CONFIDENTIAL AND MUST NOT BE REPRODUCED OR DISTRIBUTED TO ANY OTHER PERSON OR COMPANY UNLESS AGREED TO IN WRITING BY LEWIS BRADFORD

CONTRACTOR TO VERIFY ALL DIMENSIONS ON SITE REFER TO ARCHITECT'S DRAWING FOR ALL SETOUTS

NOTES :
Refer drawing 0002 for standard notes. Refer also to Structural Specification.
Refer also 5300 & 5310 series drawings for precast panel details
Xypex additive to be added to all precast panels on Gridlines 1.1, 1.7 & 1.J and precast panels 1PG-30 & 1PG31 to southeastern re-entrant corner

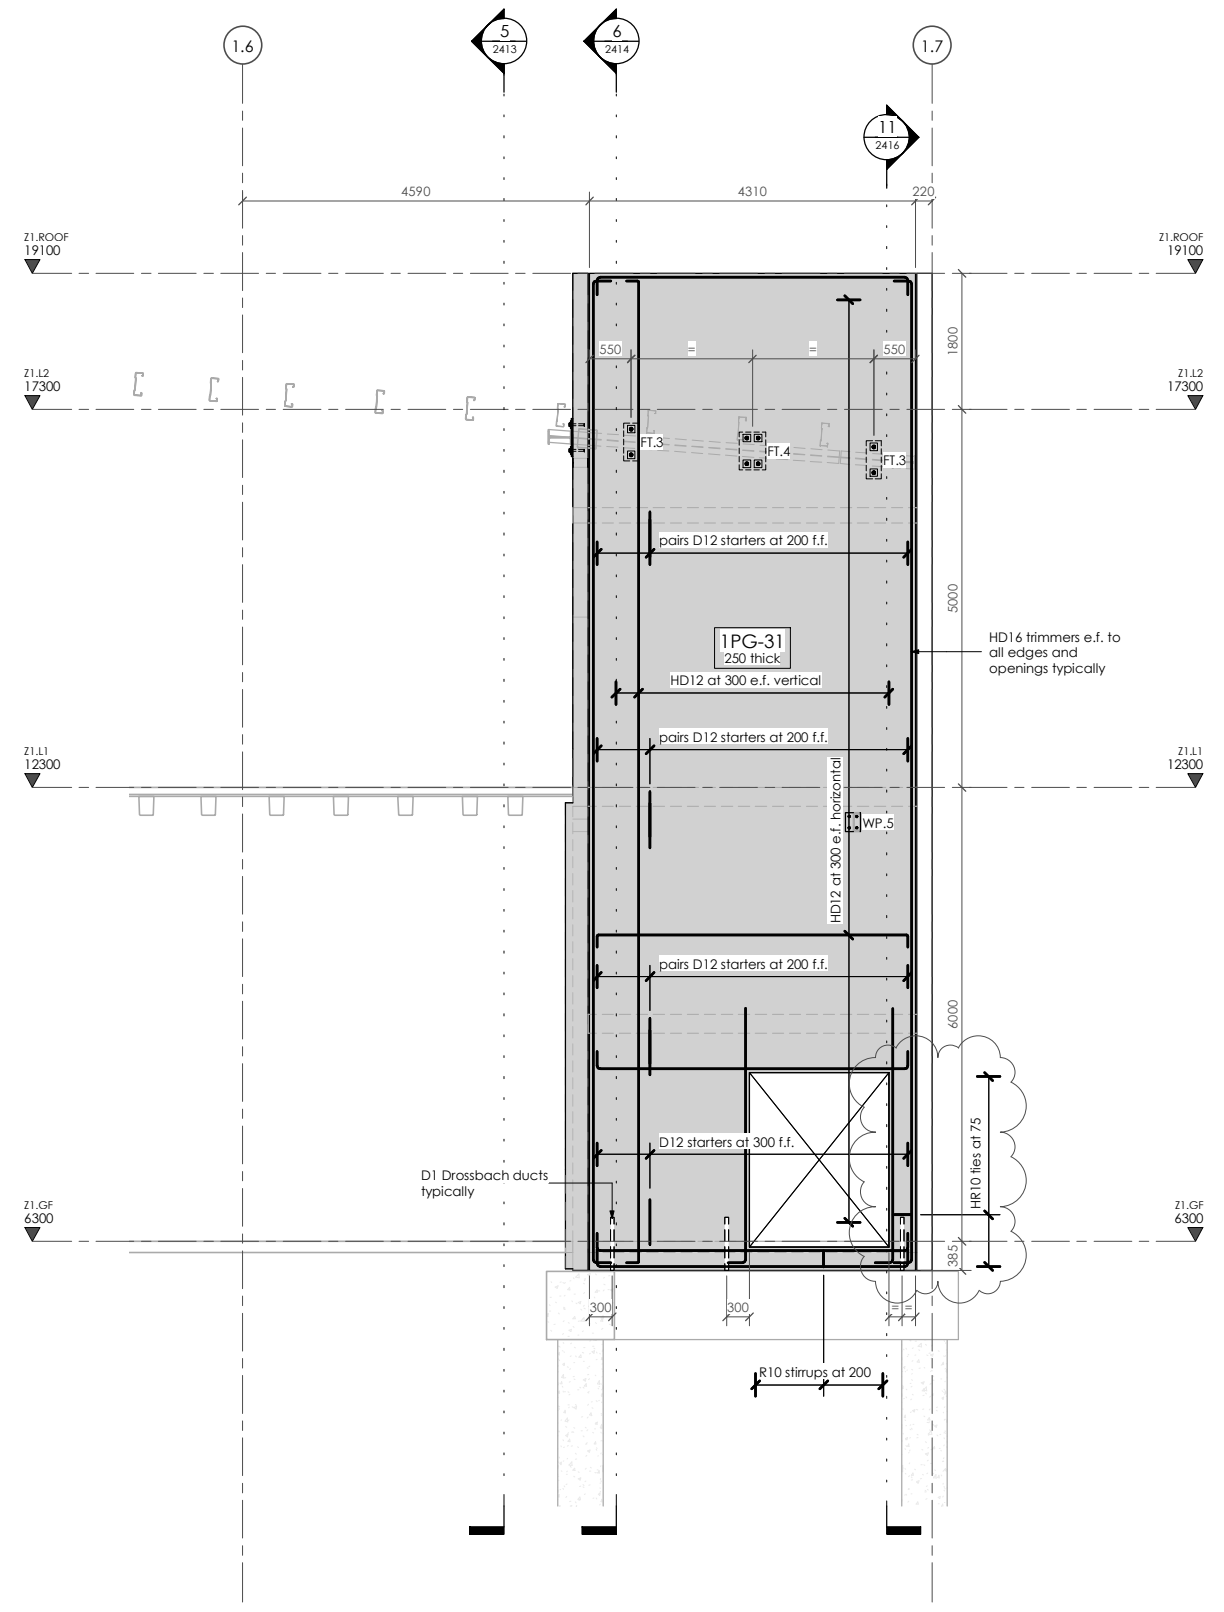

PANEL ELEVATIONS - Near Gridline 1.H

1 : 50 at A1


20
2401

Invercargill City
Council
Building Consent
Authority
Approved Site Copy

Approved For Issue
27/02/2020

REV	DATE	AMENDMENT	BY
2	25.10.19	CONSENT ISSUE	GPW
1	27.09.19	PEER REVIEW ISSUE	GPW

CLIENT:
HWCP

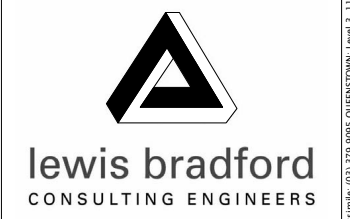

PROJECT:
**INVERCARGILL CENTRAL
ZONE 1 ANCHOR**

DRAWING TITLE:
**PRECAST PANEL
ELEVATIONS
NEAR GRIDLINE 1.H**

DRAWN: GPW	SCALE: 1 : 50 at A1
ENGINEER: EL/TSS	
CHECKED: -	

118083-Z1-WD-ST 2422 REV. 2

17 Dec 2019


Building Division

BUILDING CONSENT NUMBER
2019/1381

THIS DRAWING AND ALL INFORMATION CONTAINED WITHIN IS THE PROPERTY OF LEWIS BRADFORD. ITS CONTENTS ARE CONFIDENTIAL AND MUST NOT BE REPRODUCED OR DISTRIBUTED TO ANY OTHER PERSON OR COMPANY UNLESS AGREED TO IN WRITING BY LEWIS BRADFORD.

CONTRACTOR TO VERIFY ALL DIMENSIONS ON SITE REFER TO ARCHITECT'S DRAWING FOR ALL SETOUTS

NOTES :
Refer drawing 0002 for standard notes.
Refer also to Structural Specification.
Refer also 5300 & 5310 series drawings for precast panel details
Xypex additive to be added to all precast panels on Gridlines 1.1, 1.7 & 1.J and precast panels 1PG-30 & 1PG31 to southeastern re-entrant corner

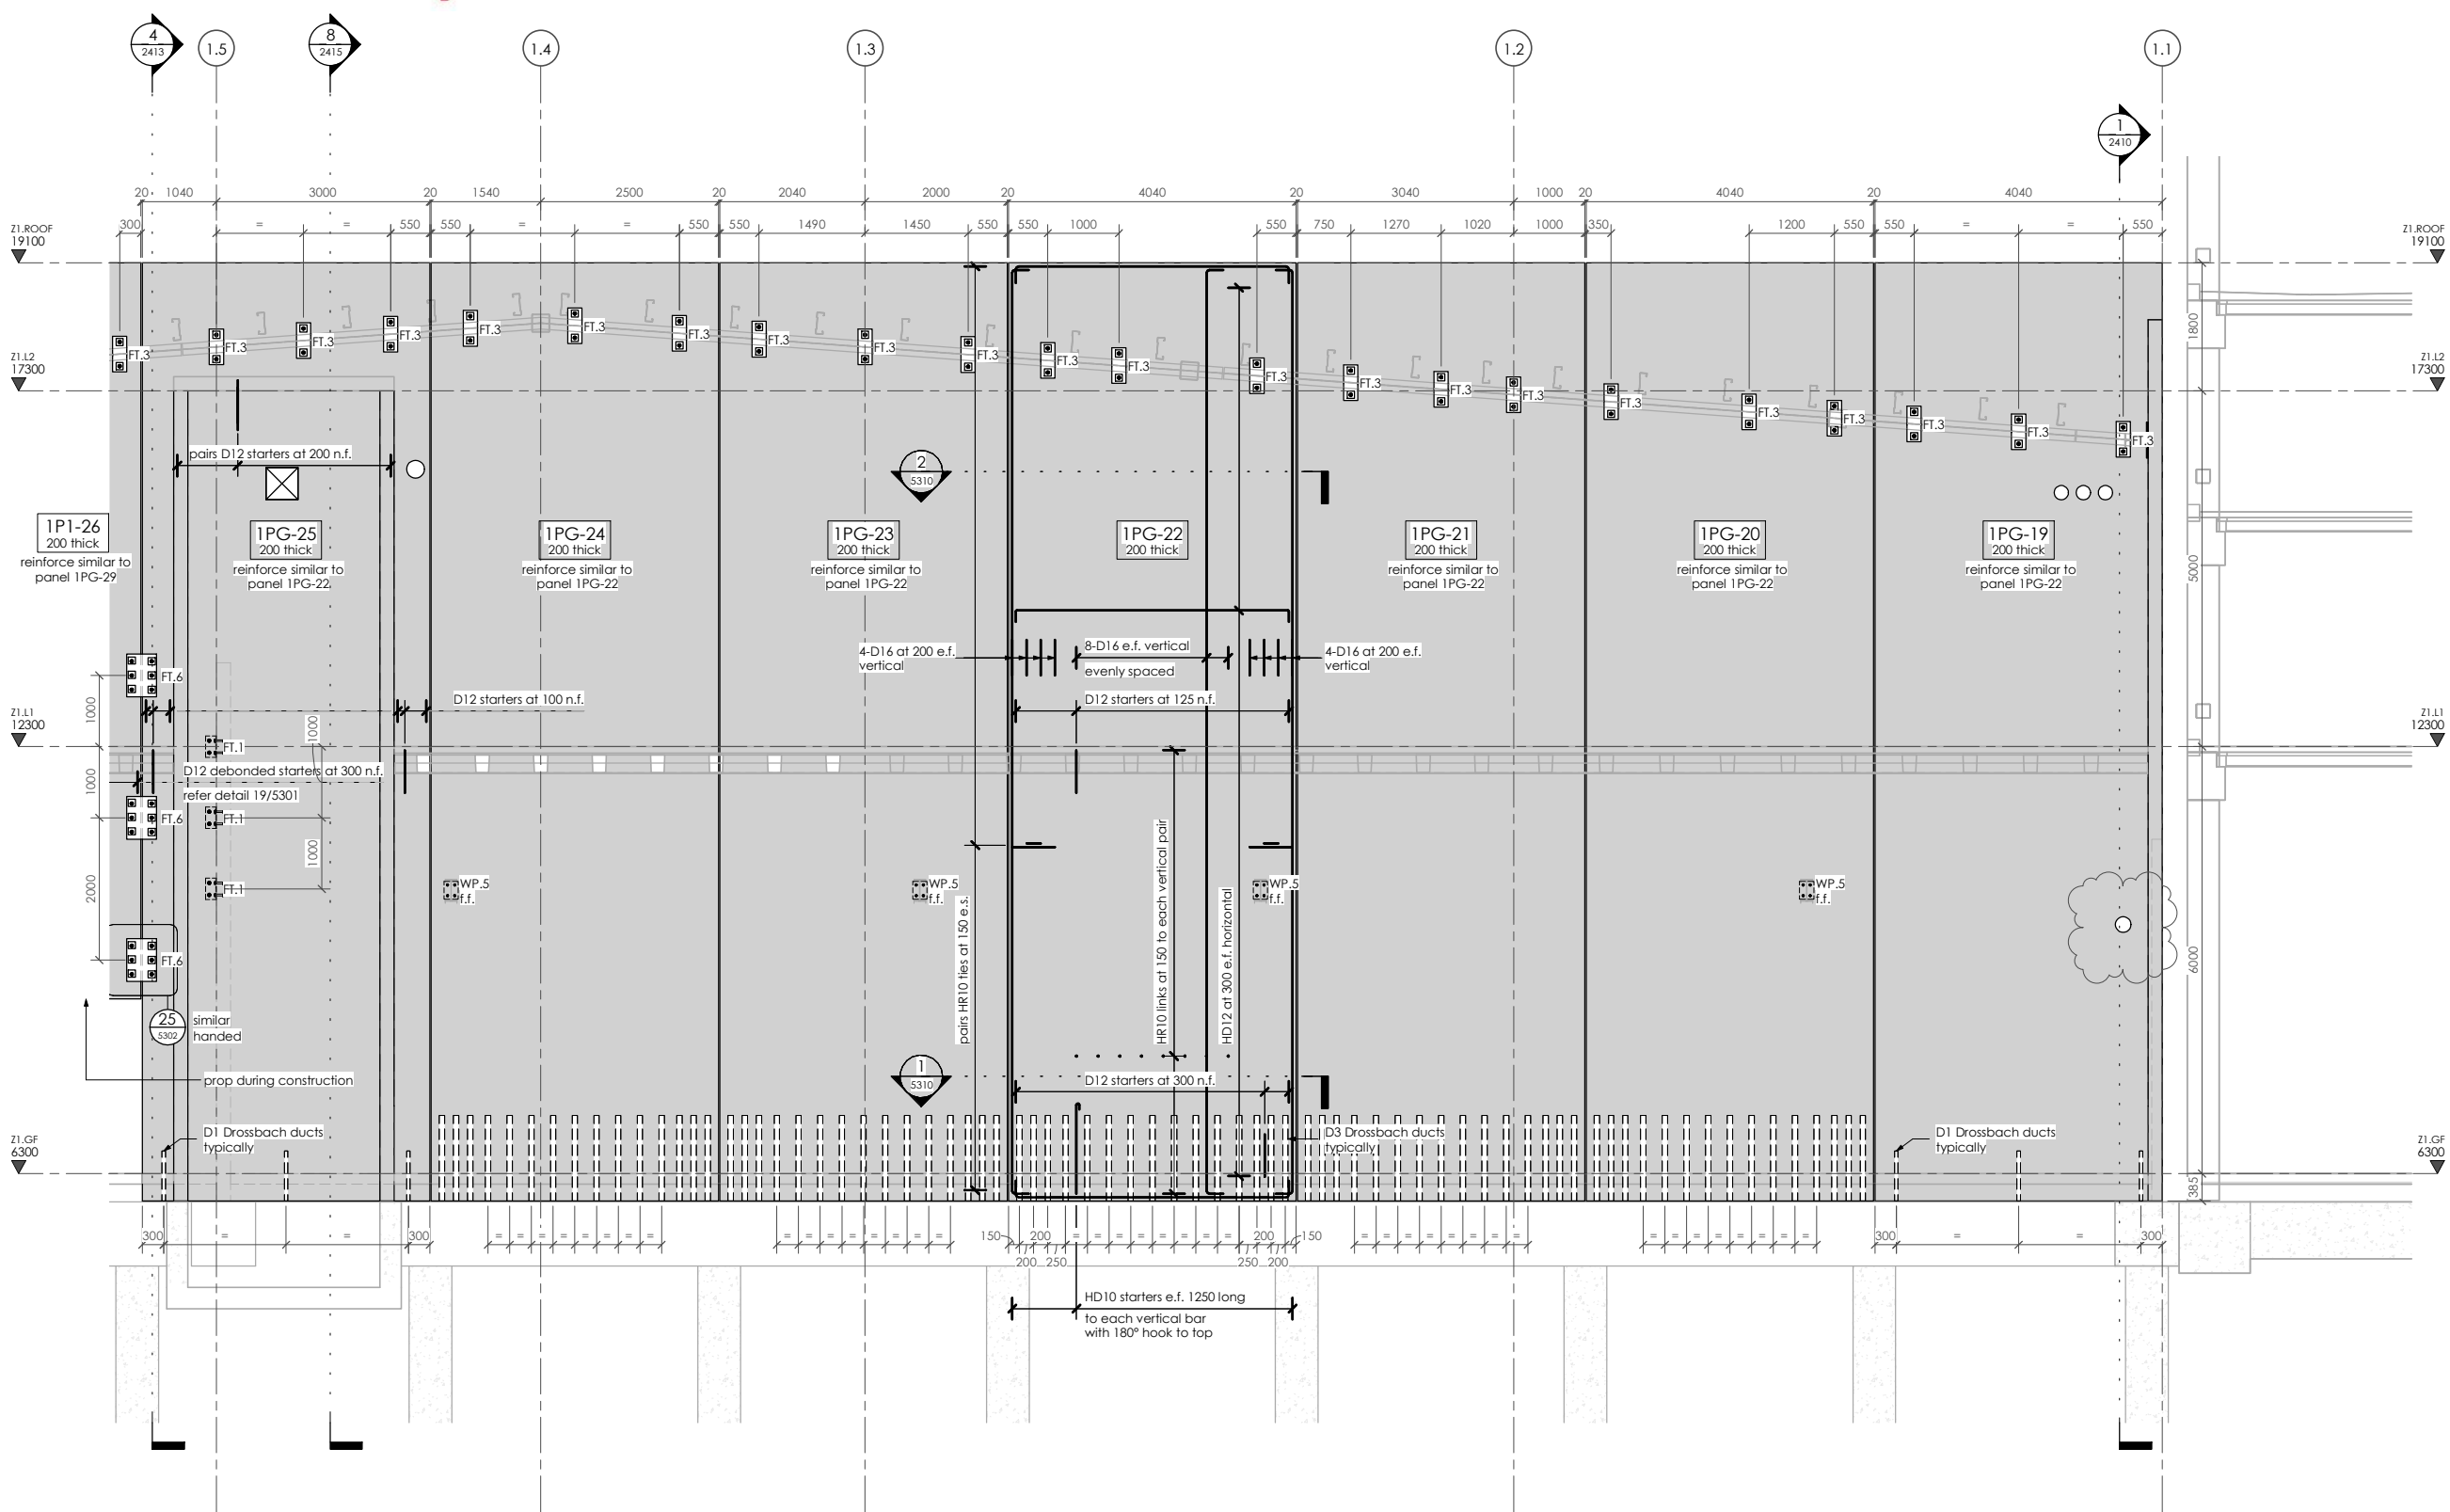


Invercargill City Council
Building Consent Authority
Approved Site Copy

Approved For Issue
27/02/2020

REV	DATE	AMENDMENT	BY
2	25.10.19	CONSENT ISSUE	GPW
1	27.09.19	PEER REVIEW ISSUE	GPW

CLIENT:
HWCP

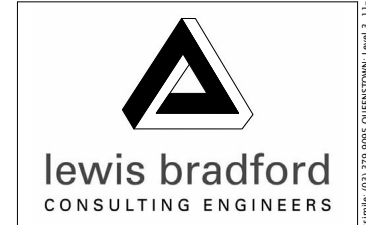

PROJECT:
INVERCARGILL CENTRAL ZONE 1 ANCHOR

DRAWING TITLE:
PRECAST PANEL ELEVATIONS GRIDLINE 1.J - PART 1

DRAWN: GPW	SCALE: 1 : 50 at A1
ENGINEER: EL/TSS	
CHECKED: -	
118083-Z1-WD-ST 2423	REV. 2

PANEL ELEVATIONS - Gridline 1.J - Part 1

1 : 50 at A1
21
2410

17 Dec 2019

Building Division


BUILDING CONSENT NUMBER
2019/1381

THIS DRAWING AND ALL INFORMATION CONTAINED WITHIN IS THE PROPERTY OF LEWIS BRADFORD. ITS CONTENTS ARE CONFIDENTIAL AND MUST NOT BE REPRODUCED OR DISTRIBUTED TO ANY OTHER PERSON OR COMPANY UNLESS AGREED TO IN WRITING BY LEWIS BRADFORD

CONTRACTOR TO VERIFY ALL DIMENSIONS ON SITE REFER TO ARCHITECT'S DRAWING FOR ALL SETOUTS

NOTES :

- Refer drawing 0002 for standard notes. Refer also to Structural Specification.
- Refer also 5300 & 5310 series drawings for precast panel details
- Xypex additive to be added to all precast panels on Gridlines 1.1, 1.7 & 1.J and precast panels 1PG-30 & 1PG31 to southeastern re-entrant corner

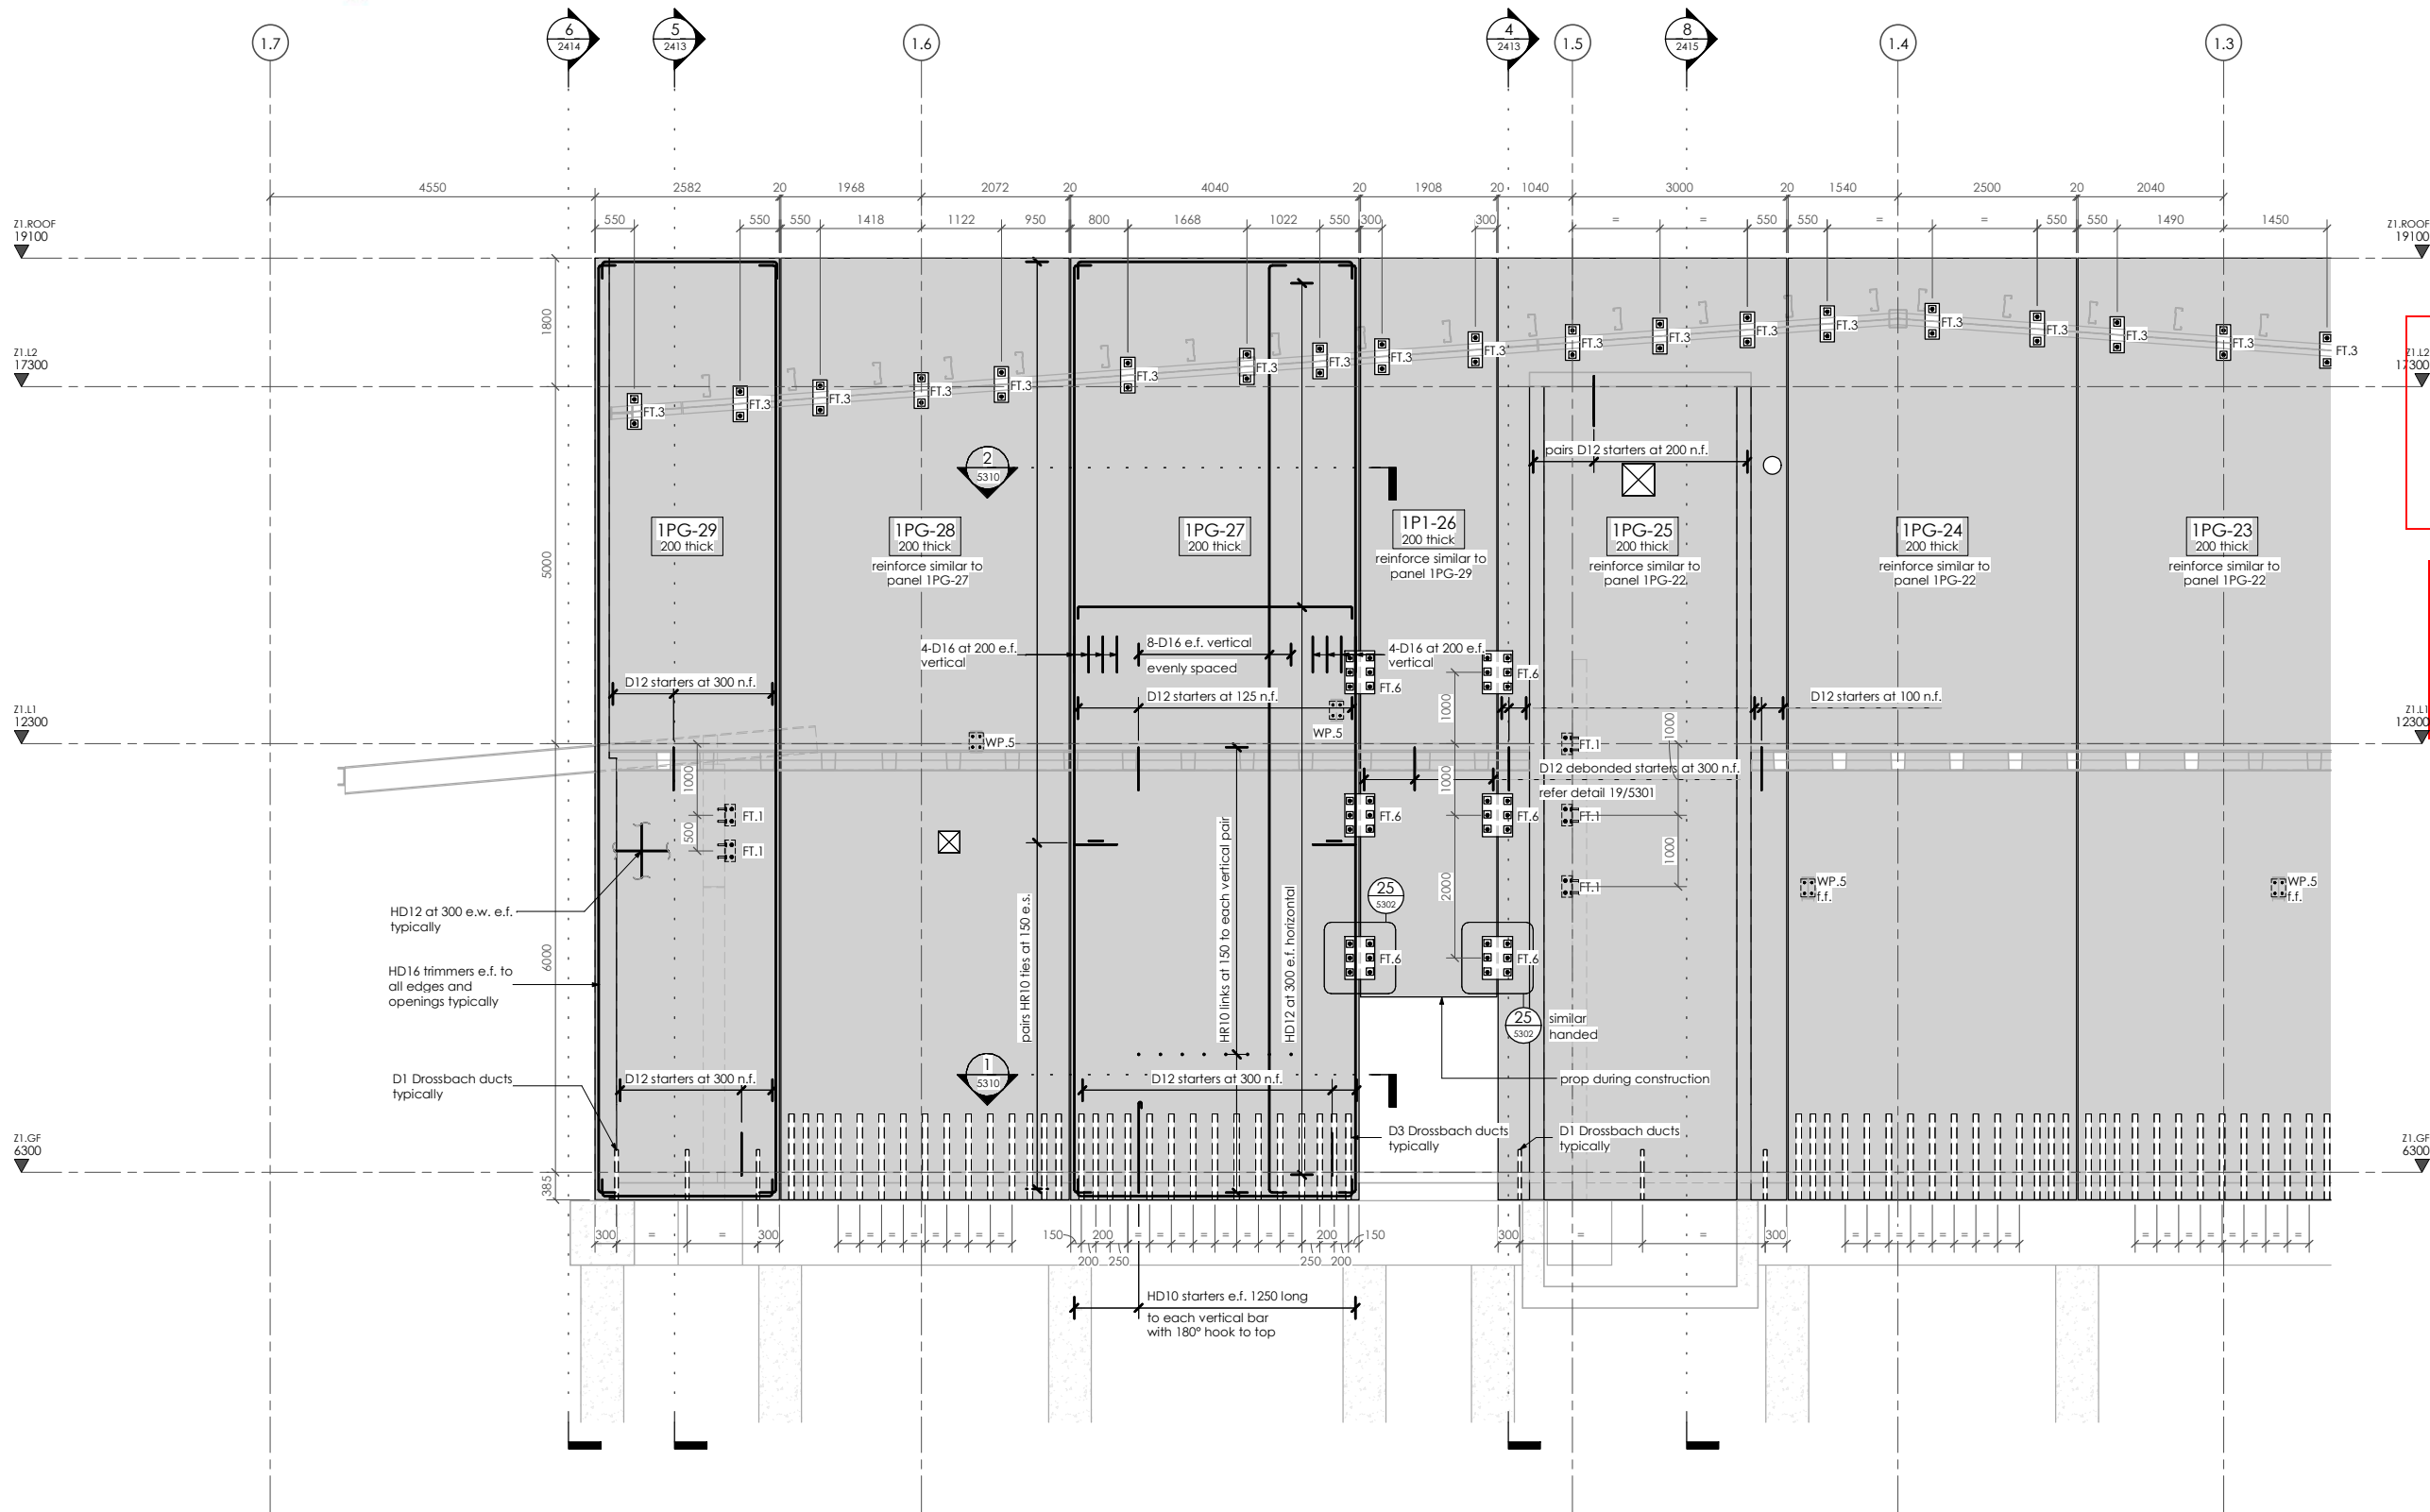


**Invercargill City Council
Building Consent Authority
Approved Site Copy**

**Approved For Issue
27/02/2020**

REV	DATE	AMENDMENT	BY
2	25.10.19	CONSENT ISSUE	GPW
1	27.09.19	PEER REVIEW ISSUE	GPW

CLIENT:
HWCP

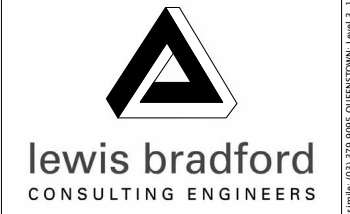

PROJECT:
**INVERCARGILL CENTRAL
ZONE 1 ANCHOR**

DRAWING TITLE:
**PRECAST PANEL
ELEVATIONS
GRIDLINE 1.J - PART 2**

DRAWN: GPW	SCALE: 1 : 50 at A1
ENGINEER: EL/TSS	
CHECKED: -	
118083-Z1-WD-ST 2424	REV. 2


PANEL ELEVATIONS - Gridline 1.J - Part 2

1 : 50 at A1
22/2401


17 Dec 2019

Building Division

BUILDING CONSENT NUMBER
2019/1381

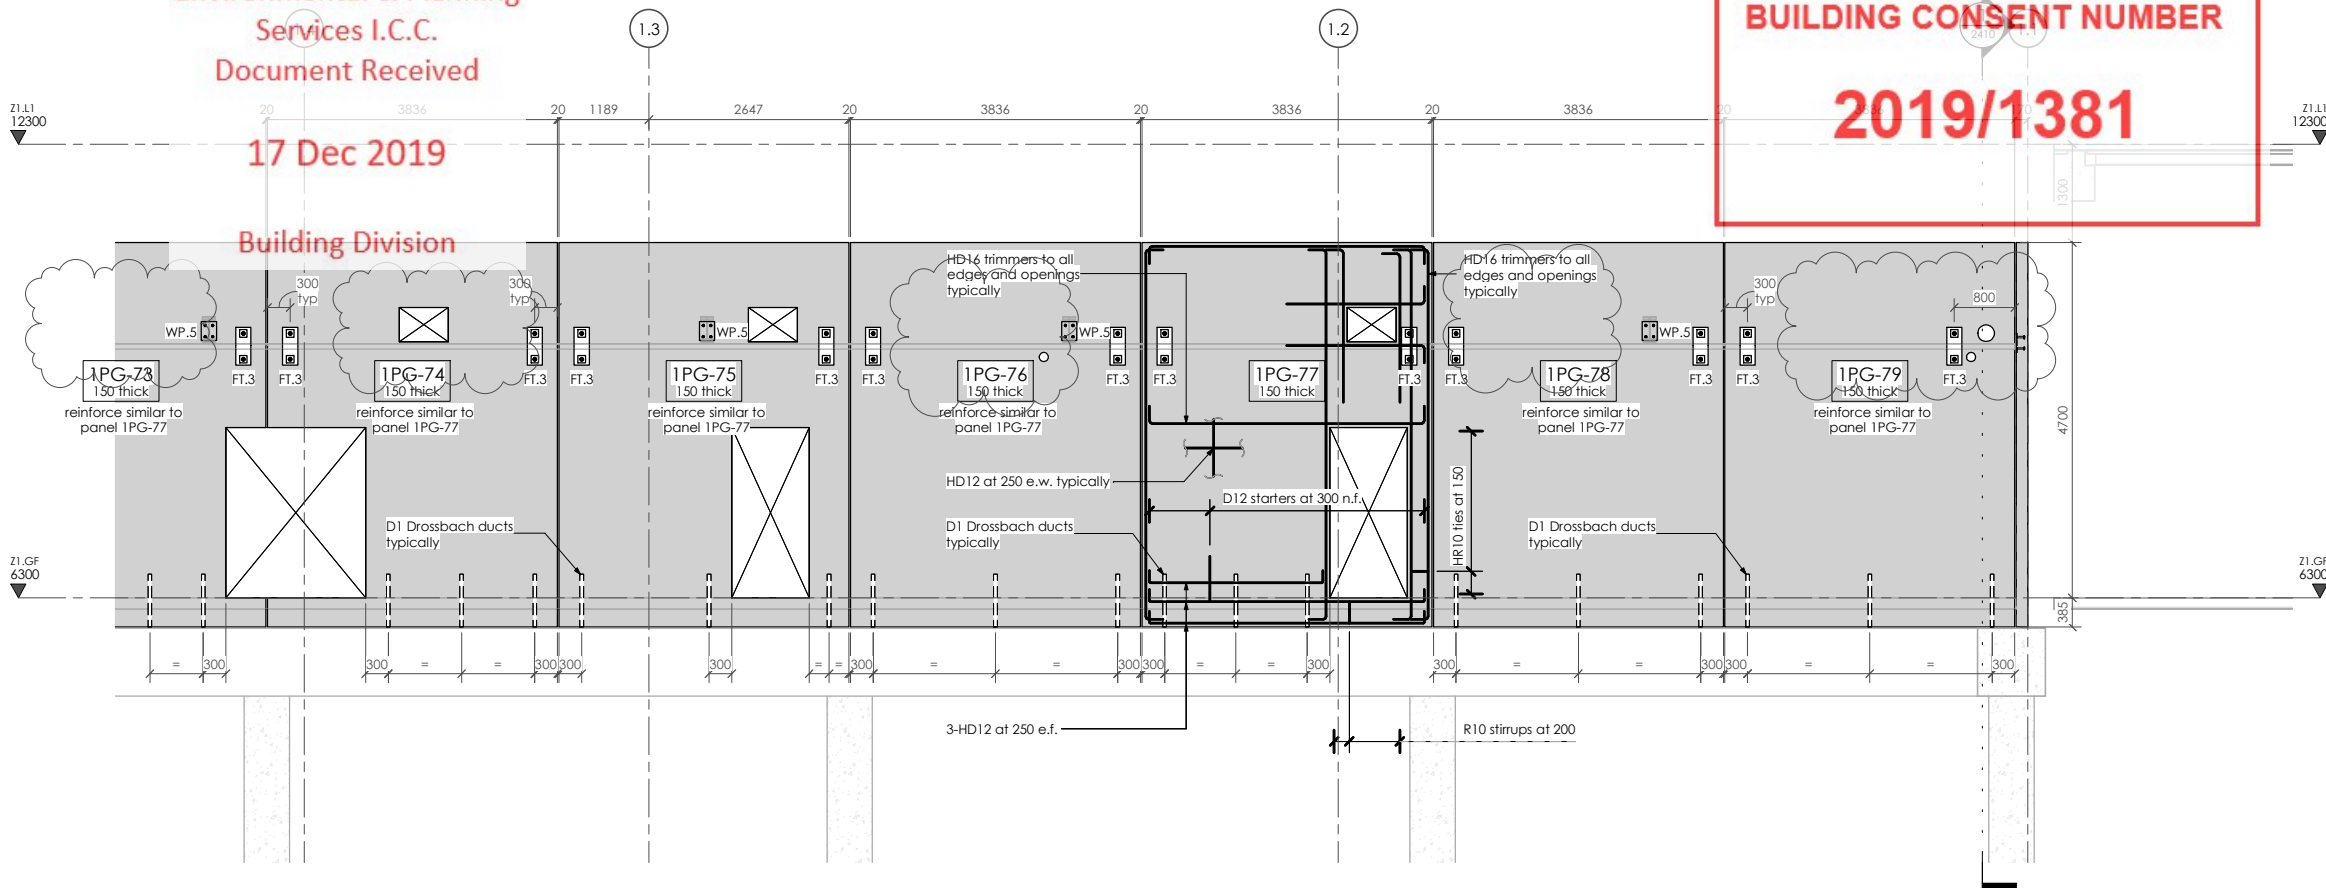

PANEL ELEVATIONS - Near Gridline 1.J

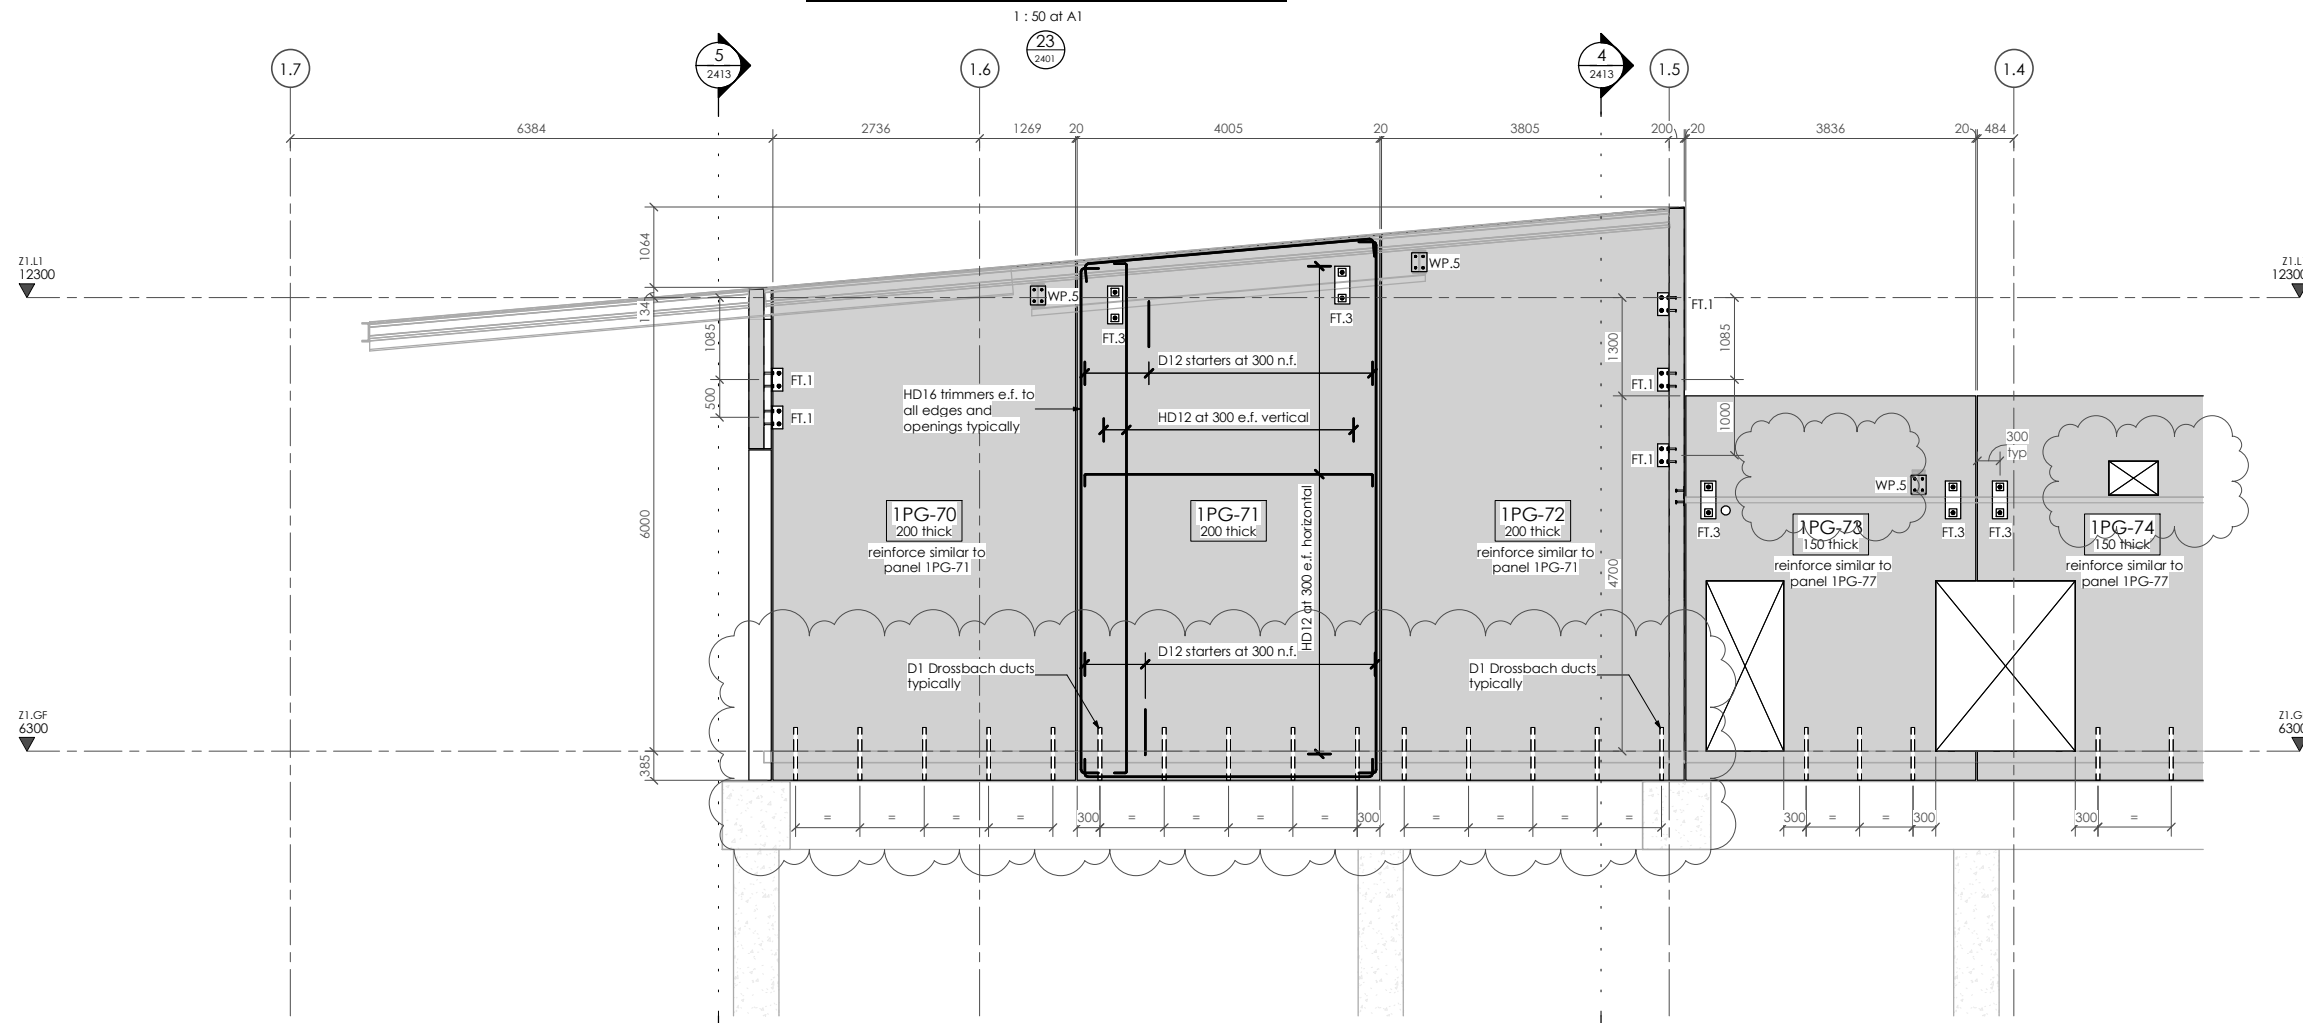

PANEL ELEVATIONS - Near Gridline 1.J

THIS DRAWING AND ALL INFORMATION CONTAINED WITHIN IS THE PROPERTY OF LEWIS BRADFORD. ITS CONTENTS ARE CONFIDENTIAL AND MUST NOT BE REPRODUCED OR DISTRIBUTED TO ANY OTHER PERSON OR COMPANY UNLESS AGREED TO IN WRITING BY LEWIS BRADFORD.

CONTRACTOR TO VERIFY ALL DIMENSIONS ON SITE REFER TO ARCHITECT'S DRAWING FOR ALL SETOUTS

NOTES:

Refer drawing 0002 for standard notes. Refer also to Structural Specification.

Refer also 5300 & 5310 series drawings for precast panel details


Xypex additive to be added to all precast panels on Gridlines 1.1, 1.7 & 1.J and precast panels 1PG-30 & 1PG31 to southeastern re-entrant corner

Invercargill City Council
Building Consent Authority
Approved Site Copy

Approved For Issue
27/02/2020

REV	DATE	AMENDMENT	BY
2	25.10.19	CONSENT ISSUE	GPW
1	27.09.19	PEER REVIEW ISSUE	GPW

CLIENT:
HWCP

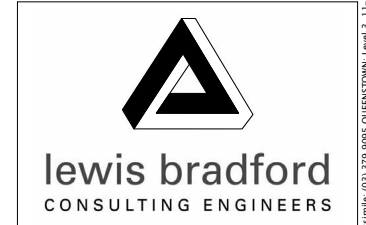

PROJECT:
INVERCARGILL CENTRAL ZONE 1 ANCHOR

DRAWING TITLE:
PRECAST PANEL ELEVATIONS NEAR GRIDLINE 1.J

DRAWN: GPW	SCALE: 1 : 50 at A1
ENGINEER: EL/TSS	
CHECKED: -	
118083-Z1-WD-ST 2425	REV. 2

17 Dec 2019


BUILDING CONSENT NUMBER
2019/1381

THIS DRAWING AND ALL INFORMATION CONTAINED WITHIN IS THE PROPERTY OF LEWIS BRADFORD. ITS CONTENTS ARE CONFIDENTIAL AND MUST NOT BE REPRODUCED OR DISTRIBUTED TO ANY OTHER PERSON OR COMPANY UNLESS AGREED TO IN WRITING BY LEWIS BRADFORD


CONTRACTOR TO VERIFY ALL DIMENSIONS ON SITE REFER TO ARCHITECT'S DRAWING FOR ALL SETOUTS

NOTES:
Refer drawing 0002 for standard notes. Refer also to Structural Specification.

ZONE 1 - pile depth varies according to required capacity - to be confirmed by the Geotechnical Engineer
ZONE 3 - pile depth approximately 9000-10000 below Ground Level - to be confirmed by the Geotechnical Engineer




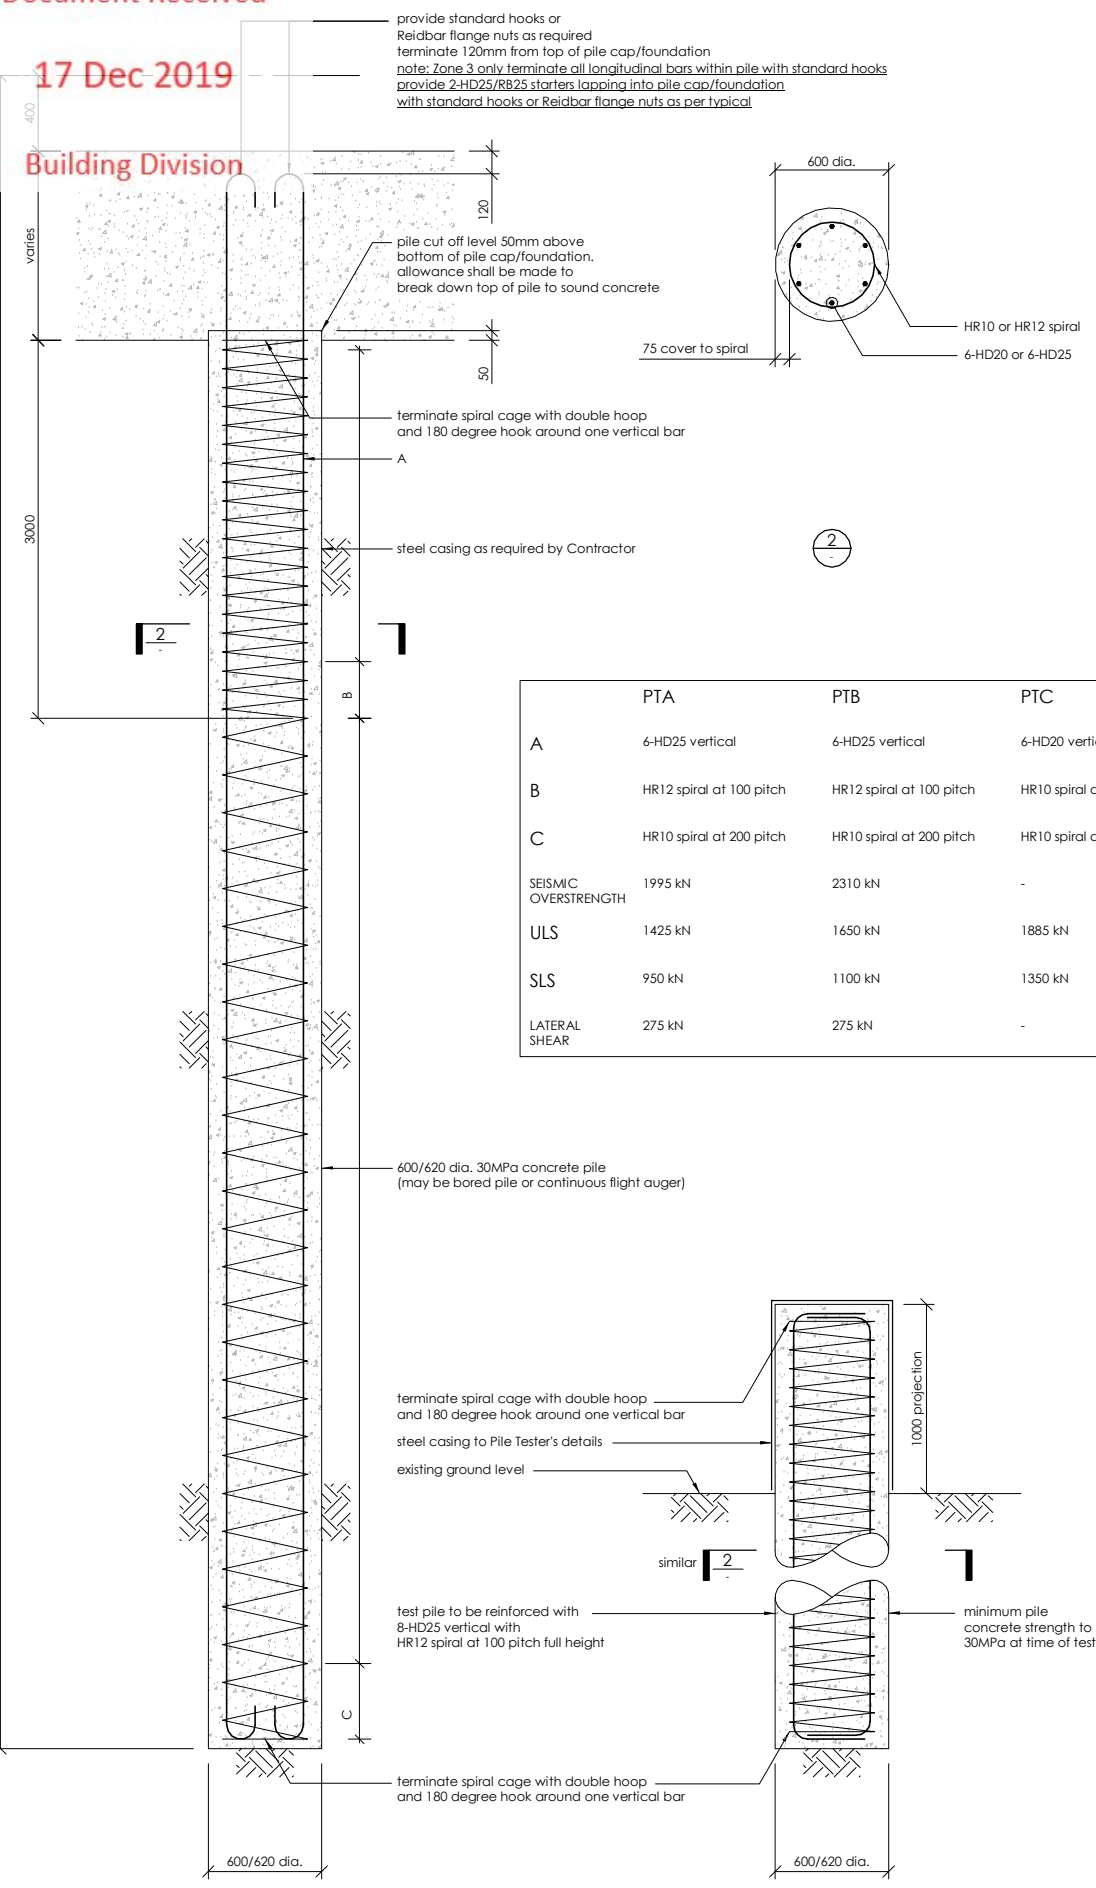


provide standard hooks or Rebar flange nuts as required terminate 120mm from top of pile cap/foundation
note: Zone 3 only terminate all longitudinal bars within pile with standard hooks provide 2-HD25/RB25 starters lapping into pile cap/foundation with standard hooks or Rebar flange nuts as per typical

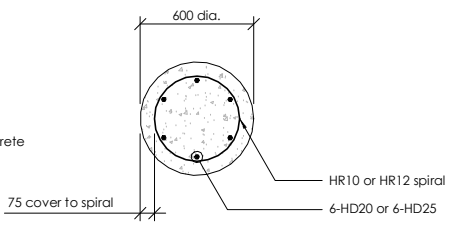

	PTA	PTB	PTC	PTD	PTE
A	6-HD25 vertical	6-HD25 vertical	6-HD20 vertical	6-HD20 vertical	6-HD25 vertical
B	HR12 spiral at 100 pitch	HR12 spiral at 100 pitch	HR10 spiral at 100 pitch	HR12 spiral at 100 pitch	HR12 spiral at 100 pitch
C	HR10 spiral at 200 pitch	HR10 spiral at 200 pitch	HR10 spiral at 200 pitch	HR10 spiral at 200 pitch	HR10 spiral at 200 pitch
SEISMIC OVERSTRENGTH	1995 kN	2310 kN	-	1205 kN	1205 kN
ULS	1425 kN	1650 kN	1885 kN	870 kN	870 kN
SLS	950 kN	1100 kN	1350 kN	575 kN	575 kN
LATERAL SHEAR	275 kN	275 kN	-	275 kN	275 kN

600/620 dia. 30MPa concrete pile (may be bored pile or continuous flight auger)

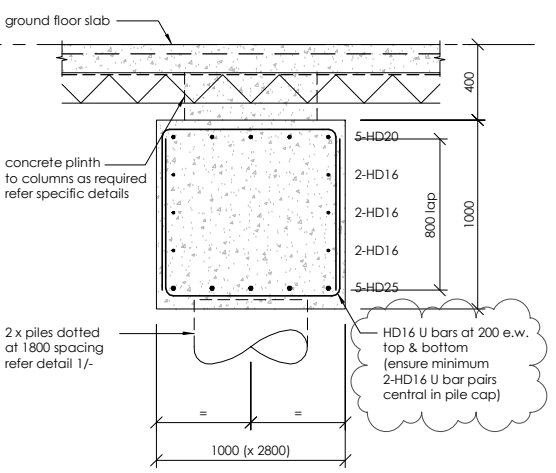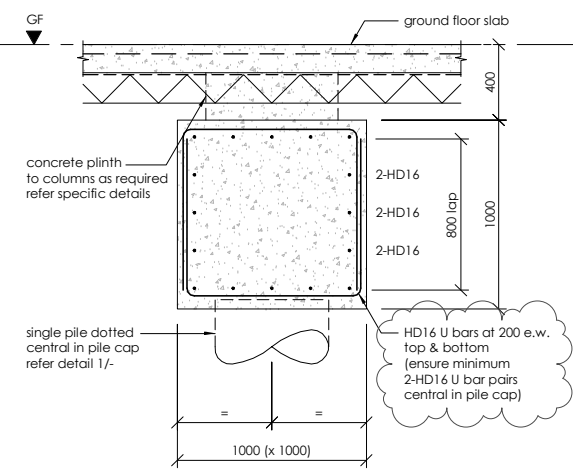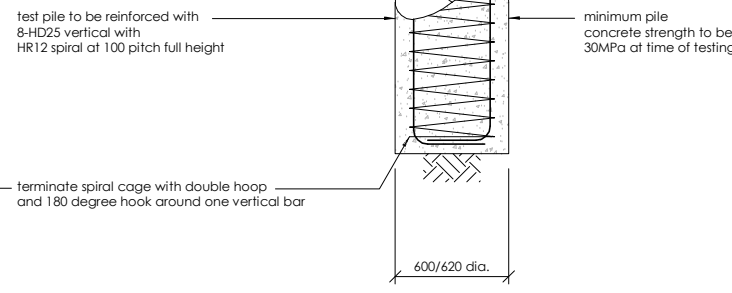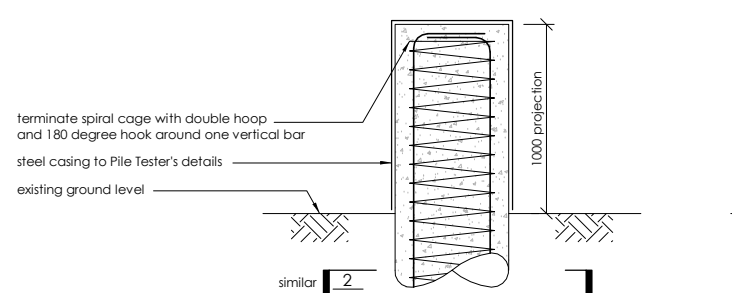

- PILING NOTES:**
- steel casing: provide temporary steel casing as required to maintain bore hole stability (minimum 300mm deep casing at top to prevent contamination at top of pile)
 - the pile base shall be clean of loose material and debris to ensure that the Design Strength can be mobilised
 - ensure correct cover to spiral cage is maintained with spacers as required to side of excavation
 - all pile starters to be caged inwards as shown to avoid clashes between hooks and hold-down bolts to columns over. use Rebar flange nuts as required to avoid concrete wall/column reinforcing and/or hold-down bolts to columns over
 - concrete shall be placed to avoid formation of voids caused by entrapped air, lack of compaction or segregation
 - concrete shall be placed in such a manner that correct position of reinforcing is maintained
 - bored piles shall be concreted on the same day they are formed unless the excavation is protected by a temporary liner
 - all bored piles shall comply with AS2159
 - bored pile depths shown are approximate and shall be verified by the Geotechnical Engineer on site. Contractor to make adequate allowances for variations in bored pile depths
 - Contractor to provide Driller's Log of excavated material for review and acceptance by the Geotechnical Engineer for approval prior to the placement of the reinforcing cage unless otherwise agreed in writing
 - refer also to Geotechnical Engineer's documentation for further information and details regarding Piling Specification and installation requirements
 - refer also to Structural Specification sections: Concrete General, Reinforcement & Piling

Invercargill City Council
Building Consent Authority
Approved Site Copy

Approved For Issue
27/02/2020

REV	DATE	AMENDMENT	BY
2	23.10.19	CONSENT ISSUE	GPW
1	27.09.19	PEER REVIEW ISSUE	GPW

CLIENT:
HWCP

lewis bradford
CONSULTING ENGINEERS

PROJECT:
INVERCARGILL CENTRAL ZONE 1 ANCHOR

DRAWING TITLE:
GROUND FLOOR / FOUNDATION PILE DETAILS

DRAWN: GPW	SCALE: 1 : 20 at A1
ENGINEER: EL/TSS	
CHECKED: -	
118083-Z1-WD-ST 5000	REV. 2

17 Dec 2019

Building Division

BUILDING CONSENT NUMBER
2019/1381


THIS DRAWING AND ALL INFORMATION CONTAINED WITHIN IS THE PROPERTY OF LEWIS BRADFORD. ITS CONTENTS ARE CONFIDENTIAL AND MUST NOT BE REPRODUCED OR DISTRIBUTED TO ANY OTHER PERSON OR COMPANY UNLESS AGREED TO IN WRITING BY LEWIS BRADFORD

CONTRACTOR TO VERIFY ALL DIMENSIONS ON SITE REFER TO ARCHITECT'S DRAWING FOR ALL SETOUTS

NOTES:
Refer drawing 0002 for standard notes. Refer also to Structural Specification.


Invercargill City Council
Building Consent Authority
Approved Site Copy

Approved For Issue
27/02/2020

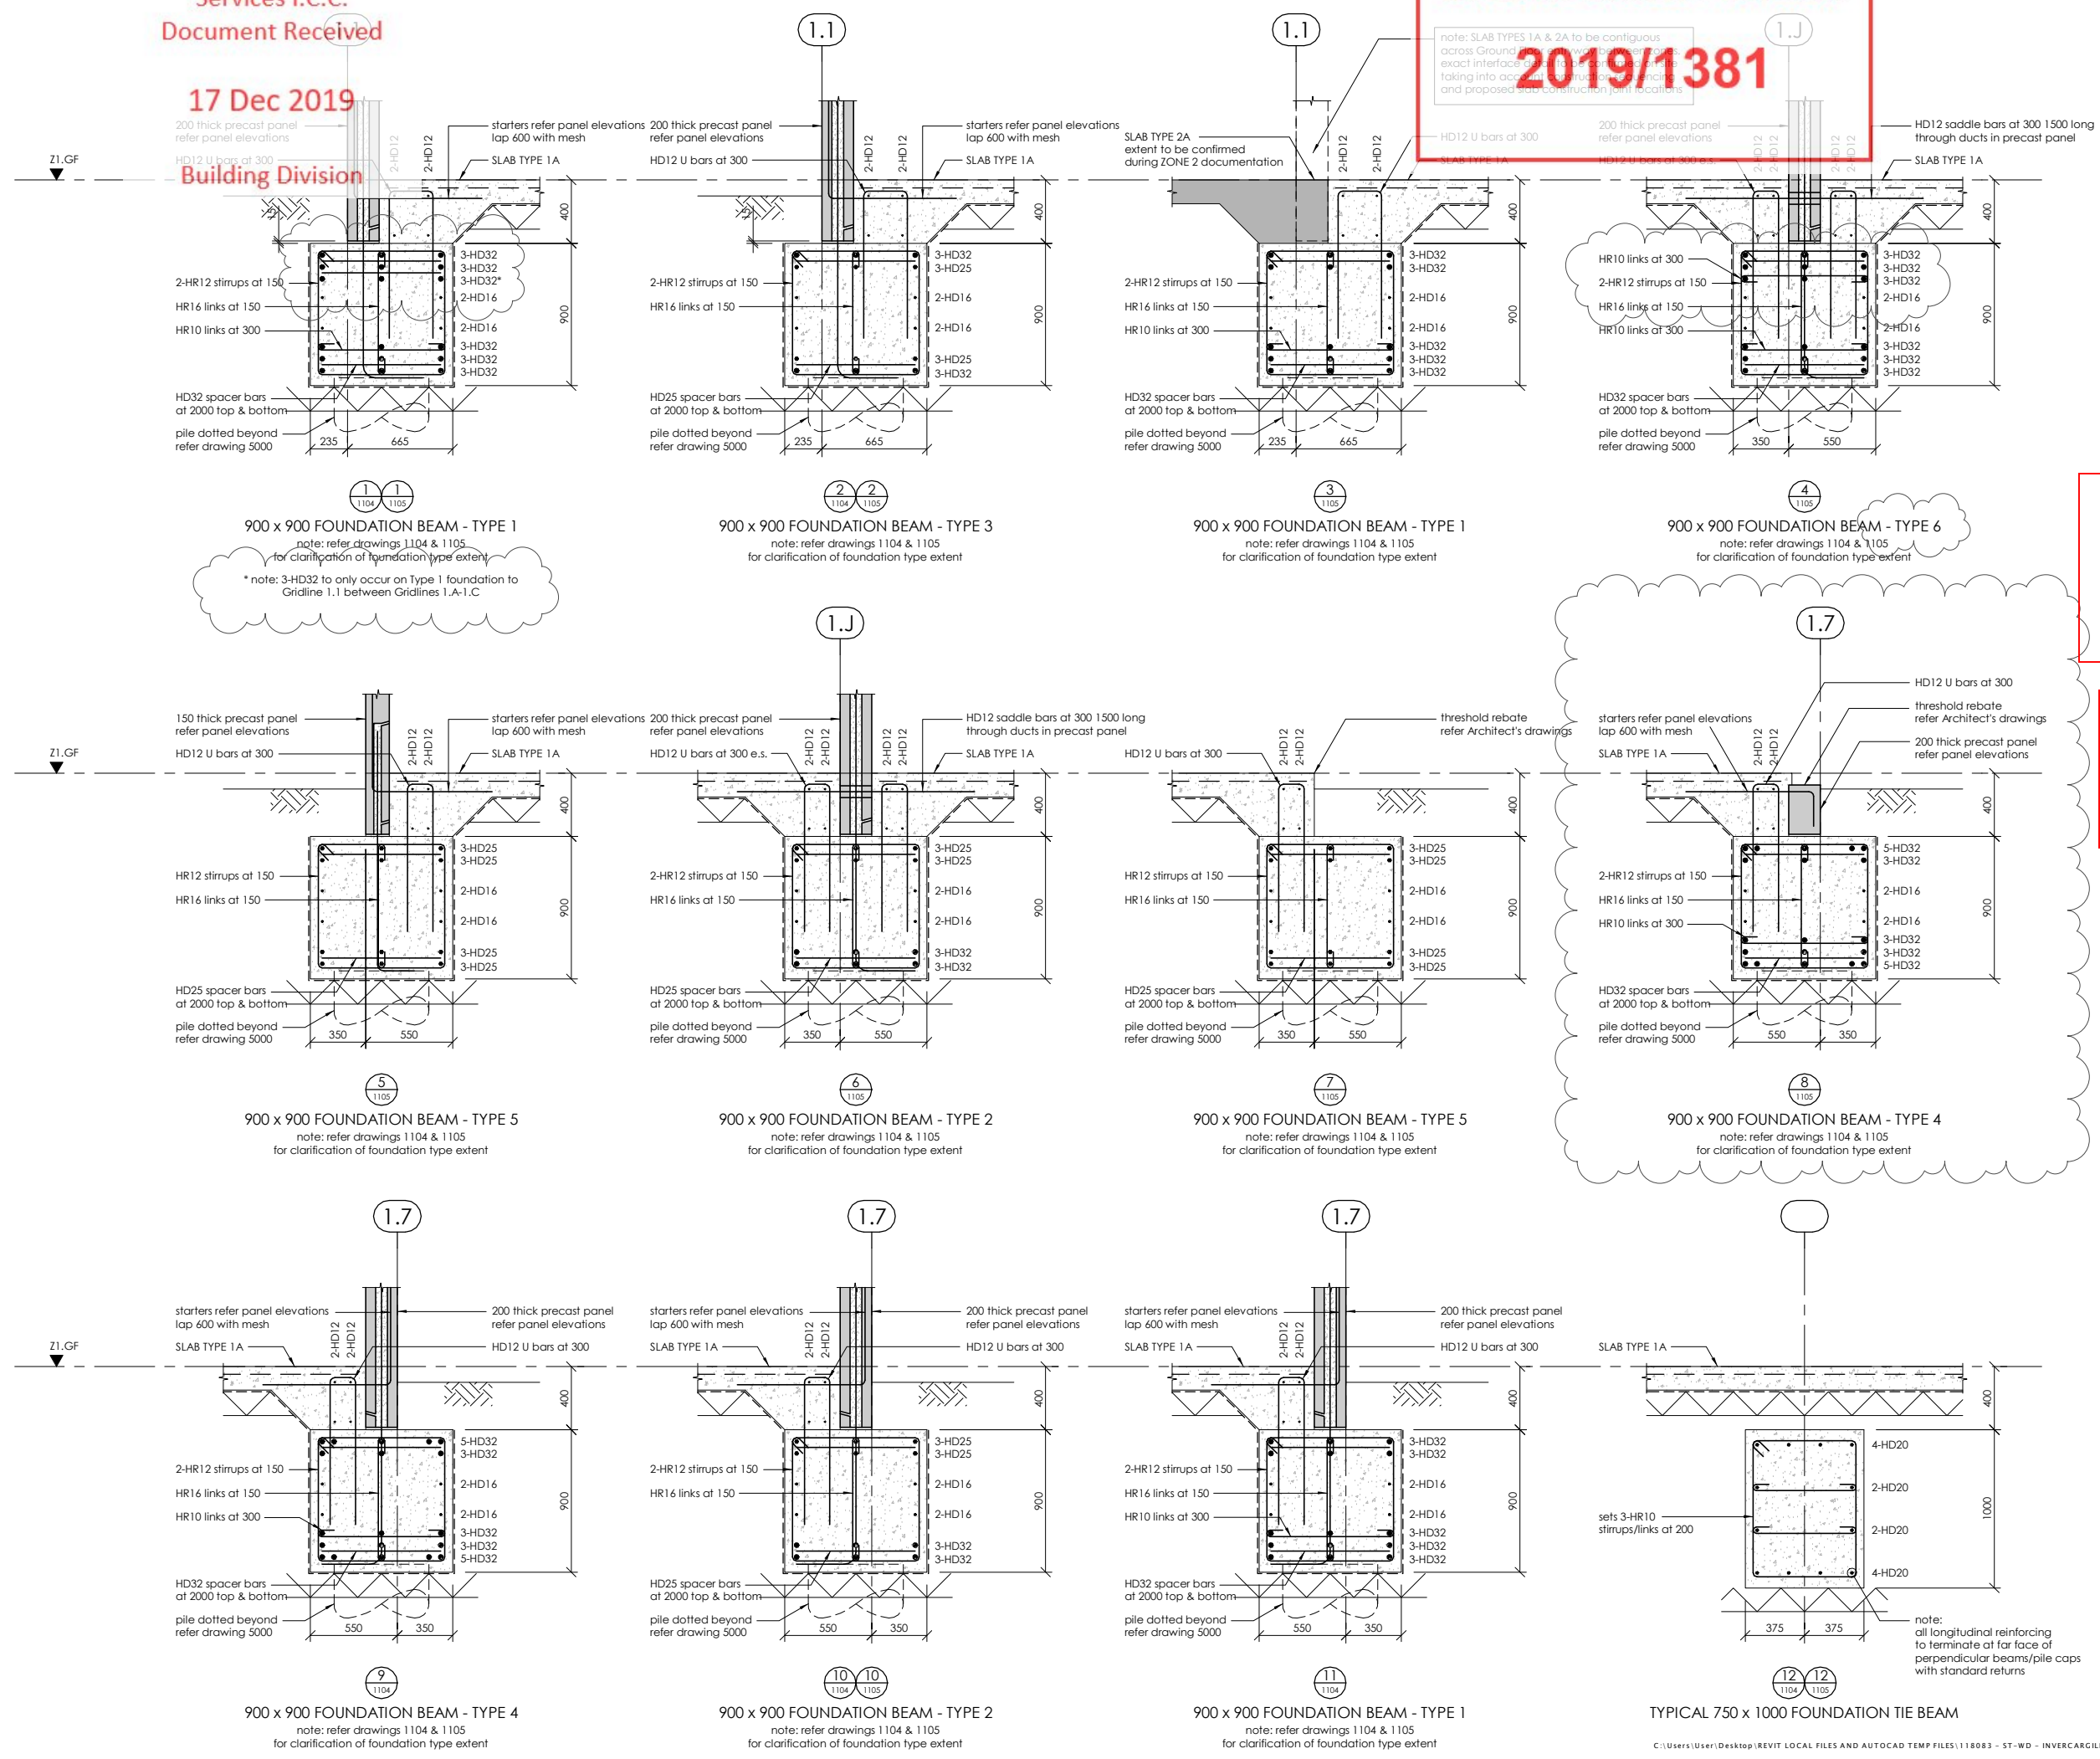

REV	DATE	AMENDMENT	BY
2	25.10.19	CONSENT ISSUE	GPW
1	27.09.19	PEER REVIEW ISSUE	GPW

CLIENT:
HWCP

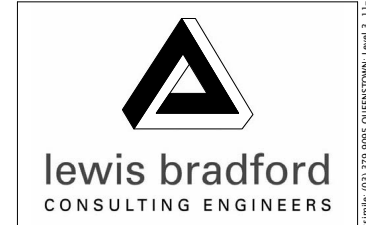

PROJECT:
INVERCARGILL CENTRAL ZONE 1 ANCHOR

DRAWING TITLE:
GROUND FLOOR / FOUNDATION DETAILS SHEET 1

DRAWN: GPW
ENGINEER: EL/TSS
CHECKED: -
SCALE: 1 : 20 at A1

118083-Z1-WD-ST 5010
REV. 2

17 Dec 2019

225 thick precast panel
refer panel elevations

Building Division

BUILDING CONSENT NUMBER
2019/1381

THIS DRAWING AND ALL INFORMATION CONTAINED WITHIN IS THE PROPERTY OF LEWIS BRADFORD. ITS CONTENTS ARE CONFIDENTIAL AND MUST NOT BE REPRODUCED OR DISTRIBUTED TO ANY OTHER PERSON OR COMPANY UNLESS AGREED TO IN WRITING BY LEWIS BRADFORD

CONTRACTOR TO VERIFY ALL DIMENSIONS ON SITE REFER TO ARCHITECT'S DRAWING FOR ALL SETOUTS


NOTES:
Refer drawing 0002 for standard notes.
Refer also to Structural Specification.

Invercargill City
Council
Building Consent
Authority
Approved Site Copy

Approved For Issue
27/02/2020

REV	DATE	AMENDMENT	BY
2	25.10.19	CONSENT ISSUE	GPW
1	27.09.19	PEER REVIEW ISSUE	GPW


CLIENT:

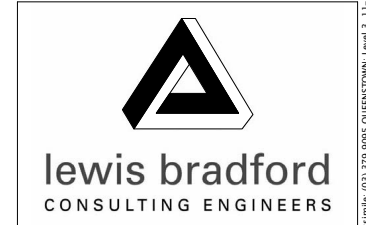

PROJECT:
**INVERCARGILL CENTRAL
ZONE 1 ANCHOR**

DRAWING TITLE:
**GROUND FLOOR /
FOUNDATION
DETAILS
SHEET 2**

DRAWN: GPW	SCALE: 1 : 20 at A1
ENGINEER: EL/TSS	
CHECKED: -	
118083-Z1-WD-ST 5011	REV. 2

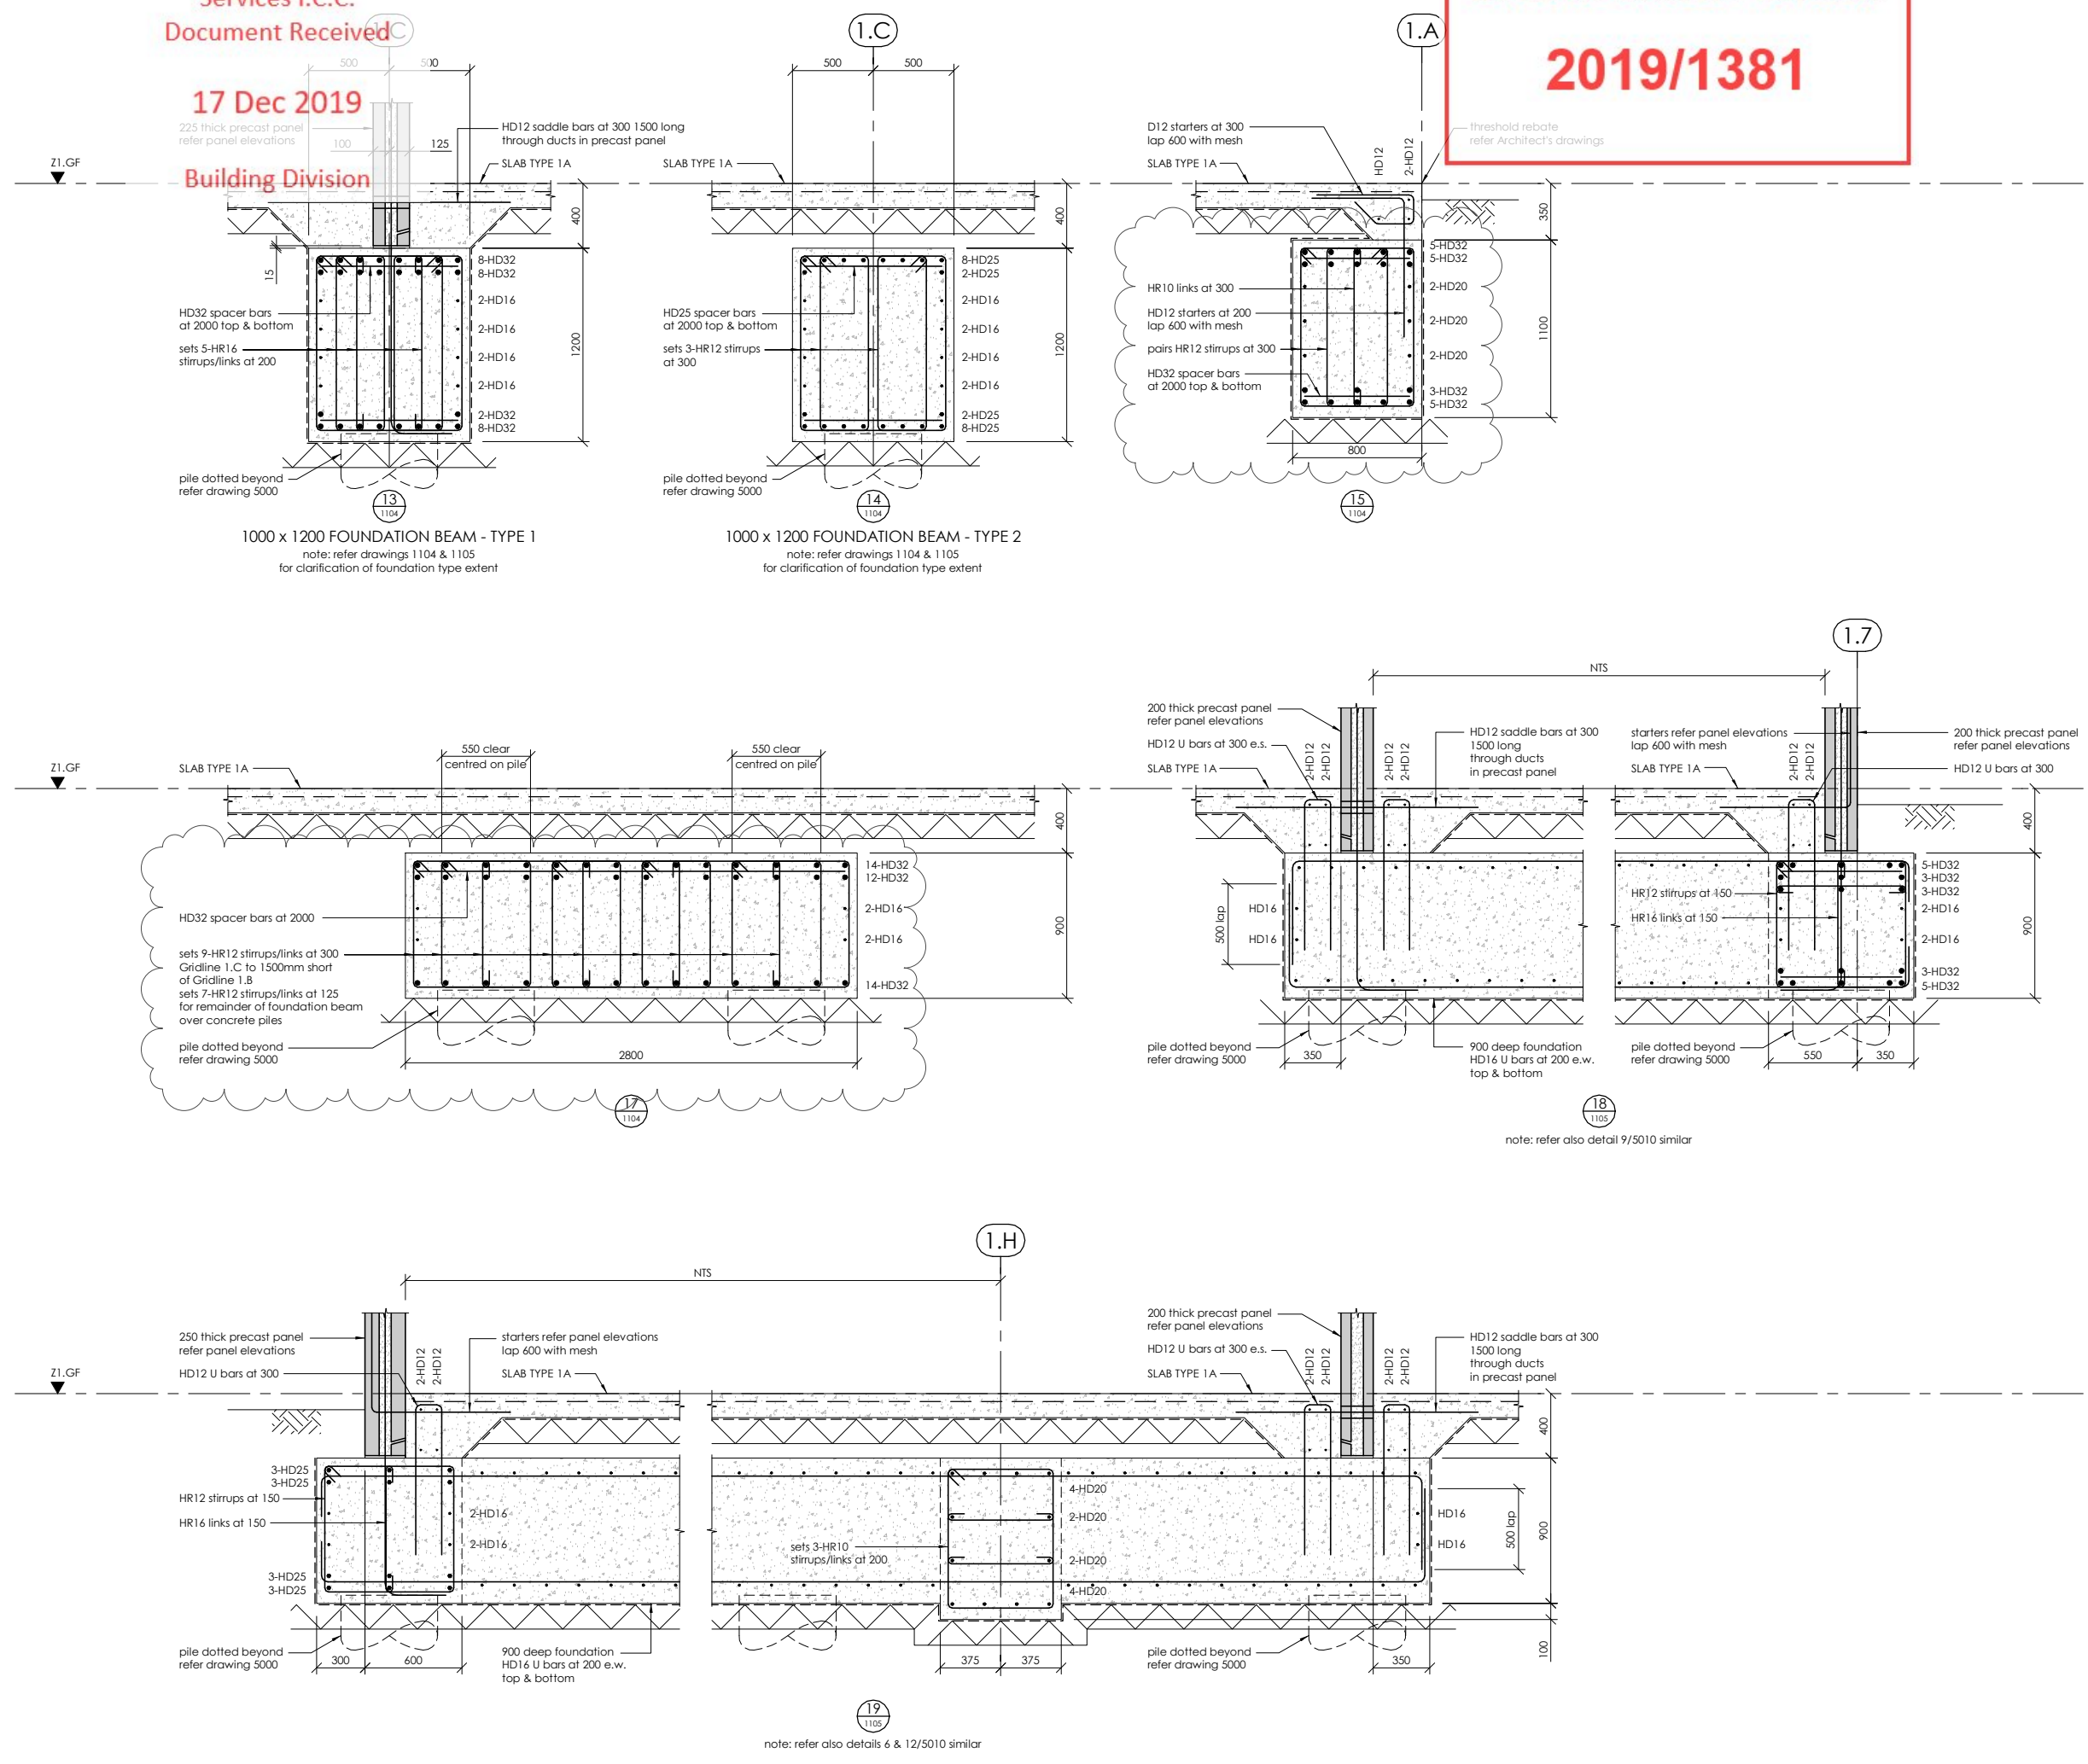

17 Dec 2019

Building Division

BUILDING CONSENT NUMBER
1.5
2019/1381


THIS DRAWING AND ALL INFORMATION CONTAINED WITHIN IS THE PROPERTY OF LEWIS BRADFORD. ITS CONTENTS ARE CONFIDENTIAL AND MUST NOT BE REPRODUCED OR DISTRIBUTED TO ANY OTHER PERSON OR COMPANY UNLESS AGREED TO IN WRITING BY LEWIS BRADFORD

CONTRACTOR TO VERIFY ALL DIMENSIONS ON SITE REFER TO ARCHITECT'S DRAWING FOR ALL SETOUTS

NOTES:
Refer drawing 0002 for standard notes. Refer also to Structural Specification.

Invercargill City Council
Building Consent Authority
Approved Site Copy

Approved For Issue
27/02/2020

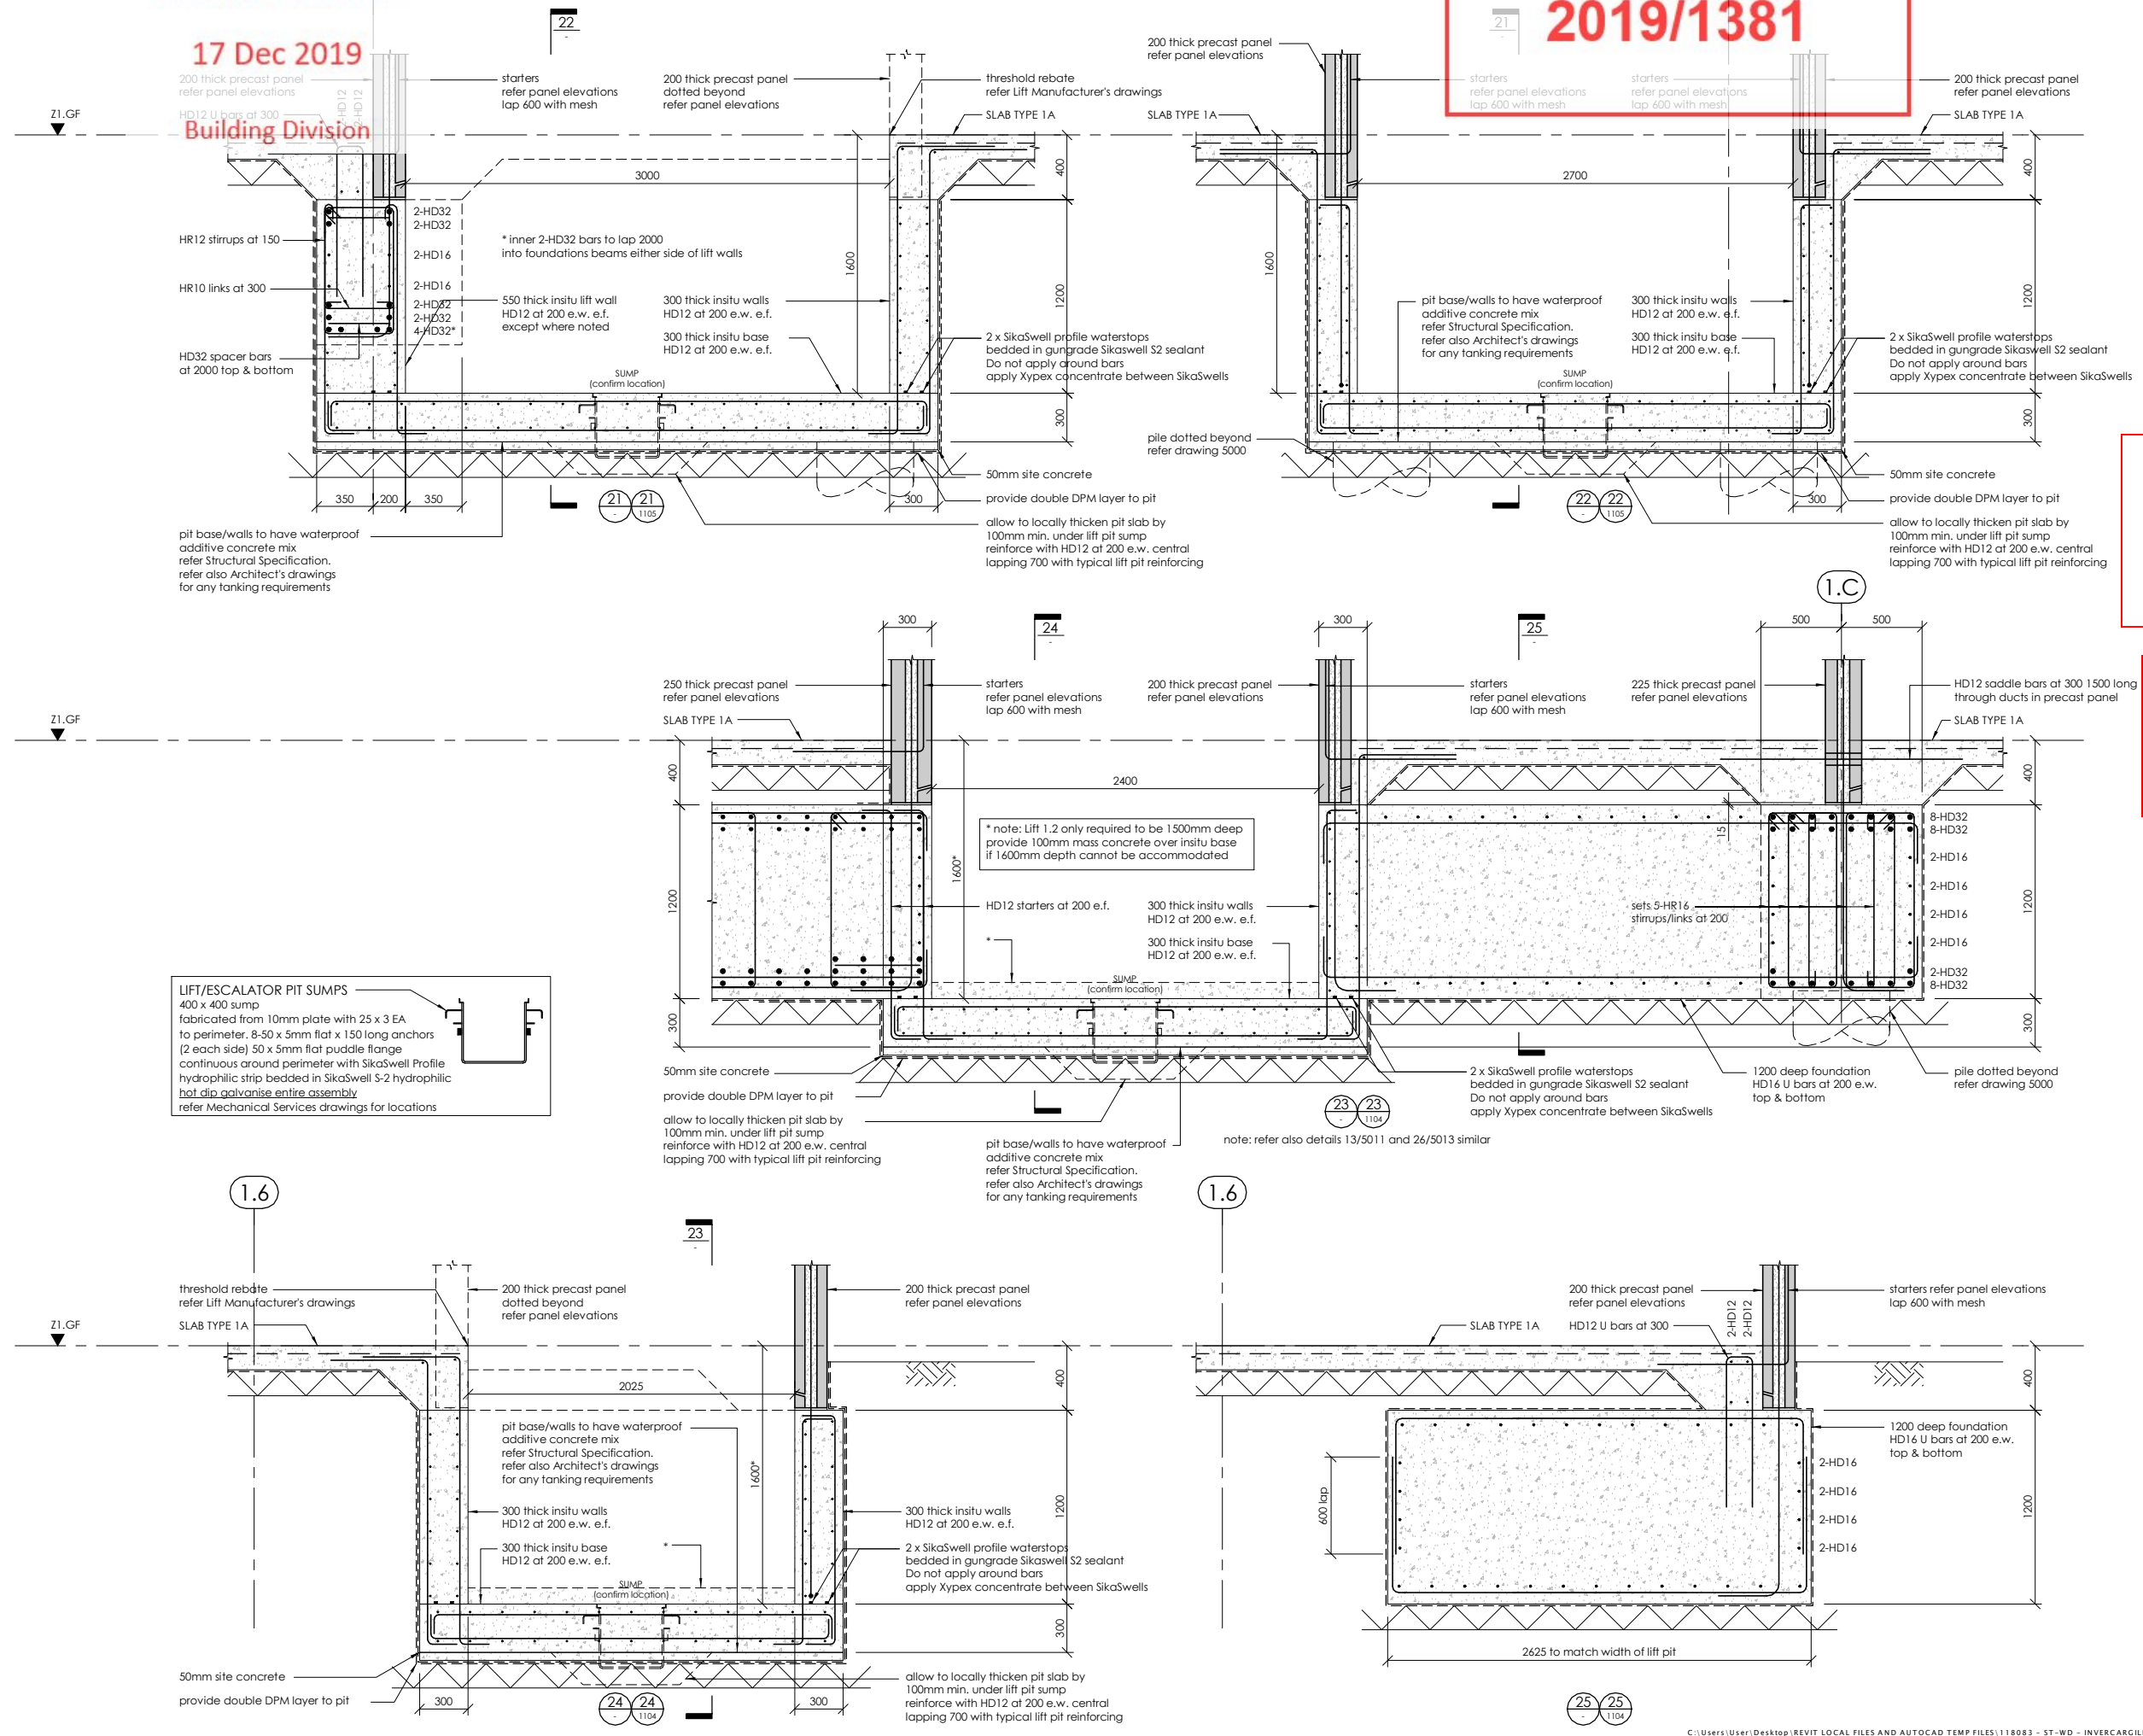

LIFT/ESCALATOR PIT SUMPS
400 x 400 sump fabricated from 10mm plate with 25 x 3 EA to perimeter. 8-50 x 5mm flat x 150 long anchors (2 each side) 50 x 5mm flat puddle flange continuous around perimeter with SikaWell Profile hydrophilic strip bedded in SikaWell S-2 hydrophilic hot dip galvanise entire assembly refer Mechanical Services drawings for locations

REV	DATE	AMENDMENT	BY
2	25.10.19	CONSENT ISSUE	GPW
1	27.09.19	PEER REVIEW ISSUE	GPW

CLIENT:
HWCP

lewis bradford
CONSULTING ENGINEERS

PROJECT:
INVERCARGILL CENTRAL ZONE 1 ANCHOR

DRAWING TITLE:
GROUND FLOOR / FOUNDATION DETAILS SHEET 3

DRAWN: GPW	SCALE: 1 : 20 at A1
ENGINEER: EL/TSS	
CHECKED: -	
118083-Z1-WD-ST 5012	REV. 2

17 Dec 2019

Building Division

BUILDING CONSENT NUMBER

2019/1381

THIS DRAWING AND ALL INFORMATION CONTAINED WITHIN IS THE PROPERTY OF LEWIS BRADFORD. ITS CONTENTS ARE CONFIDENTIAL AND MUST NOT BE REPRODUCED OR DISTRIBUTED TO ANY OTHER PERSON OR COMPANY UNLESS AGREED TO IN WRITING BY LEWIS BRADFORD





CONTRACTOR TO VERIFY ALL DIMENSIONS ON SITE REFER TO ARCHITECT'S DRAWING FOR ALL SETOUTS

NOTES:

Refer drawing 0002 for standard notes. Refer also to Structural Specification.

Invercargill City Council
Building Consent Authority
Approved Site Copy

Approved For Issue
27/02/2020

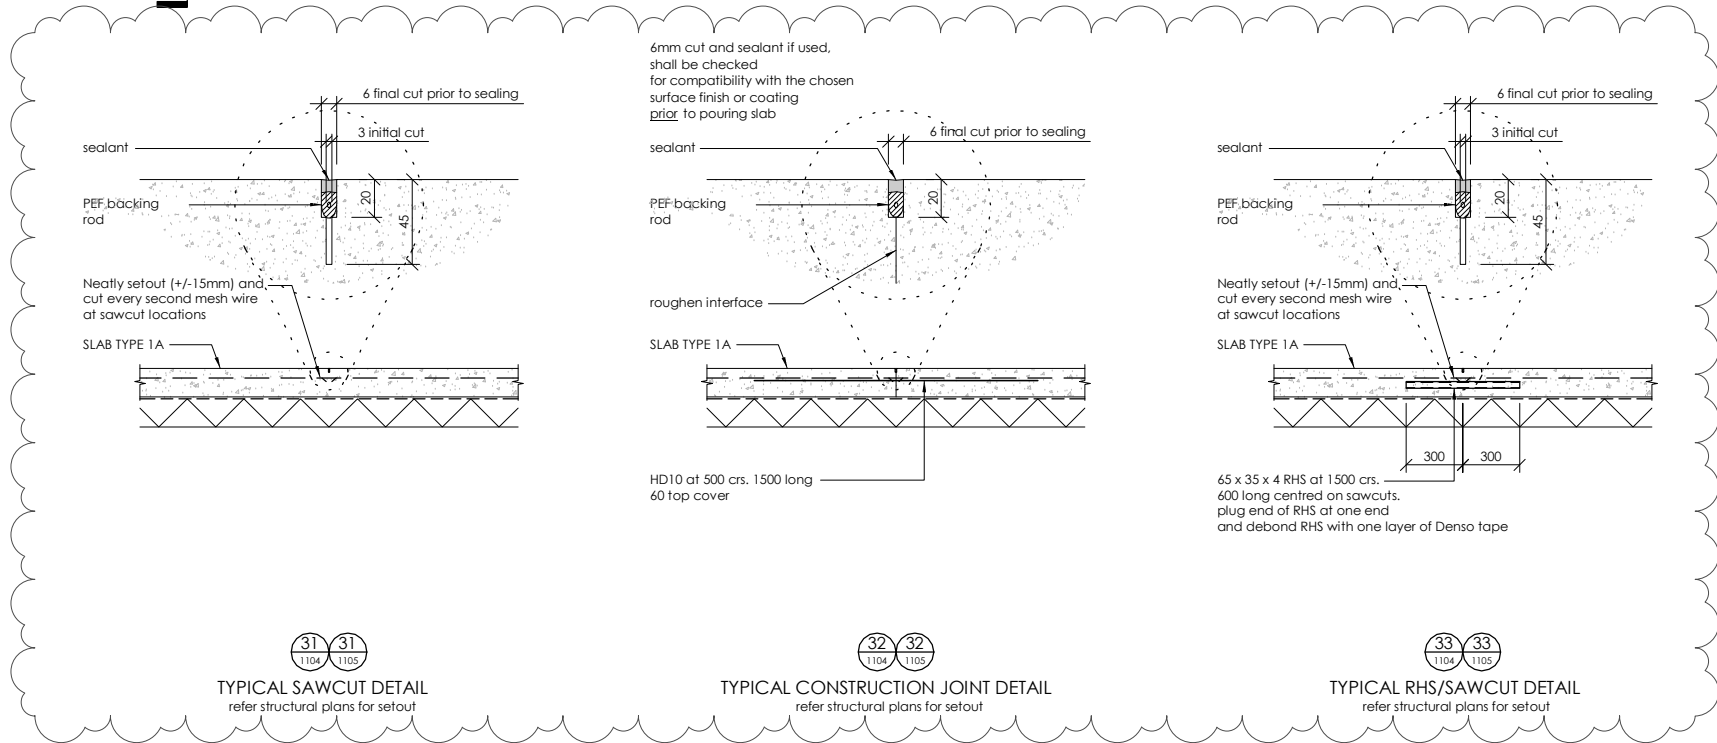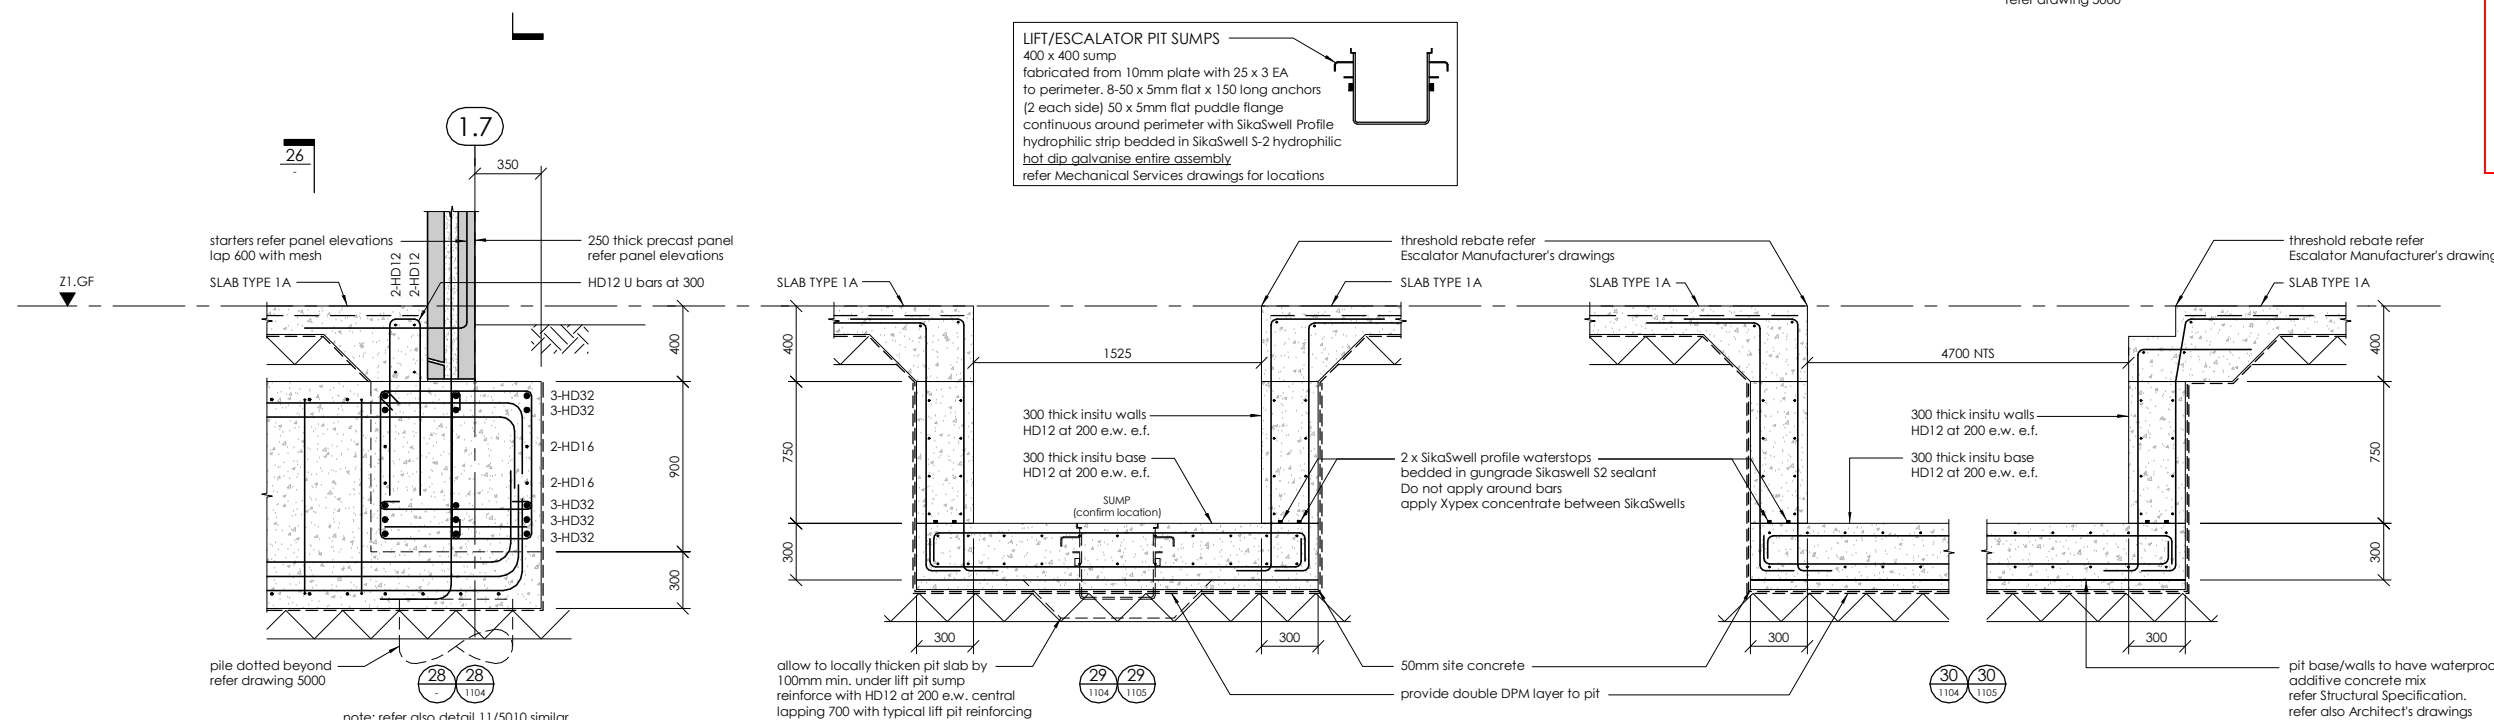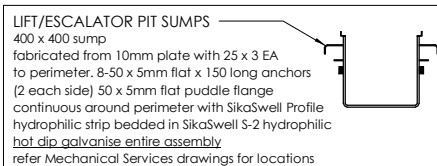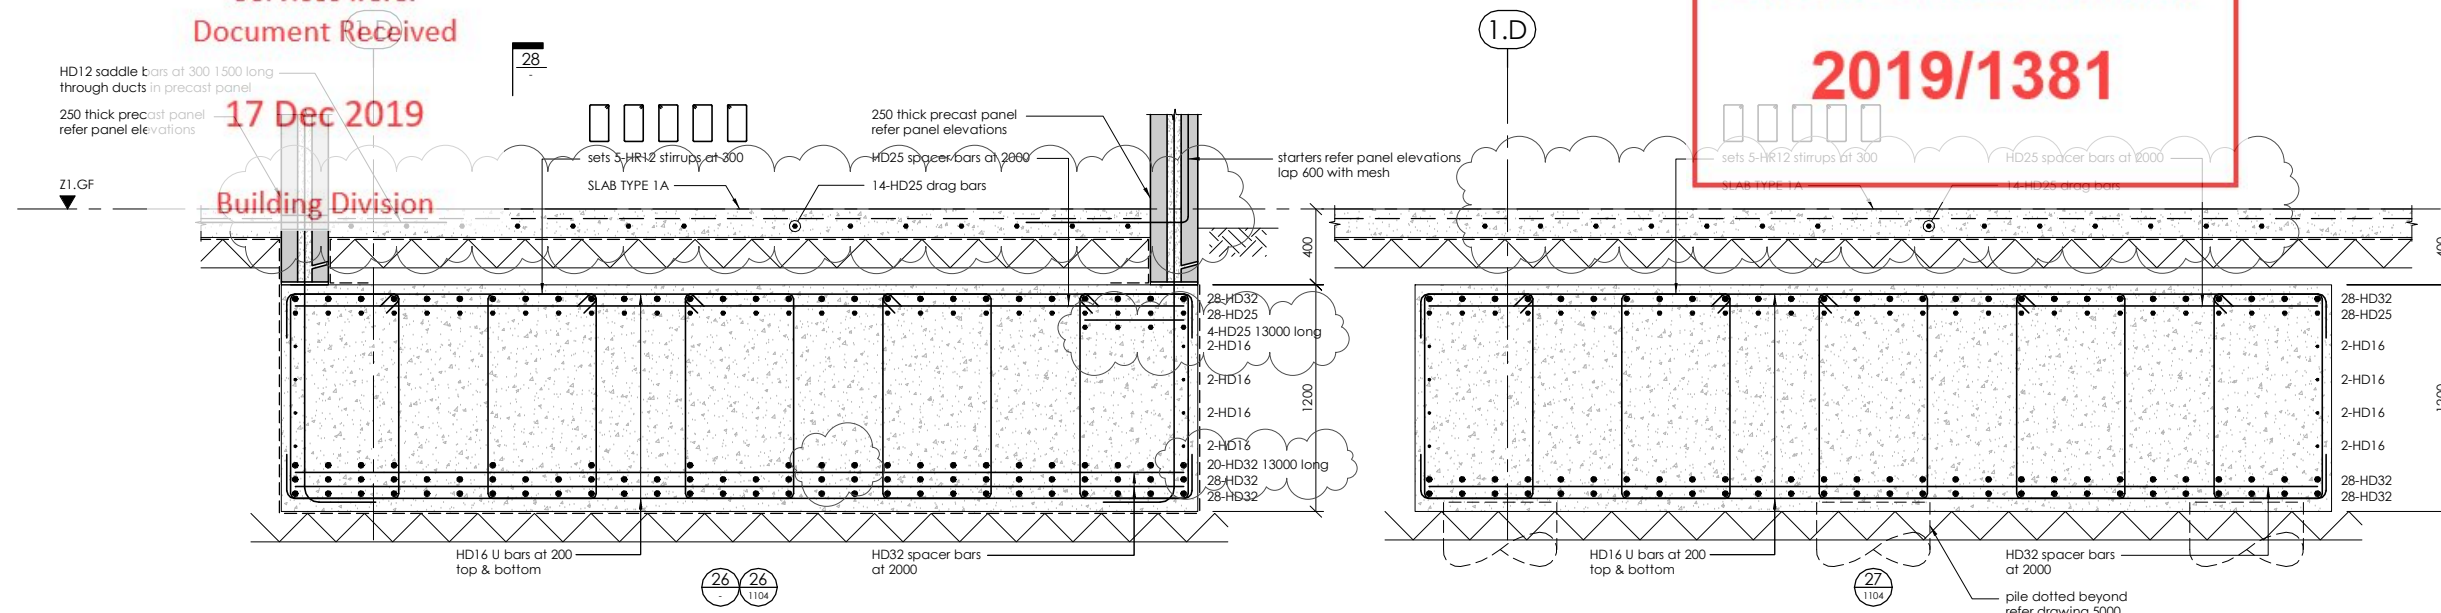

REV	DATE	AMENDMENT	BY
2	25.10.19	CONSENT ISSUE	GPW
1	27.09.19	PEER REVIEW ISSUE	GPW

CLIENT:
HWCP

lewis bradford
CONSULTING ENGINEERS

PROJECT:
**INVERCARGILL CENTRAL
ZONE 1 ANCHOR**

DRAWING TITLE:
**GROUND FLOOR /
FOUNDATION
DETAILS
SHEET 4**

DRAWN: GPW
ENGINEER: EL/TSS
CHECKED: -
SCALE: 1 : 20 at A1
118083-Z1-WD-ST 5013
REV. 2

17 Dec 2019

Building Division

BUILDING CONSENT NUMBER
2019/1381

THIS DRAWING AND ALL INFORMATION CONTAINED WITHIN IS THE PROPERTY OF LEWIS BRADFORD. ITS CONTENTS ARE CONFIDENTIAL AND MUST NOT BE REPRODUCED OR DISTRIBUTED TO ANY OTHER PERSON OR COMPANY UNLESS AGREED TO IN WRITING BY LEWIS BRADFORD


CONTRACTOR TO VERIFY ALL DIMENSIONS ON SITE REFER TO ARCHITECT'S DRAWING FOR ALL SETOUTS

NOTES:

Refer drawing 0002 for standard notes. Refer also to Structural Specification.

Invercargill City Council
Building Consent Authority
Approved Site Copy

Approved For Issue
27/02/2020

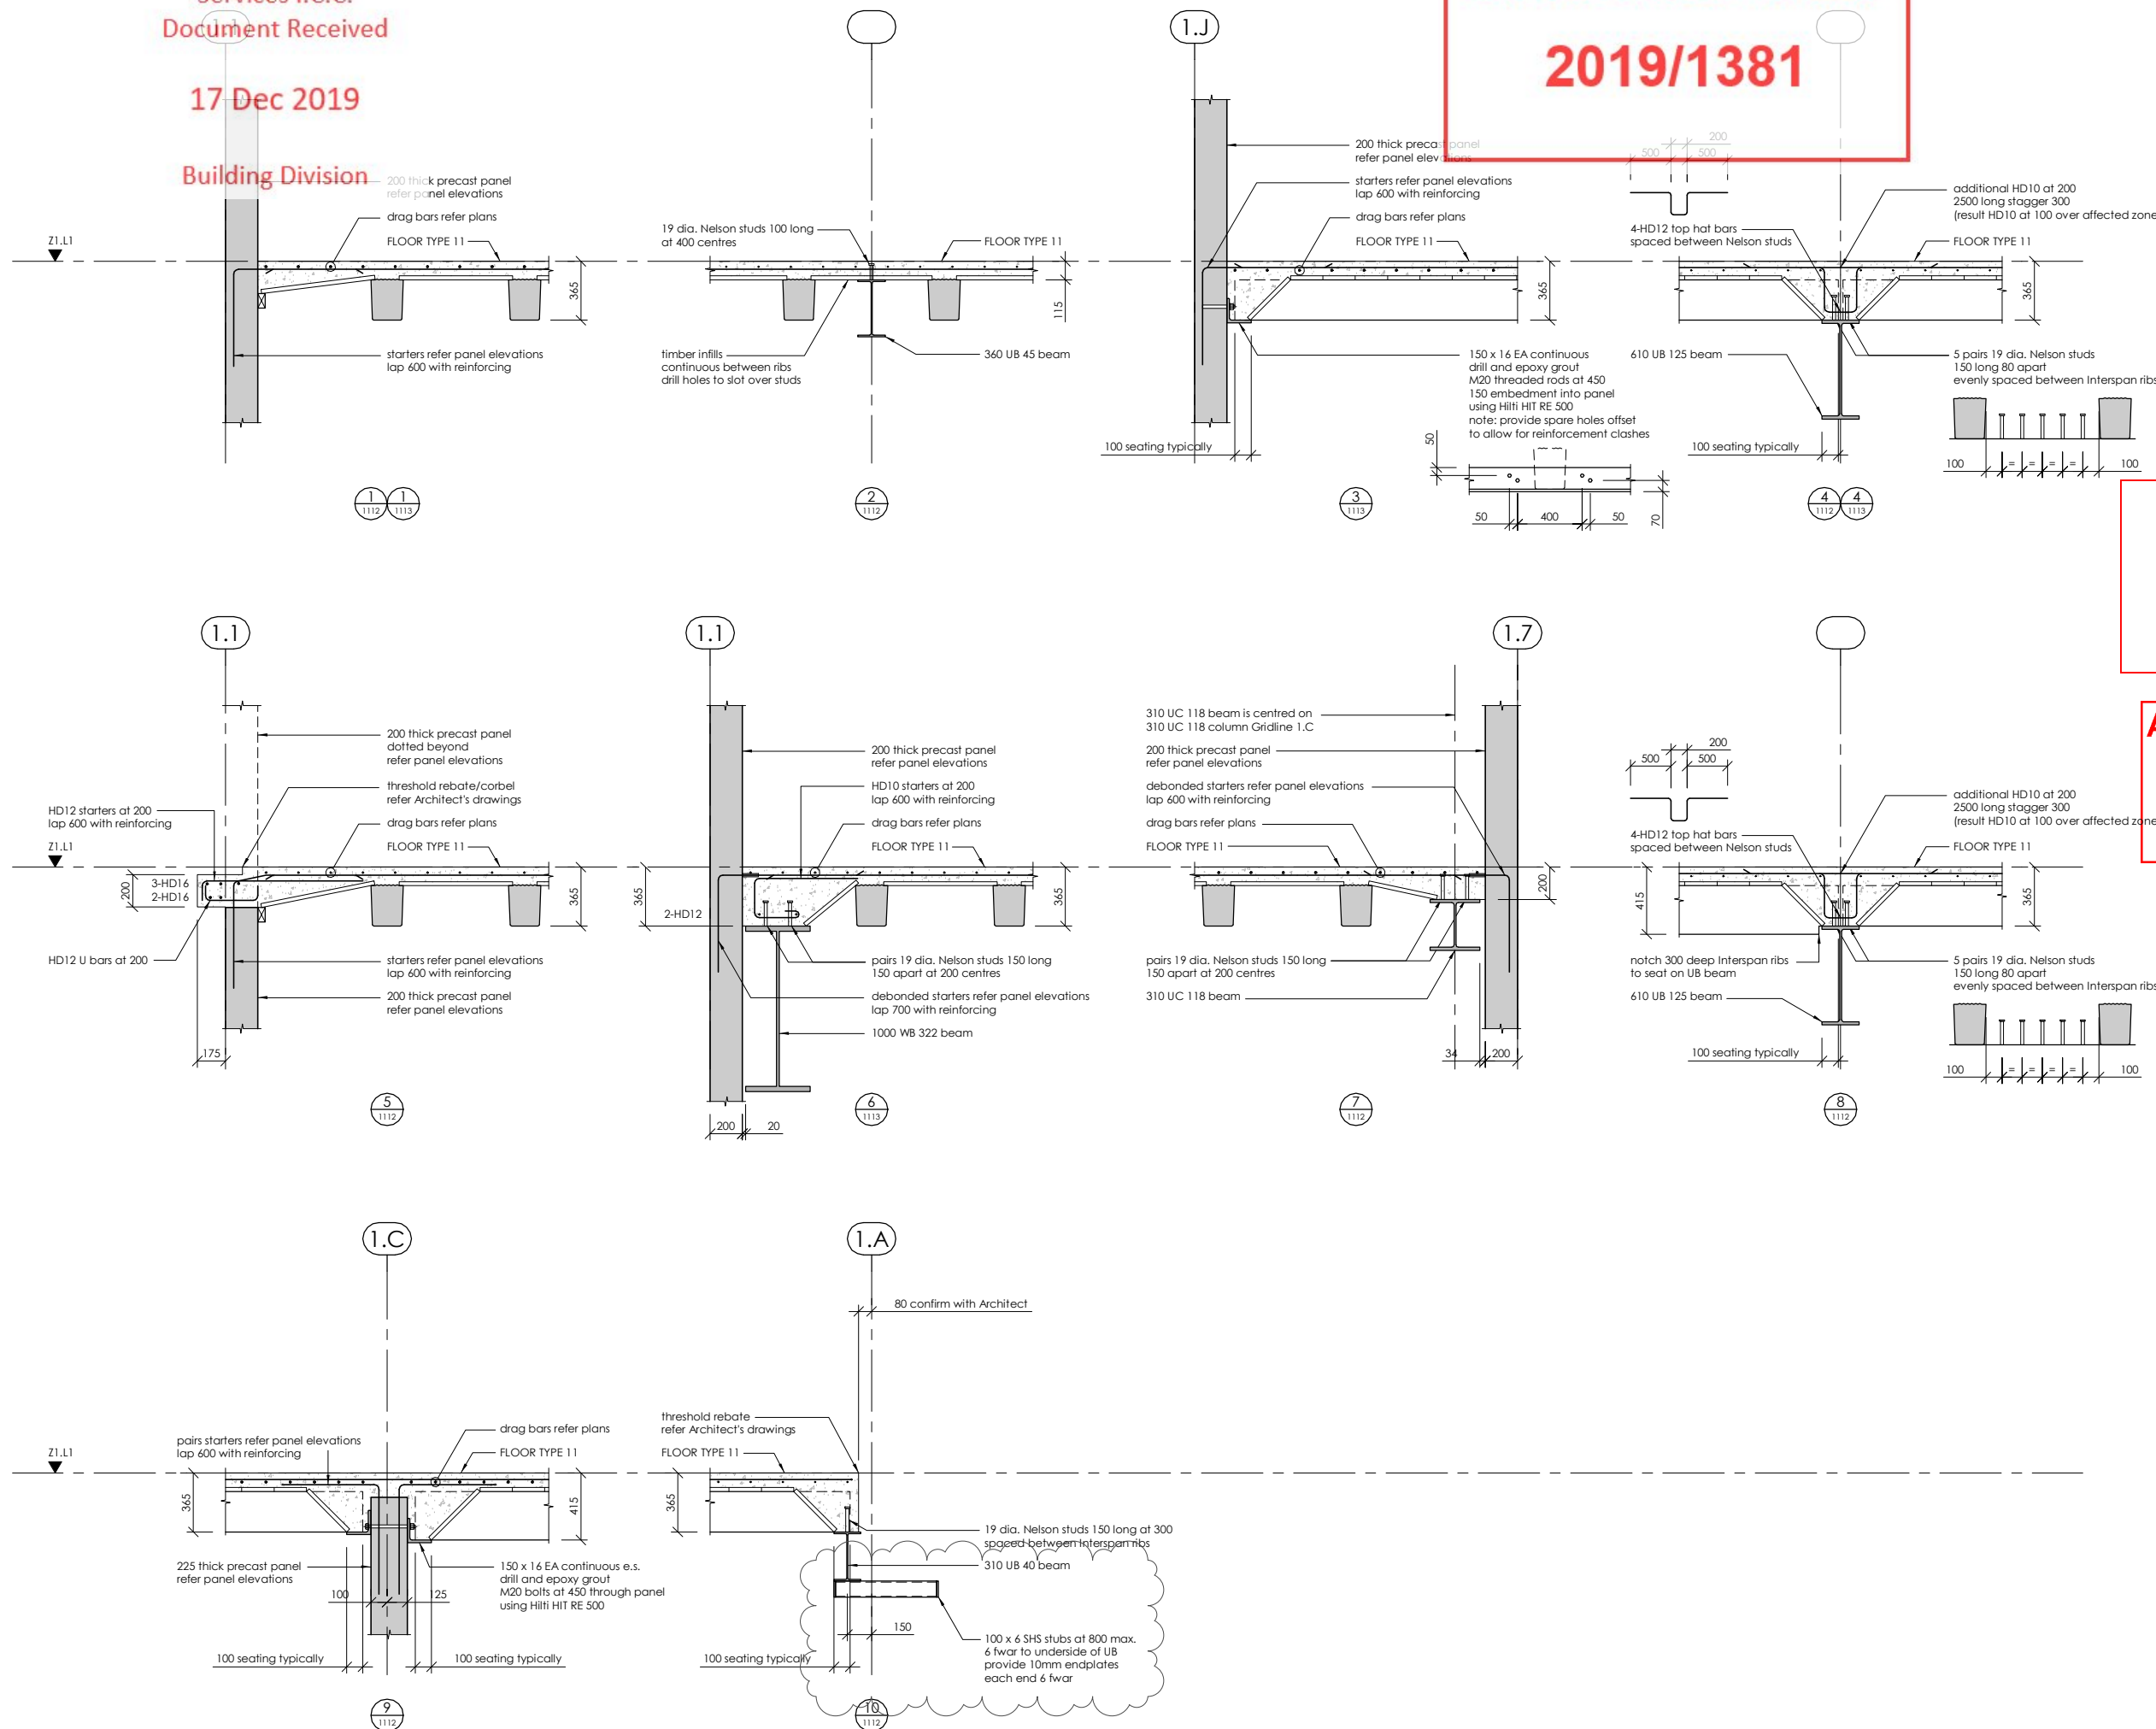

REV	DATE	AMENDMENT	BY
2	25.10.19	CONSENT ISSUE	GPW
1	27.09.19	PEER REVIEW ISSUE	GPW

CLIENT:
HWCP

lewis bradford
CONSULTING ENGINEERS

PROJECT:
**INVERCARGILL CENTRAL
ZONE 1 ANCHOR**

DRAWING TITLE:
**LEVEL 1
DETAILS
SHEET 1**

DRAWN: GPW
ENGINEER: EL/TSS
CHECKED: -
SCALE: 1 : 20 at A1
118083-Z1-WD-ST 5110
REV. 2

17 Dec 2019




Building Division

BUILDING CONSENT NUMBER
2019/1381

THIS DRAWING AND ALL INFORMATION CONTAINED WITHIN IS THE PROPERTY OF LEWIS BRADFORD. ITS CONTENTS ARE CONFIDENTIAL AND MUST NOT BE REPRODUCED OR DISTRIBUTED TO ANY OTHER PERSON OR COMPANY UNLESS AGREED TO IN WRITING BY LEWIS BRADFORD

CONTRACTOR TO VERIFY ALL DIMENSIONS ON SITE REFER TO ARCHITECT'S DRAWING FOR ALL SETOUTS

NOTES:
Refer drawing 0002 for standard notes.
Refer also to Structural Specification.

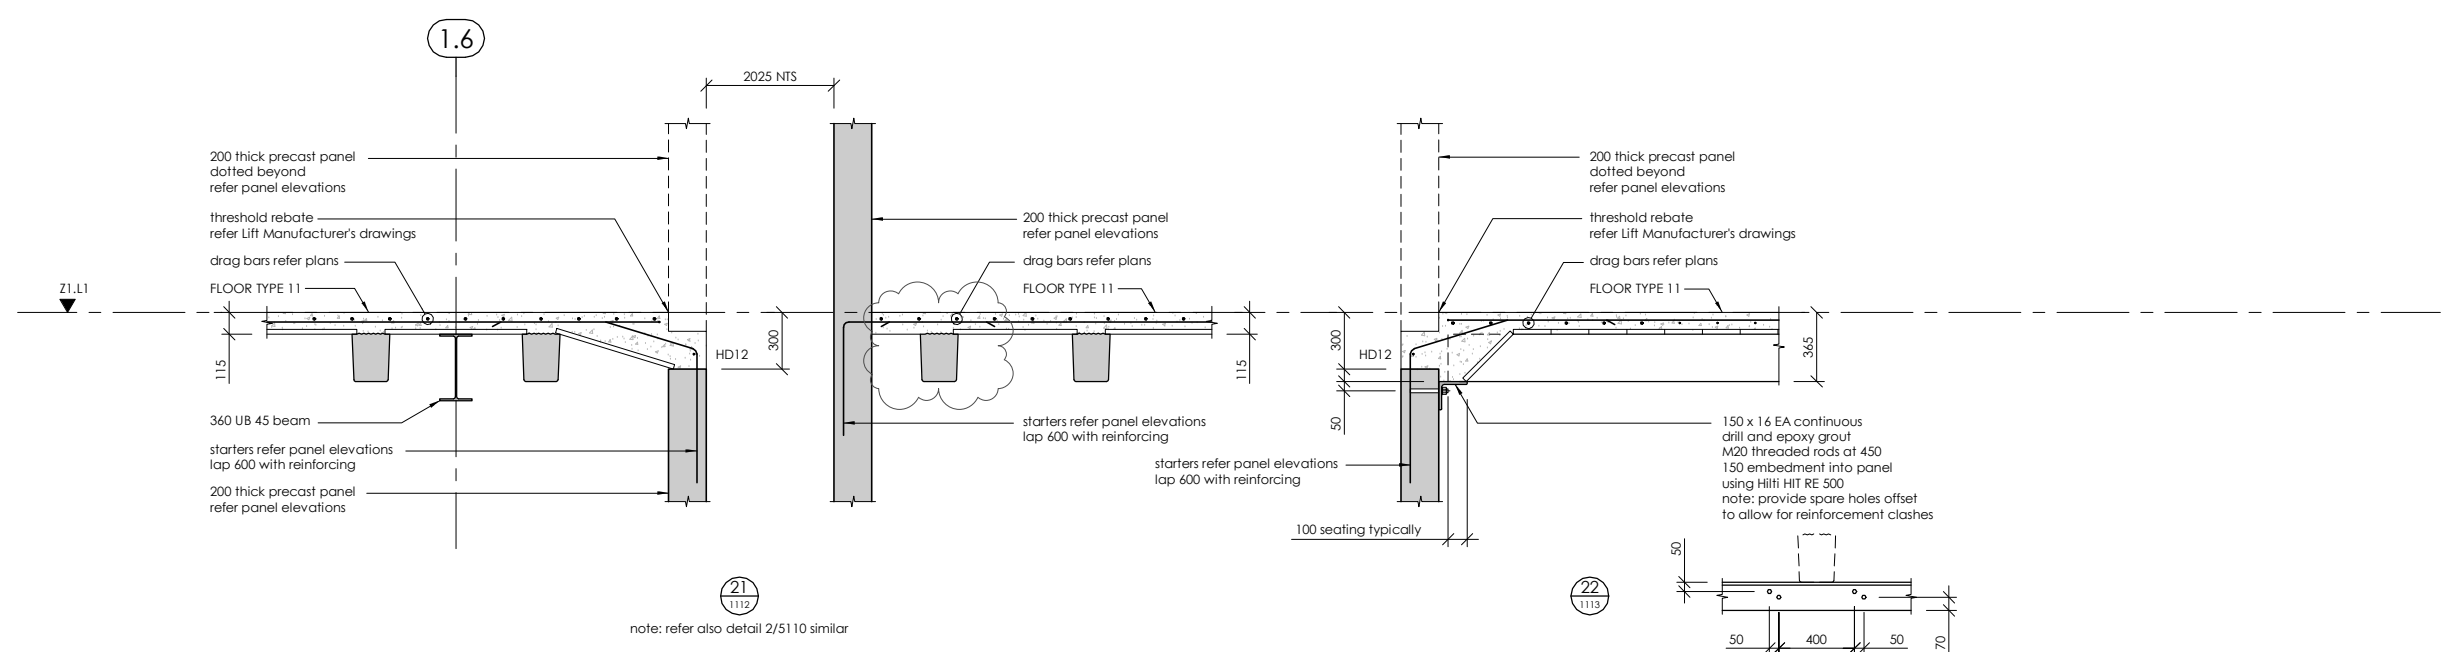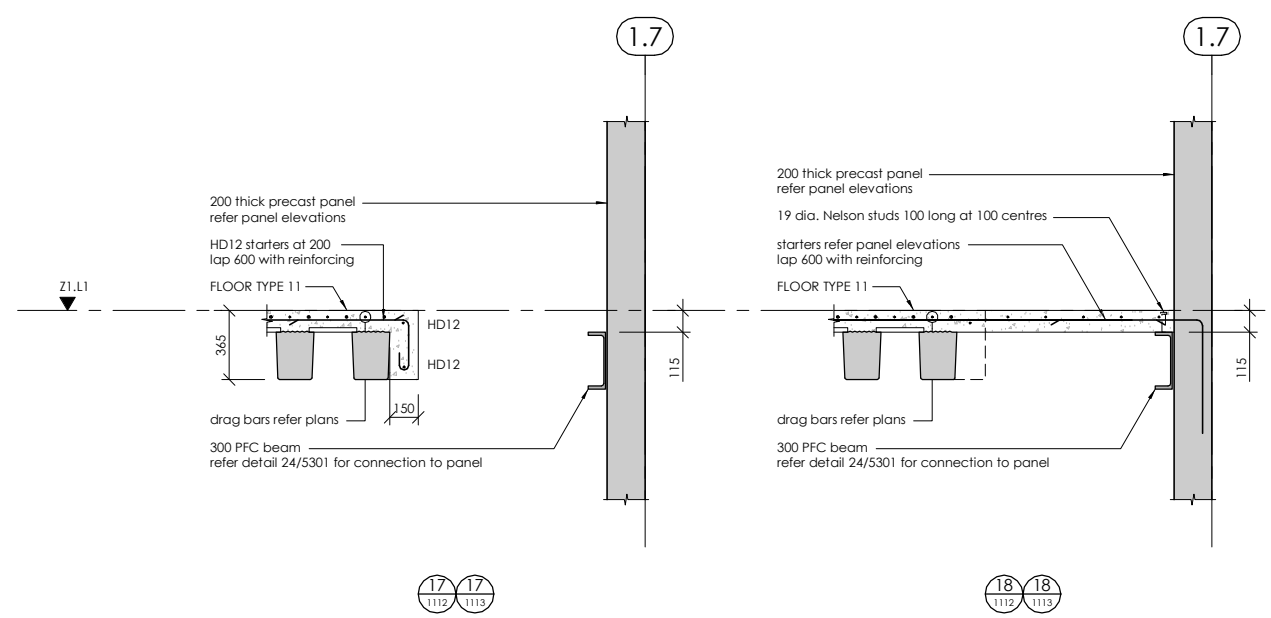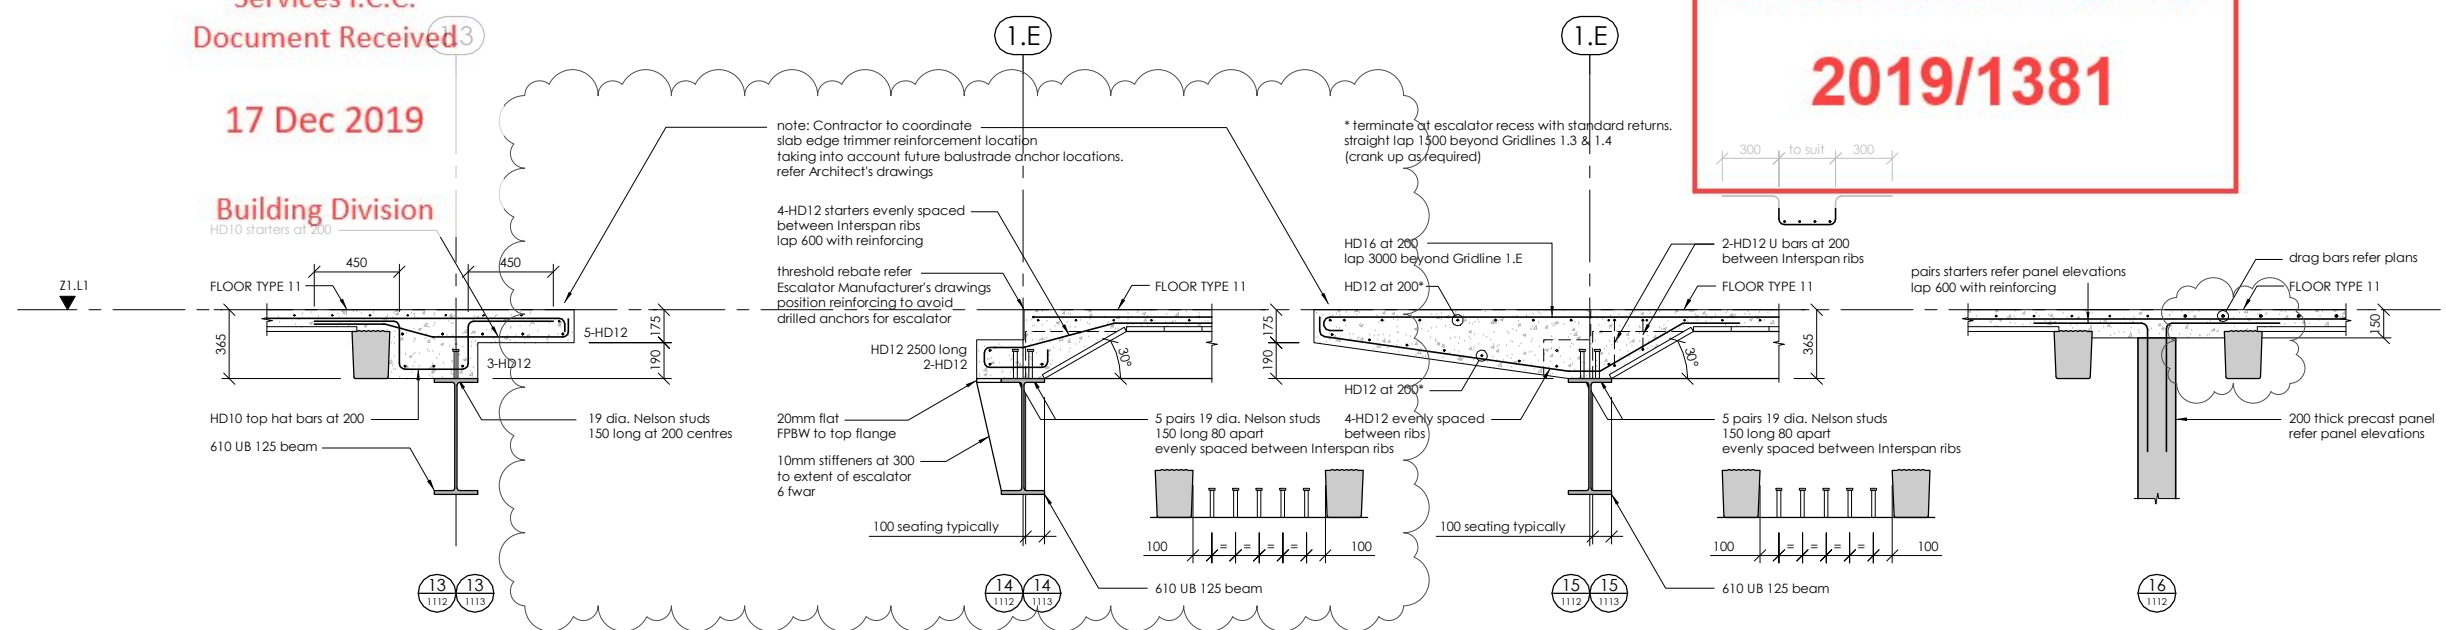


Invercargill City Council
Building Consent Authority
Approved Site Copy

Approved For Issue
27/02/2020

REV	DATE	AMENDMENT	BY
2	25.10.19	CONSENT ISSUE	GPW
1	27.09.19	PEER REVIEW ISSUE	GPW

CLIENT:
HWCP

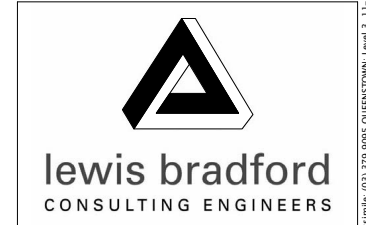

PROJECT:
INVERCARGILL CENTRAL ZONE 1 ANCHOR

DRAWING TITLE:
LEVEL 1 DETAILS SHEET 2

DRAWN: GPW	SCALE: 1 : 20 at A1
ENGINEER: EL/TSS	
CHECKED: -	

118083-Z1-WD-ST 5111
REV. 2

17 Dec 2019



Building Division
refer Architect's drawings

BUILDING CONSENT NUMBER
2019/1381


THIS DRAWING AND ALL INFORMATION CONTAINED WITHIN IS THE PROPERTY OF LEWIS BRADFORD. ITS CONTENTS ARE CONFIDENTIAL AND MUST NOT BE REPRODUCED OR DISTRIBUTED TO ANY OTHER PERSON OR COMPANY UNLESS AGREED TO IN WRITING BY LEWIS BRADFORD

CONTRACTOR TO VERIFY ALL DIMENSIONS ON SITE REFER TO ARCHITECT'S DRAWING FOR ALL SETOUTS


NOTES:
Refer drawing 0002 for standard notes. Refer also to Structural Specification.

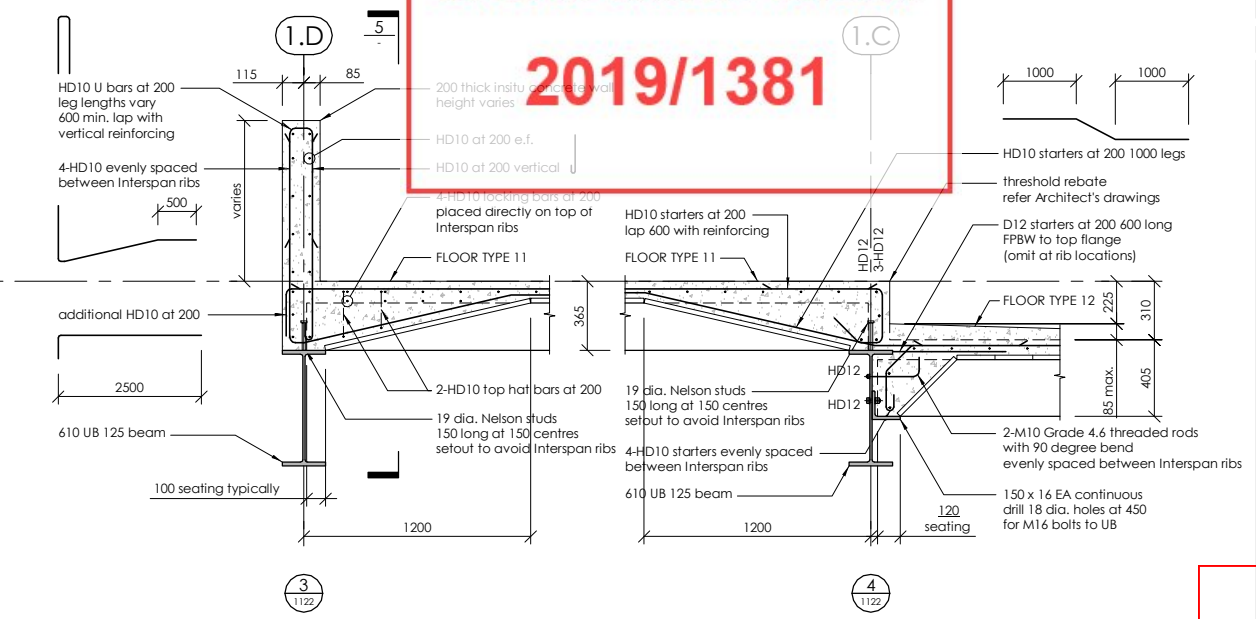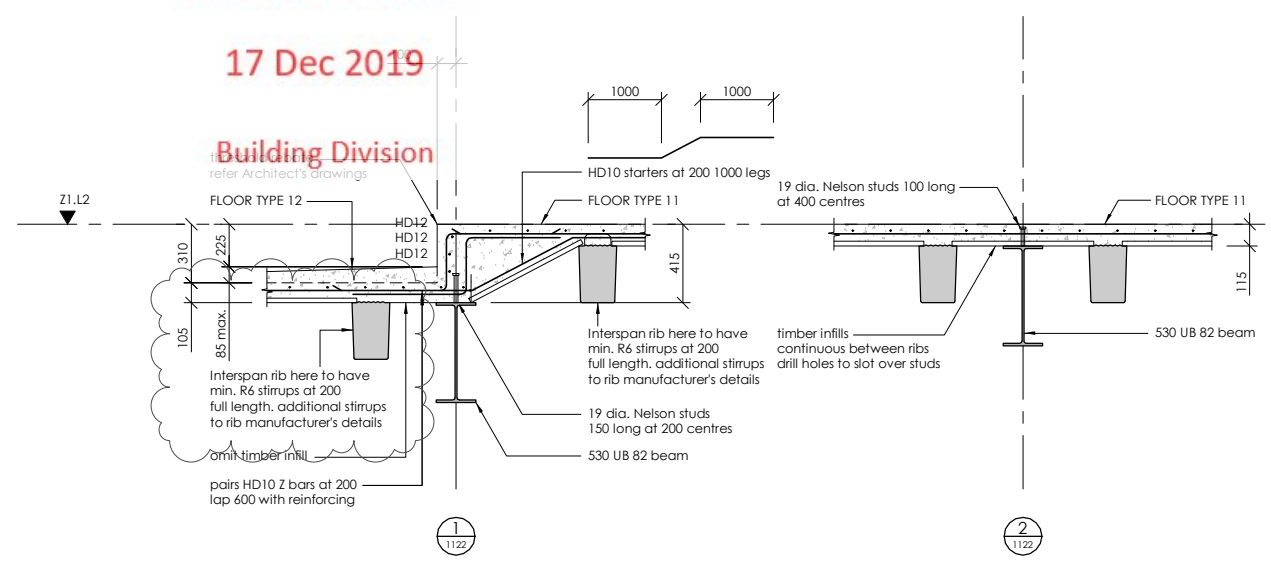


note: PFC roof connection to insitu concrete wall not shown for clarity, refer detail 13/5711

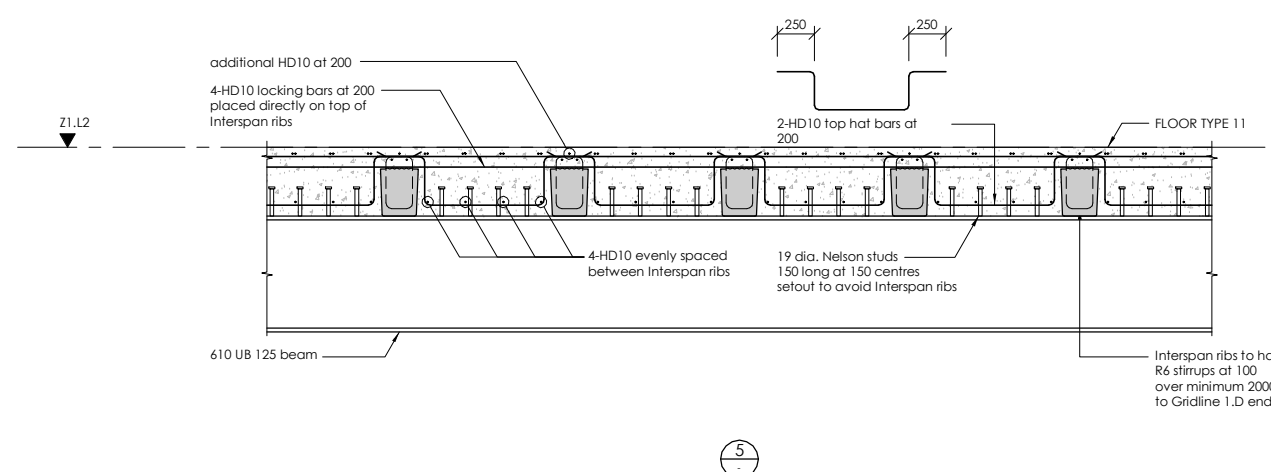

note: 200 thick insitu concrete wall and associated reinforcing not shown for clarity

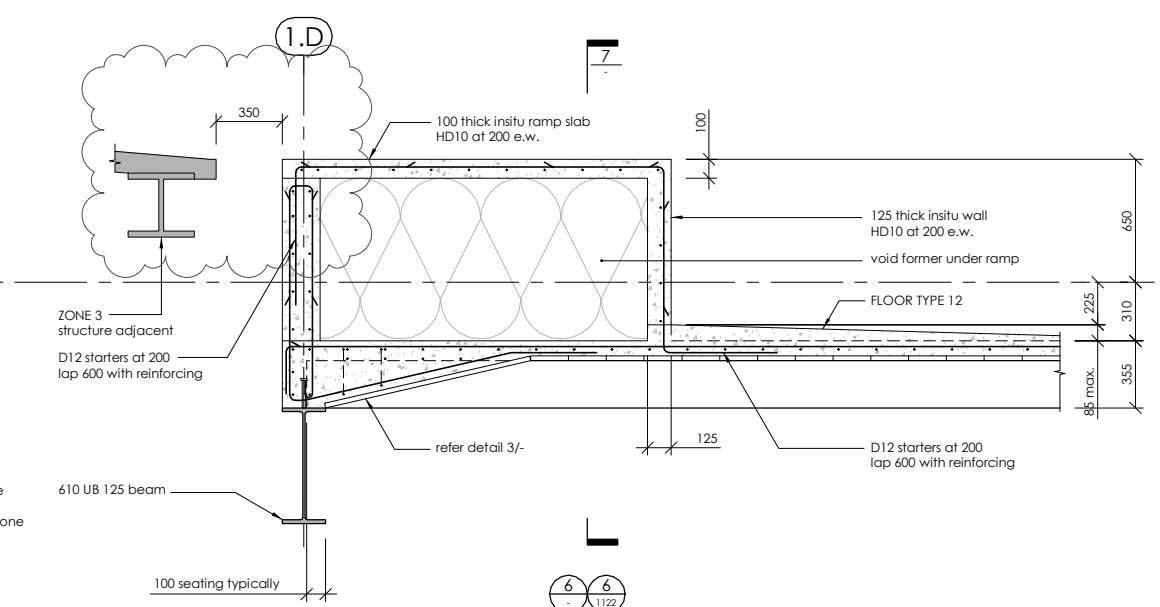

note: refer also detail 3/-

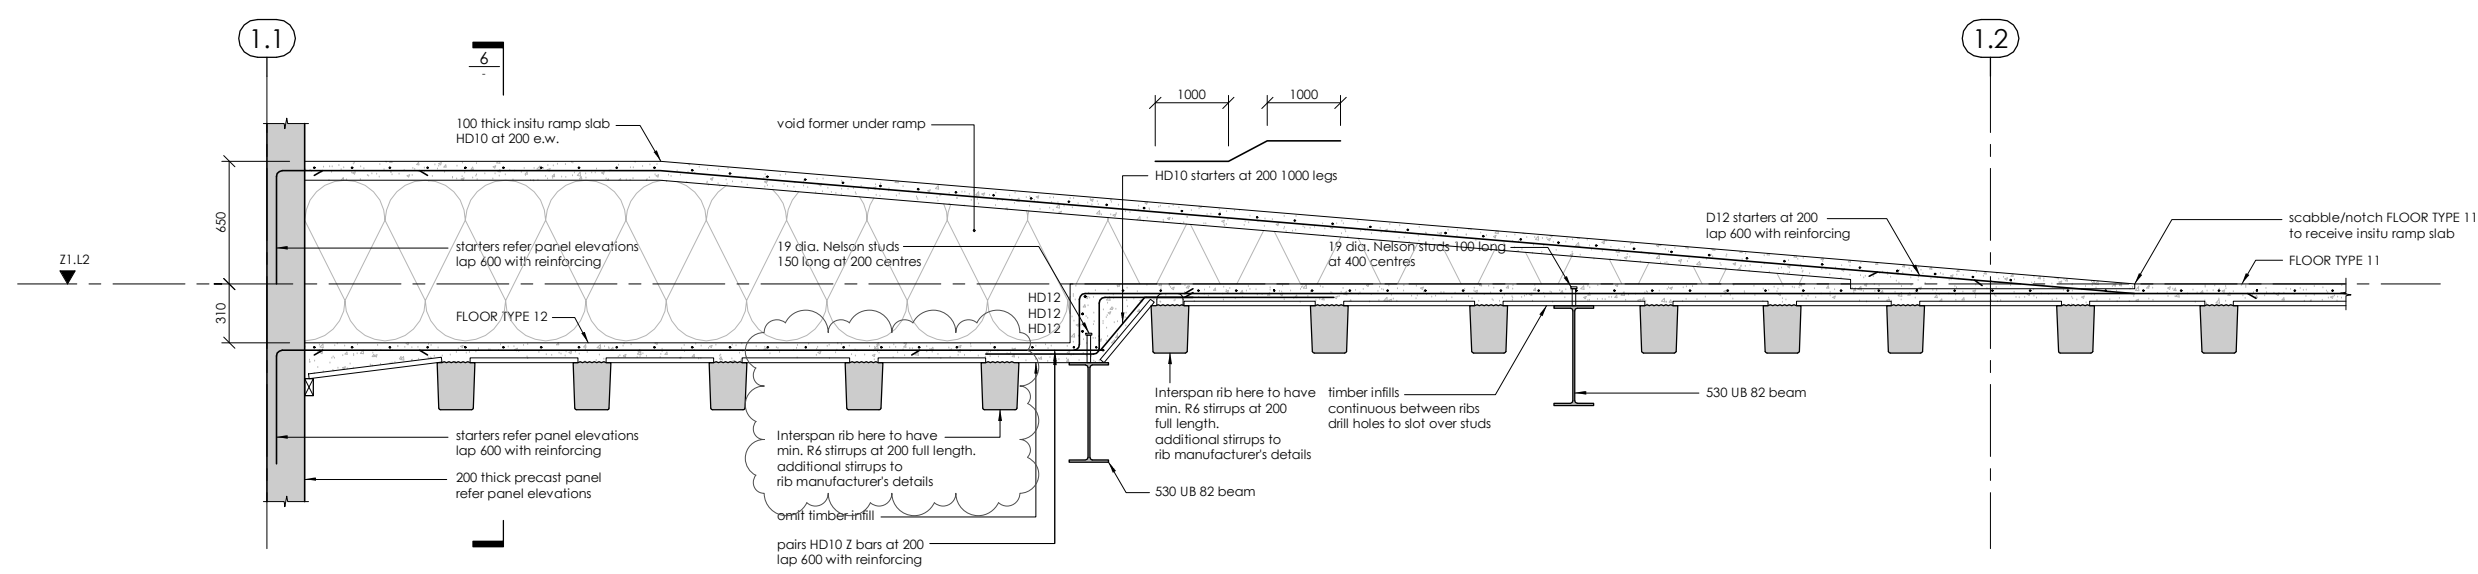

Invercargill City Council
Building Consent Authority
Approved Site Copy

Approved For Issue
27/02/2020

REV	DATE	AMENDMENT	BY
2	25.10.19	CONSENT ISSUE	GPW
1	27.09.19	PEER REVIEW ISSUE	GPW

CLIENT:
HWCP

lewis bradford
CONSULTING ENGINEERS

PROJECT:
**INVERCARGILL CENTRAL
ZONE 1 ANCHOR**


DRAWING TITLE:
**LEVEL 2
DETAILS
SHEET 1**

DRAWN: GPW	SCALE: 1 : 20 at A1
ENGINEER: EL/TSS	
CHECKED: -	
118083-Z1-WD-ST 5120	REV. 2

17 Dec 2019

Building Division

BUILDING CONSENT NUMBER
2019/1381

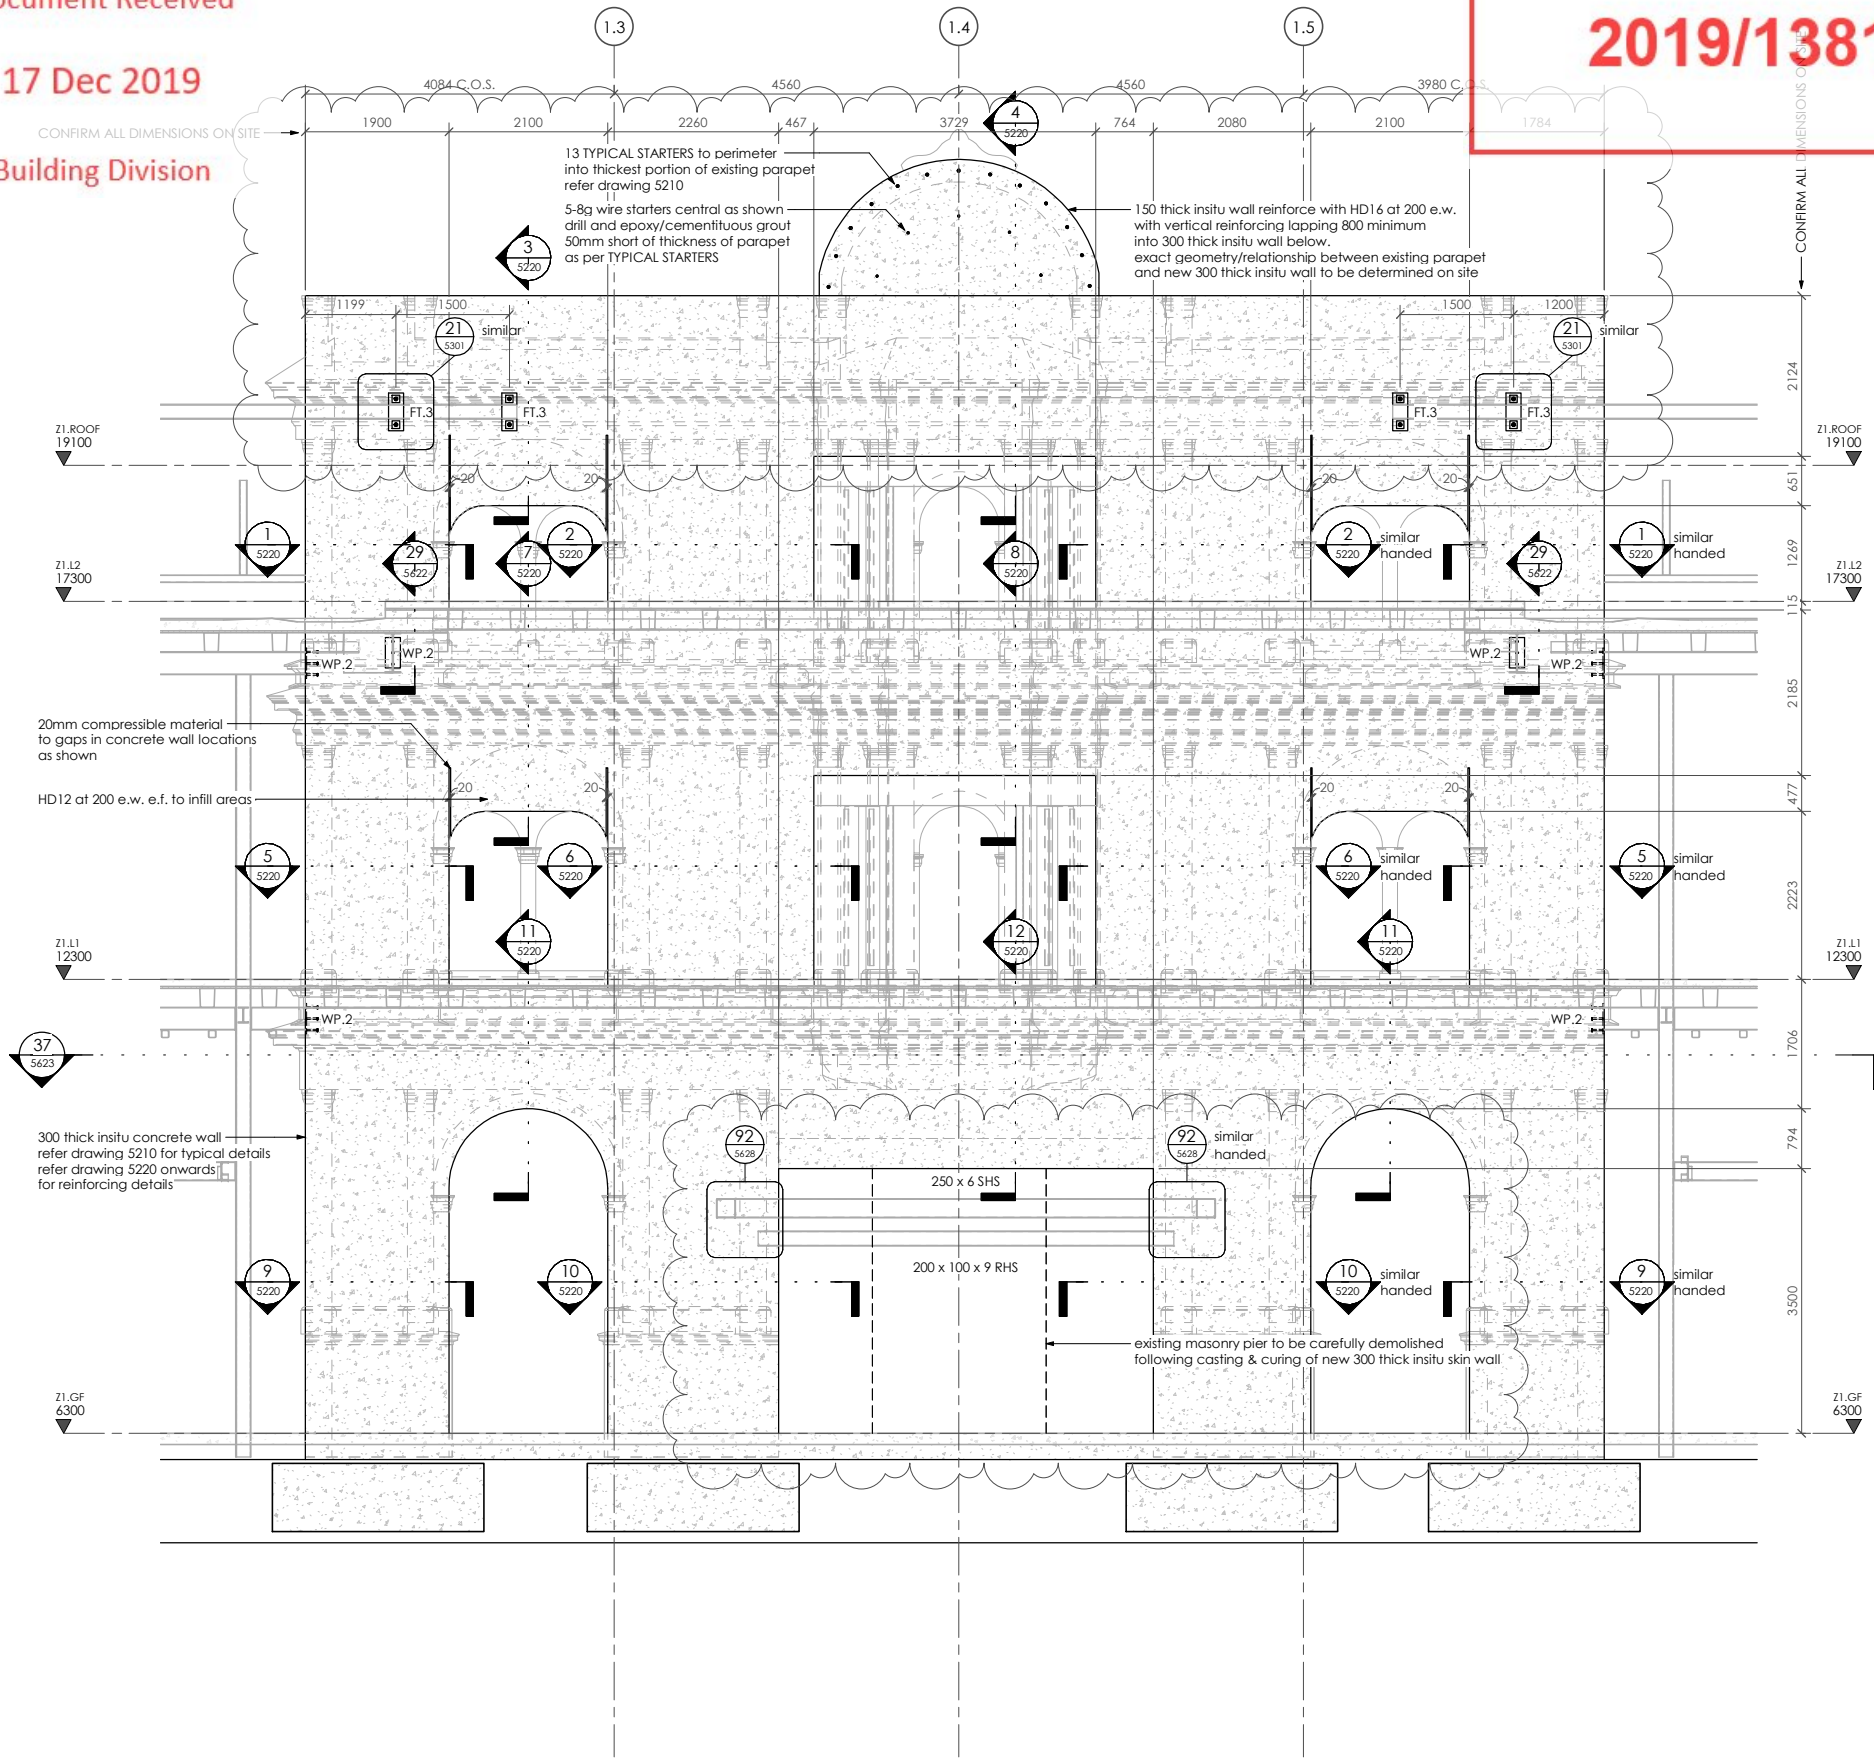

FACADE RETENTION ELEVATION - GRIDLINE 1.A

1 : 50

THIS DRAWING AND ALL INFORMATION CONTAINED WITHIN IS THE PROPERTY OF LEWIS BRADFORD. ITS CONTENTS ARE CONFIDENTIAL AND MUST NOT BE REPRODUCED OR DISTRIBUTED TO ANY OTHER PERSON OR COMPANY UNLESS AGREED TO IN WRITING BY LEWIS BRADFORD

CONTRACTOR TO VERIFY ALL DIMENSIONS ON SITE REFER TO ARCHITECT'S DRAWING FOR ALL SETOUTS

NOTES:
Refer drawing 0002 for standard notes.
Refer also to Structural Specification.

Refer also:
Lewis Bradford
Facade Retention Structural Documentation
Job Number 118083.02

Contractor to provide full method statement including sequence of works to Engineer prior to any construction of the new 300 thick insitu skin wall to the inner face of the existing facade.

Key Assumptions:
It has generally been assumed the new 300 thick insitu skin wall will be constructed level by level following the same sequence as the floor slabs (i.e. existing props will not be sufficient to brace the existing facade and new 300 thick insitu skin wall full height without additional restraint)

The new 300 thick insitu skin wall is to be fully cast and cured prior to carefully demolishing the existing central masonry pier on Gridline 1.4


The Contractor is to be responsible for any hit and miss construction

Invercargill City Council
Building Consent Authority
Approved Site Copy

Approved For Issue
27/02/2020

2	25.10.19	CONSENT ISSUE	GPW
1	27.09.19	PEER REVIEW ISSUE	GPW
REV	DATE	AMENDMENT	BY

CLIENT:
HWCP

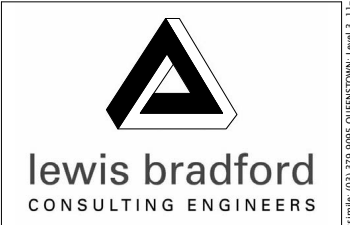


PROJECT:
INVERCARGILL CENTRAL ZONE 1 ANCHOR


DRAWING TITLE:
FACADE RETENTION ELEVATION GRIDLINE 1.A

DRAWN: GPW	SCALE: 1 : 50 at A1
ENGINEER: EL/TSS	
CHECKED: -	
118083-Z1-WD-ST 5200	REV. 2


17 Dec 2019

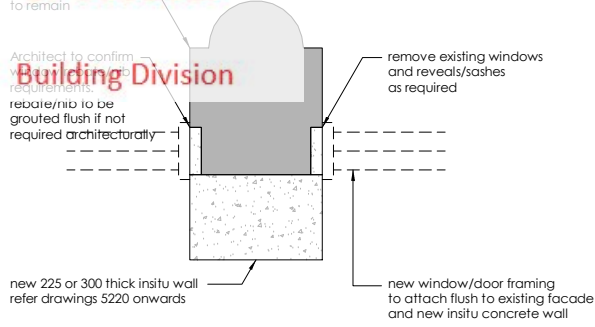

TYPICAL PIER TREATMENT - PLAN VIEW
①

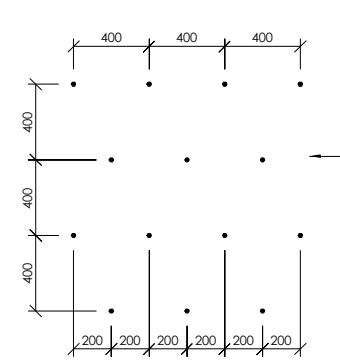

TYPICAL STARTER SETOUT - ELEVATION
②

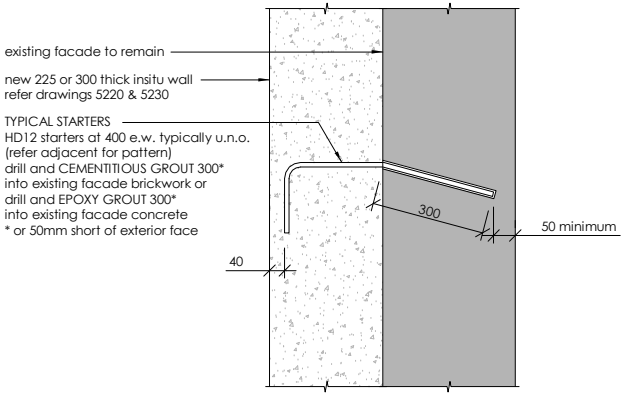

TYPICAL STARTER DETAIL - SECTION VIEW
③

STEELWORK NOTES

All structural steel shall comply with NZS 3404.

Surface preparation and corrosion protection of steel work shall be in accordance with the Specification.

All exposed ends of RHS members to be capped with ex. 6mm ms plate unless shown otherwise.

All plates shall be 10mm minimum unless noted otherwise.

Unless shown otherwise, all welds are to be 6 fillet weld all round refer to the Specification for type and class of weld.

All bolts and nuts shall be grade 8.8 high strength.

Oversized holes up to 1.33D may be provided for fixing structural steelwork to cast-in items (such as floor seating angle connections to cast-in Reid threaded inserts) if required for construction tolerance.

All oversized holes must be accompanied with a flat square steel washer 6mm min. thick welded all around with 6 fwar min.

All dry pack mortar/grout shall have a compressive strength of at least 30 MPa.

The Contractor shall provide an electronic copy of the shop drawings for the structural steel work to the Engineer. Allow 10 working days for review.

REIDBRACE NOTES


to reduce sag it is permissible to pre-tension unlubricated braces to a maximum of: 100Nm torque for RB16 bracing 250Nm torque for RB20 bracing 400Nm torque for RB25 bracing

Install Reidbrace in strict accordance with Reid's details including site installation of safety clip, tension nut and spring and washers either side of cleats.


Provide plastic sleeves wired to brace where braces cross

Where splicing of bars is required use Reidbar couplers

All RB25 Reidbar crossbracing to have ductile steel fuse plate elements to end bays of bracing.

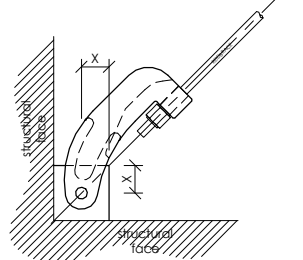

Reidbrace Size	Minimum Edge Distance = X	Cleat Plate Thickness	Weld Type U.N.O.
RB12	50mm	12mm	6mm
RB16	50mm	12mm	8mm
RB20	50mm	20mm	8mm
RB25	75mm	25mm	8mm

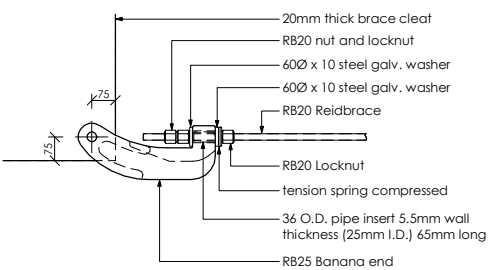

RB25 BANANA END CONVERSION TO RB20 ROOF BRACING

INSITU CONCRETE NOTES

Refer Architects drawings for all set out dimensions, opening sizes, slab set downs, rebates etc. Should there be any discrepancies between the architectural and engineering drawings advise the engineer.

All reinforcing steel shall be manufactured by Pacific Steel Limited using the microalloy process and shall be Grade 500E or Grade 300E.

All insitu interfaces and construction joints shall be thoroughly roughened to 5mm amplitude.


All reinforcing to be continuous around corners.

Bar annotations:
HD - denotes grade 500E
D - denotes grade 300E.

Refer to Specification for cover requirements to reinforcement.

Refer specification for minimum concrete compressive strength for all insitu concrete work.

All horizontal foundation reinforcing must lap adequately at corners and junctions as indicated below:

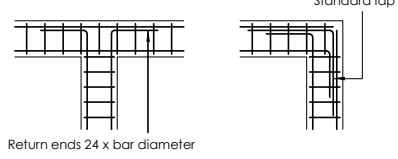

BUILDING CONSENT NUMBER
2019/1381

THIS DRAWING AND ALL INFORMATION CONTAINED WITHIN IS THE PROPERTY OF LEWIS BRADFORD. ITS CONTENTS ARE CONFIDENTIAL AND MUST NOT BE REPRODUCED OR DISTRIBUTED TO ANY OTHER PERSON OR COMPANY UNLESS AGREED TO IN WRITING BY LEWIS BRADFORD

CONTRACTOR TO VERIFY ALL DIMENSIONS ON SITE REFER TO ARCHITECT'S DRAWING FOR ALL SETOUTS

NOTES:
Refer drawing 0002 for standard notes. Refer also to Structural Specification.

GROUTING OF TYPICAL STARTERS

CEMENTITIOUS GROUT where referenced on drawings refers to either Hilti HIT-HY 170 or Sika Grout 215 to be installed in strict accordance with the Manufacturer's instructions. Refer also Structural Specification Section 7.2

EPOXY GROUT where referenced on drawings refers to Hilti HIT-HY 200 or Hilti HIT-RE 500 V3 (or similar approved) to be installed in strict accordance with the Manufacturer's instructions. Refer also Structural Specification Section 3.1

The Contractor is to submit a detailed method statement for the core drilling and grouting works well in advance of construction. This method statement will be reviewed and approved by the Engineer prior to commencing any core drilling. Refer also to the Structural Specification

BRICK AND STONE MASONRY REPAIRS

An experienced bricklayer is to inspect all brickwork and stonework for damage and deterioration

A detailed repair specification is to be prepared by the Contractor in conjunction with a brick layer experienced in heritage work and submitted to the Engineer for review and approval prior to undertaking any repair works. This specification should include, but not be limited to:

- a method statement for each repair type including the proposed materials to be used
- elevations showing itemised repair locations, types and extent

Damaged masonry units to be carefully removed and replaced with new masonry units to the approval on the Engineer

GENERAL NOTES

This drawing is to be read in conjunction with all relevant Engineers and Architects drawings and the Specification.

These facade strengthening drawings are based on no original drawings and limited on site investigation works. Investigation works are required on site to confirm as built structural details.

These facade strengthening drawings cover the design of the temporary facade retention system only. Additional temporary works will be required between work phases to suit the Contractor's final proposed methodology

Refer Architects drawings for all set out dimensions, opening sizes, slab set downs, rebates, insitu nibs and upstands etc.

All discrepancies shall be referred to the Architect for resolution before proceeding work.

Refer hydraulic drawings for pipe penetrations required through foundations.

Foundation material shall be approved by the Geotechnical Engineer for safe bearing capacity before construction of any footings

The Contractor is responsible for the design, installation and maintenance of all necessary temporary works to ensure the strength and stability of the building throughout the course of the demolition works. Note that significant temporary propping will be required to the existing masonry facade structure during demolition of the ground floor piers.

Contractor to take all measures necessary to prevent damage to the facade during the works.

Contractor to determine positions of all existing services (i.e. including but not limited to electrical and drainage) before excavation for foundations. It is expected that existing water supply and stormwater pipes are located within 6m of the existing facades.

Contractor shall notify the Engineer at least SEVEN DAYS prior to pouring foundation concrete.

All materials and workmanship must comply with the New Zealand Building Code.

Locate, disconnect and/or otherwise make safe all existing services on or adjacent to the site before commencing works.

Allow to comply with all Invercargill City Council requirements and notify the Engineer of any conditions of consent.

Notify the Engineer if any hidden existing defects such as rotten or degraded structural members are uncovered as part of these works.

Invercargill City Council
Building Consent Authority
Approved Site Copy

Approved For Issue
27/02/2020

REV	DATE	AMENDMENT	BY
2	25.10.19	CONSENT ISSUE	GPW
1	27.09.19	PEER REVIEW ISSUE	GPW

CLIENT:
HWCP

lewis bradford
CONSULTING ENGINEERS

PROJECT:
INVERCARGILL CENTRAL ZONE 1 ANCHOR

DRAWING TITLE:
FACADE RETENTION DETAILS TYPICAL

DRAWN:	GPW	SCALE:
ENGINEER:	EL/TSS	1 : 10 at A1
CHECKED:	-	
118083-Z1-WD-ST 5210		REV. 2

17 Dec 2019

Building Division

BUILDING CONSENT NUMBER

2019/1381

THIS DRAWING AND ALL INFORMATION CONTAINED WITHIN IS THE PROPERTY OF LEWIS BRADFORD. ITS CONTENTS ARE CONFIDENTIAL AND MUST NOT BE REPRODUCED OR DISTRIBUTED TO ANY OTHER PERSON OR COMPANY UNLESS AGREED TO IN WRITING BY LEWIS BRADFORD

CONTRACTOR TO VERIFY ALL DIMENSIONS ON SITE REFER TO ARCHITECT'S DRAWING FOR ALL SETOUTS

NOTES:

Refer drawing 0002 for standard notes. Refer also to Structural Specification.

Refer also:
**Lewis Bradford
Facade Retention Structural Documentation
Job Number 118083.02**

Contractor to provide full method statement including sequence of works to Engineer prior to any construction of the new 300 thick insitu skin wall to the inner face of the existing facade.

Key Assumptions:
It has generally been assumed the new 300 thick insitu skin wall will be constructed level by level following the same sequence as the floor slabs (i.e. existing props will not be sufficient to brace the existing facade and new 300 thick insitu skin wall full height without additional restraint)

The new 300 thick insitu skin wall is to be fully cast and cured prior to carefully demolishing the existing central masonry pier on Gridline 1.4


The new 300 thick insitu skin wall is to be fully cast and cured prior to carefully demolishing the existing central masonry pier on Gridline 1.4

**Invercargill City Council
Building Consent Authority
Approved Site Copy**

**Approved For Issue
27/02/2020**

REV	DATE	AMENDMENT	BY
2	25.10.19	CONSENT ISSUE	GPW
1	27.09.19	PEER REVIEW ISSUE	GPW





CLIENT:
HWCP

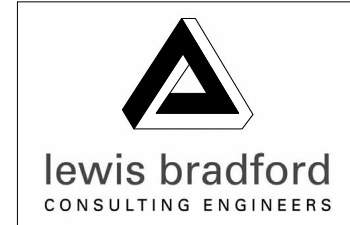

PROJECT:
**INVERCARGILL CENTRAL
ZONE 1 ANCHOR**

DRAWING TITLE:
**FACADE RETENTION
DETAILS
SOUTHLAND TIMES**

DRAWN: GPW	SCALE: 1 : 20 at A1
ENGINEER: EL/TSS	
CHECKED: -	
118083-Z1-WD-ST 5220	REV. 2

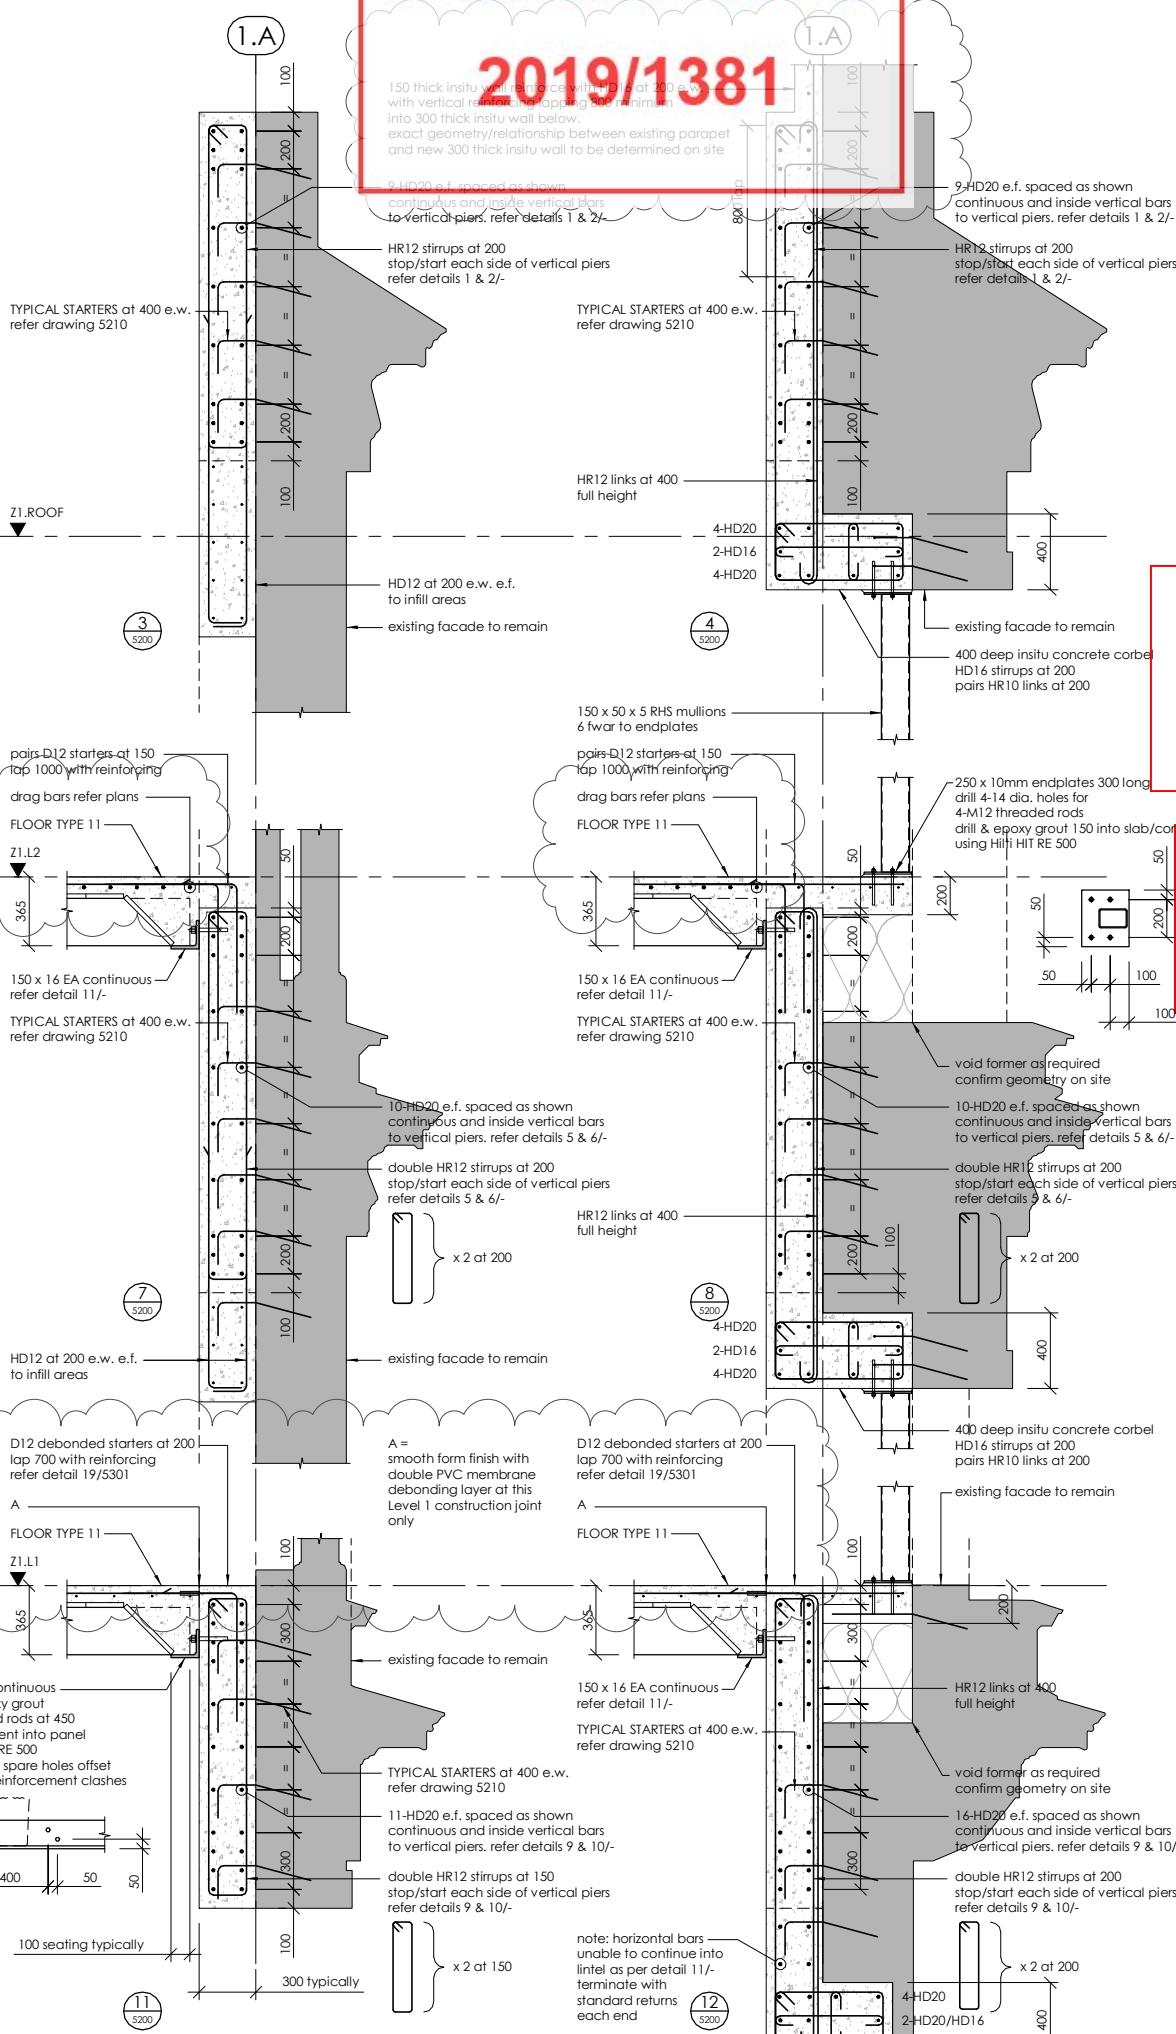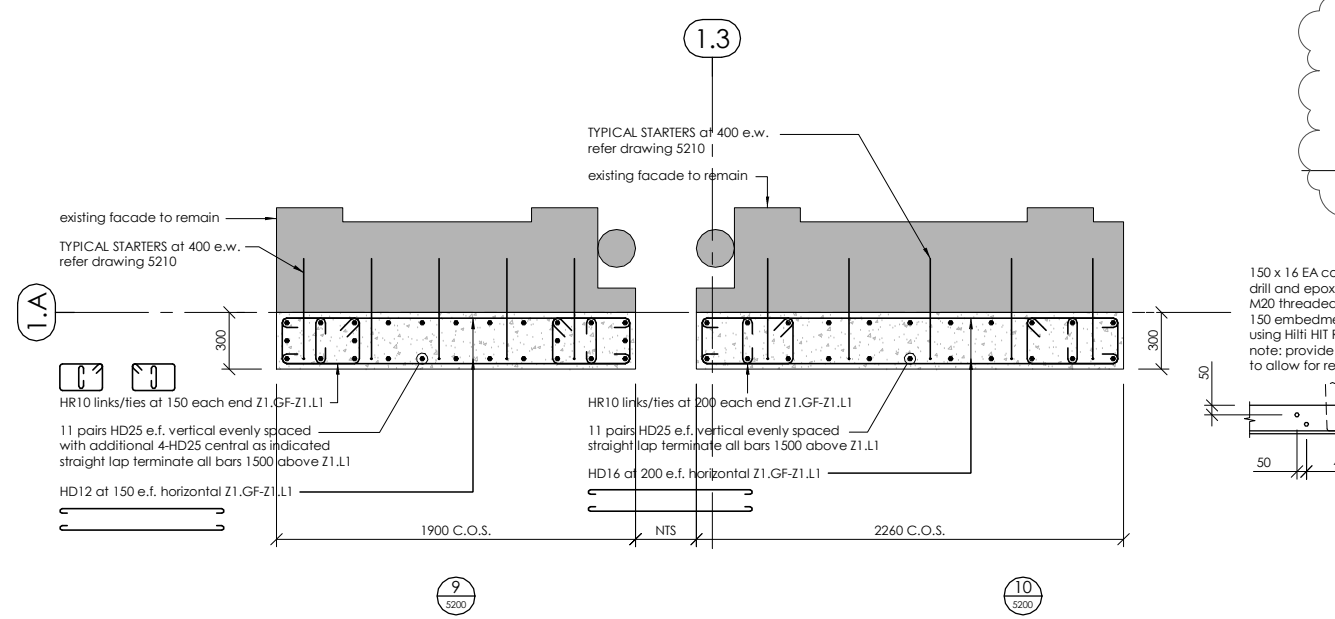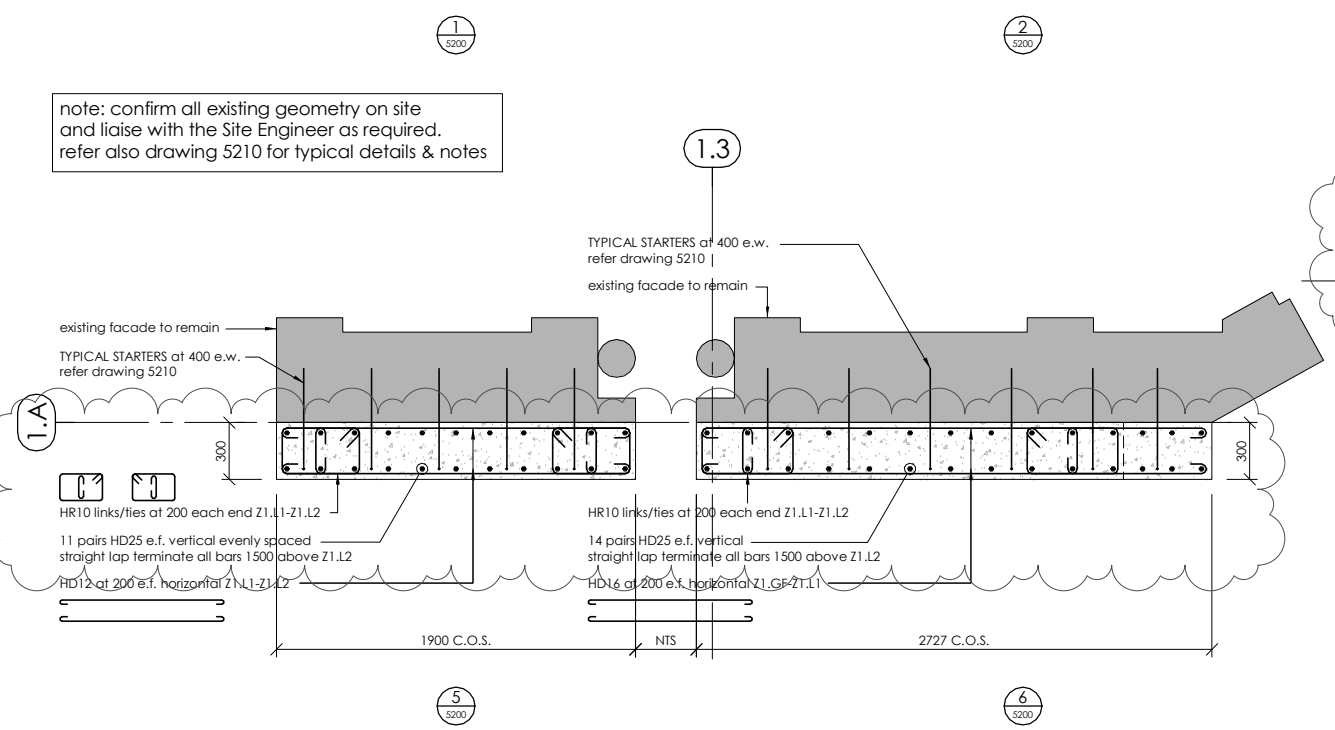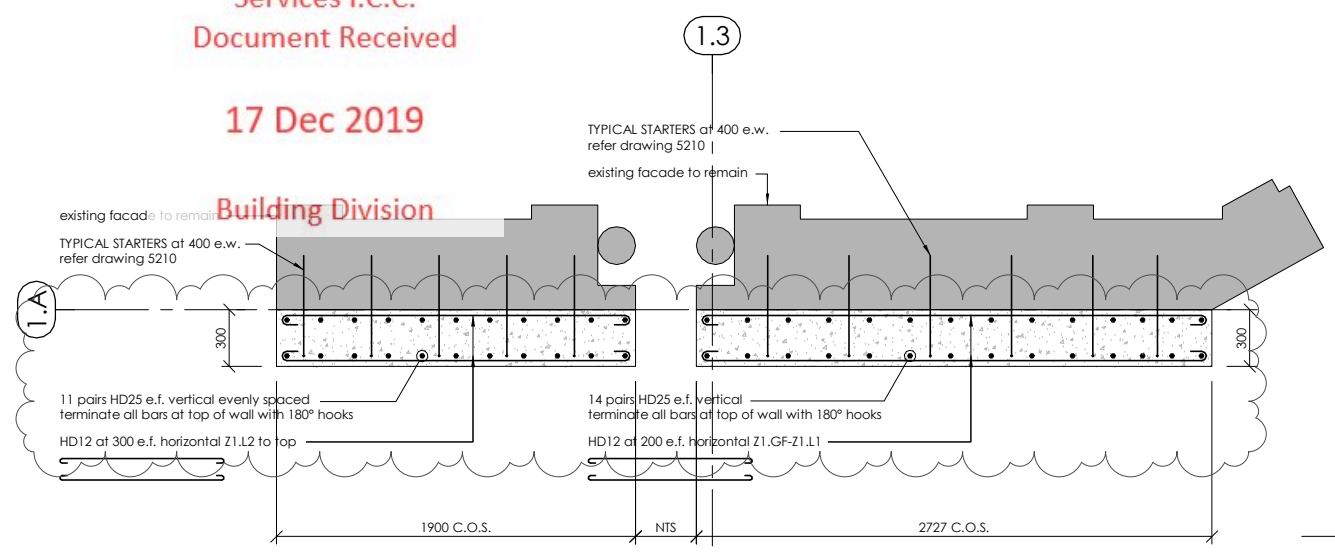

17 Dec 2019

Building Division

BUILDING CONSENT NUMBER
2019/1381

THIS DRAWING AND ALL INFORMATION CONTAINED WITHIN IS THE PROPERTY OF LEWIS BRADFORD. ITS CONTENTS ARE CONFIDENTIAL AND MUST NOT BE REPRODUCED OR DISTRIBUTED TO ANY OTHER PERSON OR COMPANY UNLESS AGREED TO IN WRITING BY LEWIS BRADFORD


CONTRACTOR TO VERIFY ALL DIMENSIONS ON SITE REFER TO ARCHITECT'S DRAWING FOR ALL SETOUTS

NOTES:


Refer drawing 0002 for standard notes. Refer also to Structural Specification.




D1 DROSSBACH DUCT DETAIL ZONES 1 & 3

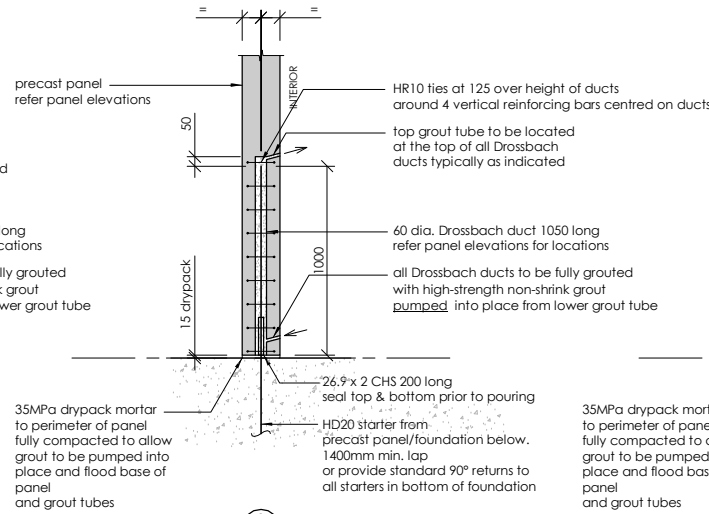


D2 DROSSBACH DUCT DETAIL ZONE 3 ONLY

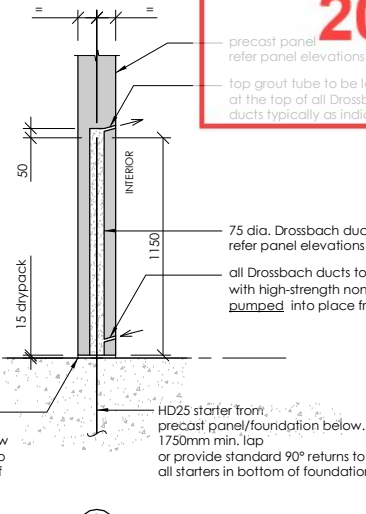


D3 DROSSBACH DUCT DETAIL ZONES 1 & 3

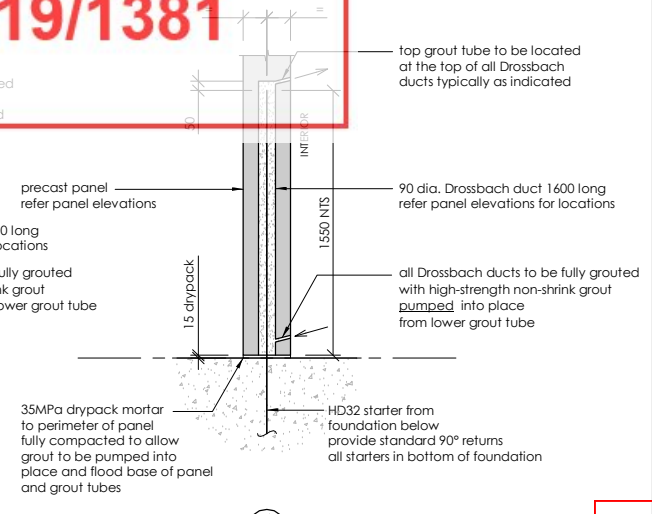


D4 DROSSBACH DUCT DETAIL ZONE 1 ONLY

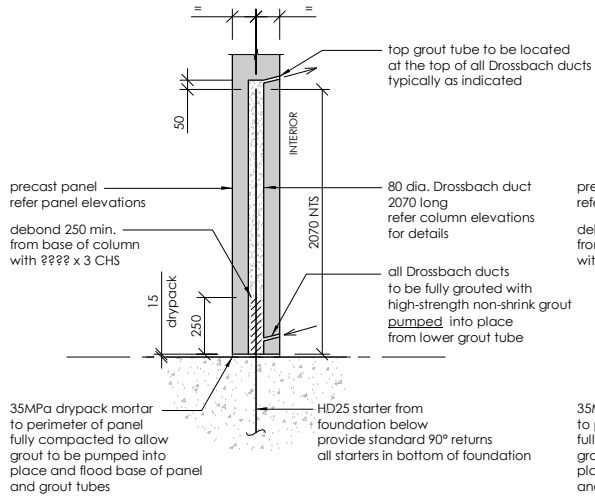

D5 DROSSBACH DUCT DETAIL ZONE 3 ONLY

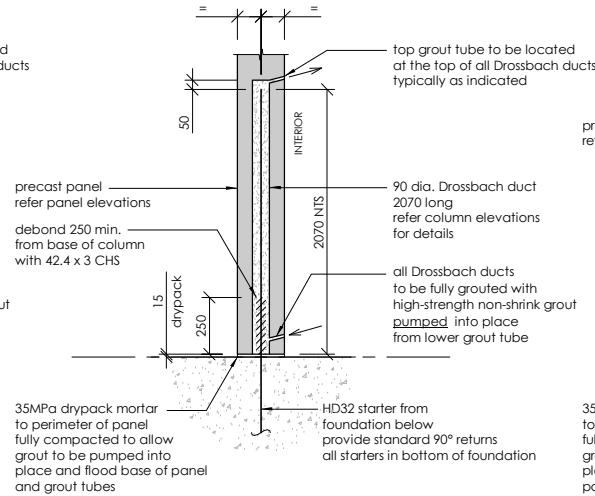

D6 DROSSBACH DUCT DETAIL ZONE 3 ONLY

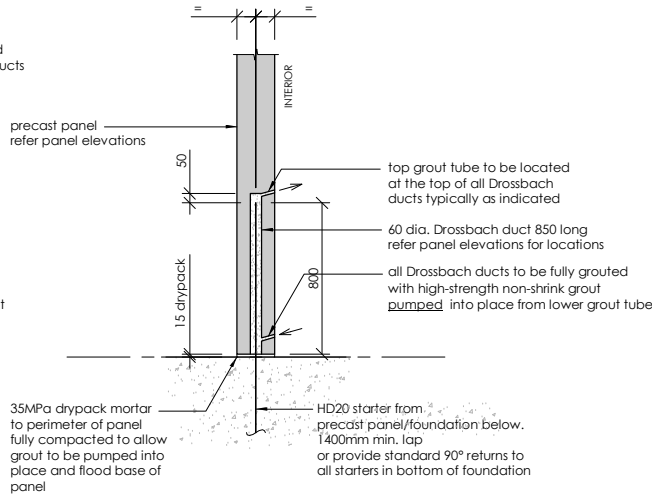

D7 DROSSBACH DUCT DETAIL ZONES 1 & 3

Invercargill City Council
Building Consent Authority
Approved Site Copy

Approved For Issue
27/02/2020

REV	DATE	AMENDMENT	BY
2	25.10.19	CONSENT ISSUE	GPW
1	27.09.19	PEER REVIEW ISSUE	GPW

CLIENT:
HWCP

lewis bradford
CONSULTING ENGINEERS

PROJECT:
INVERCARGILL CENTRAL ZONE 1 ANCHOR

DRAWING TITLE:
TYPICAL PRECAST PANEL DETAILS SHEET 1

DRAWN: GPW	SCALE: 1 : 20 at A1
ENGINEER: EL/TSS	
CHECKED: -	
118083-Z1-WD-ST 5300	REV. 2

17 Dec 2019

Building Division


BUILDING CONSENT NUMBER
2019/1381

THIS DRAWING AND ALL INFORMATION CONTAINED WITHIN IS THE PROPERTY OF LEWIS BRADFORD. ITS CONTENTS ARE CONFIDENTIAL AND MUST NOT BE REPRODUCED OR DISTRIBUTED TO ANY OTHER PERSON OR COMPANY UNLESS AGREED TO IN WRITING BY LEWIS BRADFORD


CONTRACTOR TO VERIFY ALL DIMENSIONS ON SITE REFER TO ARCHITECT'S DRAWING FOR ALL SETOUTS

NOTES :
Refer drawing 0002 for standard notes.
Refer also to Structural Specification


note: apply intumescent fire protection with equivalent FRR to connections to all elements shown on plans/elevations designated with a *, ** or ***
Where unprotected areas of steelwork meet fire protected elements overlap the fire protection onto the adjoining 500mm of 'unprotected' structural steel!

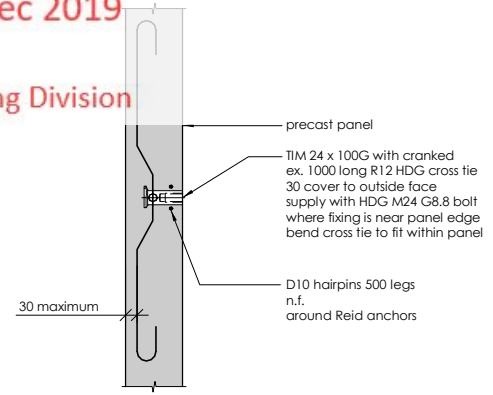


13
INSERT TYPE 1 (IT.1)
scale 1:10

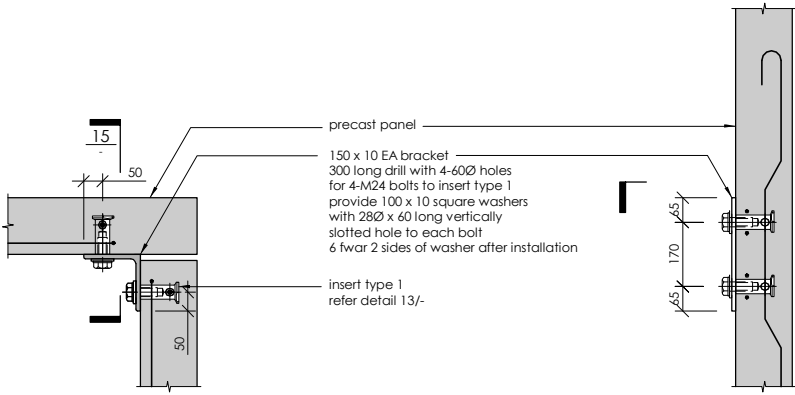


14
FIXING TYPE 1 (FT.1) - ZONES 1 & 3
scale 1:10

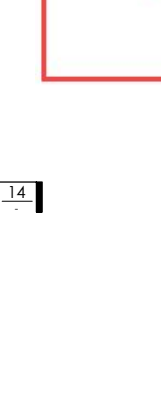


15
FIXING TYPE 1 (FT.1) - ZONES 1 & 3
scale 1:10

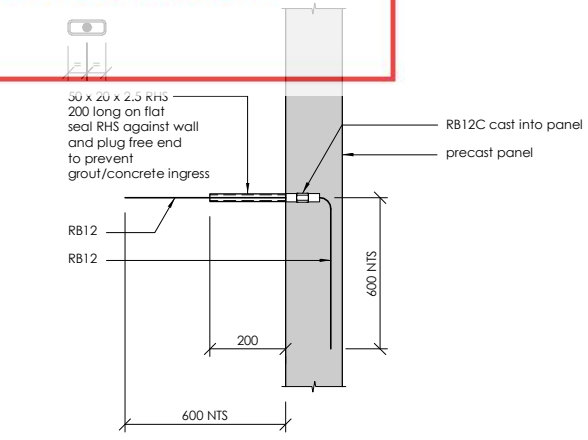


16
TYPICAL RB12 DEBONDED STARTER - ZONE 3 ONLY
scale 1:10

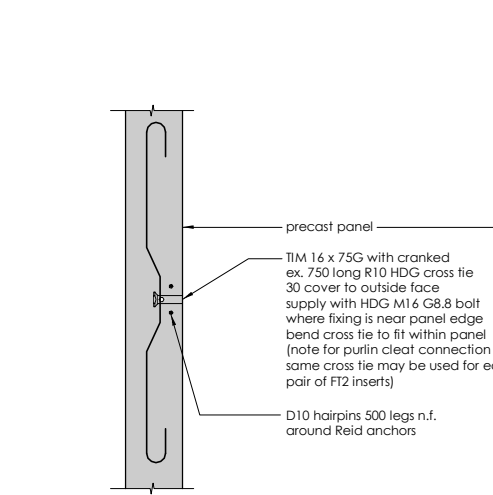


17
INSERT TYPE 2 (IT.2)
scale 1:10

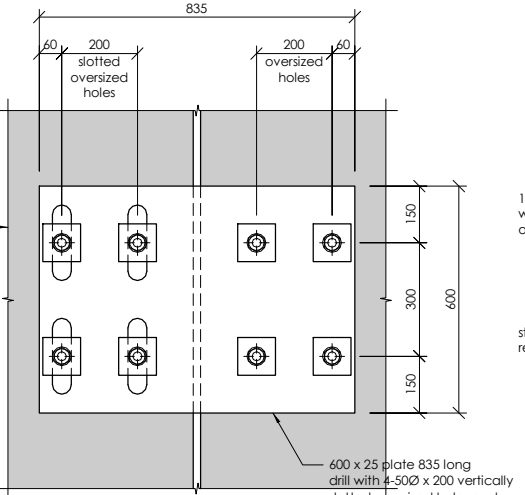


18
FIXING TYPE 2 (FT.2) - ZONE 3 ONLY
scale 1:10

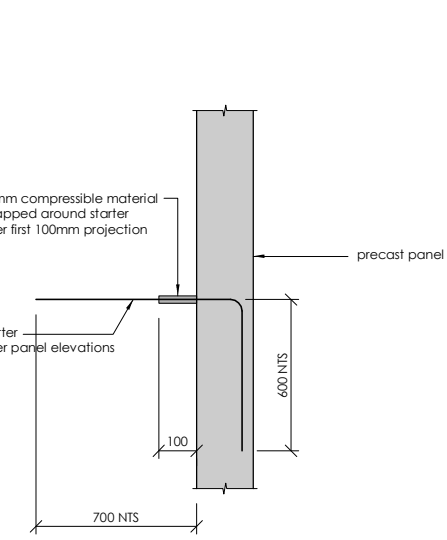


19
TYPICAL DEBONDED STARTER - ZONE 1 ONLY
scale 1:10

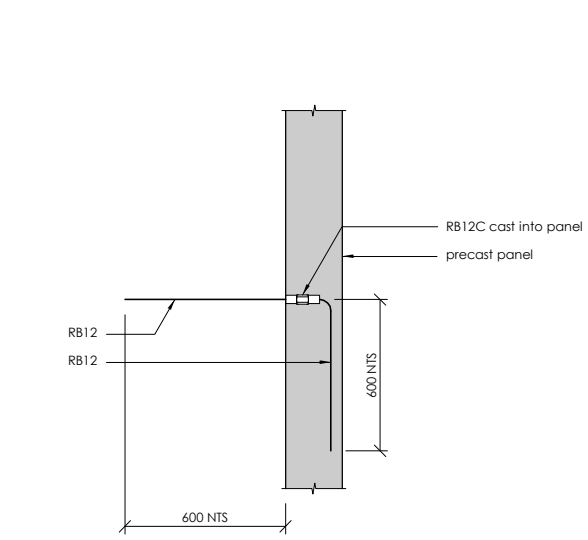


20
TYPICAL RB12 BONDED STARTER
scale 1:10

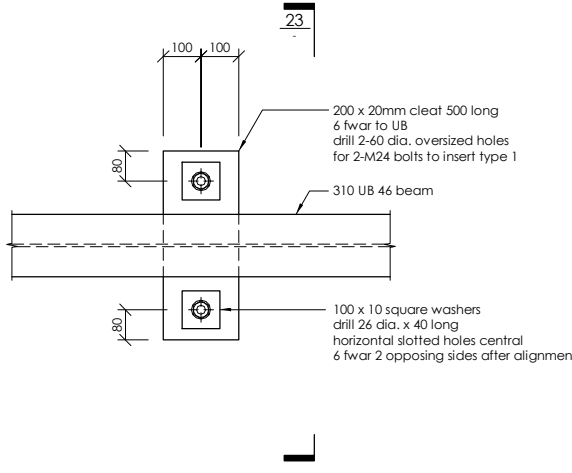


21
FIXING TYPE 3 (FT.3) - ZONE 1 ONLY
scale 1:10

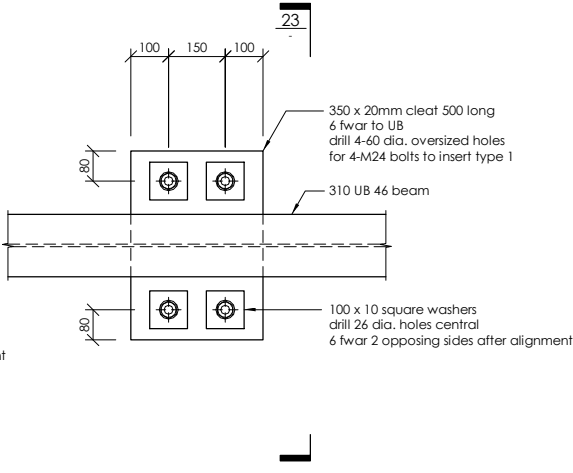

22
FIXING TYPE 4 (FT.4) - ZONE 1 ONLY
scale 1:10

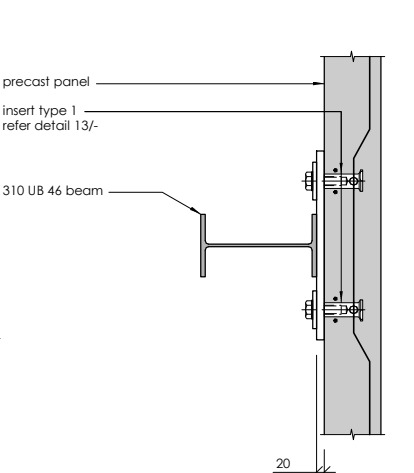

23
FIXING TYPE 5 (FT.5) - ZONE 1 ONLY
scale 1:10

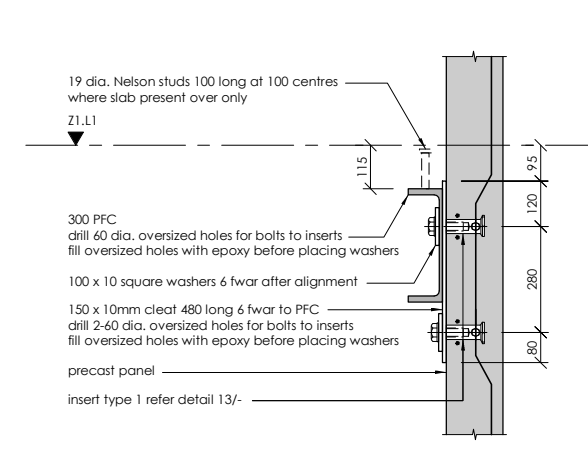

24
FIXING TYPE 5 (FT.5) - ZONE 1 ONLY
scale 1:10

Invercargill City Council
Building Consent Authority
Approved Site Copy

Approved For Issue
27/02/2020

REV	DATE	AMENDMENT	BY
2	25.10.19	CONSENT ISSUE	GPW
1	27.09.19	PEER REVIEW ISSUE	GPW

CLIENT:
HWCP

lewis bradford
CONSULTING ENGINEERS

PROJECT:
INVERCARGILL CENTRAL ZONE 1 ANCHOR


DRAWING TITLE:
TYPICAL PRECAST PANEL DETAILS SHEET 2

DRAWN: GPW	SCALE: 1 : 20 at A1
ENGINEER: EL/TSS	
CHECKED: -	
118083-Z1-WD-ST 5301	REV. 2


17 Dec 2019

3-100 x 10 square washers
drill 26 dia. holes central
6 fwar after alignment

Building Division

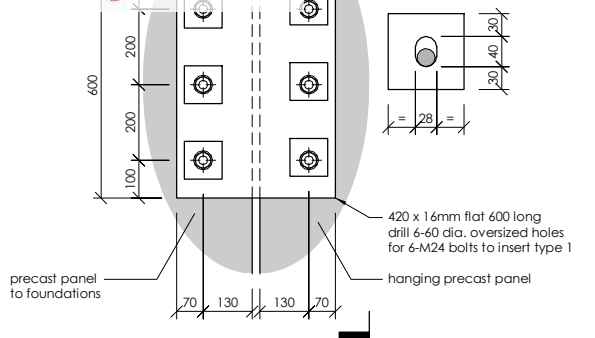


FIXING TYPE 6 (FT.6) - ZONE 1 ONLY
scale 1:10

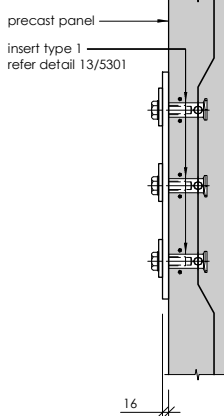

26

BUILDING CONSENT NUMBER

2019/1381

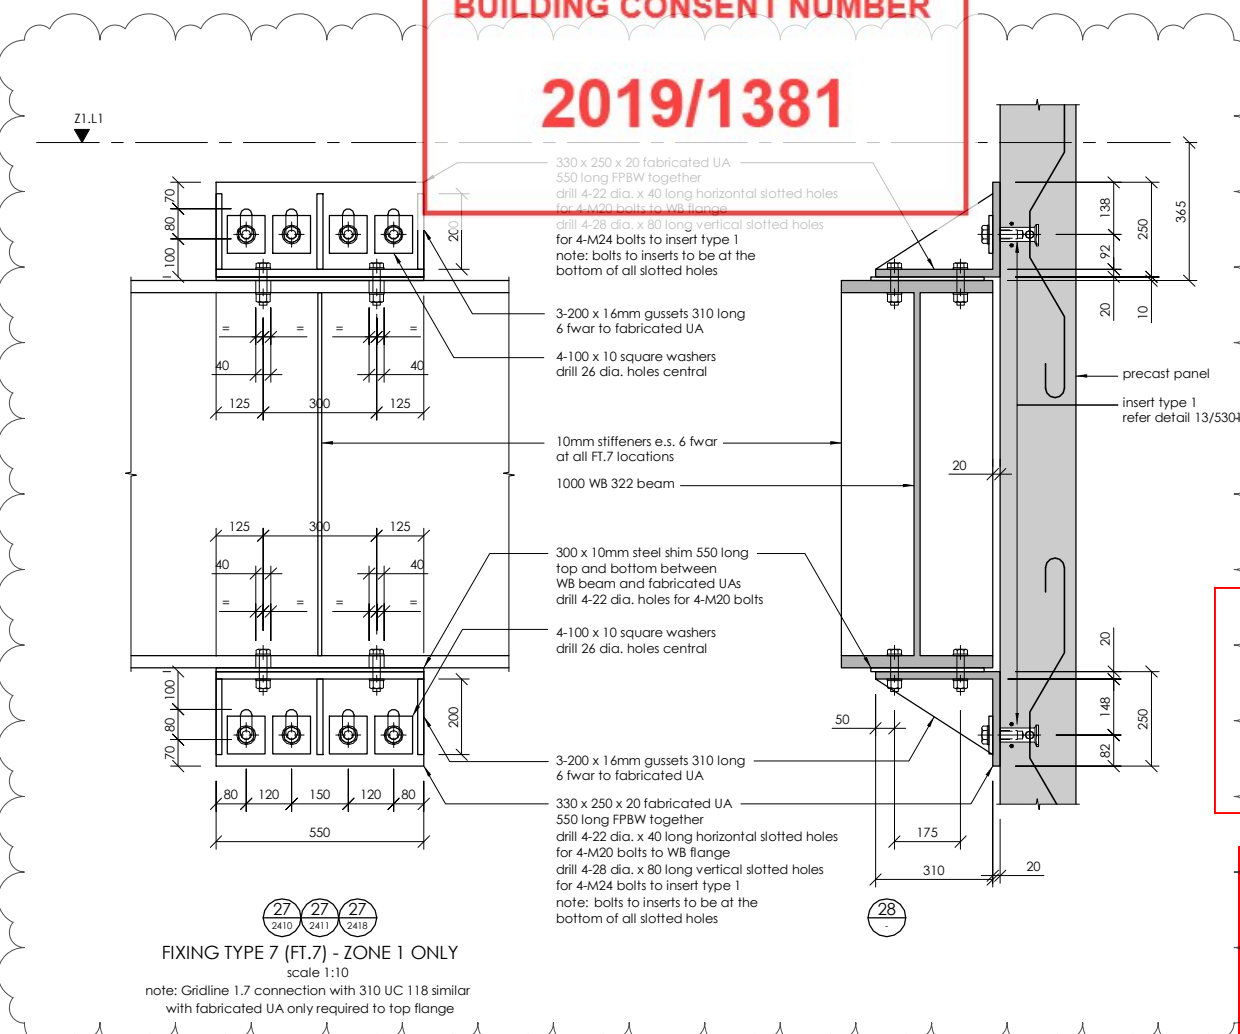

FIXING TYPE 7 (FT.7) - ZONE 1 ONLY
scale 1:10
note: Gridline 1.7 connection with 310 UC 118 similar
with fabricated UA only required to top flange

THIS DRAWING AND ALL INFORMATION CONTAINED WITHIN IS THE PROPERTY OF LEWIS BRADFORD. ITS CONTENTS ARE CONFIDENTIAL AND MUST NOT BE REPRODUCED OR DISTRIBUTED TO ANY OTHER PERSON OR COMPANY UNLESS AGREED TO IN WRITING BY LEWIS BRADFORD

CONTRACTOR TO VERIFY ALL DIMENSIONS ON SITE REFER TO ARCHITECT'S DRAWING FOR ALL SETOUTS

NOTES:
Refer drawing 0002 for standard notes. Refer also to Structural Specification

note: apply intumescent fire protection with equivalent FRR to connections to all elements shown on plans/elevations designated with a *, ** or ***

Where unprotected areas of steelwork meet fire protected elements overlap the fire protection onto the adjoining 500mm of 'unprotected' structural steel

Invercargill City Council
Building Consent Authority
Approved Site Copy

Approved For Issue
27/02/2020

REV	DATE	AMENDMENT	BY
2	25.10.19	CONSENT ISSUE	GPW
1	27.09.19	PEER REVIEW ISSUE	GPW

CLIENT:
HWCP

lewis bradford
CONSULTING ENGINEERS

PROJECT:
**INVERCARGILL CENTRAL
ZONE 1 ANCHOR**

DRAWING TITLE:
**TYPICAL PRECAST PANEL
DETAILS
SHEET 3**

DRAWN: GPW	SCALE: 1 : 20 at A1
ENGINEER: EL/TSS	
CHECKED: -	
118083-Z1-WD-ST 5302	REV. 2

17 Dec 2019

Building Division


BUILDING CONSENT NUMBER
2019/1381

THIS DRAWING AND ALL INFORMATION CONTAINED WITHIN IS THE PROPERTY OF LEWIS BRADFORD. ITS CONTENTS ARE CONFIDENTIAL AND MUST NOT BE REPRODUCED OR DISTRIBUTED TO ANY OTHER PERSON OR COMPANY UNLESS AGREED TO IN WRITING BY LEWIS BRADFORD



CONTRACTOR TO VERIFY ALL DIMENSIONS ON SITE REFER TO ARCHITECT'S DRAWING FOR ALL SETOUTS

NOTES :


Refer drawing 0002 for standard notes.
Refer also to Structural Specification.

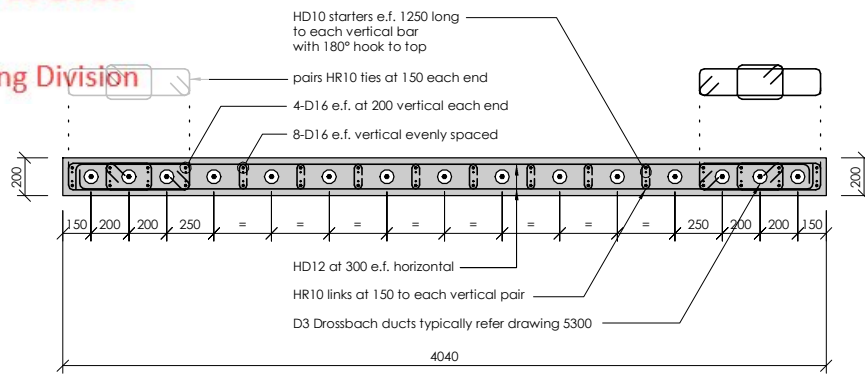

TYPICAL SEISMIC PANEL SECTION - GROUND LEVEL

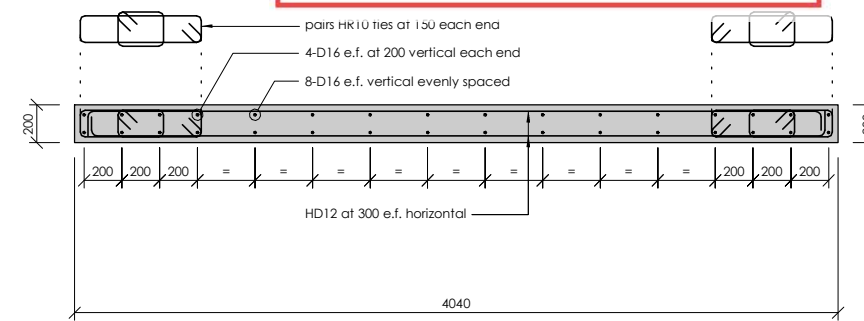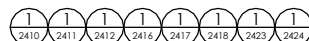


TYPICAL SEISMIC PANEL SECTION - ABOVE Z1.L1

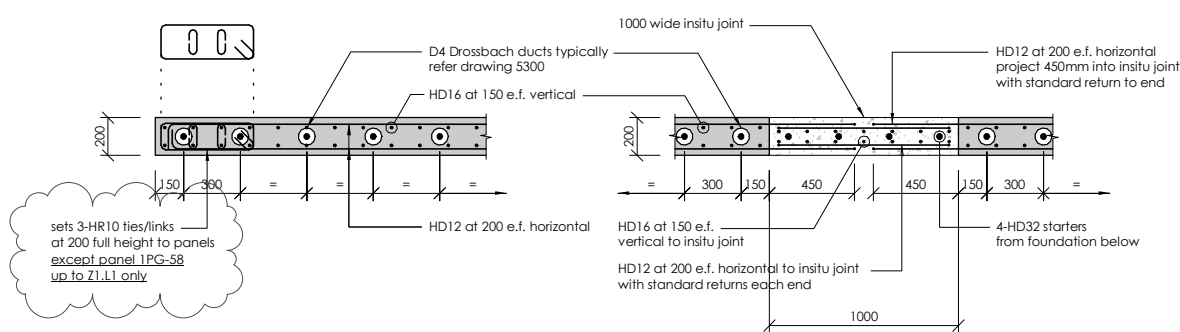


3
2420


4
2420

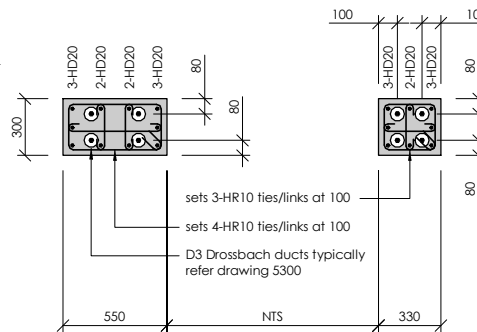


5
2413

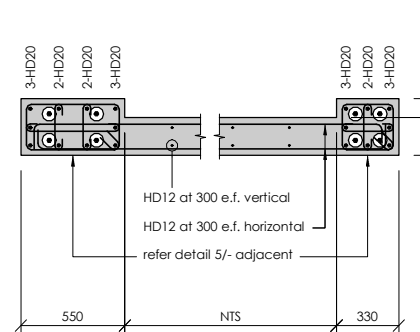

6
2413

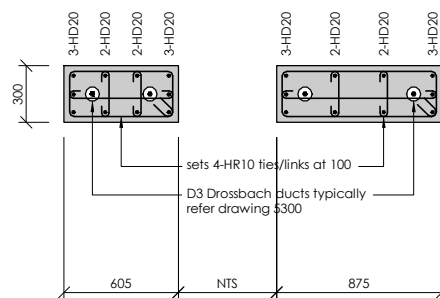

7
2414

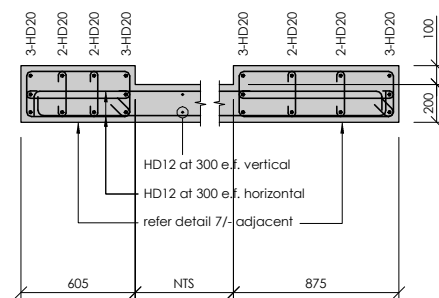

8
2414

Invercargill City
Council
Building Consent
Authority
Approved Site Copy

Approved For Issue
27/02/2020

REV	DATE	AMENDMENT	BY
2	25.10.19	CONSENT ISSUE	GPW
1	27.09.19	PEER REVIEW ISSUE	GPW

CLIENT:
HWCP

lewis bradford
CONSULTING ENGINEERS

PROJECT:
**INVERCARGILL CENTRAL
ZONE 1 ANCHOR**


DRAWING TITLE:
**PRECAST PANEL
DETAILS
SHEET 1**

DRAWN: GPW	SCALE:
ENGINEER: EL/TSS	1 : 20 at A1
CHECKED: -	
118083-Z1-WD-ST 5310	REV. 2

17 Dec 2019

Building Division

65 dia. duct with grout tube each end
solid fill with 45MPa low shrink grout

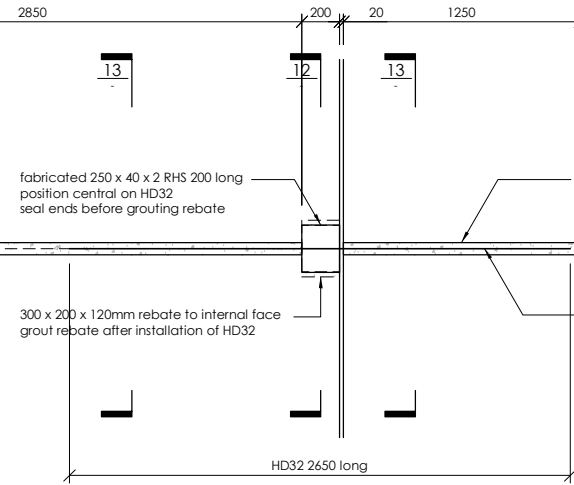


note: HD32 bar to be placed loosely in long duct
prior to erection of precast panels then slid across
into panel with the shorter duct

11
2416
HD32 TENSION TIE DETAIL

65 dia. duct with grout tube each end
solid fill with 45MPa low shrink grout

HD32 bar 2650 long
hot dip galvanised

HD32 bar 2650 long
hot dip galvanised

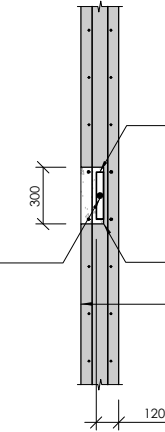


12

BUILDING CONSENT NUMBER
2019/1381

fabricated 250 x 40 x 2 RHS 200 long
position central on HD32
seal ends before grouting rebate

300 x 200 x 120mm rebate to internal face
grout rebate after installation of HD32

200 thick precast panel
refer panel elevations and detail 13/
reinforcing to continue through rebate

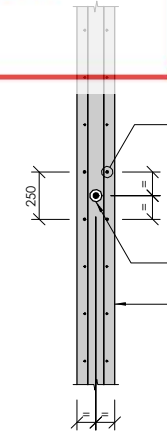

13

2-HD16 at 250 e.f. central on ducts
(4 off total) full width of panel
in lieu of typical panel reinforcing

65 dia. duct with grout tube each end
solid fill with 45MPa low shrink grout

200 thick precast panel
refer panel elevations

THIS DRAWING AND ALL INFORMATION CONTAINED WITHIN IS THE
PROPERTY OF LEWIS BRADFORD. ITS CONTENTS ARE CONFIDENTIAL AND
MUST NOT BE REPRODUCED OR DISTRIBUTED TO ANY OTHER PERSON OR
COMPANY UNLESS AGREED TO IN WRITING BY LEWIS BRADFORD

CONTRACTOR TO VERIFY ALL DIMENSIONS ON SITE
REFER TO ARCHITECT'S DRAWING FOR ALL SETOUTS

NOTES :

Refer drawing 0002 for standard notes.
Refer also to Structural Specification.

**Invercargill City
Council
Building Consent
Authority
Approved Site Copy**

**Approved For Issue
27/02/2020**

REV	DATE	AMENDMENT	BY
2	25.10.19	CONSENT ISSUE	GPW
1	27.09.19	PEER REVIEW ISSUE	GPW

CLIENT:
HWCP

lewis bradford
CONSULTING ENGINEERS


PROJECT:
**INVERCARGILL CENTRAL
ZONE 1 ANCHOR**

DRAWING TITLE:
**PRECAST PANEL
DETAILS
SHEET 2**

DRAWN: GPW	SCALE: 1 : 20 at A1
ENGINEER: EL/TSS	
CHECKED: -	
118083-Z1-WD-ST 5311	REV. 2


17 Dec 2019

Building Division

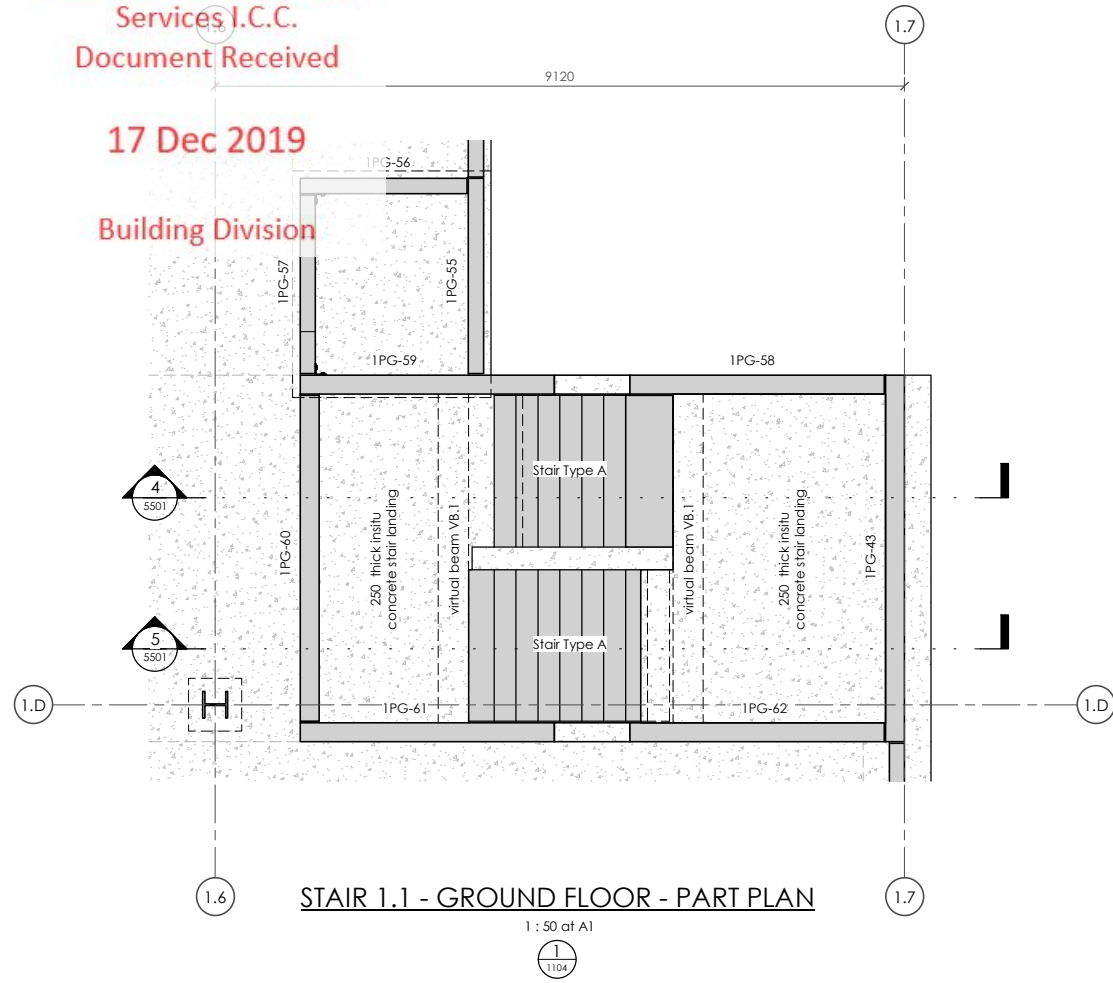


STAIR 1.1 - GROUND FLOOR - PART PLAN

1 : 50 at A1
1
1104

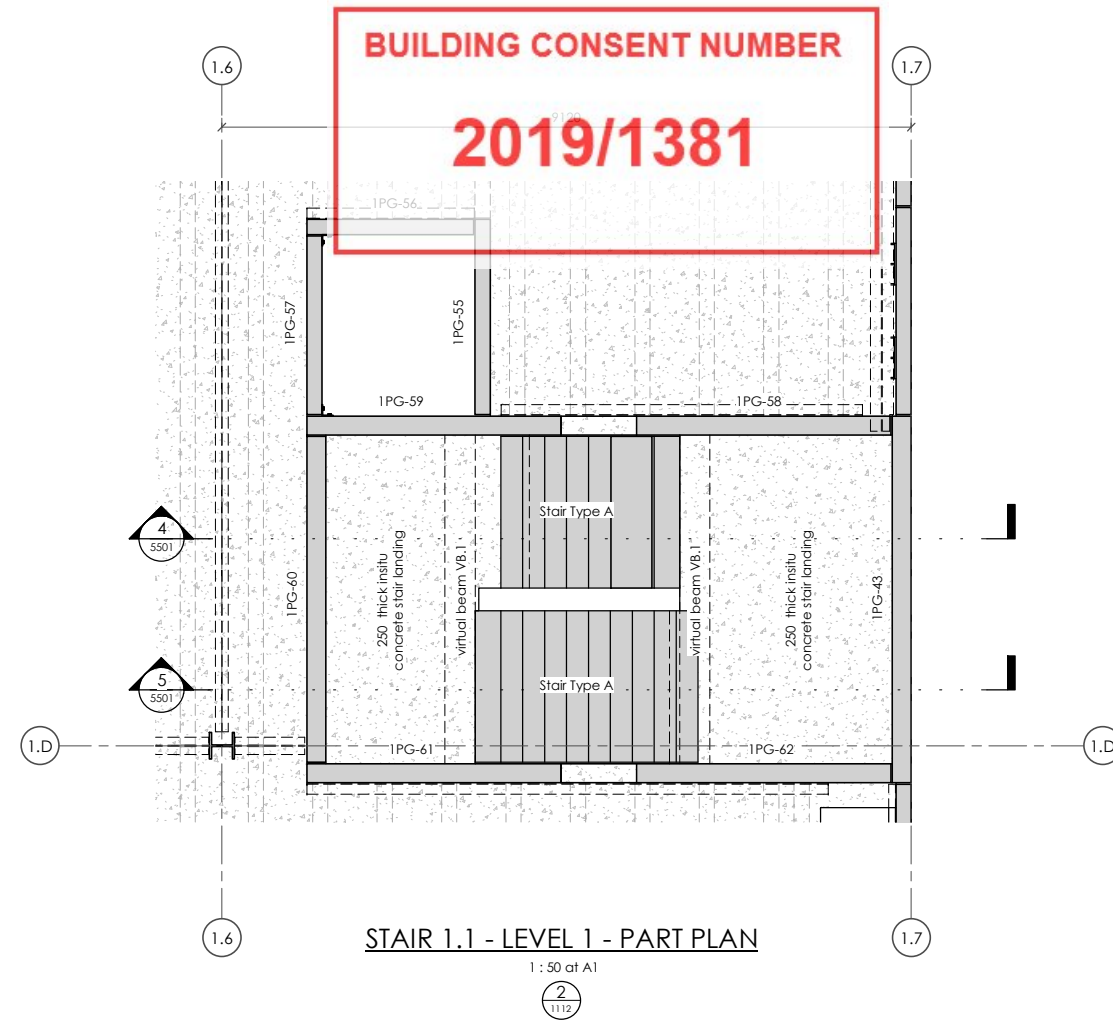

STAIR 1.1 - LEVEL 1 - PART PLAN

1 : 50 at A1
2
1112

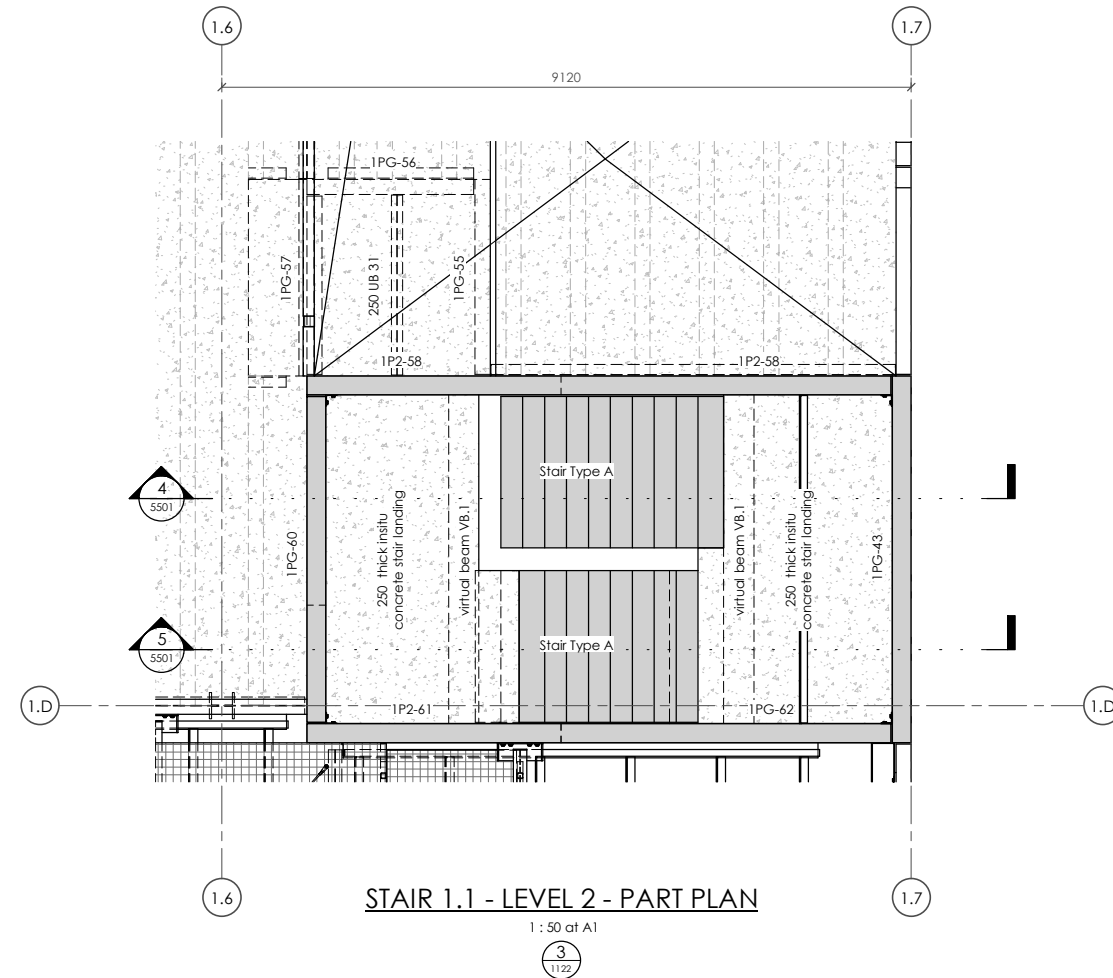

STAIR 1.1 - LEVEL 2 - PART PLAN

1 : 50 at A1
3
1122

THIS DRAWING AND ALL INFORMATION CONTAINED WITHIN IS THE PROPERTY OF LEWIS BRADFORD. ITS CONTENTS ARE CONFIDENTIAL AND MUST NOT BE REPRODUCED OR DISTRIBUTED TO ANY OTHER PERSON OR COMPANY UNLESS AGREED TO IN WRITING BY LEWIS BRADFORD

CONTRACTOR TO VERIFY ALL DIMENSIONS ON SITE REFER TO ARCHITECT'S DRAWING FOR ALL SETOUTS

NOTES :

Refer drawing 0002 for standard notes.
Refer also to Structural Specification.


Invercargill City
Council
Building Consent
Authority
Approved Site Copy

Approved For Issue
27/02/2020

REV	DATE	AMENDMENT	BY
2	25.10.19	CONSENT ISSUE	GPW
1	27.09.19	PEER REVIEW ISSUE	GPW

CLIENT:

HWCP

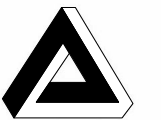

lewis bradford
CONSULTING ENGINEERS

PROJECT:

INVERCARGILL CENTRAL
ZONE 1 ANCHOR

DRAWING TITLE:

STAIR 1.1
PART PLANS

DRAWN: GPW	SCALE: 1 : 50 at A1
ENGINEER: EL/TSS	
CHECKED: -	

118083-Z1-WD-ST 5500 REV. 2

17 Dec 2019


Building Division

BUILDING CONSENT NUMBER
2019/1381

THIS DRAWING AND ALL INFORMATION CONTAINED WITHIN IS THE PROPERTY OF LEWIS BRADFORD. ITS CONTENTS ARE CONFIDENTIAL AND MUST NOT BE REPRODUCED OR DISTRIBUTED TO ANY OTHER PERSON OR COMPANY UNLESS AGREED TO IN WRITING BY LEWIS BRADFORD


CONTRACTOR TO VERIFY ALL DIMENSIONS ON SITE REFER TO ARCHITECT'S DRAWING FOR ALL SETOUTS

NOTES :
Refer drawing 0002 for standard notes.
Refer also to Structural Specification.

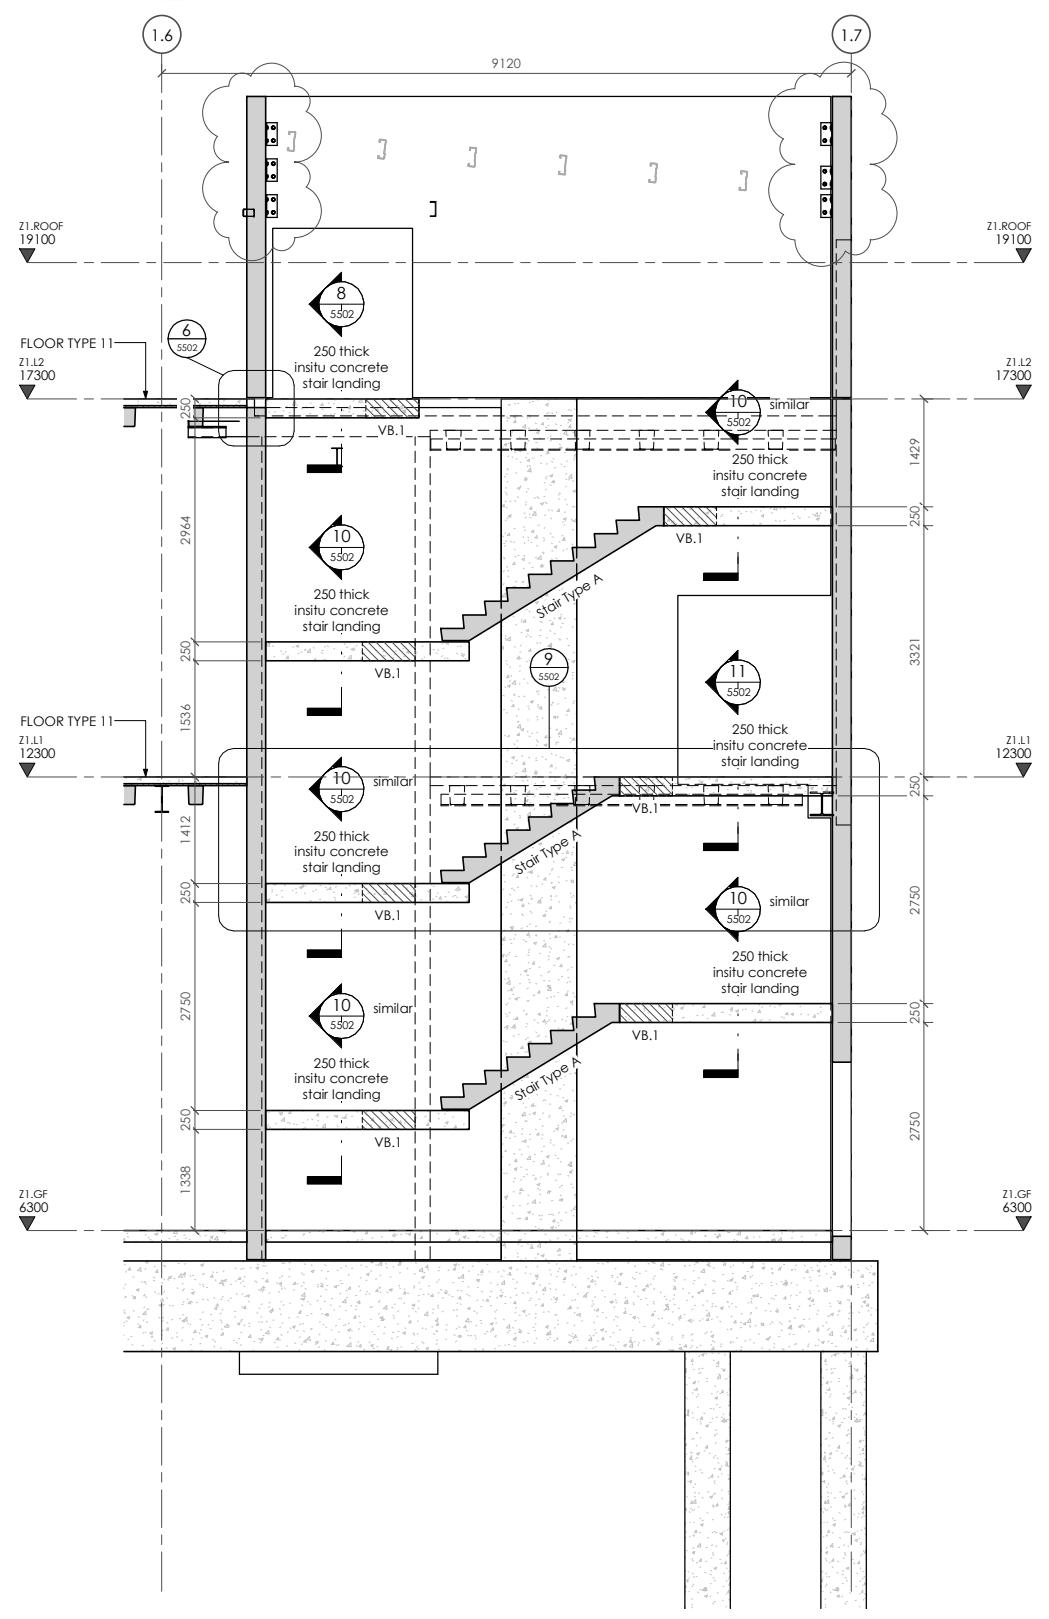

STAIR 1.1 - NORTH ELEVATION

1 : 50 at A1
4
5502

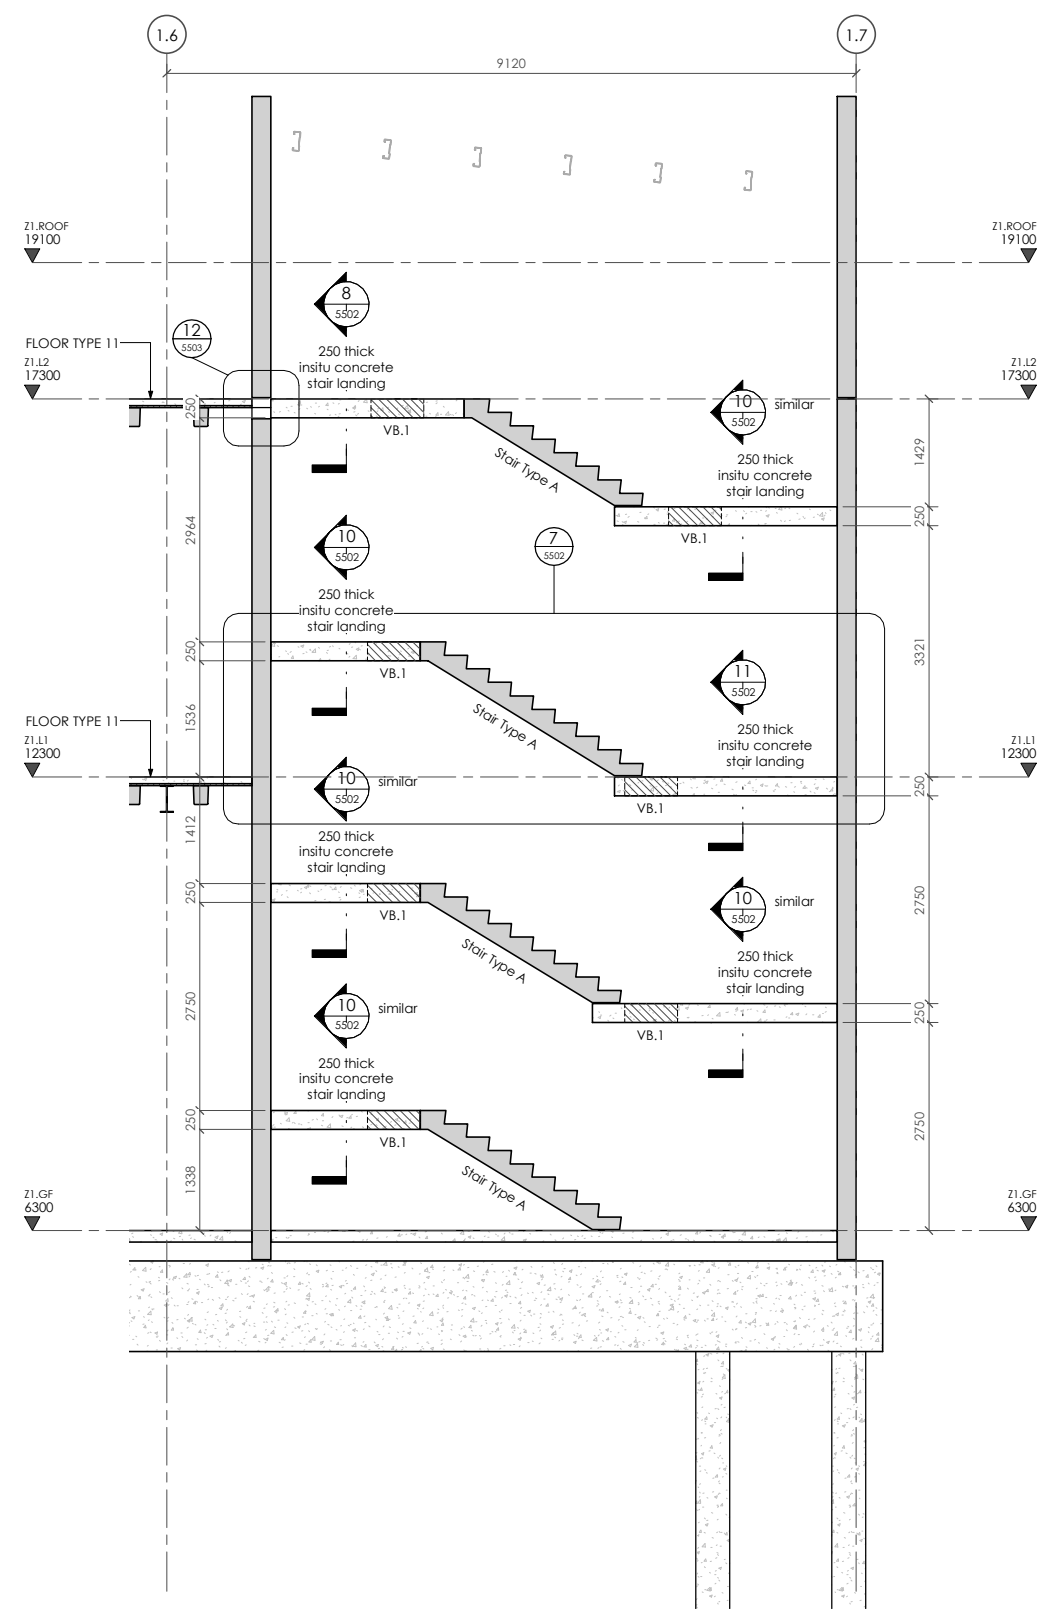

STAIR 1.1 - SOUTH ELEVATION


1 : 50 at A1
5
5502

Invercargill City Council
Building Consent Authority
Approved Site Copy

Approved For Issue
27/02/2020

REV	DATE	AMENDMENT	BY
2	25.10.19	CONSENT ISSUE	GPW
1	27.09.19	PEER REVIEW ISSUE	GPW

CLIENT:
HWCP

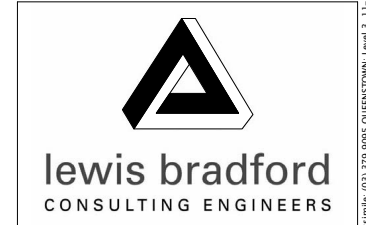


PROJECT:
INVERCARGILL CENTRAL ZONE 1 ANCHOR

DRAWING TITLE:
STAIR 1.1 ELEVATIONS

DRAWN: GPW	SCALE: 1 : 50 at A1
ENGINEER: EL/TSS	
CHECKED: -	
118083-Z1-WD-ST 5501	REV. 2

17 Dec 2019

Building Division

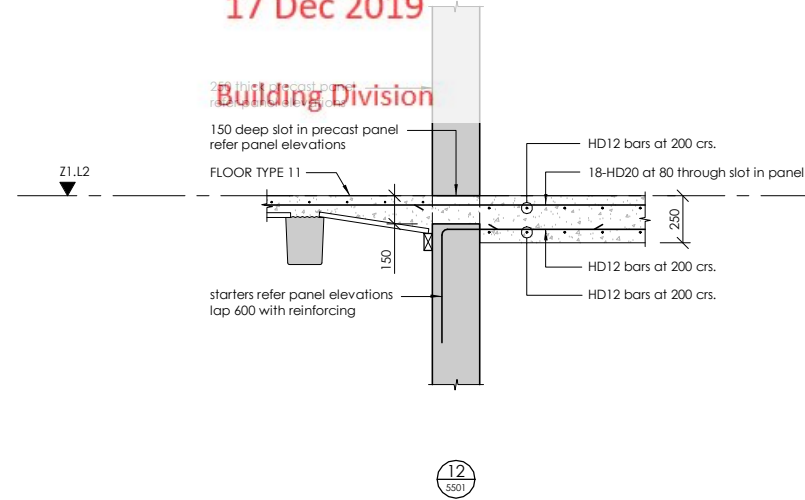

BUILDING CONSENT NUMBER
2019/1381

THIS DRAWING AND ALL INFORMATION CONTAINED WITHIN IS THE PROPERTY OF LEWIS BRADFORD. ITS CONTENTS ARE CONFIDENTIAL AND MUST NOT BE REPRODUCED OR DISTRIBUTED TO ANY OTHER PERSON OR COMPANY UNLESS AGREED TO IN WRITING BY LEWIS BRADFORD

CONTRACTOR TO VERIFY ALL DIMENSIONS ON SITE REFER TO ARCHITECT'S DRAWING FOR ALL SETOUTS


NOTES :
Refer drawing 0002 for standard notes.
Refer also to Structural Specification.

Invercargill City Council
Building Consent Authority
Approved Site Copy

Approved For Issue
27/02/2020

REV	DATE	AMENDMENT	BY
2	25.10.19	CONSENT ISSUE	GPW
1	27.09.19	PEER REVIEW ISSUE	GPW

CLIENT:
HWCP


lewis bradford
CONSULTING ENGINEERS

PROJECT:
**INVERCARGILL CENTRAL
ZONE 1 ANCHOR**

DRAWING TITLE:
**STAIR 1.1
DETAILS
SHEET 2**


DRAWN: GPW	SCALE: 1 : 20 at A1
ENGINEER: EL/TSS	
CHECKED: -	
118083-Z1-WD-ST 5503	REV. 2

BUILDING CONSENT NUMBER
2019/1381

THIS DRAWING AND ALL INFORMATION CONTAINED WITHIN IS THE PROPERTY OF LEWIS BRADFORD. ITS CONTENTS ARE CONFIDENTIAL AND MUST NOT BE REPRODUCED OR DISTRIBUTED TO ANY OTHER PERSON OR COMPANY UNLESS AGREED TO IN WRITING BY LEWIS BRADFORD

CONTRACTOR TO VERIFY ALL DIMENSIONS ON SITE REFER TO ARCHITECT'S DRAWING FOR ALL SETOUTS


NOTES:
 Refer drawing 0002 for standard notes.
 Refer also to Structural Specification.

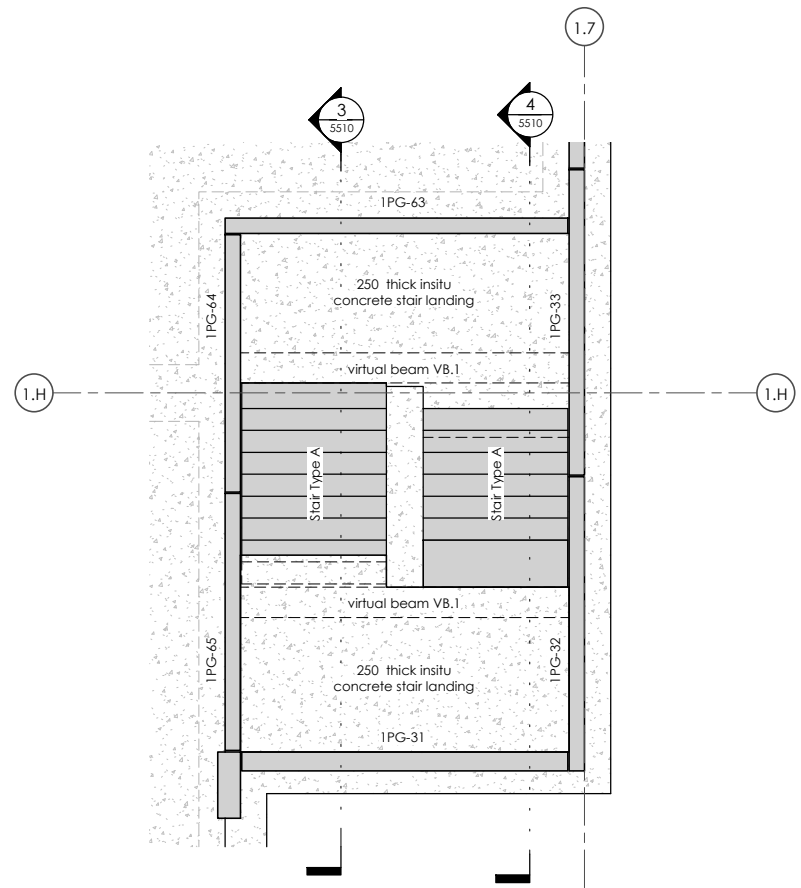

STAIR 1.2 - GROUND FLOOR - PART PLAN

1 : 50 at A1


1
1105

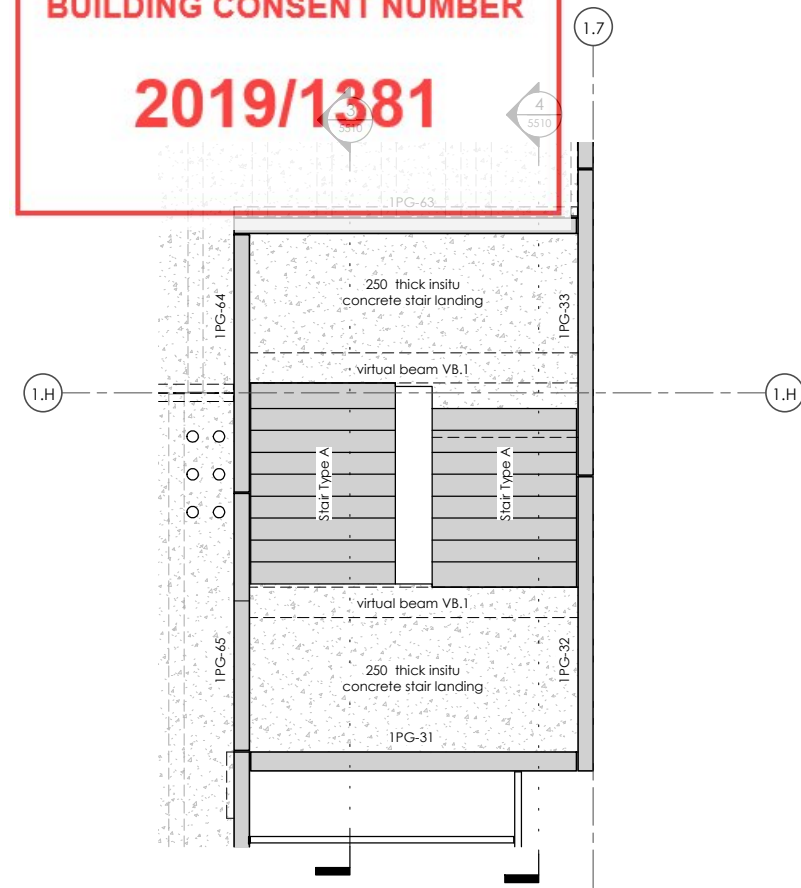

STAIR 1.2 - LEVEL 1 - PART PLAN

1 : 50 at A1


2
1115

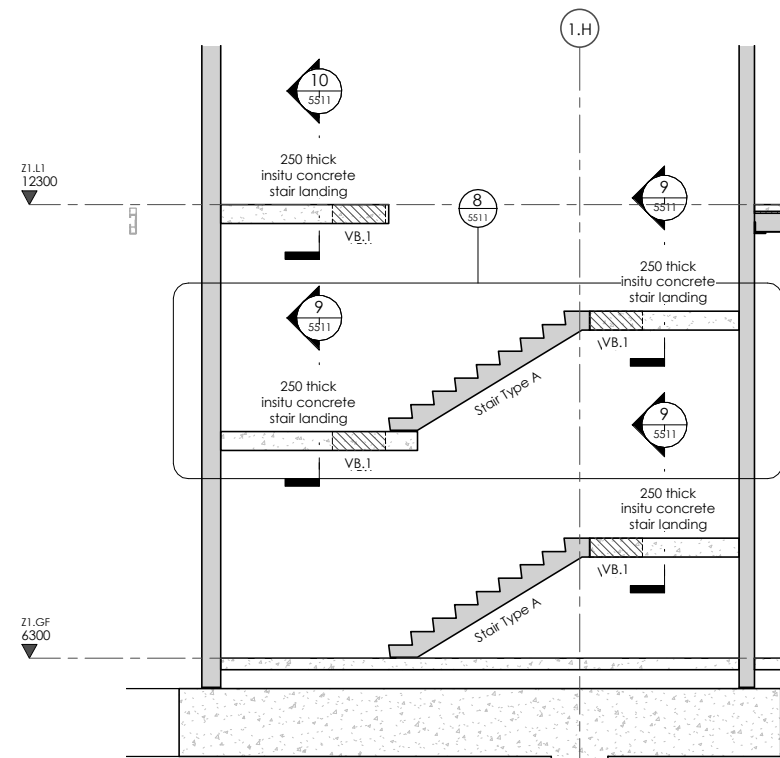

STAIR 1.2 - WEST ELEVATION

1 : 50 at A1

3
5510

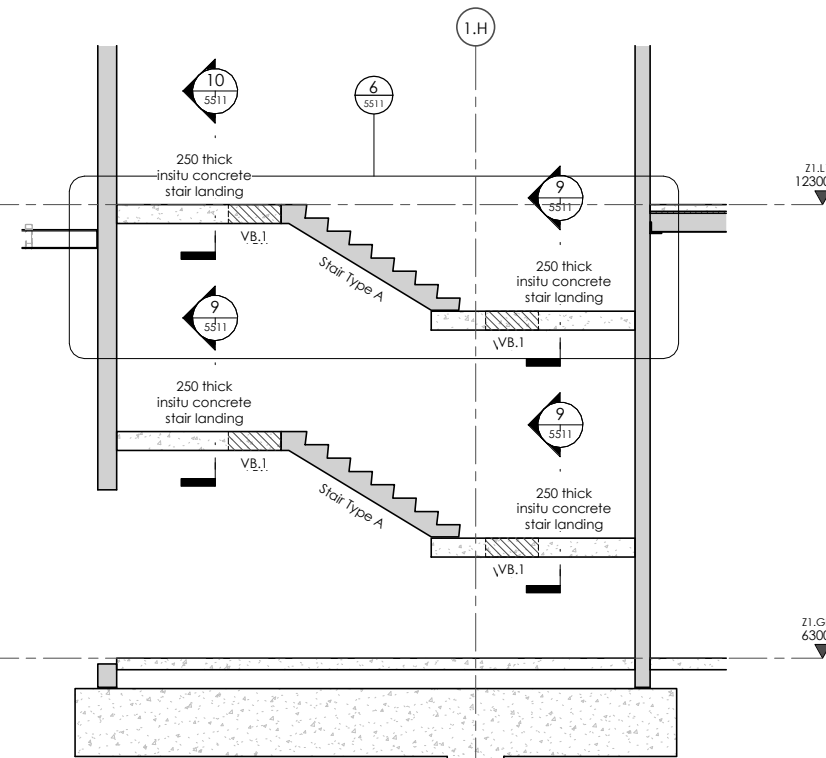

STAIR 1.2 - EAST ELEVATION

1 : 50 at A1

4
5510

Invercargill City
 Council
 Building Consent
 Authority
 Approved Site Copy

Approved For Issue
 27/02/2020

REV	DATE	AMENDMENT	BY
2	25.10.19	CONSENT ISSUE	GPW
1	27.09.19	PEER REVIEW ISSUE	GPW

CLIENT:
HWCP

lewis bradford
 CONSULTING ENGINEERS

PROJECT:
**INVERCARGILL CENTRAL
 ZONE 1 ANCHOR**

DRAWING TITLE:
**STAIR 1.2
 PART PLANS AND
 ELEVATIONS**

DRAWN: GPW	SCALE: 1 : 50 at A1
ENGINEER: EL/TSS	
CHECKED: -	
118083-Z1-WD-ST 5510	REV. 2

17 Dec 2019

Building Division

BUILDING CONSENT NUMBER
1.H
2019/1381

THIS DRAWING AND ALL INFORMATION CONTAINED WITHIN IS THE PROPERTY OF LEWIS BRADFORD. ITS CONTENTS ARE CONFIDENTIAL AND MUST NOT BE REPRODUCED OR DISTRIBUTED TO ANY OTHER PERSON OR COMPANY UNLESS AGREED TO IN WRITING BY LEWIS BRADFORD

CONTRACTOR TO VERIFY ALL DIMENSIONS ON SITE REFER TO ARCHITECT'S DRAWING FOR ALL SETOUTS

NOTES:
Refer drawing 0002 for standard notes.
Refer also to Structural Specification.

**Invercargill City Council
Building Consent Authority
Approved Site Copy**

**Approved For Issue
27/02/2020**

REV	DATE	AMENDMENT	BY
2	25.10.19	CONSENT ISSUE	GPW
1	27.09.19	PEER REVIEW ISSUE	GPW


CLIENT:
HWCP

lewis bradford
CONSULTING ENGINEERS

PROJECT:
**INVERCARGILL CENTRAL
ZONE 1 ANCHOR**

DRAWING TITLE:
**STAIR 1.2
DETAILS
SHEET 1**

DRAWN: GPW	SCALE: 1 : 20 at A1
ENGINEER: EL/TSS	
CHECKED: -	
118083-Z1-WD-ST 5511	REV. 2

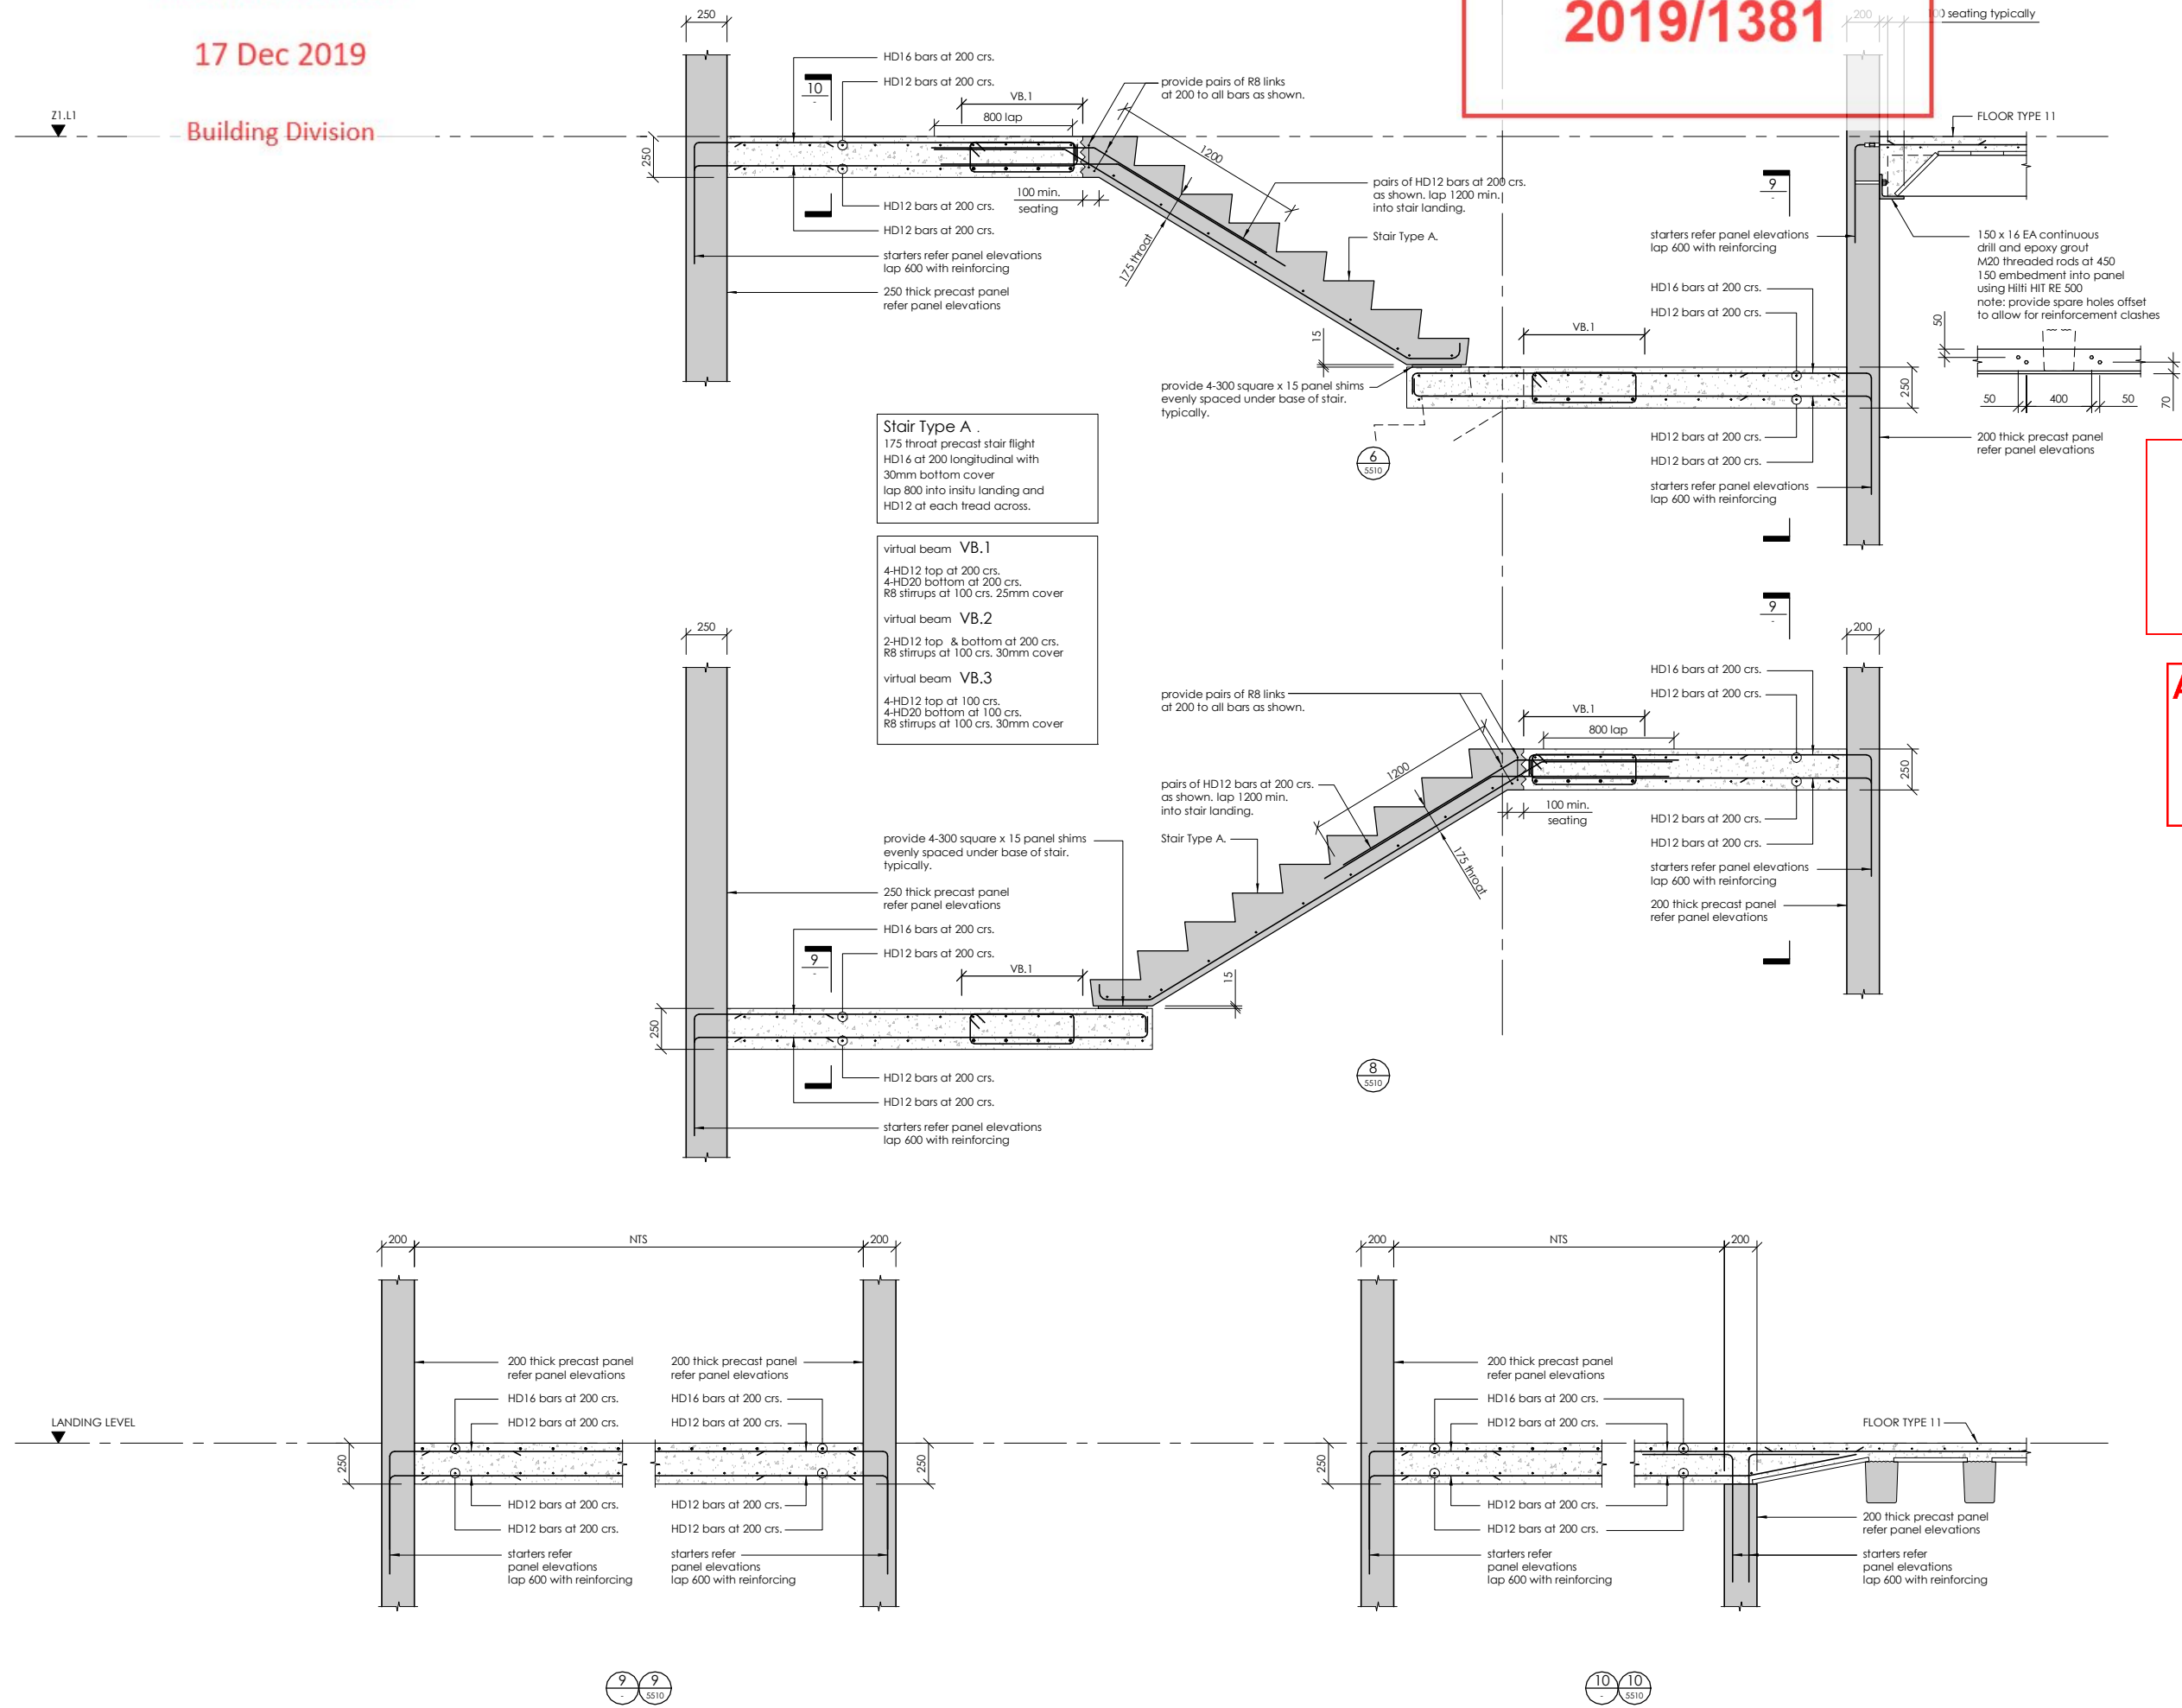

Stair Type A
175 throat precast stair flight
HD16 at 200 longitudinal with
30mm bottom cover
lap 800 into insitu landing and
HD12 at each tread across.

virtual beam VB.1
4-HD12 top at 200 crs.
4-HD20 bottom at 200 crs.
R8 stirrups at 100 crs. 25mm cover

virtual beam VB.2
2-HD12 top & bottom at 200 crs.
R8 stirrups at 100 crs. 30mm cover

virtual beam VB.3
4-HD12 top at 100 crs.
4-HD20 bottom at 100 crs.
R8 stirrups at 100 crs. 30mm cover

17 Dec 2019

Building Division

BUILDING CONSENT NUMBER
2019/1381

THIS DRAWING AND ALL INFORMATION CONTAINED WITHIN IS THE PROPERTY OF LEWIS BRADFORD. ITS CONTENTS ARE CONFIDENTIAL AND MUST NOT BE REPRODUCED OR DISTRIBUTED TO ANY OTHER PERSON OR COMPANY UNLESS AGREED TO IN WRITING BY LEWIS BRADFORD

CONTRACTOR TO VERIFY ALL DIMENSIONS ON SITE REFER TO ARCHITECT'S DRAWING FOR ALL SETOUTS

NOTES:
Refer drawing 0002 for standard notes.
Refer also to Structural Specification

note: apply intumescent fire protection with equivalent FRR to connections to all elements shown on plans/elevations designated with a *, ** or ***

Where unprotected areas of steelwork meet fire protected elements overlap the fire protection onto the adjoining 500mm of 'unprotected' structural steel

Invercargill City Council
Building Consent Authority
Approved Site Copy

Approved For Issue
27/02/2020

REV	DATE	AMENDMENT	BY
2	25.10.19	CONSENT ISSUE	GPW
1	27.09.19	PEER REVIEW ISSUE	GPW


CLIENT:
HWCP

lewis bradford
CONSULTING ENGINEERS

PROJECT:
INVERCARGILL CENTRAL ZONE 1 ANCHOR


DRAWING TITLE:
ZONE 1 BASEPLATE DETAILS SHEET 1

DRAWN: GPW	SCALE: 1 : 10 at A1
ENGINEER: EL/TSS	
CHECKED: -	
118083-Z1-WD-ST 5601	REV. 2

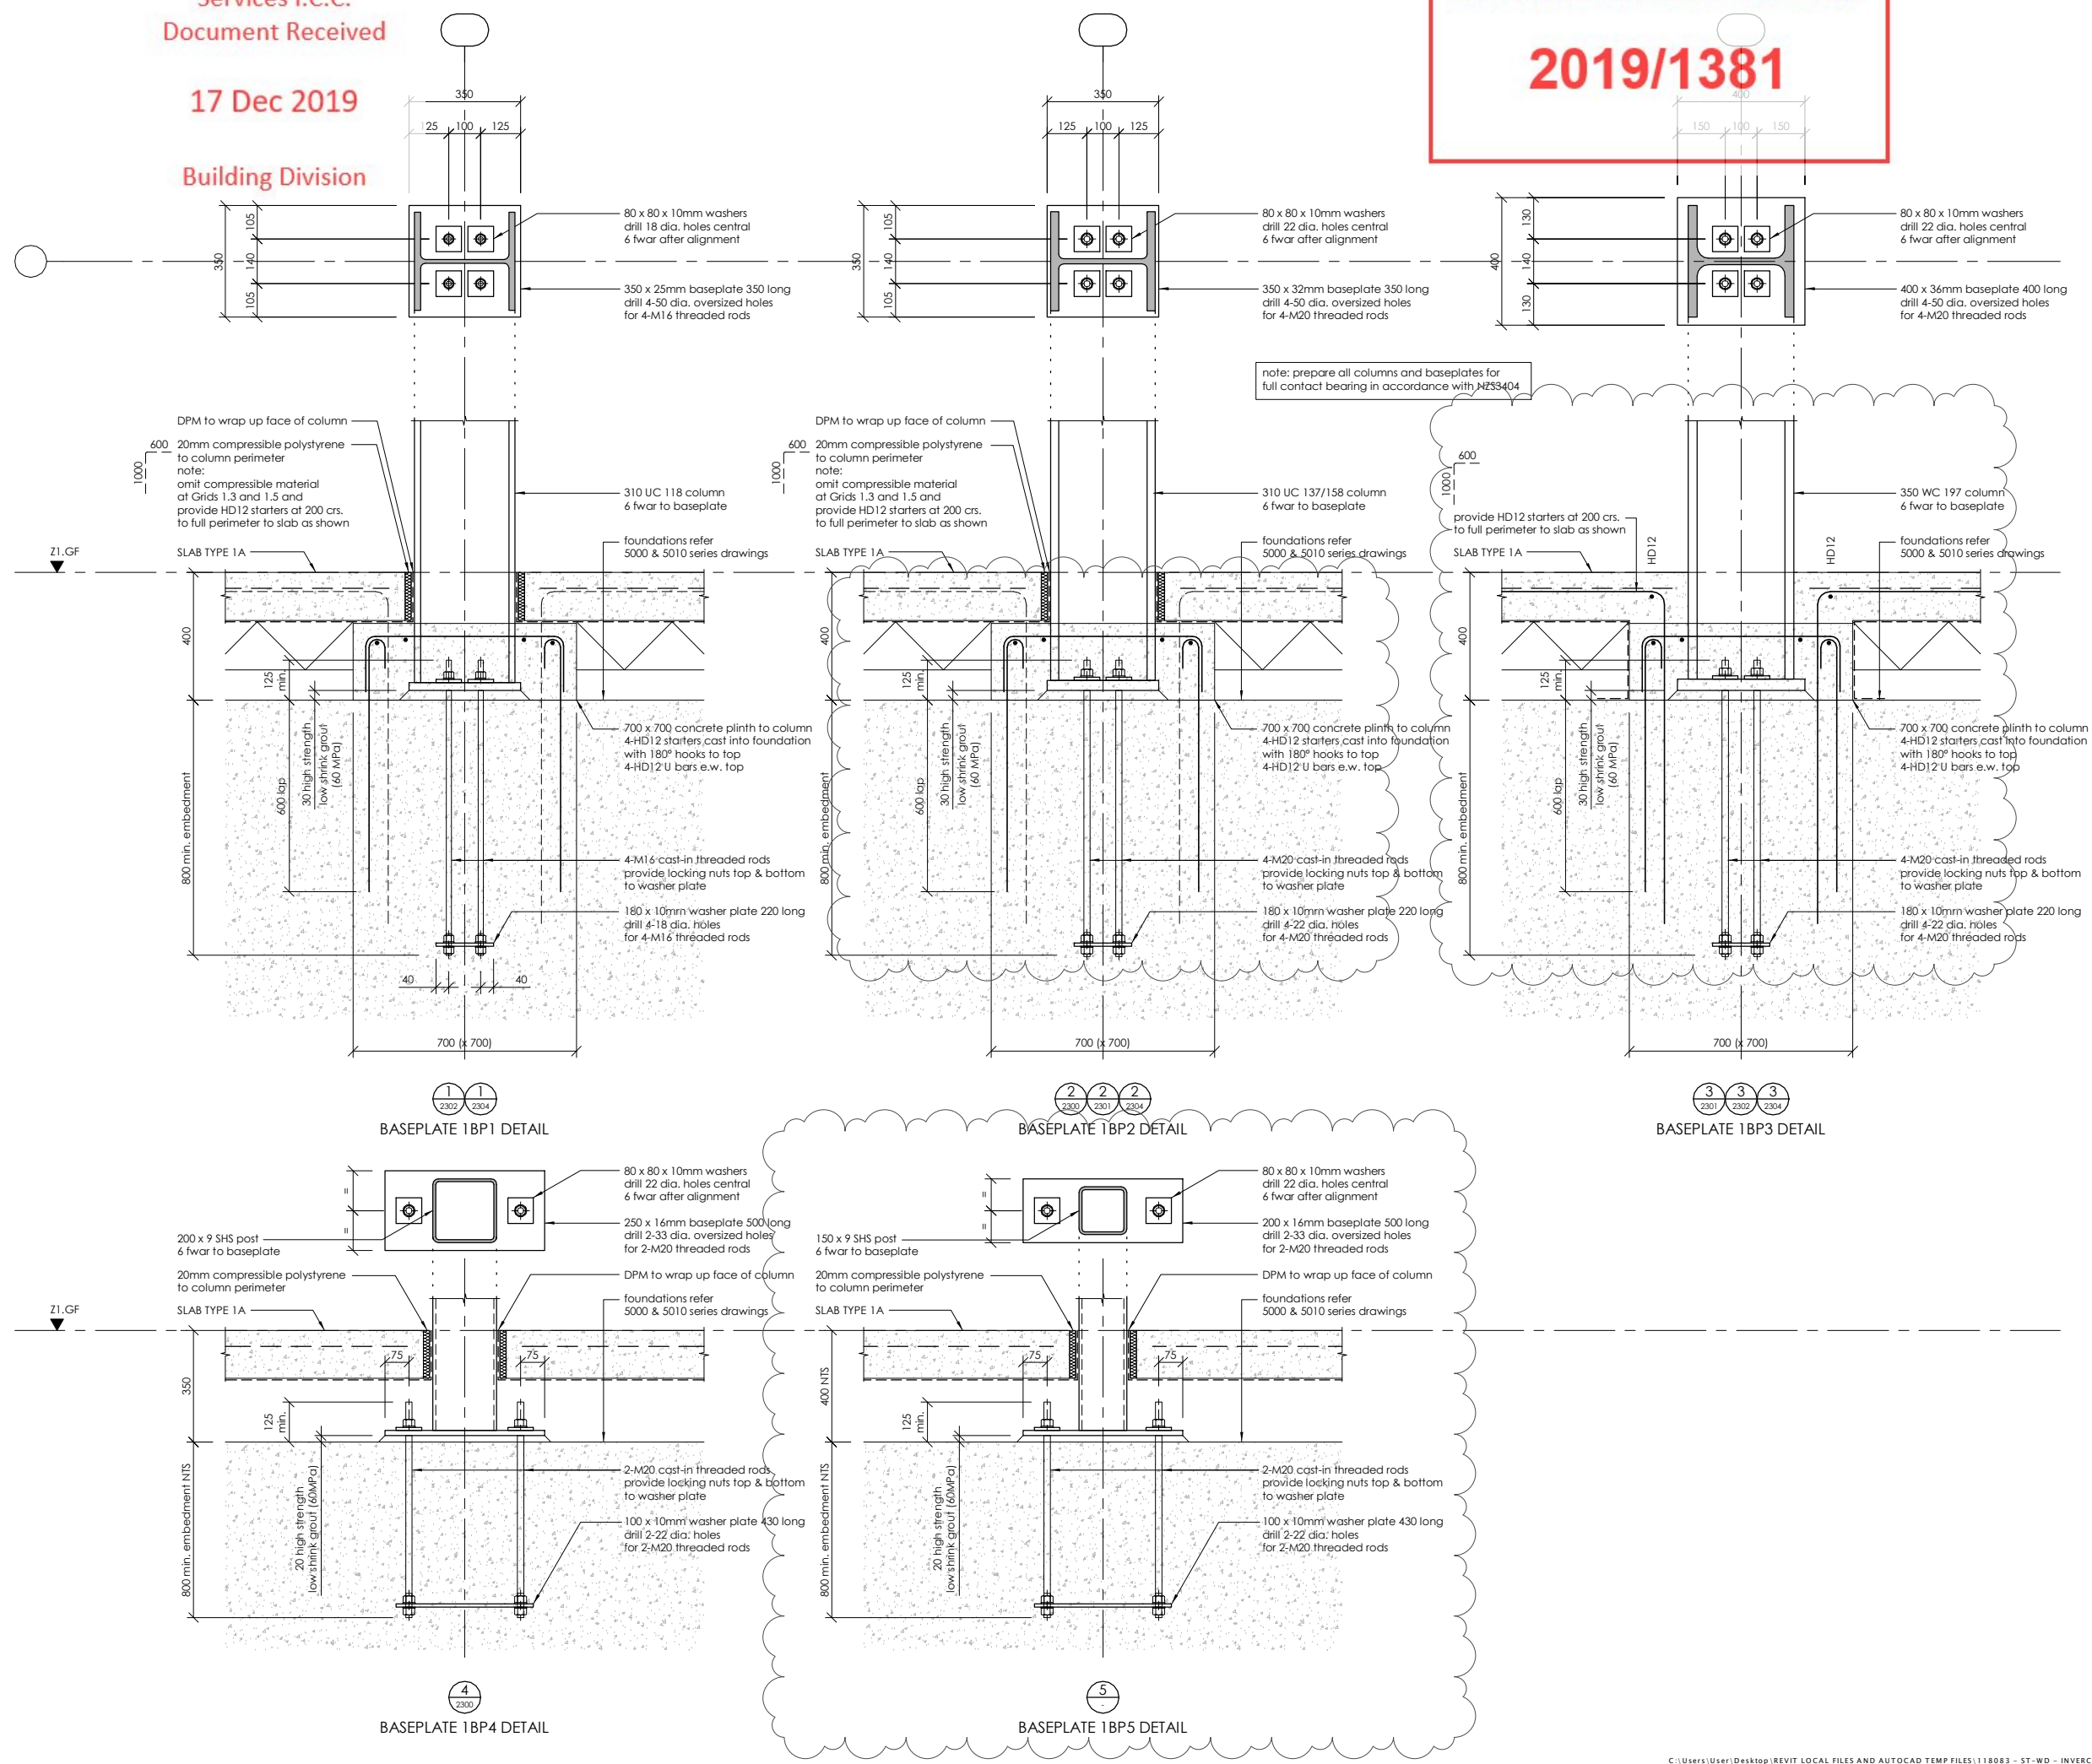

17 Dec 2019

Building Division

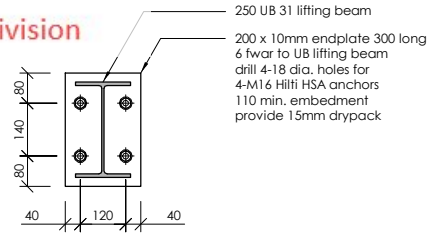

TYPICAL LIFTING BEAM CONNECTION
TO PRECAST PANEL

BUILDING CONSENT NUMBER

2019/1381

THIS DRAWING AND ALL INFORMATION CONTAINED WITHIN IS THE PROPERTY OF LEWIS BRADFORD. ITS CONTENTS ARE CONFIDENTIAL AND MUST NOT BE REPRODUCED OR DISTRIBUTED TO ANY OTHER PERSON OR COMPANY UNLESS AGREED TO IN WRITING BY LEWIS BRADFORD

CONTRACTOR TO VERIFY ALL DIMENSIONS ON SITE
REFER TO ARCHITECT'S DRAWING FOR ALL SETOUTS

NOTES :

Refer drawing 0002 for standard notes.
Refer also to Structural Specification

note: apply intumescent fire protection with equivalent FRR to connections to all elements shown on plans/elevations designated with a *, ** or ***

Where unprotected areas of steelwork meet fire protected elements overlap the fire protection onto the adjoining 500mm of 'unprotected' structural steel

Invercargill City
Council
Building Consent
Authority
Approved Site Copy

Approved For Issue
27/02/2020

REV	DATE	AMENDMENT	BY
2	25.10.19	CONSENT ISSUE	GPW
1	27.09.19	PEER REVIEW ISSUE	GPW

CLIENT:

HWCP



lewis bradford
CONSULTING ENGINEERS

PROJECT:

INVERCARGILL CENTRAL
ZONE 1 ANCHOR

DRAWING TITLE:

TYPICAL
STEELWORK DETAILS
SHEET 1

DRAWN:	ENGINEER:	CHECKED:	SCALE:
GPW	EL/TSS	-	1 : 10 at A1

118083-Z1-WD-ST 5610 REV. 2

17 Dec 2019







Building Division

BUILDING CONSENT NUMBER
2019/1381

THIS DRAWING AND ALL INFORMATION CONTAINED WITHIN IS THE PROPERTY OF LEWIS BRADFORD. ITS CONTENTS ARE CONFIDENTIAL AND MUST NOT BE REPRODUCED OR DISTRIBUTED TO ANY OTHER PERSON OR COMPANY UNLESS AGREED TO IN WRITING BY LEWIS BRADFORD

CONTRACTOR TO VERIFY ALL DIMENSIONS ON SITE REFER TO ARCHITECT'S DRAWING FOR ALL SETOUTS

NOTES:
Refer drawing 0002 for standard notes. Refer also to Structural Specification
note: apply intumescent fire protection with equivalent FRR to connections to all elements shown on plans/elevations designated with a *, ** or ***
Where unprotected areas of steelwork meet fire protected elements overlap the fire protection onto the adjoining 500mm of 'unprotected' structural steel

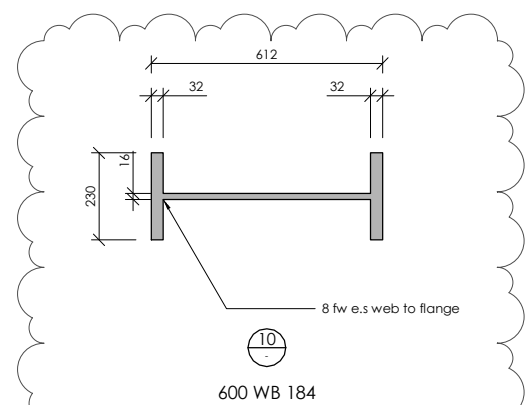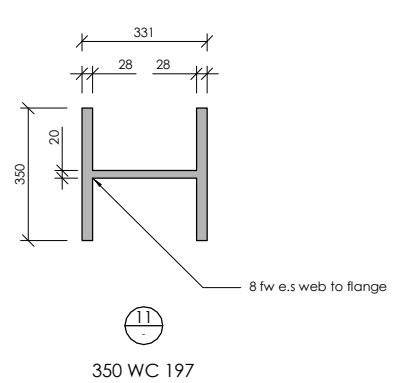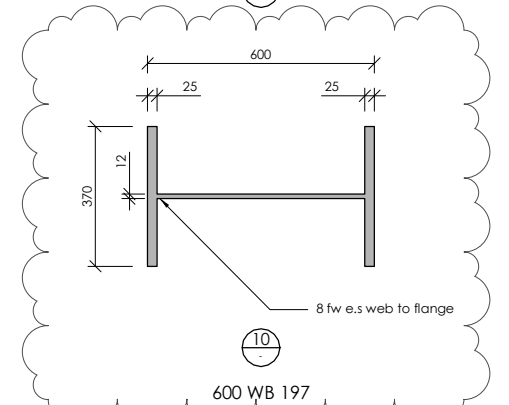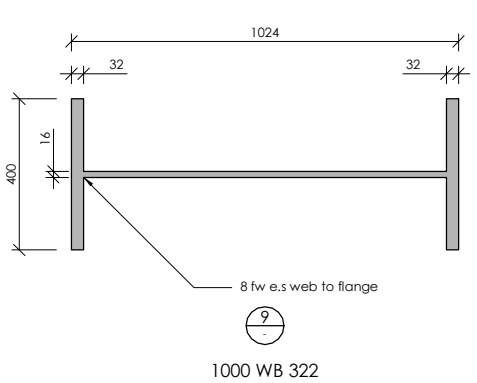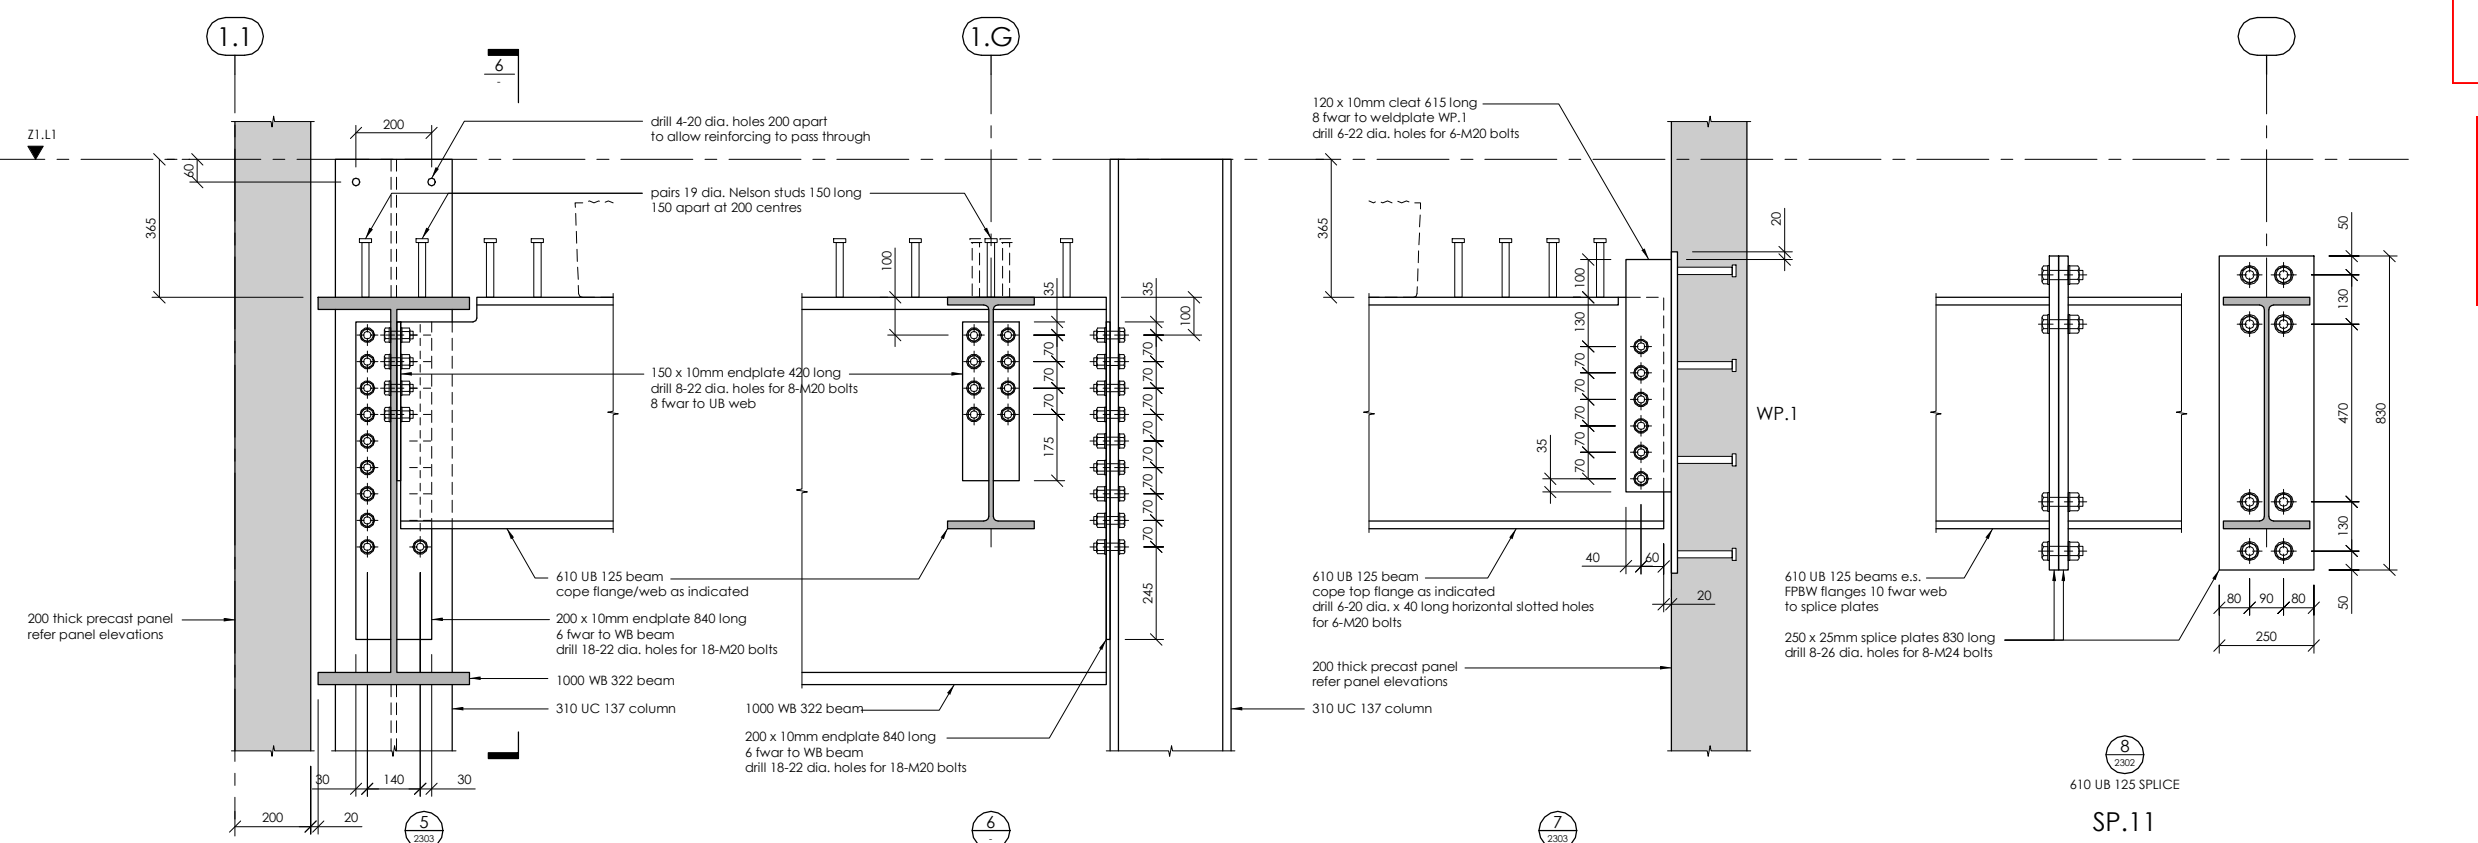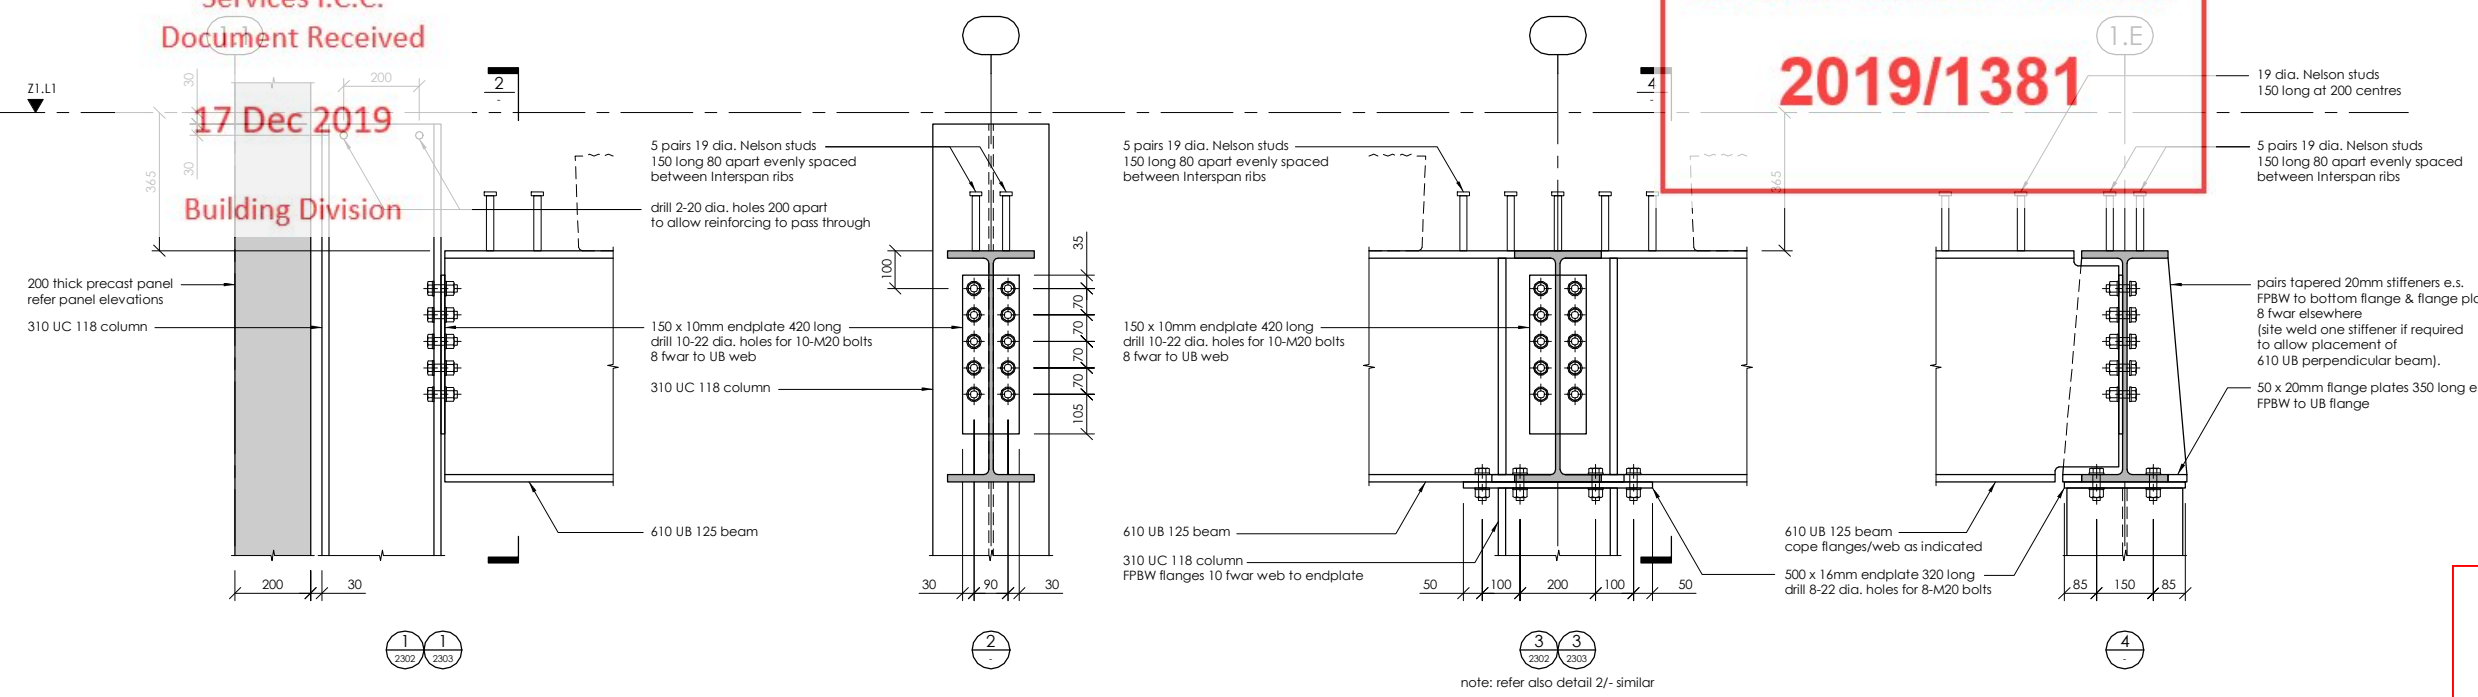

CUSTOM STEEL BEAMS AND COLUMNS

Invercargill City Council
Building Consent Authority
Approved Site Copy

Approved For Issue
27/02/2020

REV	DATE	AMENDMENT	BY
2	25.10.19	CONSENT ISSUE	GPW
1	27.09.19	PEER REVIEW ISSUE	GPW

CLIENT:
HWCP

lewis bradford
CONSULTING ENGINEERS

PROJECT:
**INVERCARGILL CENTRAL
ZONE 1 ANCHOR**

DRAWING TITLE:
**ZONE 1
STEELWORK DETAILS
SHEET 1**

DRAWN: GPW	SCALE: 1 : 10 at A1
ENGINEER: EL/TSS	
CHECKED: -	
118083-Z1-WD-ST 5620	REV. 2

17 Dec 2019

Building Division

BUILDING CONSENT NUMBER
2019/1381

THIS DRAWING AND ALL INFORMATION CONTAINED WITHIN IS THE PROPERTY OF LEWIS BRADFORD. ITS CONTENTS ARE CONFIDENTIAL AND MUST NOT BE REPRODUCED OR DISTRIBUTED TO ANY OTHER PERSON OR COMPANY UNLESS AGREED TO IN WRITING BY LEWIS BRADFORD

CONTRACTOR TO VERIFY ALL DIMENSIONS ON SITE REFER TO ARCHITECT'S DRAWING FOR ALL SETOUTS

NOTES:
Refer drawing 0002 for standard notes. Refer also to Structural Specification

note: apply intumescent fire protection with equivalent FRR to connections to all elements shown on plans/elevations designated with a *, ** or ***

Where unprotected areas of steelwork meet fire protected elements overlap the fire protection onto the adjoining 500mm of 'unprotected' structural steel

Invercargill City Council
Building Consent Authority
Approved Site Copy

Approved For Issue
27/02/2020

REV	DATE	AMENDMENT	BY
2	25.10.19	CONSENT ISSUE	GPW
1	27.09.19	PEER REVIEW ISSUE	GPW


CLIENT:
HWCP

lewis bradford
CONSULTING ENGINEERS

PROJECT:
INVERCARGILL CENTRAL ZONE 1 ANCHOR

DRAWING TITLE:
ZONE 1 STEELWORK DETAILS SHEET 2

DRAWN: GPW	SCALE: 1 : 10 at A1
ENGINEER: EL/TSS	
CHECKED: -	
118083-Z1-WD-ST 5621	REV. 2

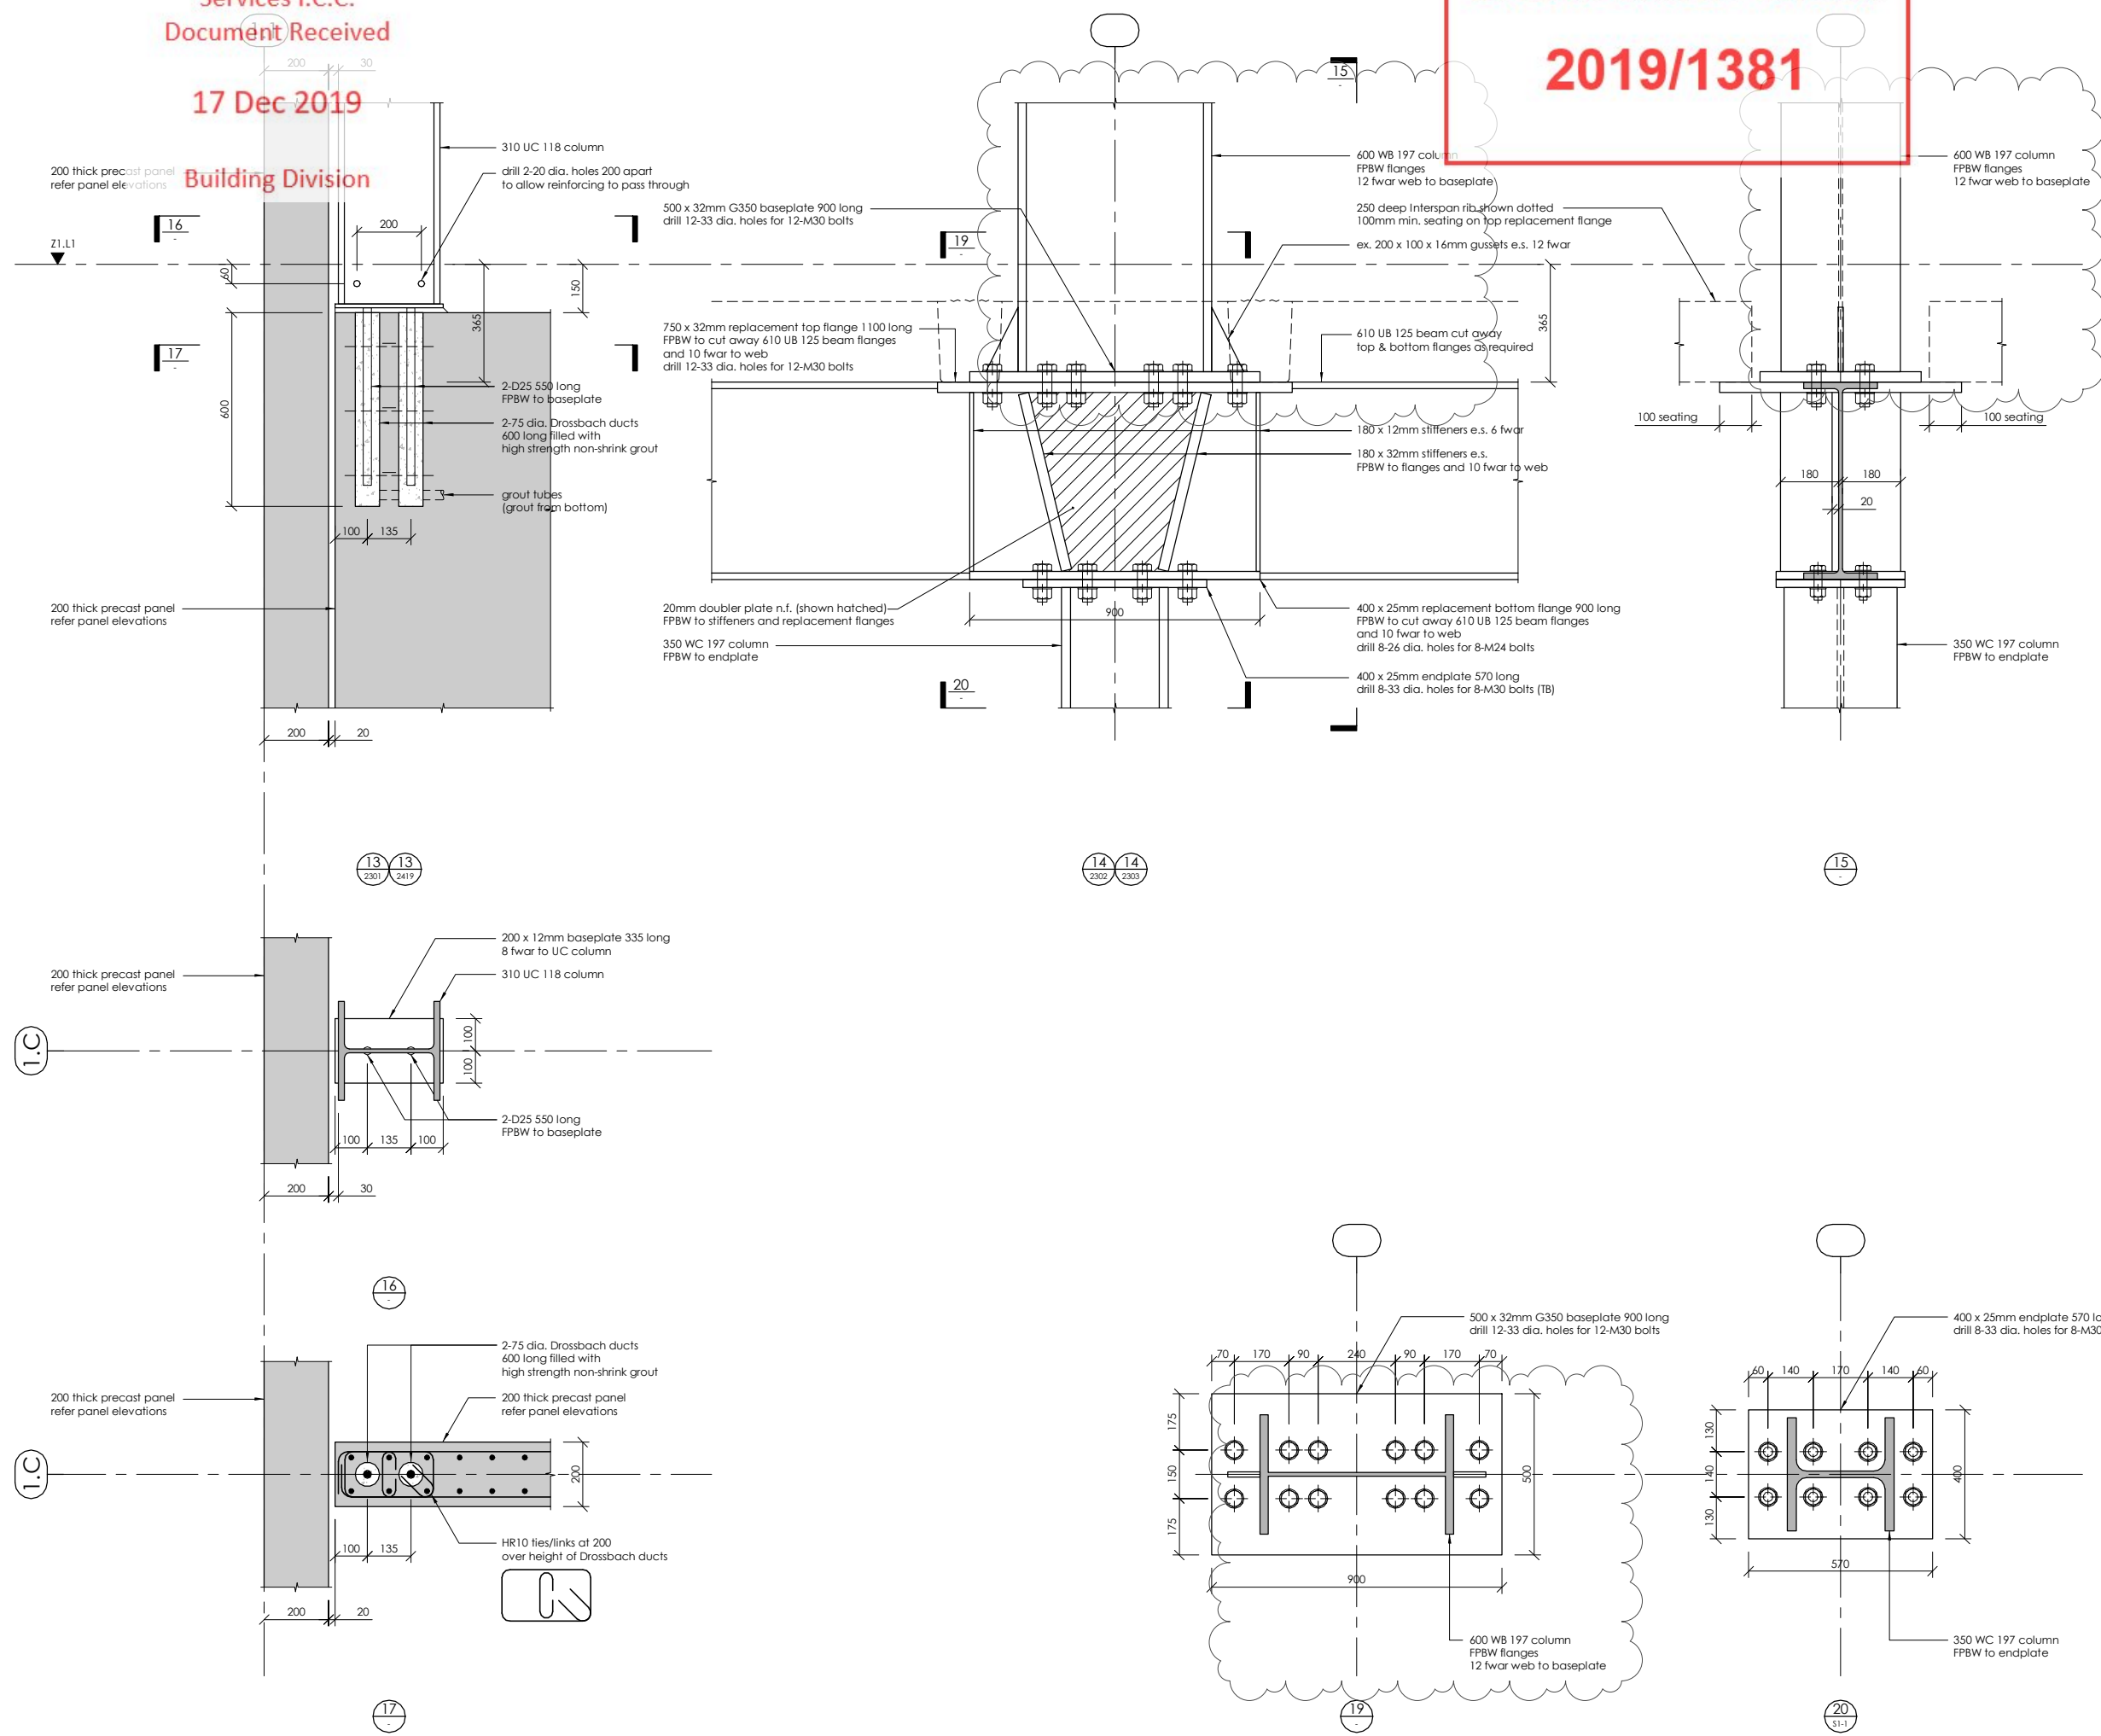

17 Dec 2019

Building Division

BUILDING CONSENT NUMBER
2019/1381

THIS DRAWING AND ALL INFORMATION CONTAINED WITHIN IS THE PROPERTY OF LEWIS BRADFORD. ITS CONTENTS ARE CONFIDENTIAL AND MUST NOT BE REPRODUCED OR DISTRIBUTED TO ANY OTHER PERSON OR COMPANY UNLESS AGREED TO IN WRITING BY LEWIS BRADFORD

CONTRACTOR TO VERIFY ALL DIMENSIONS ON SITE REFER TO ARCHITECT'S DRAWING FOR ALL SETOUTS


NOTES:
Refer drawing 0002 for standard notes. Refer also to Structural Specification.
note: apply intumescent fire protection with equivalent FRR to connections to all elements shown on plans/elevations designated with a *, ** or ***
Where unprotected areas of steelwork meet fire protected elements overlap the fire protection onto the adjoining 500mm of 'unprotected' structural steel

Invercargill City Council Building Consent Authority Approved Site Copy

Approved For Issue 27/02/2020

REV	DATE	AMENDMENT	BY
2	25.10.19	CONSENT ISSUE	GPW
1	27.09.19	PEER REVIEW ISSUE	GPW


CLIENT:
HWCP

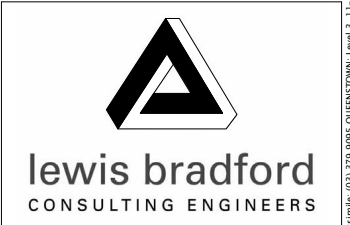

PROJECT:
INVERCARGILL CENTRAL ZONE 1 ANCHOR

DRAWING TITLE:
ZONE 1 STEELWORK DETAILS SHEET 3

DRAWN: GPW	SCALE: 1 : 10 at A1
ENGINEER: EL/TSS	
CHECKED: -	
118083-Z1-WD-ST 5622	REV. 2

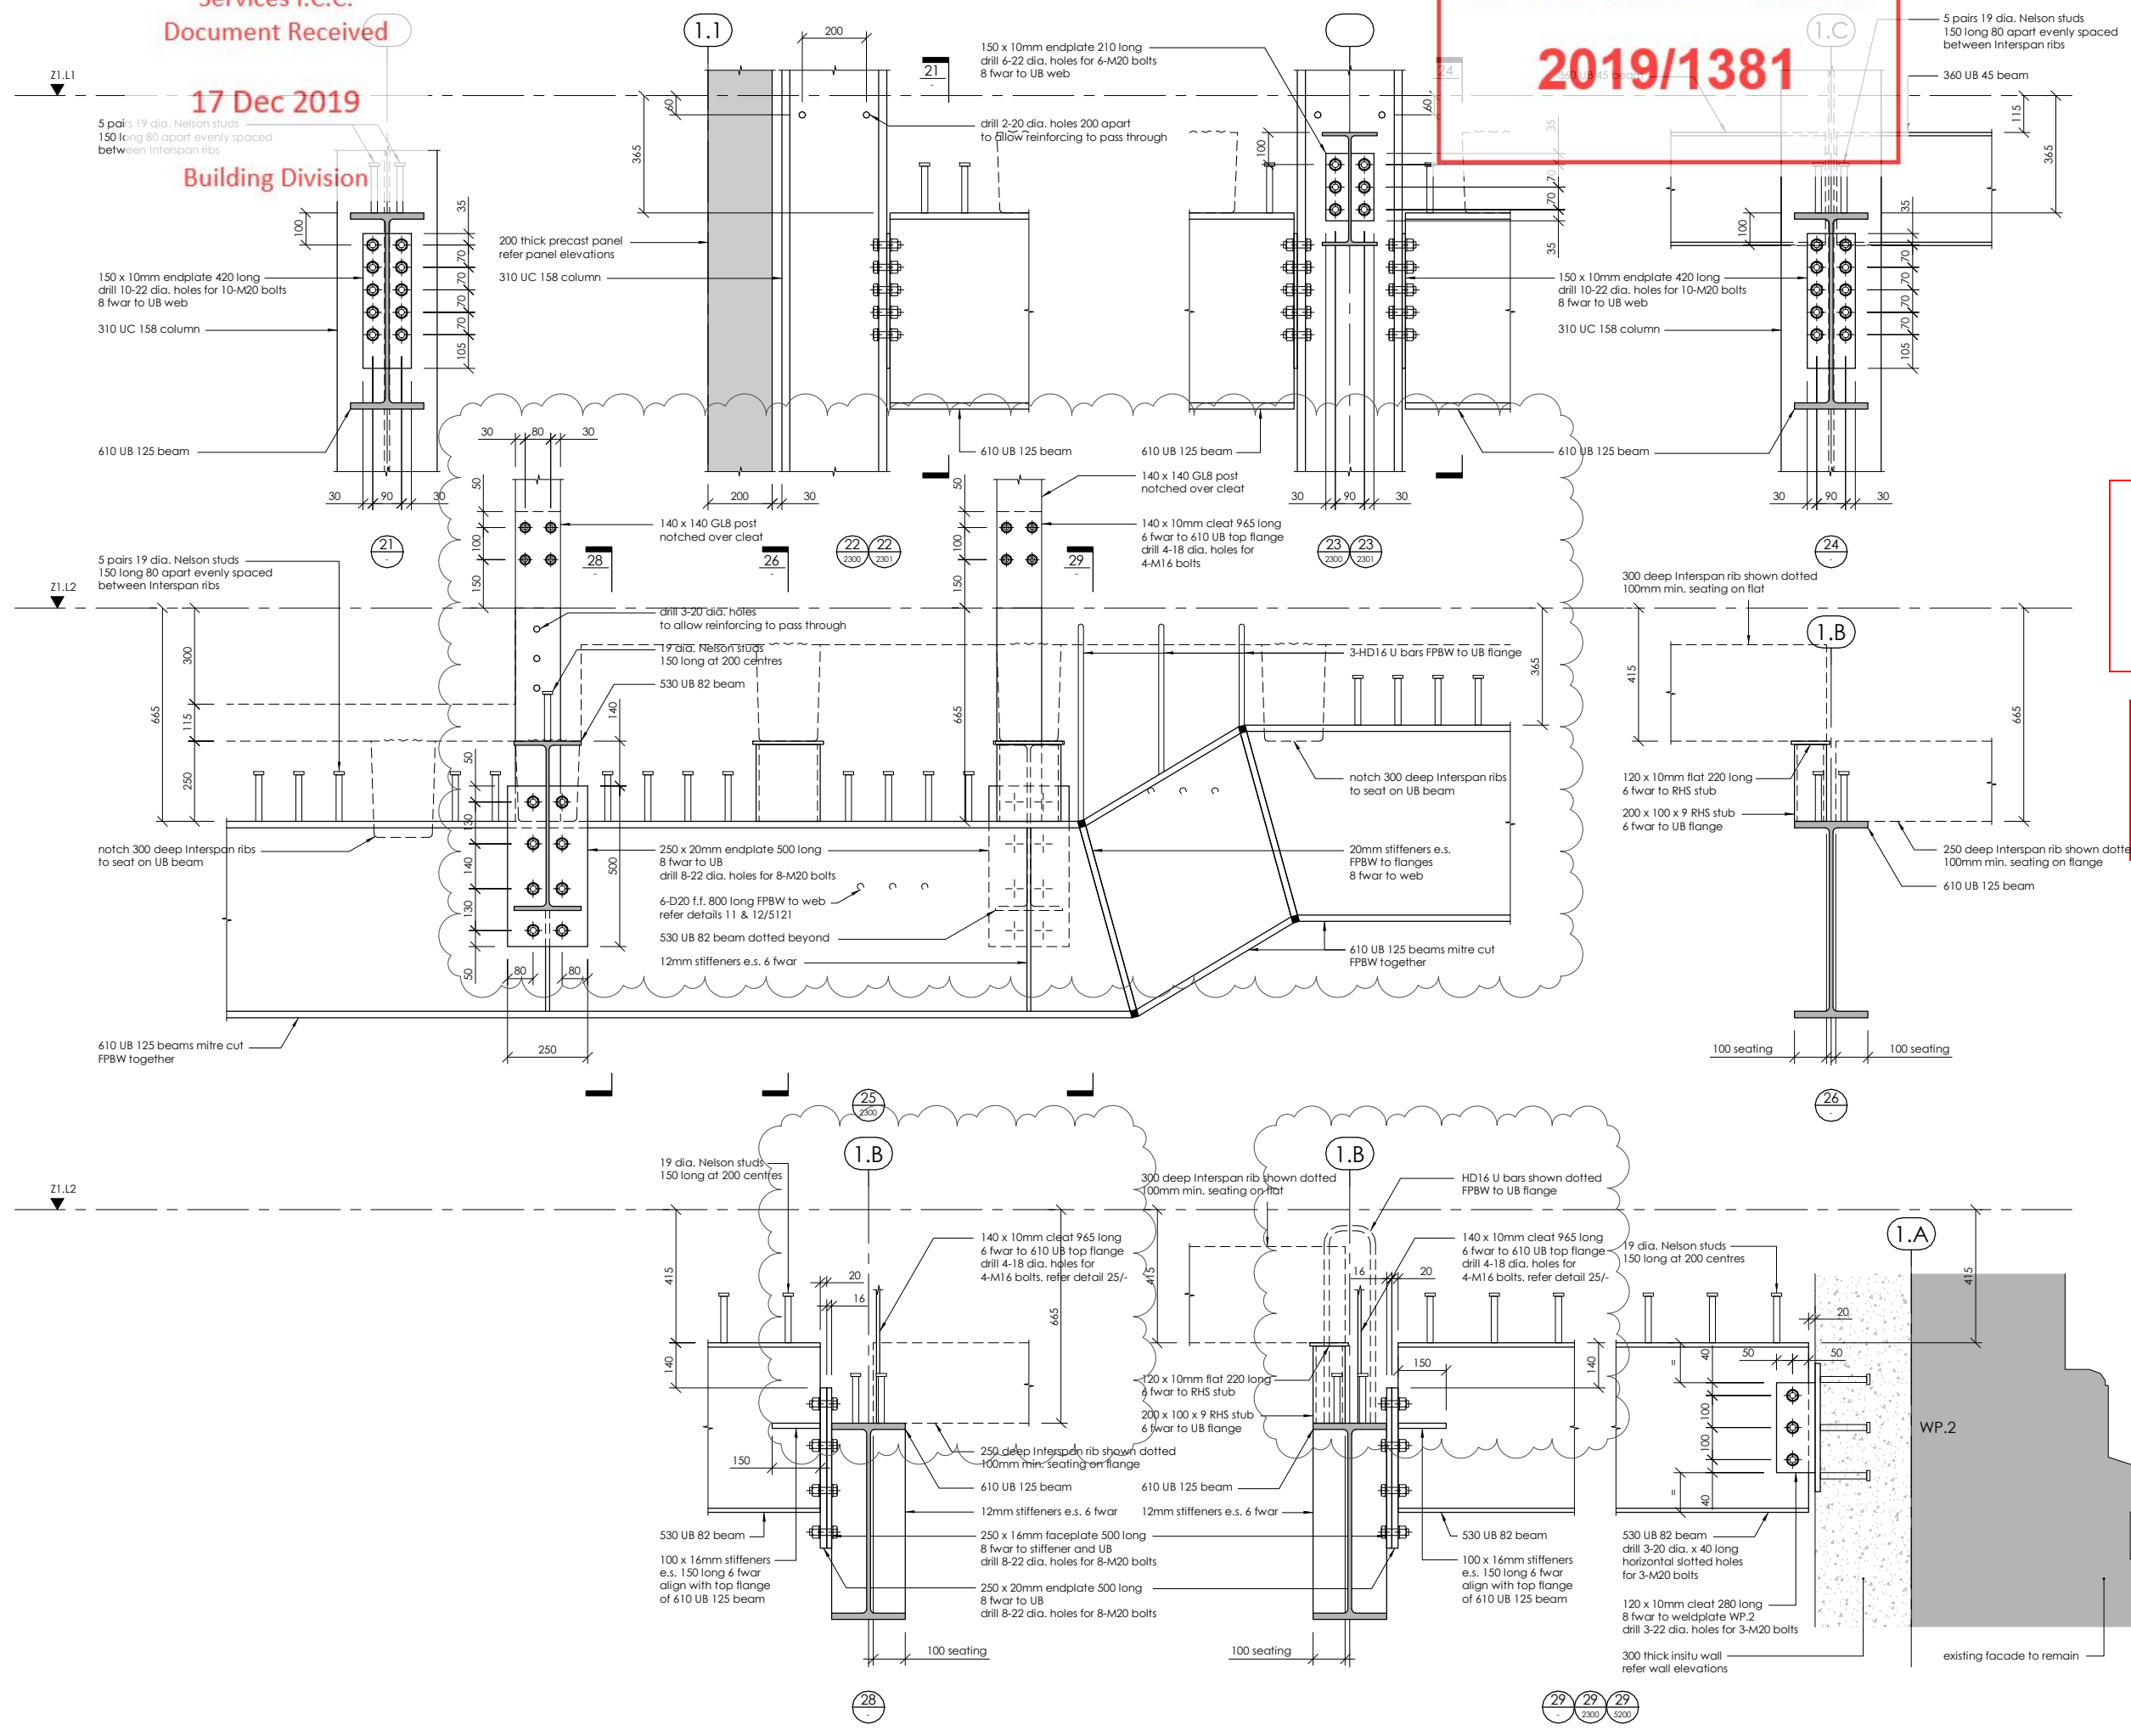

17 Dec 2019

Building Division

BUILDING CONSENT NUMBER
2019/1381

THIS DRAWING AND ALL INFORMATION CONTAINED WITHIN IS THE PROPERTY OF LEWIS BRADFORD. ITS CONTENTS ARE CONFIDENTIAL AND MUST NOT BE REPRODUCED OR DISTRIBUTED TO ANY OTHER PERSON OR COMPANY UNLESS AGREED TO IN WRITING BY LEWIS BRADFORD

CONTRACTOR TO VERIFY ALL DIMENSIONS ON SITE REFER TO ARCHITECT'S DRAWING FOR ALL SETOUTS

NOTES:
Refer drawing 0002 for standard notes. Refer also to Structural Specification.

COLUMN LEGEND

IC1	100 x 6 SHS
IC2	150 x 9 SHS
IC3	150 x 100 x 5 RHS
IC4	200 x 100 x 9 RHS
IC5**	200 x 9 SHS**
IC6	200 UB 30
IC7*	310 UC 118*
IC7**	310 UC 118**
IC8*	310 UC 137*
IC9**	310 UC 158**
IC10*	350 WC 197*
IC10**	350 WC 197**
IC11	600 WB 197
IC12	140 x 140 GLB pps†

† indicates steel member to have 30 minutes fire rated paint protection (limiting temperature 550°C)
* indicates steel member to have 60 minutes fire rated paint protection (limiting temperature 550°C)
** indicates steel member to have 120 minutes fire rated paint protection (limiting temperature 550°C)
Where unprotected areas of steelwork meet fire protected elements over pp...
500mm of 'unprotected' structural steel
note: apply intumescent fire protection with...
on plans, elevation designated with... or

Invercargill City Council
Building Consent Authority
Approved Site Copy

Approved for Issue
27/02/2020

2	25.10.19	CONSENT ISSUE	GPW
1	27.09.19	PEER REVIEW ISSUE	GPW
REV	DATE	AMENDMENT	BY


CLIENT:
HWCP

lewis bradford
CONSULTING ENGINEERS

PROJECT:
INVERCARGILL CENTRAL ZONE 1 ANCHOR

DRAWING TITLE:
ZONE 1 STEELWORK DETAILS SHEET 4

DRAWN: GPW
ENGINEER: EL/TSS
CHECKED: -
SCALE: 1 : 50 at A1
REV. 2

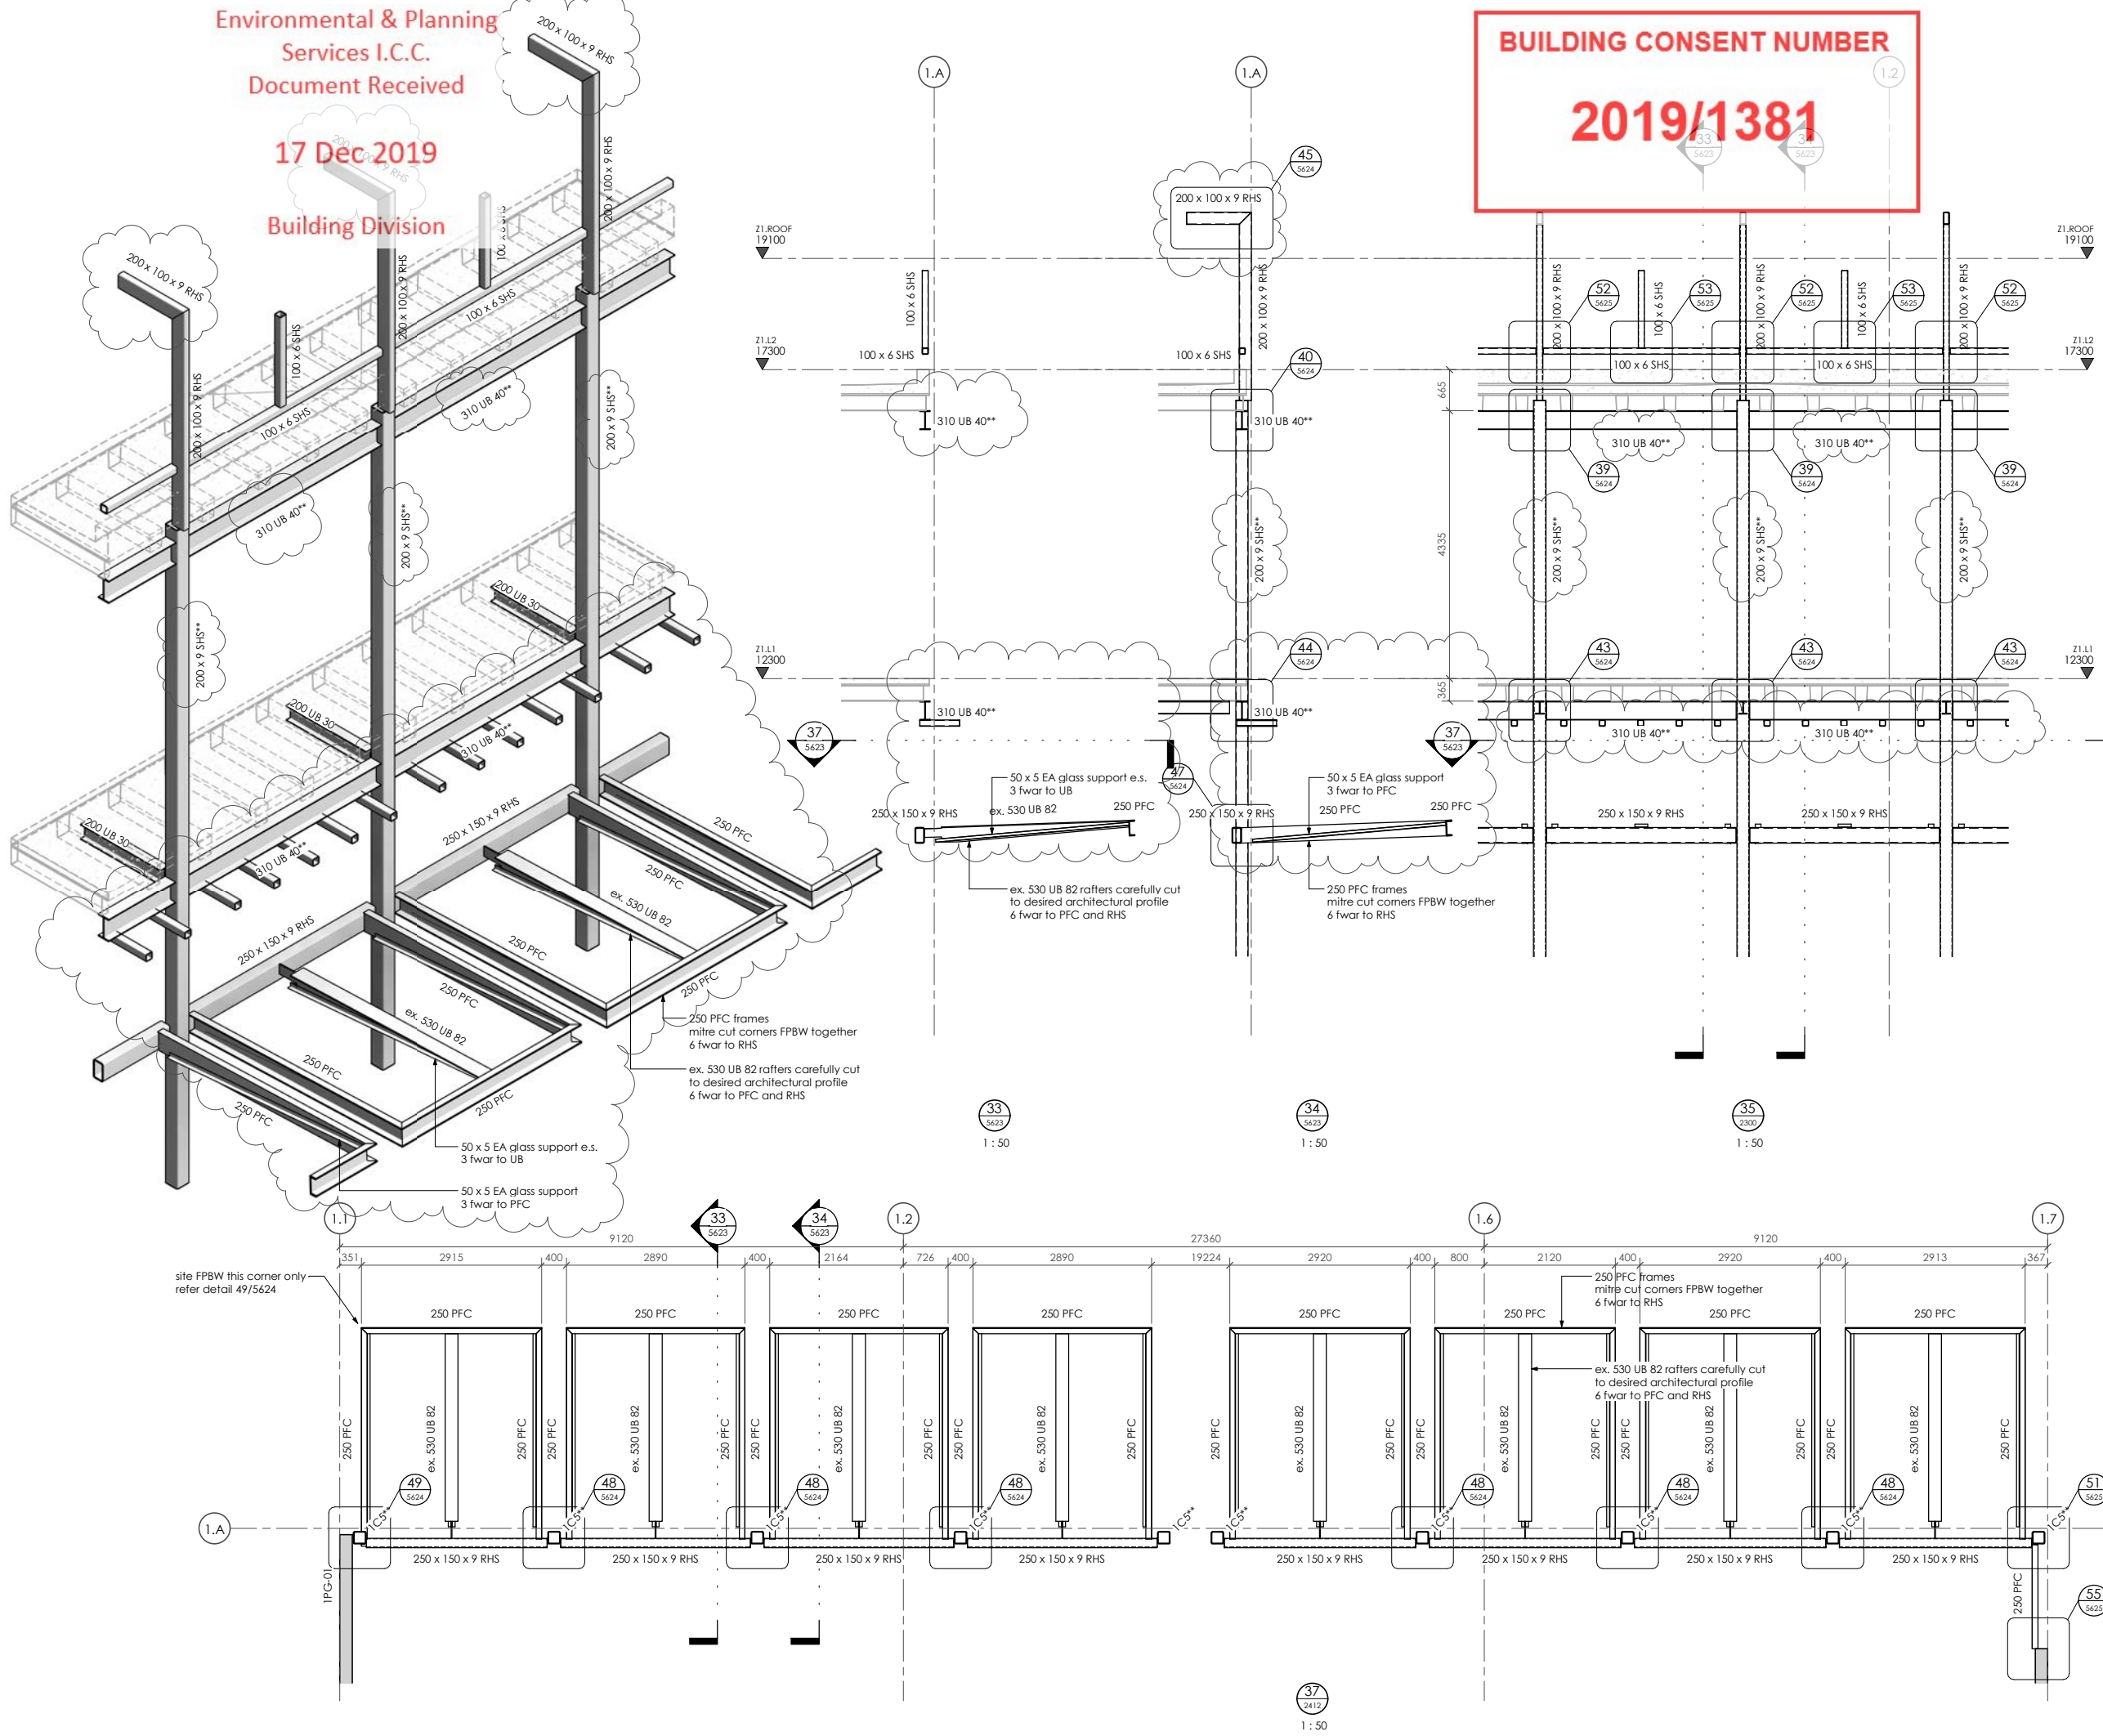

17 Dec 2019

Building Division

BUILDING CONSENT NUMBER
2019/1381


THIS DRAWING AND ALL INFORMATION CONTAINED WITHIN IS THE PROPERTY OF LEWIS BRADFORD. ITS CONTENTS ARE CONFIDENTIAL AND MUST NOT BE REPRODUCED OR DISTRIBUTED TO ANY OTHER PERSON OR COMPANY UNLESS AGREED TO IN WRITING BY LEWIS BRADFORD

CONTRACTOR TO VERIFY ALL DIMENSIONS ON SITE REFER TO ARCHITECT'S DRAWING FOR ALL SETOUTS

NOTES:
Refer drawing 0002 for standard notes.
Refer also to Structural Specification

note: apply intumescent fire protection with equivalent FRR to connections to all elements shown on plans/elevations designated with a *, ** or ***

Where unprotected areas of steelwork meet fire protected elements overlap the fire protection onto the adjoining 500mm of 'unprotected' structural steel

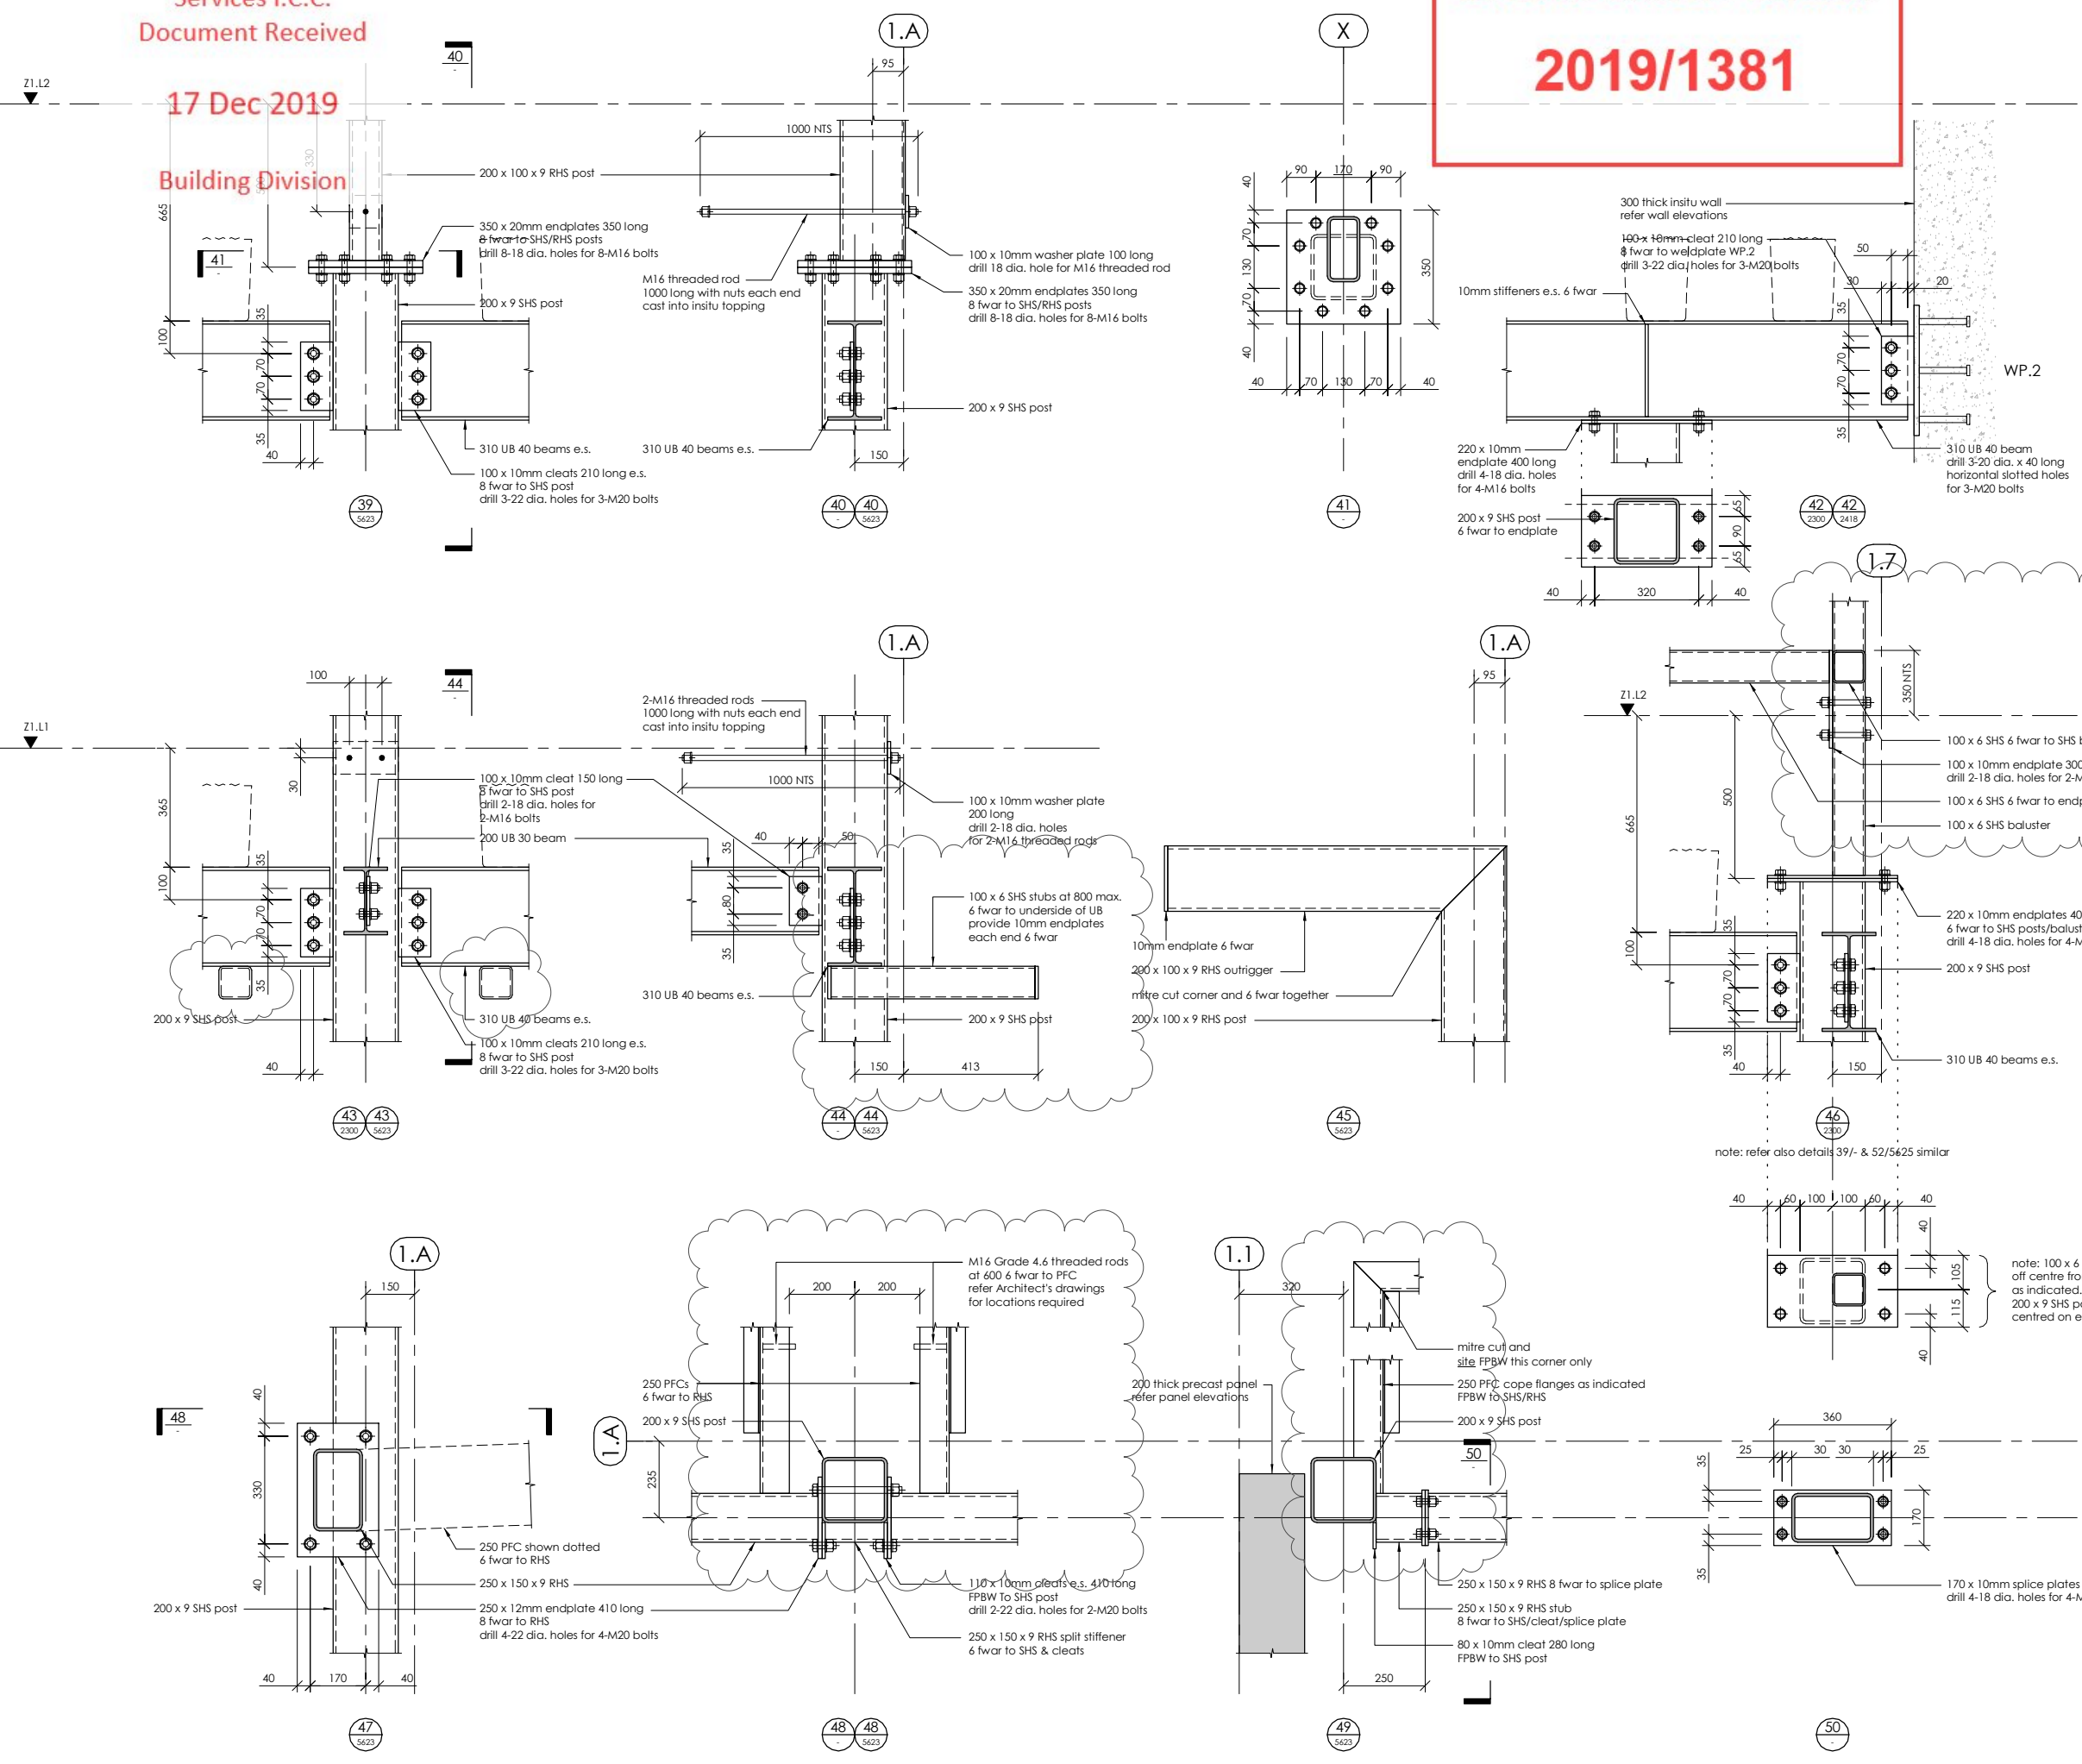


Invercargill City Council
Building Consent Authority
Approved Site Copy

Approved For Issue
27/02/2020

REV	DATE	AMENDMENT	BY
2	25.10.19	CONSENT ISSUE	GPW
1	27.09.19	PEER REVIEW ISSUE	GPW

CLIENT:
HWCP

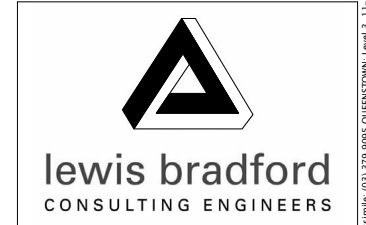

PROJECT:
INVERCARGILL CENTRAL ZONE 1 ANCHOR

DRAWING TITLE:
ZONE 1 STEELWORK DETAILS SHEET 5

DRAWN: GPW	SCALE: 1 : 10 at A1
ENGINEER: EL/TSS	
CHECKED: -	
118083-Z1-WD-ST 5624	REV. 2

17 Dec 2019

Building Division

BUILDING CONSENT NUMBER
2019/1381

THIS DRAWING AND ALL INFORMATION CONTAINED WITHIN IS THE PROPERTY OF LEWIS BRADFORD. ITS CONTENTS ARE CONFIDENTIAL AND MUST NOT BE REPRODUCED OR DISTRIBUTED TO ANY OTHER PERSON OR COMPANY UNLESS AGREED TO IN WRITING BY LEWIS BRADFORD

CONTRACTOR TO VERIFY ALL DIMENSIONS ON SITE REFER TO ARCHITECT'S DRAWING FOR ALL SETOUTS

NOTES:
Refer drawing 0002 for standard notes. Refer also to Structural Specification

note: apply intumescent fire protection with equivalent FRR to connections to any elements shown on plans/elevations designated with a *, ** or ***


Where unprotected areas of steelwork meet fire protected elements overlap the fire protection onto the adjoining 500mm of 'unprotected' structural steel

Invercargill City Council
Building Consent Authority
Approved Site Copy

Approved For Issue
27/02/2020

REV	DATE	AMENDMENT	BY
2	25.10.19	CONSENT ISSUE	GPW
1	27.09.19	PEER REVIEW ISSUE	GPW


CLIENT:
HWCP

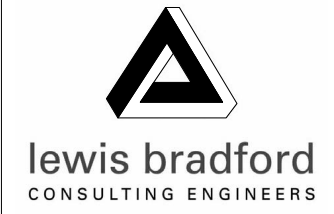

PROJECT:
**INVERCARGILL CENTRAL
ZONE 1 ANCHOR**

DRAWING TITLE:
**ZONE 1
STEELWORK DETAILS
SHEET 6**

DRAWN: GPW	SCALE: 1 : 10 at A1
ENGINEER: EL/TSS	
CHECKED: -	
118083-Z1-WD-ST 5625	REV. 2

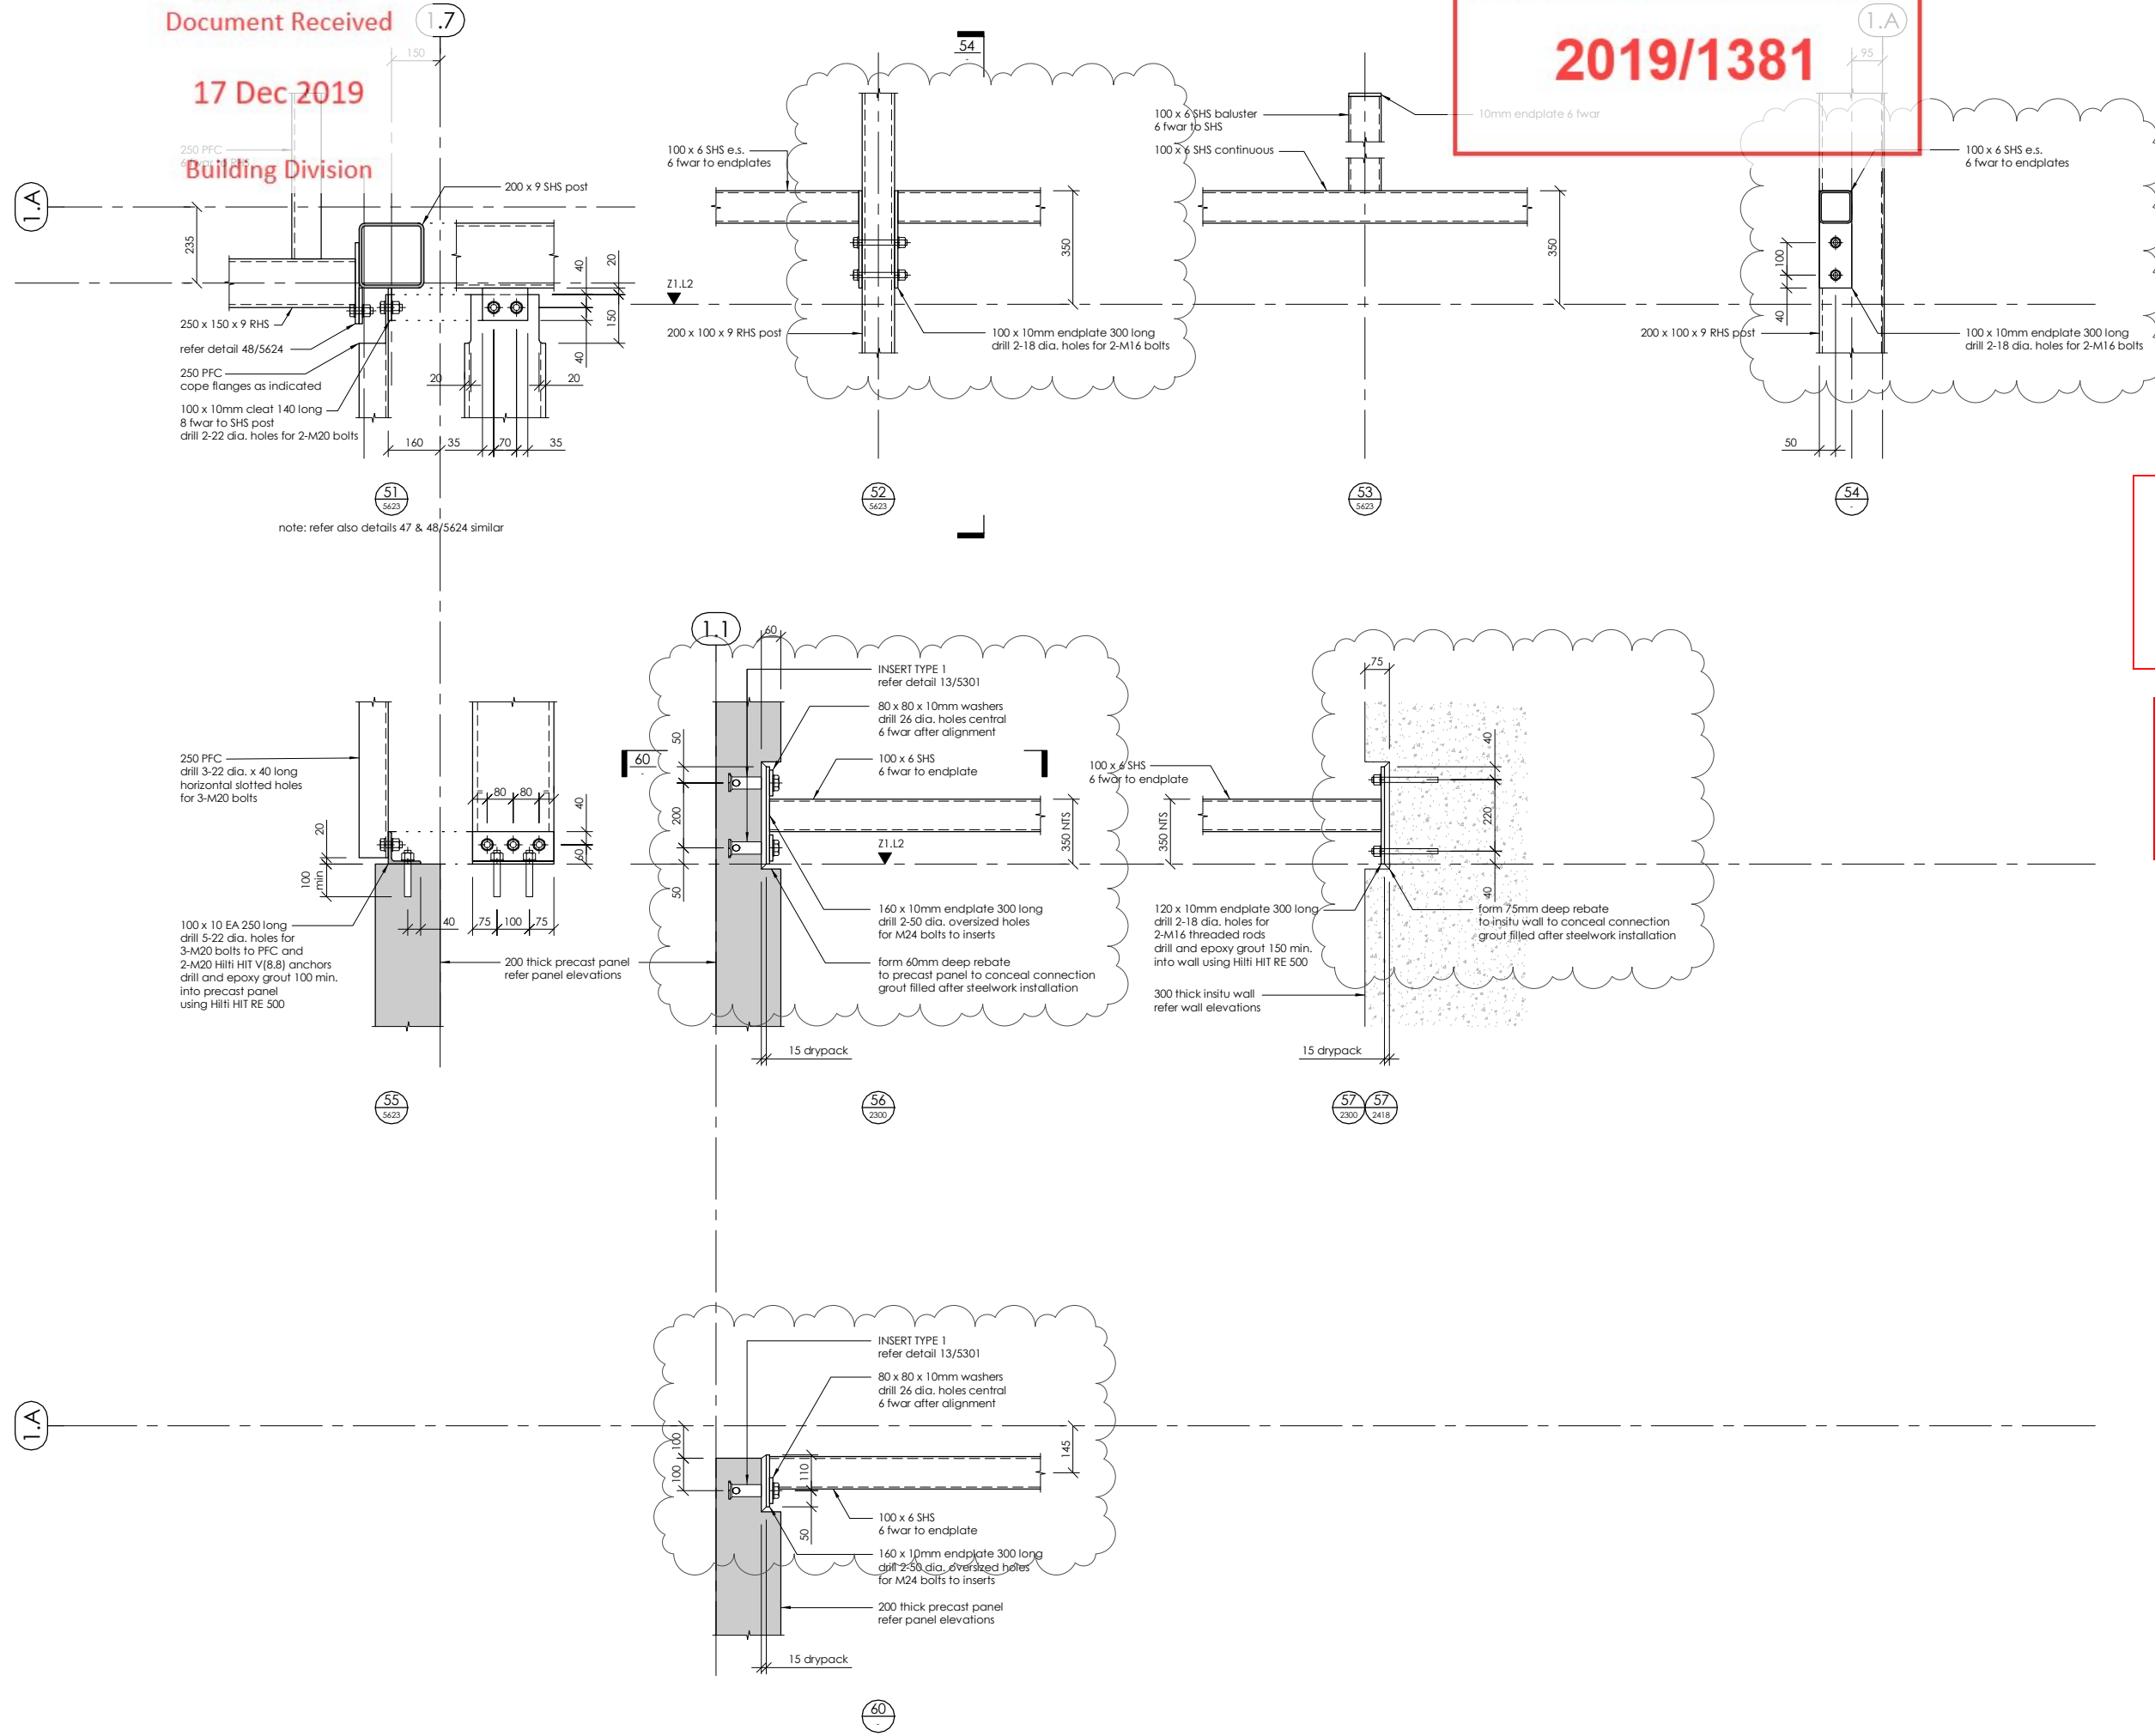

17 Dec 2019

Building Division

BUILDING CONSENT NUMBER
2019/1381

THIS DRAWING AND ALL INFORMATION CONTAINED WITHIN IS THE PROPERTY OF LEWIS BRADFORD. ITS CONTENTS ARE CONFIDENTIAL AND MUST NOT BE REPRODUCED OR DISTRIBUTED TO ANY OTHER PERSON OR COMPANY UNLESS AGREED TO IN WRITING BY LEWIS BRADFORD

CONTRACTOR TO VERIFY ALL DIMENSIONS ON SITE REFER TO ARCHITECT'S DRAWING FOR ALL SETOUTS

NOTES:
Refer drawing 0002 for standard notes. Refer also to Structural Specification.
note: apply intumescent fire protection with equivalent FRR to connections to all elements shown on plans/elevations designated with a *, ** or ***
Where unprotected areas of steelwork meet fire protected elements overlap the fire protection onto the adjoining 500mm of 'unprotected' structural steel

Invercargill City Council
Building Consent Authority
Approved Site Copy

Approved For Issue
27/02/2020

REV	DATE	AMENDMENT	BY
2	25.10.19	CONSENT ISSUE	GPW
1	27.09.19	PEER REVIEW ISSUE	GPW


CLIENT:
HWCP

lewis bradford
CONSULTING ENGINEERS

PROJECT:
INVERCARGILL CENTRAL ZONE 1 ANCHOR

DRAWING TITLE:
ZONE 1 STEELWORK DETAILS SHEET 7

DRAWN: GPW	SCALE: 1 : 10 at A1
ENGINEER: EL/TSS	
CHECKED: -	
118083-Z1-WD-ST 5626	REV. 2

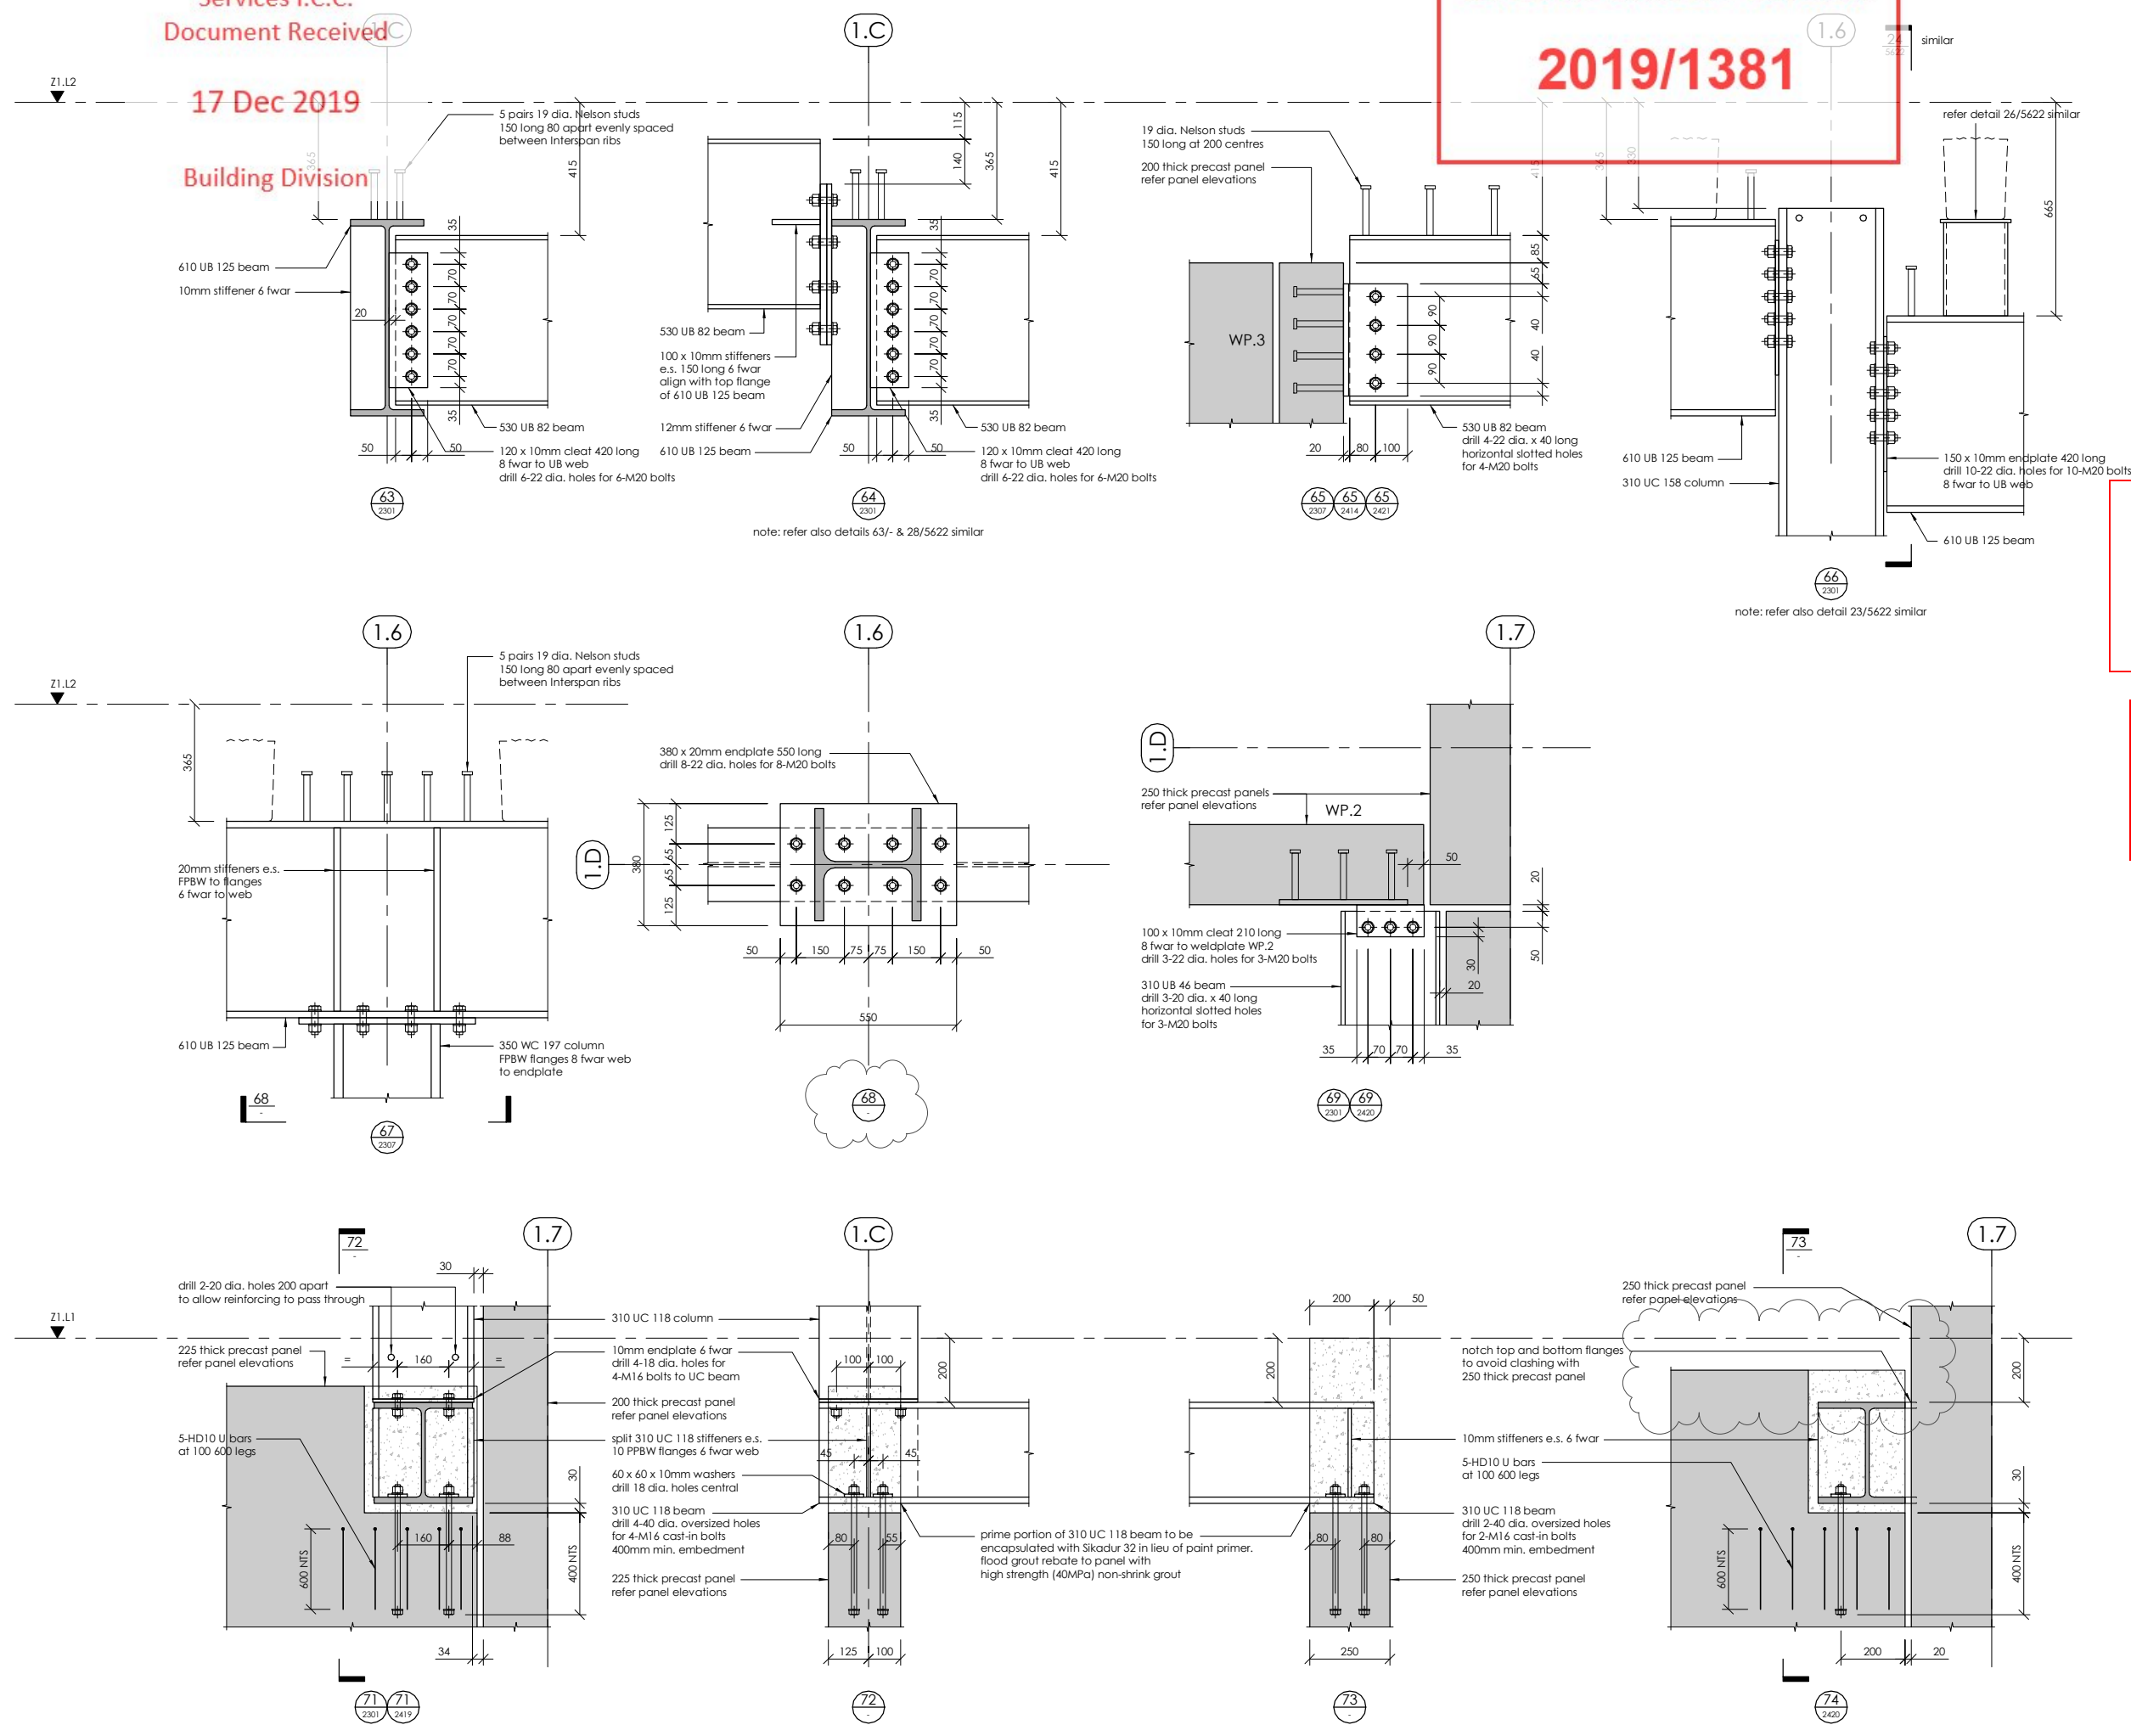

17 Dec 2019








Building Division

BUILDING CONSENT NUMBER
2019/1381

THIS DRAWING AND ALL INFORMATION CONTAINED WITHIN IS THE PROPERTY OF LEWIS BRADFORD. ITS CONTENTS ARE CONFIDENTIAL AND MUST NOT BE REPRODUCED OR DISTRIBUTED TO ANY OTHER PERSON OR COMPANY UNLESS AGREED TO IN WRITING BY LEWIS BRADFORD

CONTRACTOR TO VERIFY ALL DIMENSIONS ON SITE REFER TO ARCHITECT'S DRAWING FOR ALL SETOUTS

NOTES:
Refer drawing 0002 for standard notes. Refer also to Structural Specification
note: apply intumescent fire protection with equivalent FRR to connections to all elements shown on plans/elevations designated with a *, ** or ***
Where unprotected areas of steelwork meet fire protected elements overlap the fire protection onto the adjoining 500mm of 'unprotected' structural steel!

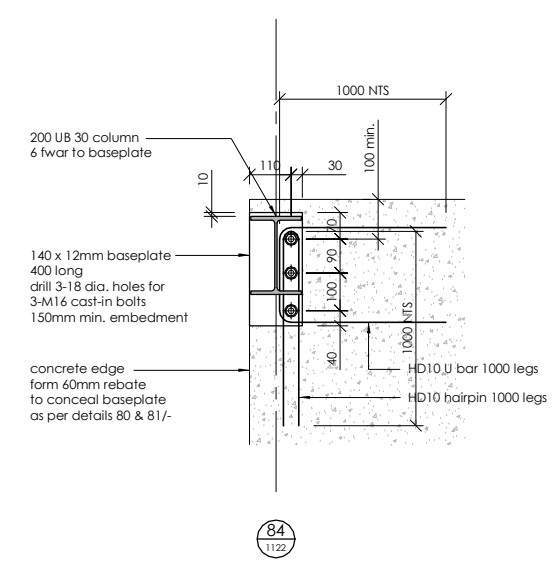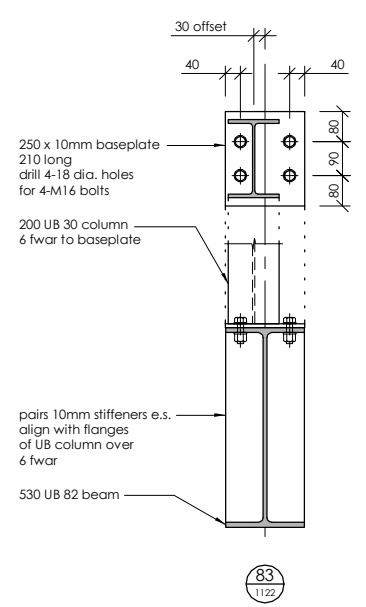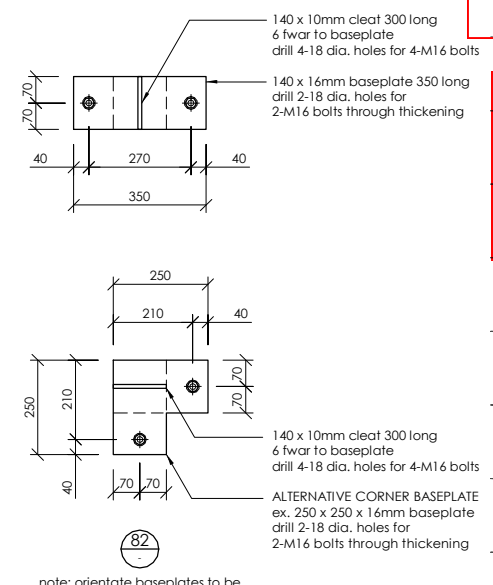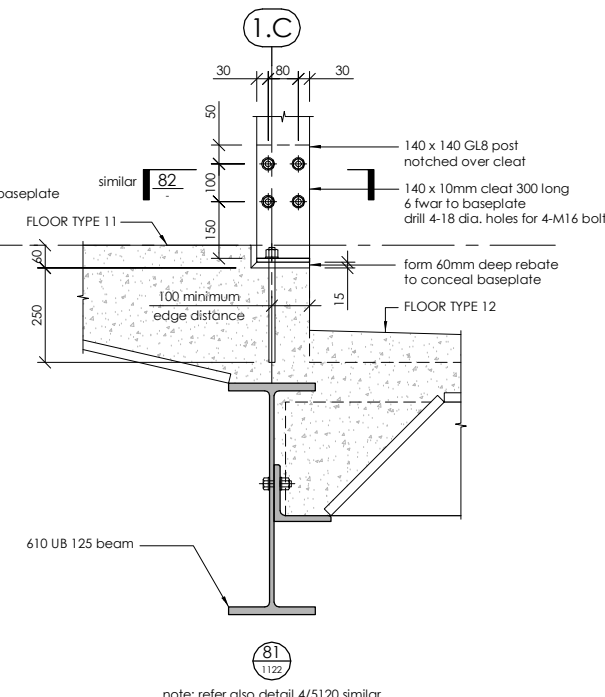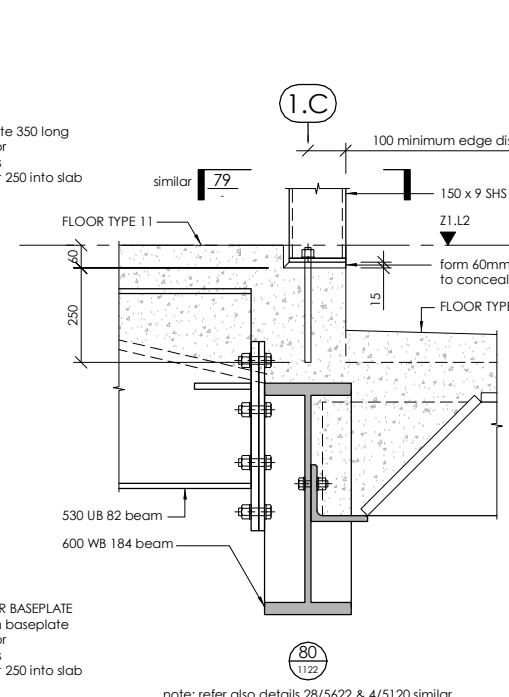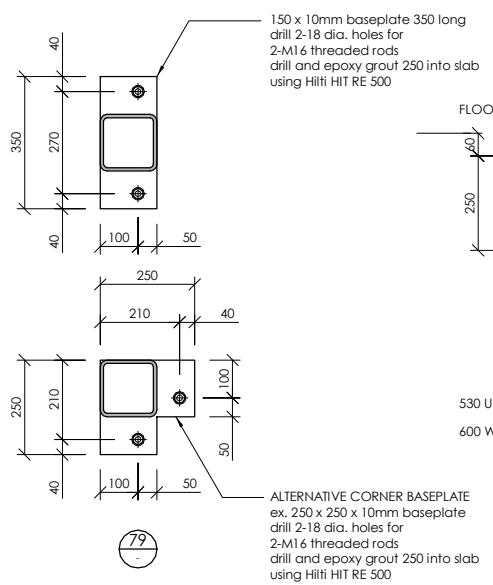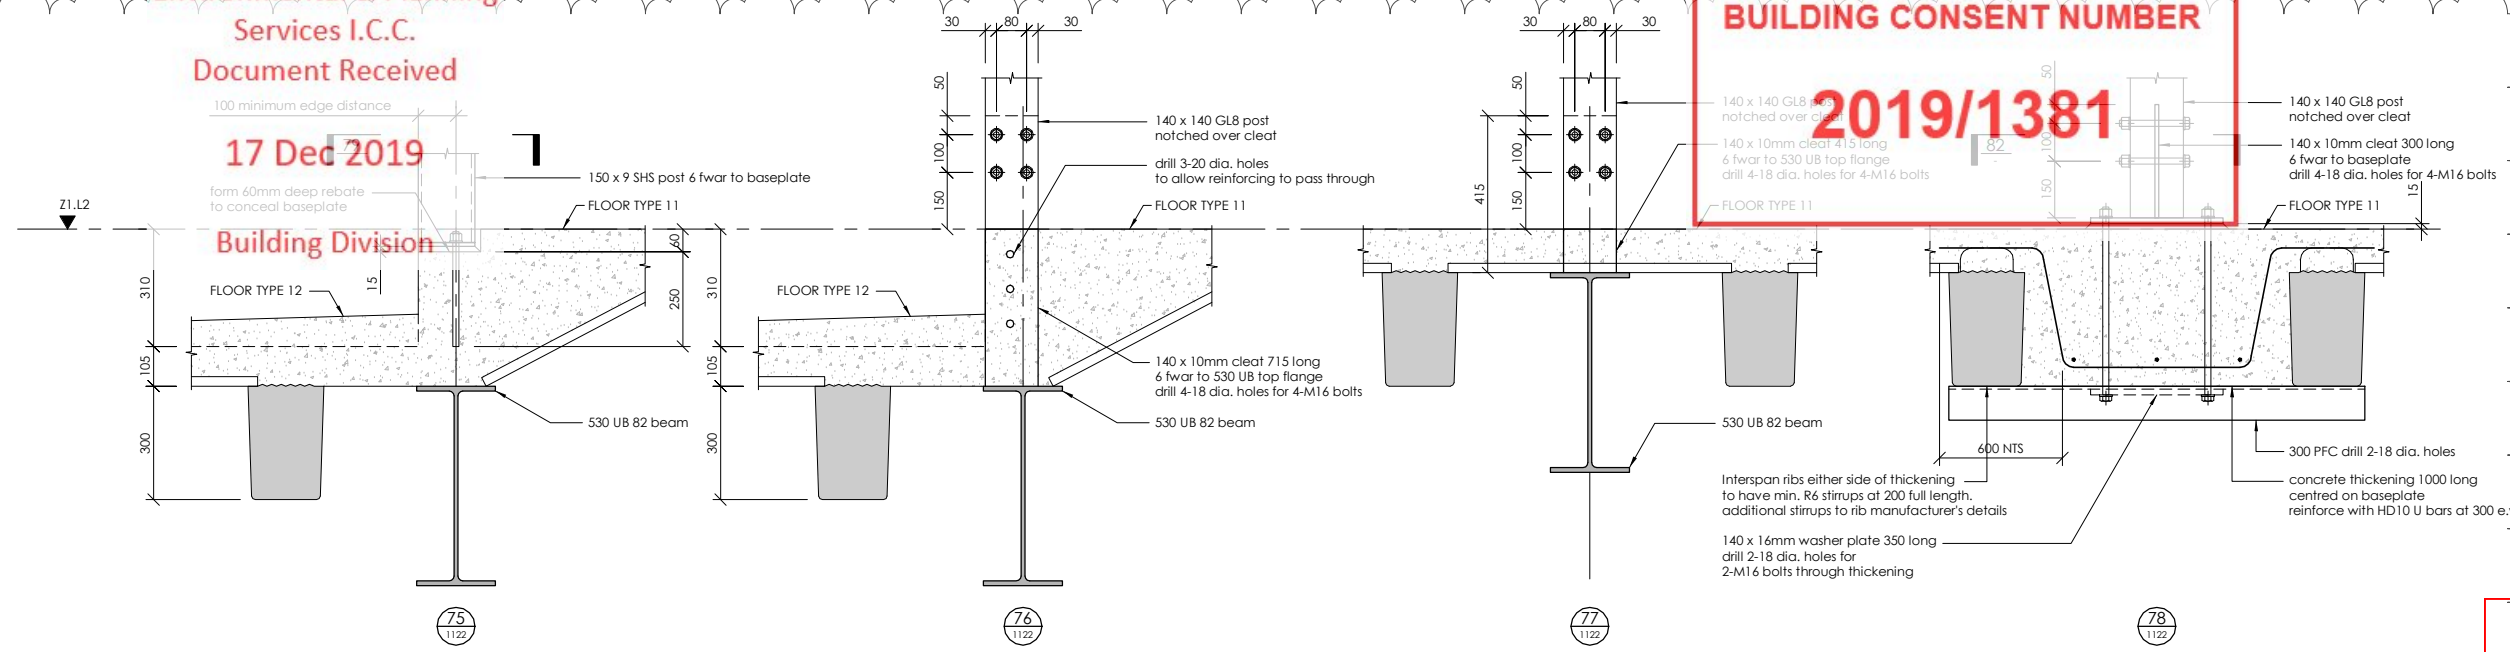

Invercargill City Council Building Consent Authority Approved Site Copy

Approved For Issue 27/02/2020

REV	DATE	AMENDMENT	BY
1	25.10.19	CONSENT ISSUE	GPW

CLIENT: **HWCP**

lewis bradford
CONSULTING ENGINEERS

PROJECT: **INVERCARGILL CENTRAL ZONE 1 ANCHOR**

DRAWING TITLE: **ZONE 1 STEELWORK DETAILS SHEET 8**

DRAWN: GPW SCALE: 1 : 10 at A1
ENGINEER: EL/TSS
CHECKED: -

118083-Z1-WD-ST 5627 REV. 1

17 Dec 2019

split 100 x 50 x 9 RHS stiffeners e.s. 6 fwar
6 fwar

Building Division
1000 Wb 322 beam

200 x 12mm endplate 300 long
6 fwar to RHS
drill 4-18 dia. holes for 4-M16 bolts

100 x 50 x 9 RHS hanger
6 fwar to RHS lintel


100 x 50 x 9 RHS lintel

200 thick precast panel
refer panel elevations

180 200


87

note: RHS hanger is not centred on WB beam

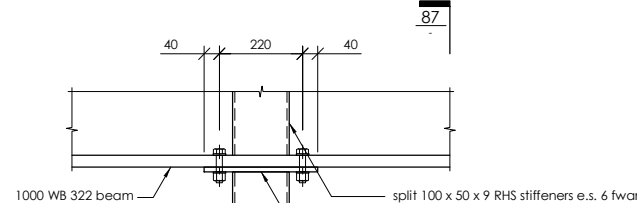


88


90

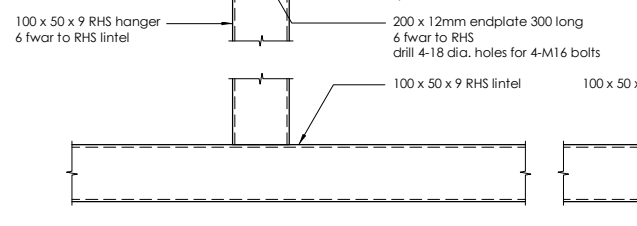

89

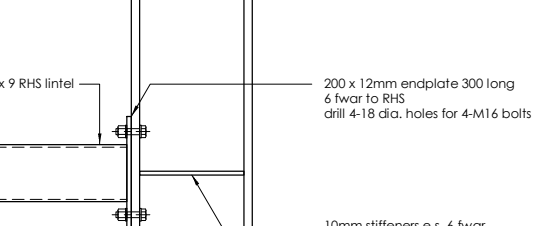

90

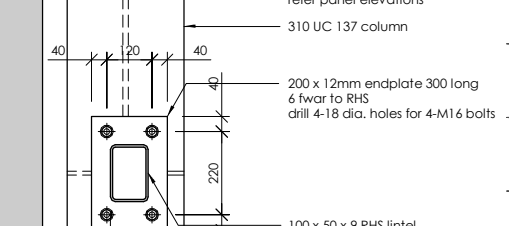

note: RHS lintel is not centred on UC column

BUILDING CONSENT NUMBER
2019/1381

THIS DRAWING AND ALL INFORMATION CONTAINED WITHIN IS THE PROPERTY OF LEWIS BRADFORD. ITS CONTENTS ARE CONFIDENTIAL AND MUST NOT BE REPRODUCED OR DISTRIBUTED TO ANY OTHER PERSON OR COMPANY UNLESS AGREED TO IN WRITING BY LEWIS BRADFORD

CONTRACTOR TO VERIFY ALL DIMENSIONS ON SITE REFER TO ARCHITECT'S DRAWING FOR ALL SETOUTS

NOTES:
Refer drawing 0002 for standard notes.
Refer also to Structural Specification

note: apply intumescent fire protection with equivalent FRR to connections to all elements shown on plans/elevations designated with a *, ** or ***

Where unprotected areas of steelwork meet fire protected elements overlap the fire protection onto the adjoining 500mm of 'unprotected' structural steel

Invercargill City Council
Building Consent Authority
Approved Site Copy

Approved For Issue
27/02/2020

REV	DATE	CONSENT ISSUE	AMENDMENT	GPW	BY
1	25.10.19	CONSENT ISSUE		GPW	

CLIENT:
HWCP


lewis bradford
CONSULTING ENGINEERS

PROJECT:
**INVERCARGILL CENTRAL
ZONE 1 ANCHOR**


DRAWING TITLE:
**ZONE 1
STEELWORK DETAILS
SHEET 9**

DRAWN: GPW	SCALE: 1 : 10 at A1
ENGINEER: EL/TSS	
CHECKED: -	


118083-Z1-WD-ST 5628 REV. 1

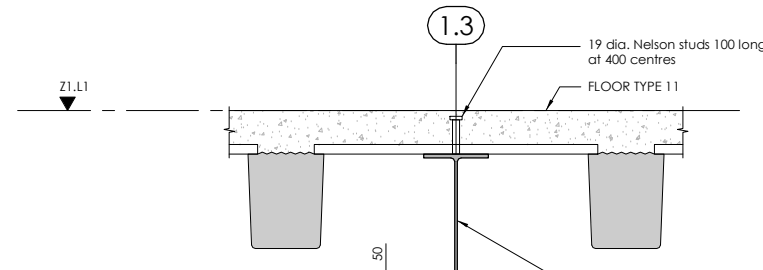






1.3

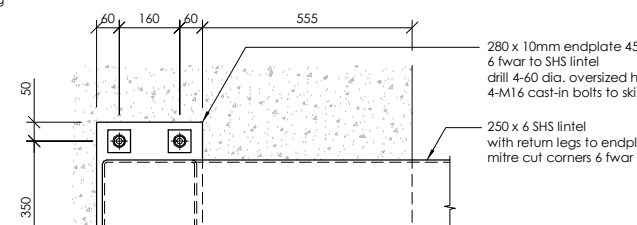

92

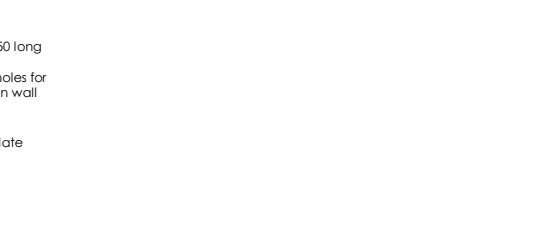


91

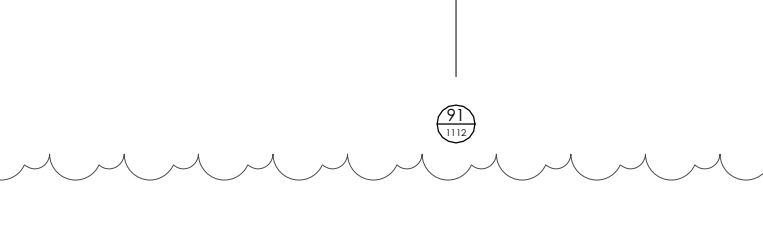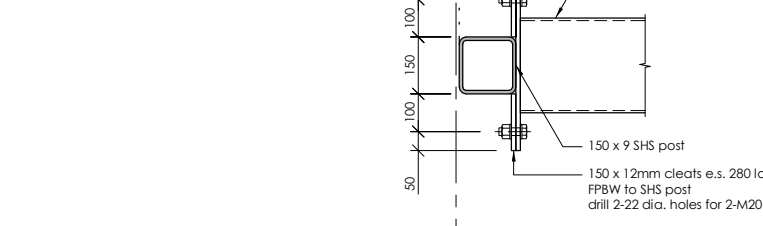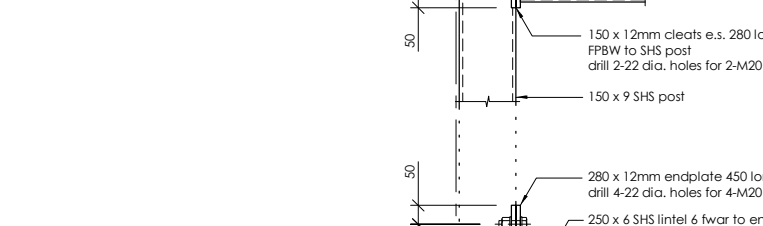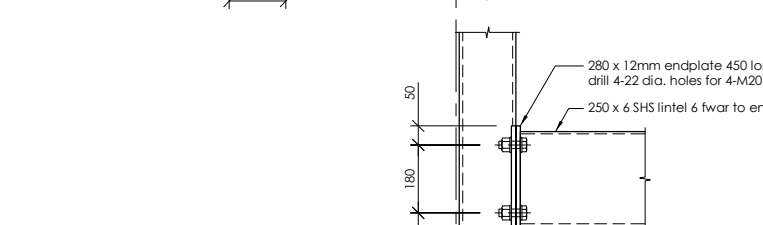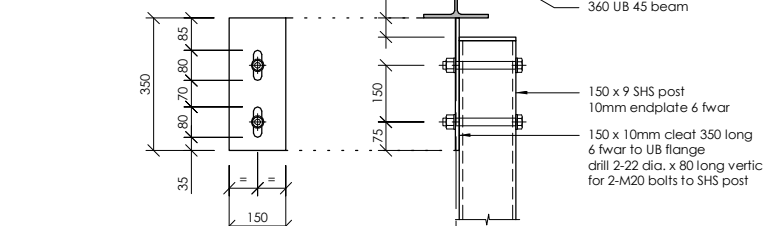

17 Dec 2019

Building Division

BUILDING CONSENT NUMBER
2019/1381

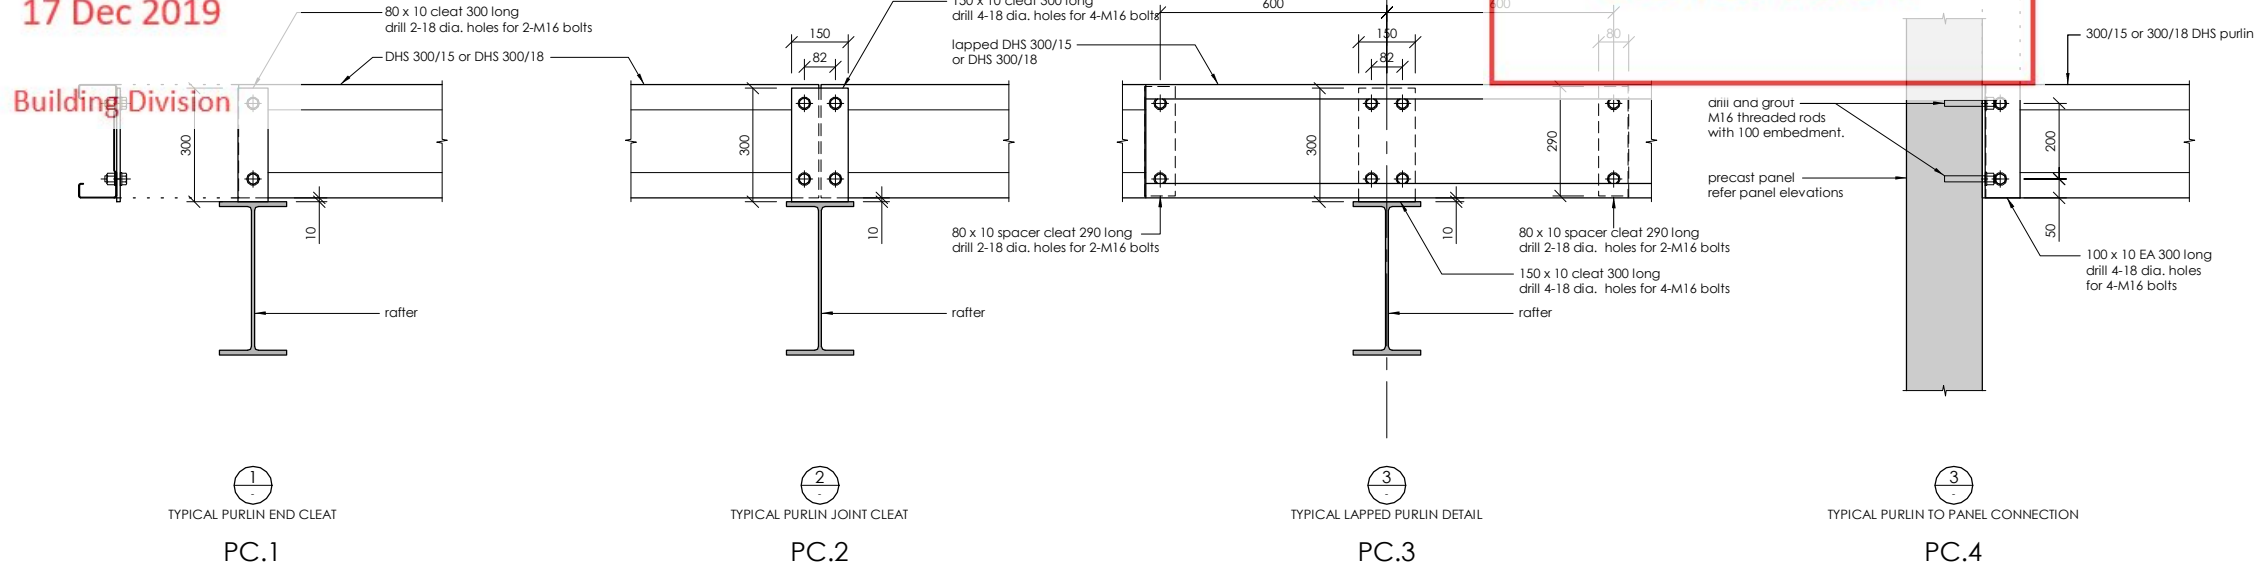

THIS DRAWING AND ALL INFORMATION CONTAINED WITHIN IS THE PROPERTY OF LEWIS BRADFORD. ITS CONTENTS ARE CONFIDENTIAL AND MUST NOT BE REPRODUCED OR DISTRIBUTED TO ANY OTHER PERSON OR COMPANY UNLESS AGREED TO IN WRITING BY LEWIS BRADFORD



CONTRACTOR TO VERIFY ALL DIMENSIONS ON SITE REFER TO ARCHITECT'S DRAWING FOR ALL SETOUTS

NOTES:
Refer drawing 0002 for standard notes.
Refer also to Structural Specification

note: apply intumescent fire protection with equivalent FRR to connections to all elements shown on plans/elevations designated with a *, ** or ***
Where unprotected areas of steelwork meet fire protected elements overlap the fire protection onto the adjoining 500mm of 'unprotected' structural steel

Invercargill City
Council
Building Consent
Authority
Approved Site Copy

Approved For Issue
27/02/2020

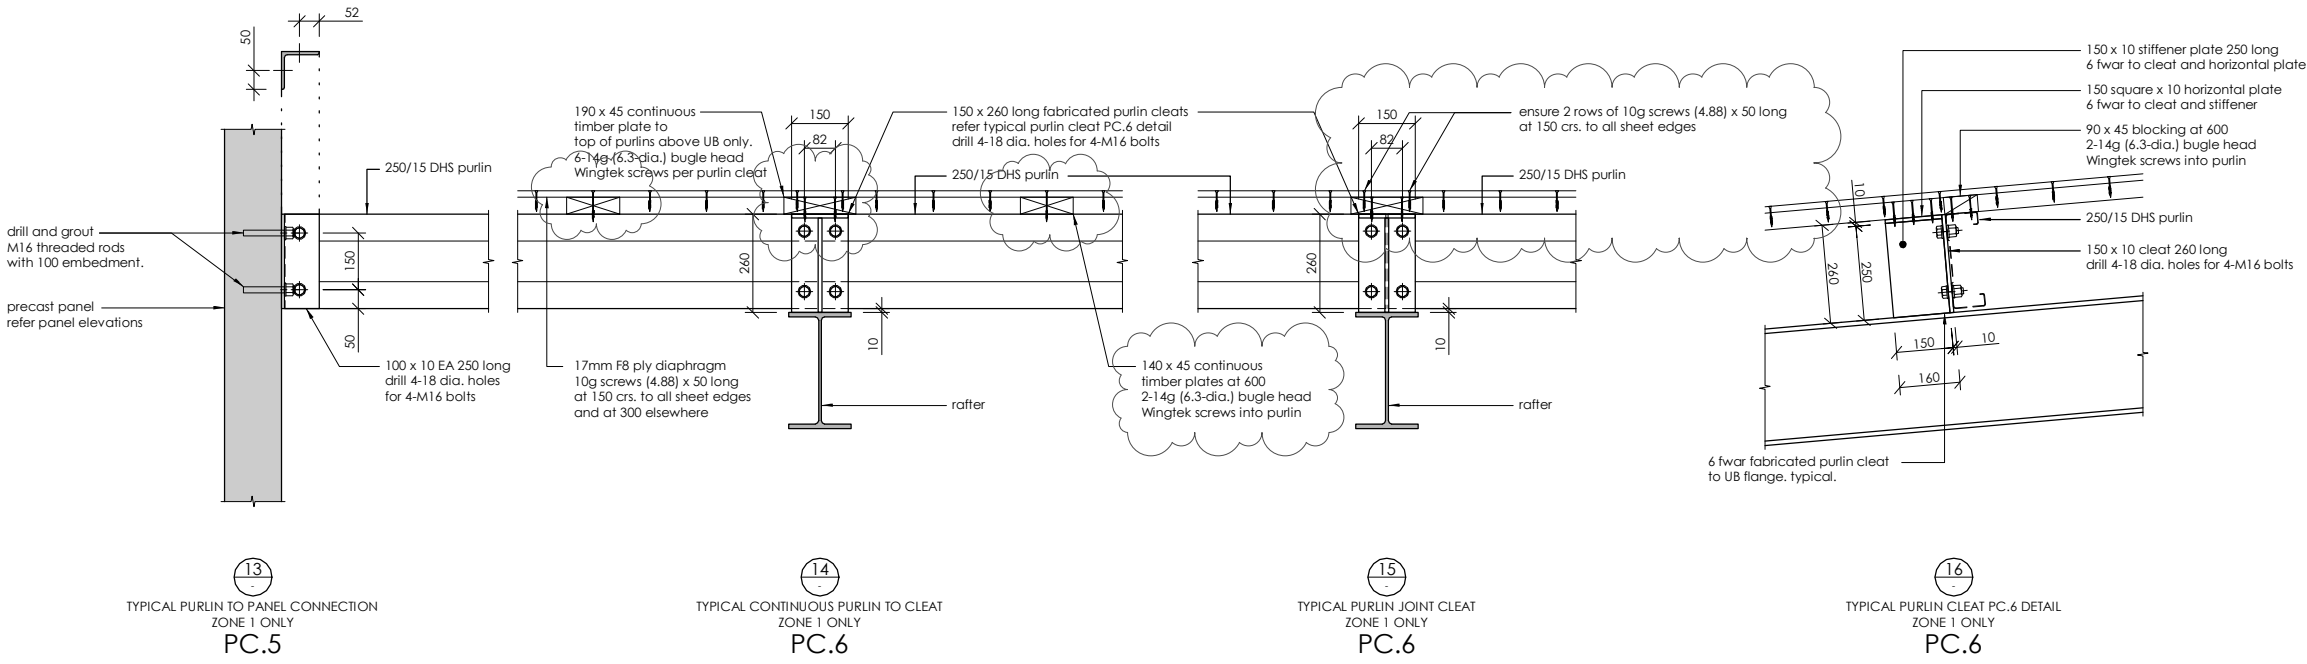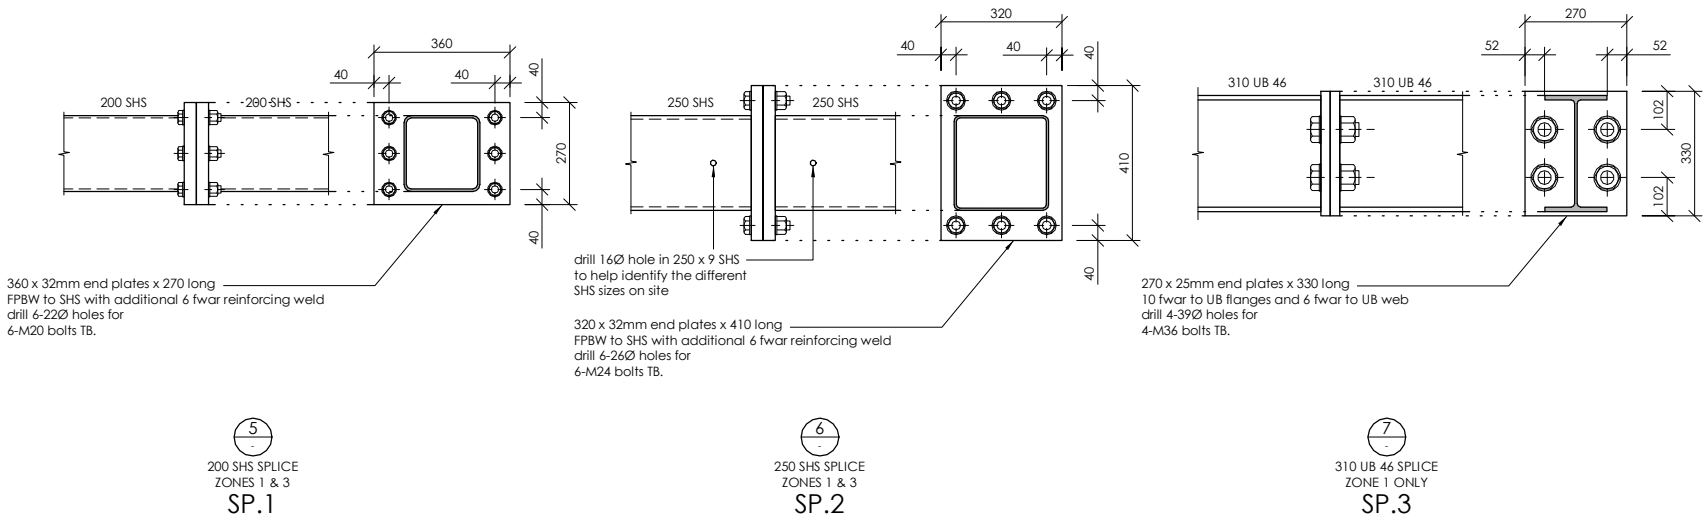

REV	DATE	AMENDMENT	BY
2	25.10.19	CONSENT ISSUE	GPW
1	27.09.19	PEER REVIEW ISSUE	GPW

CLIENT:
HWCP

lewis bradford
CONSULTING ENGINEERS

PROJECT:
**INVERCARGILL CENTRAL
ZONE 1 ANCHOR**

DRAWING TITLE:
**TYPICAL ROOF
STEELWORK DETAILS
SHEET 1**

DRAWN: GPW	SCALE: 1 : 10 at A1
ENGINEER: EL/TSS	
CHECKED: -	
118083-Z1-WD-ST 5700	REV. 2

1.1
17 Dec 2019

Building Division

BUILDING CONSENT NUMBER
2019/1381 1.4

THIS DRAWING AND ALL INFORMATION CONTAINED WITHIN IS THE PROPERTY OF LEWIS BRADFORD. ITS CONTENTS ARE CONFIDENTIAL AND MUST NOT BE REPRODUCED OR DISTRIBUTED TO ANY OTHER PERSON OR COMPANY UNLESS AGREED TO IN WRITING BY LEWIS BRADFORD

CONTRACTOR TO VERIFY ALL DIMENSIONS ON SITE REFER TO ARCHITECT'S DRAWING FOR ALL SETOUTS

NOTES:


Refer drawing 0002 for standard notes. Refer also to Structural Specification

note: apply intumescent fire protection with equivalent FRR to connections to all elements shown on plans/elevations designated with a *, ** or ***

Where unprotected areas of steelwork meet fire protected elements overlap the fire protection onto the adjoining 500mm of 'unprotected' structural steel

Invercargill City Council
Building Consent Authority
Approved Site Copy


Approved For Issue
27/02/2020

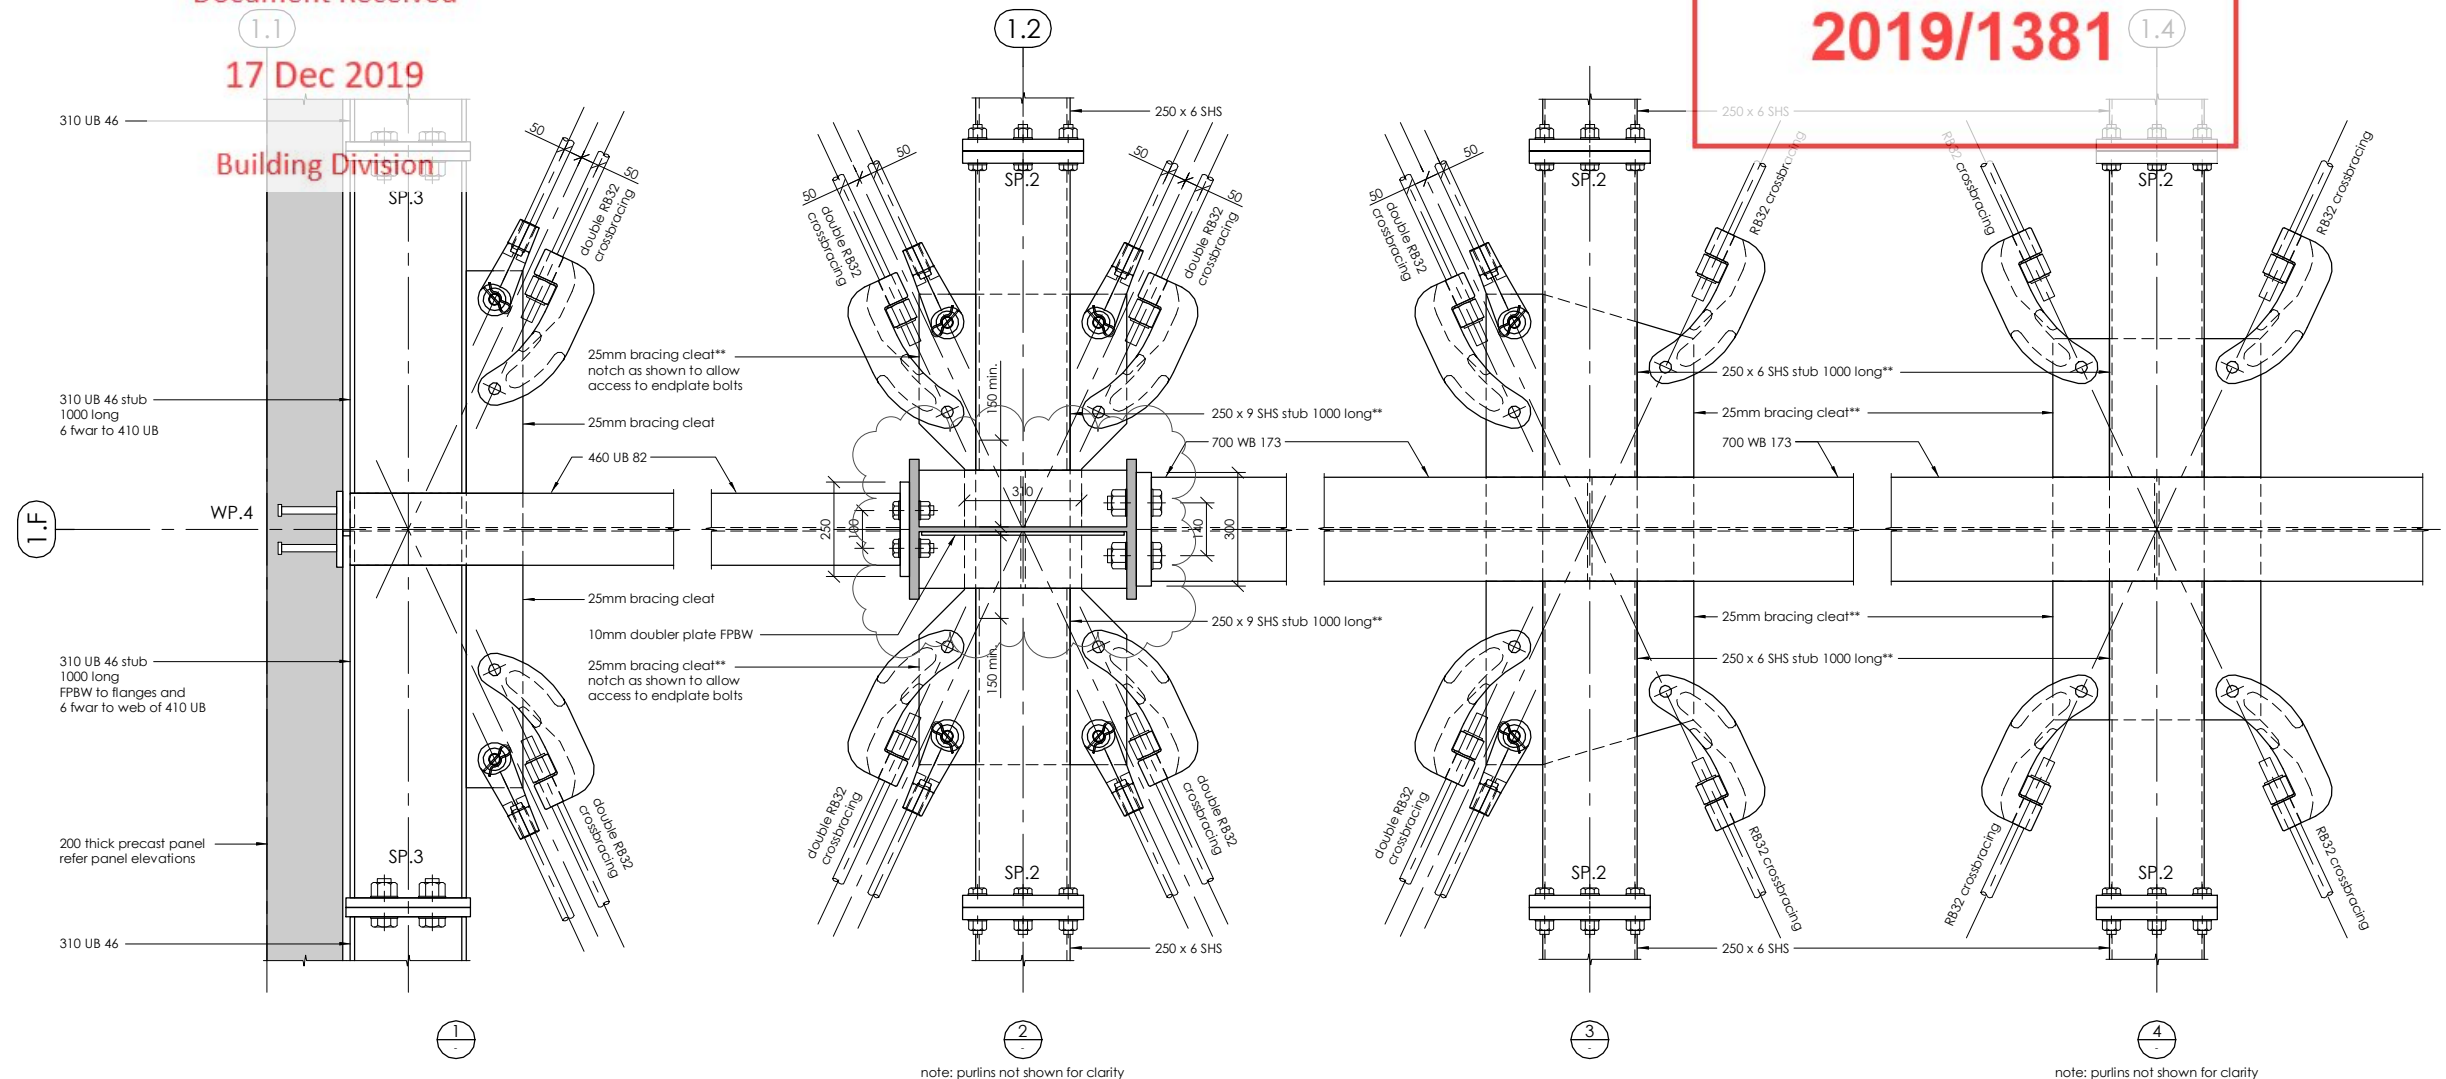

note: purlins not shown for clarity

note: purlins not shown for clarity

**** WELDING SEQUENCE TO BRACING MEMBERS**
1. slot bracing cleat over UB/WB web stiffener and 6 fwar to UB/WB and web stiffener
2. slot SHS stub over bracing cleat and web stiffener bevel prep FPBW and fillet weld top flange to build up minimum 6mm throat weld to top flange of SHS 6 fwar remaining 3 sides (contractor may propose alternative order of fabrication)

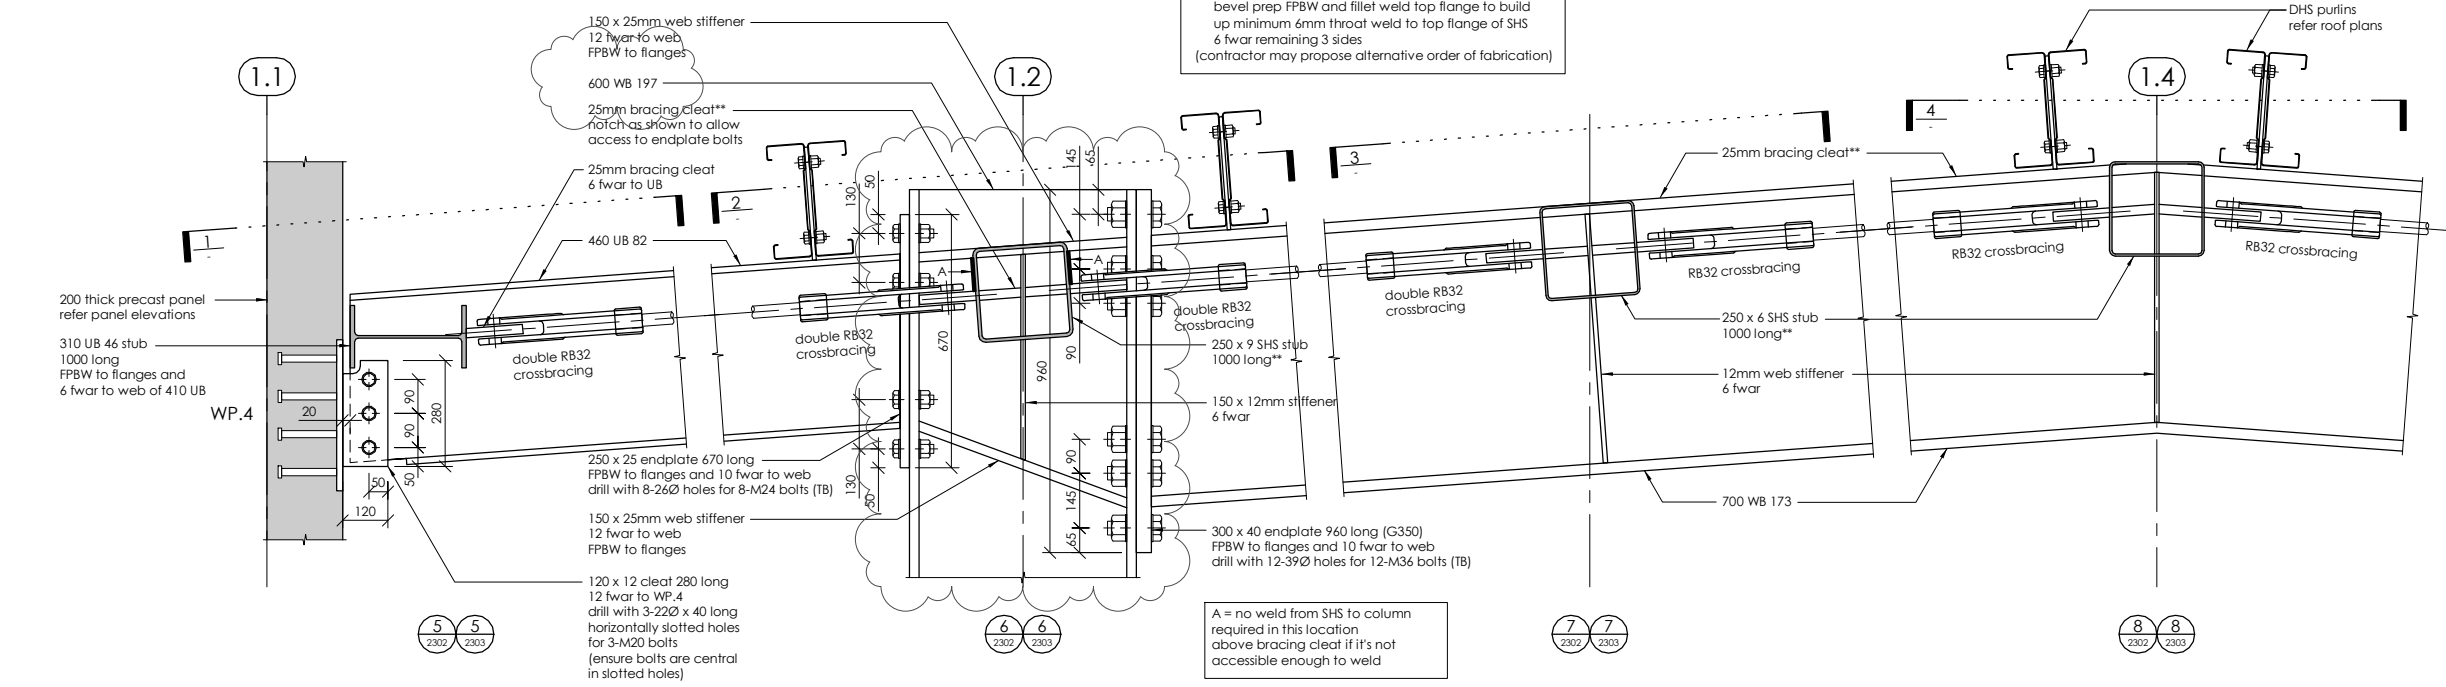

A = no weld from SHS to column required in this location above bracing cleat if it's not accessible enough to weld

2	25.10.19	CONSENT ISSUE	GPW
1	27.09.19	PEER REVIEW ISSUE	GPW
REV	DATE	AMENDMENT	BY

CLIENT:
HWCP

lewis bradford
CONSULTING ENGINEERS


PROJECT:
INVERCARGILL CENTRAL ZONE 1 ANCHOR

DRAWING TITLE:
ROOF STEELWORK DETAILS SHEET 1

DRAWN: GPW	SCALE: 1 : 10 at A1
ENGINEER: EL/TSS	
CHECKED: -	
118083-Z1-WD-ST 5710	REV. 2



17 Dec 2019

Building Division

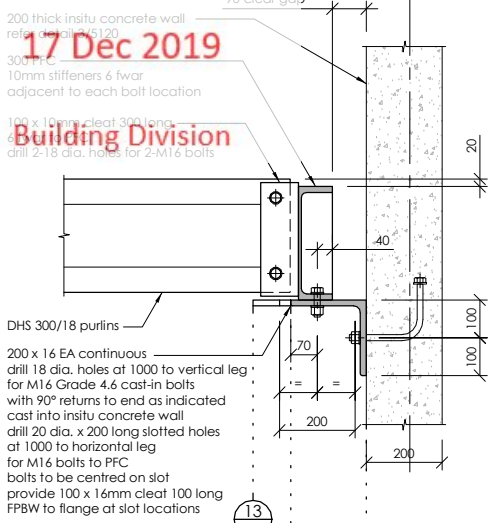

200 x 16 EA continuous drill 18 dia. holes at 1000 to vertical leg with 90° returns to end as indicated cast into in situ concrete wall drill 20 dia. x 200 long slotted holes at 1000 to horizontal leg for M16 bolts to PFC bolts to be centred on slot provide 100 x 16mm cleat 100 long FPBW to flange at slot locations


note: refer also detail 3/5120

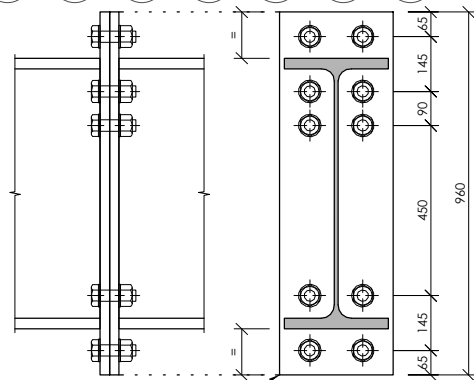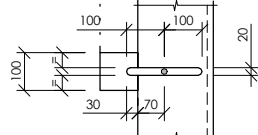


300 x 25mm end plates x 960 long FPBW to WB flanges and 10 fwar to WB web drill 10-33/2 holes for 10-M30 bolts TB.

700 WB 173 SPLICE

SP.12



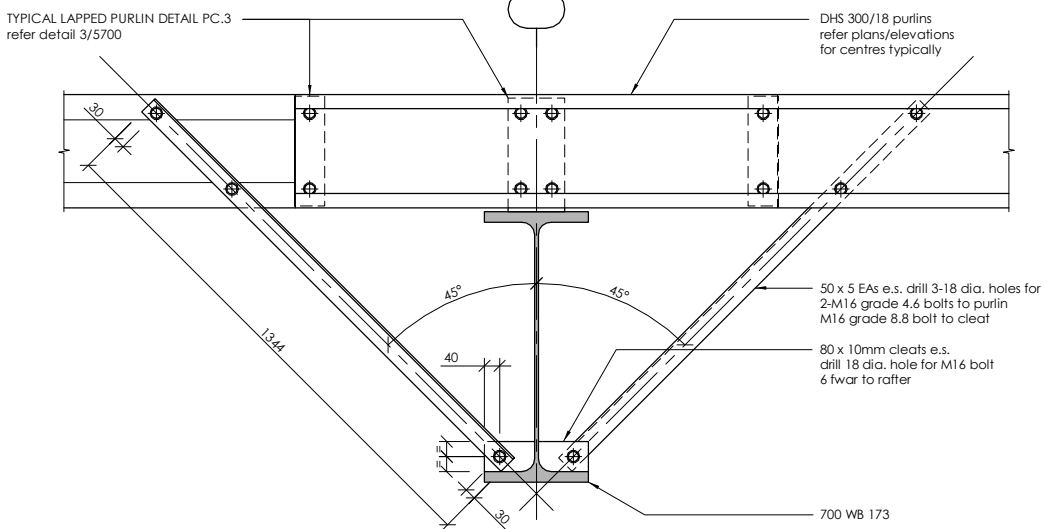


TYPICAL 700 WB 173 FLYBRACE DETAIL

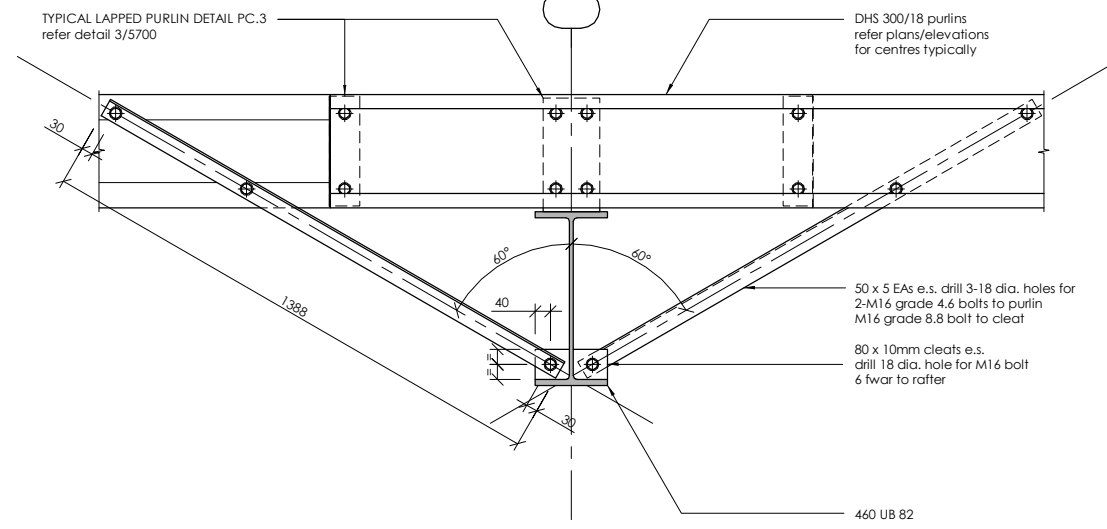

TYPICAL 460 UB 82 FLYBRACE DETAIL

BUILDING CONSENT NUMBER
2019/1381

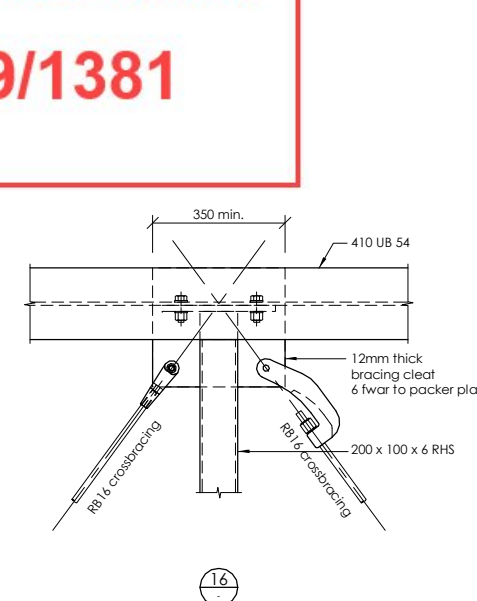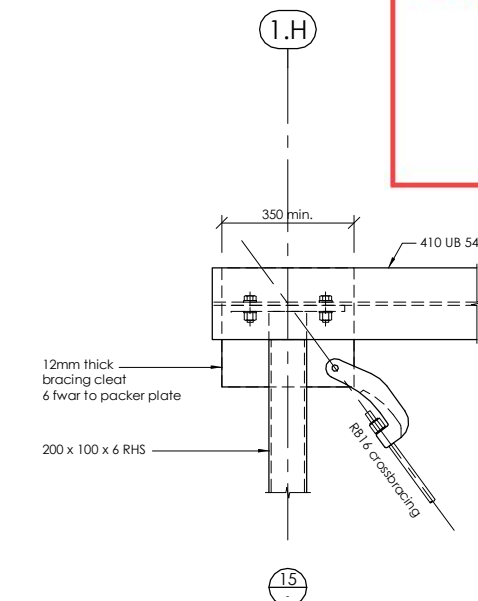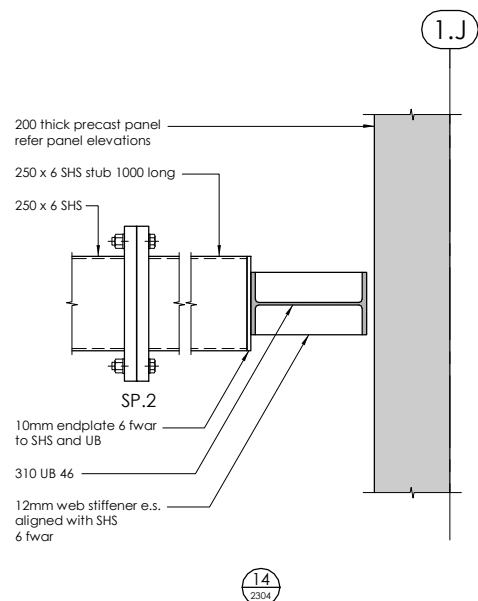

note: steel grating not shown for clarity

note: steel grating not shown for clarity

THIS DRAWING AND ALL INFORMATION CONTAINED WITHIN IS THE PROPERTY OF LEWIS BRADFORD. ITS CONTENTS ARE CONFIDENTIAL AND MUST NOT BE REPRODUCED OR DISTRIBUTED TO ANY OTHER PERSON OR COMPANY UNLESS AGREED TO IN WRITING BY LEWIS BRADFORD

CONTRACTOR TO VERIFY ALL DIMENSIONS ON SITE REFER TO ARCHITECT'S DRAWING FOR ALL SETOUTS

NOTES:
Refer drawing 0002 for standard notes. Refer also to Structural Specification

note: apply intumescent fire protection with equivalent FRR to connections to all elements shown on plans/elevations designated with a *, ** or ***

Where unprotected areas of steelwork meet fire protected elements overlap the fire protection onto the adjoining 500mm of 'unprotected' structural steel

Invercargill City Council
Building Consent Authority
Approved Site Copy

Approved For Issue
27/02/2020

2	25.10.19	CONSENT ISSUE	GPW
1	27.09.19	PEER REVIEW ISSUE	GPW
REV	DATE	AMENDMENT	BY

CLIENT:
HWCP

lewis bradford
CONSULTING ENGINEERS

PROJECT:
INVERCARGILL CENTRAL ZONE 1 ANCHOR

DRAWING TITLE:
ROOF STEELWORK DETAILS SHEET 2

DRAWN: GPW
ENGINEER: EL/TSS
CHECKED: -
SCALE:
1 : 10 at A1

118083-Z1-WD-ST 5711
REV. 2

Document Received

17 Dec 2019







Building Division

BUILDING CONSENT NUMBER
2019/1381

THIS DRAWING AND ALL INFORMATION CONTAINED WITHIN IS THE PROPERTY OF LEWIS BRADFORD. ITS CONTENTS ARE CONFIDENTIAL AND MUST NOT BE REPRODUCED OR DISTRIBUTED TO ANY OTHER PERSON OR COMPANY UNLESS AGREED TO IN WRITING BY LEWIS BRADFORD

CONTRACTOR TO VERIFY ALL DIMENSIONS ON SITE REFER TO ARCHITECT'S DRAWING FOR ALL SETOUTS

NOTES:
Refer drawing 0002 for standard notes. Refer also to Structural Specification.
note: apply intumescent fire protection with equivalent FRR to connections to all elements shown on plans/elevations designated with a *, ** or ***
Where unprotected areas of steelwork meet fire protected elements overlap the fire protection onto the adjoining 500mm of 'unprotected' structural steel

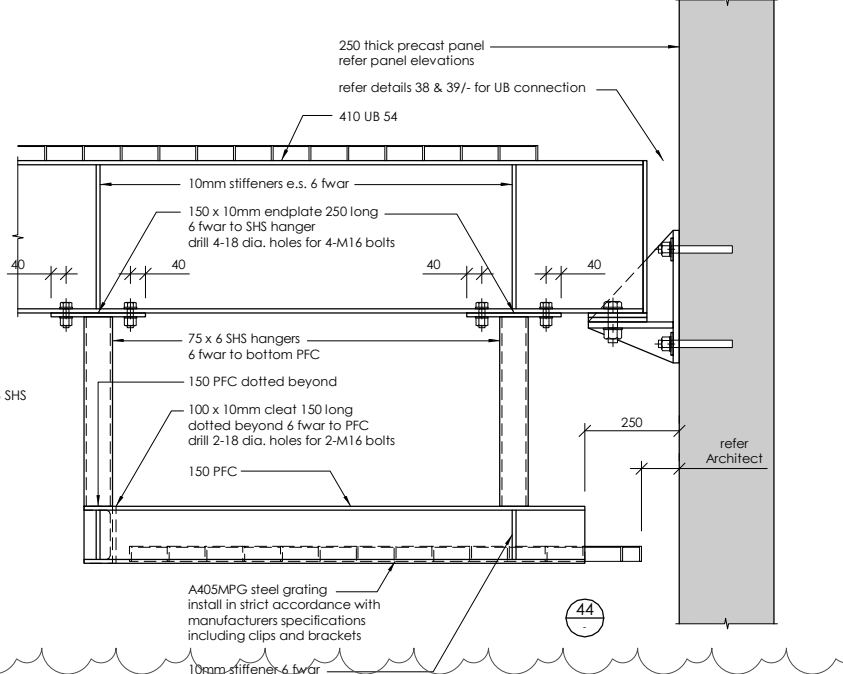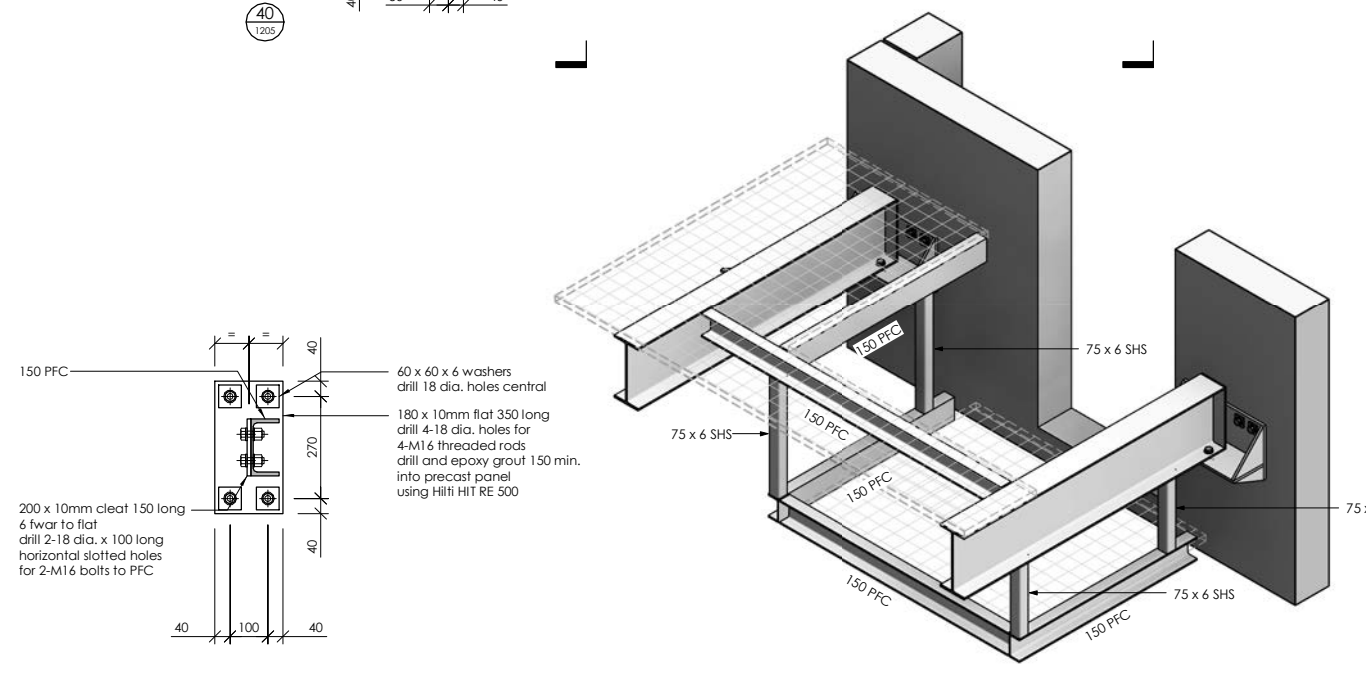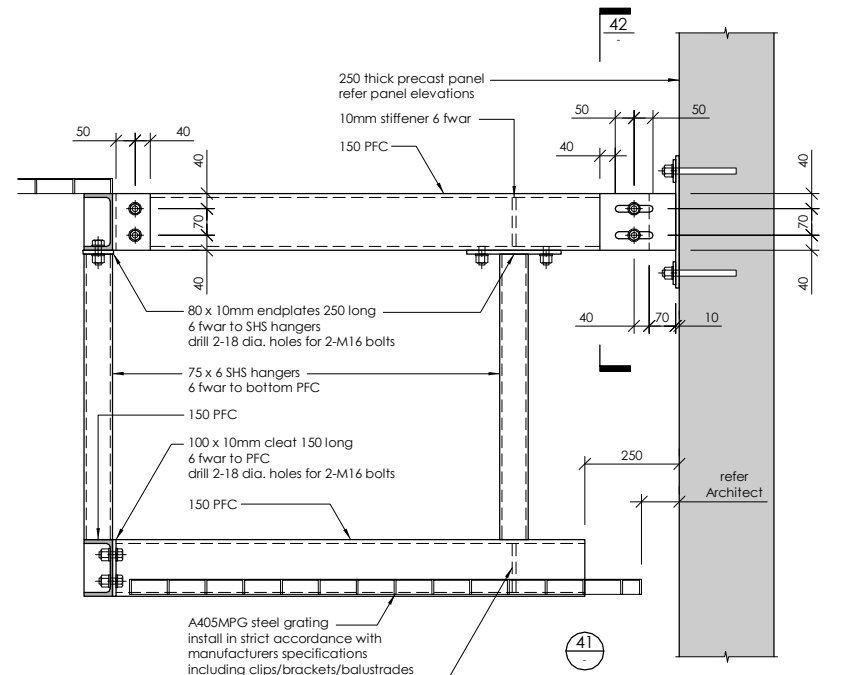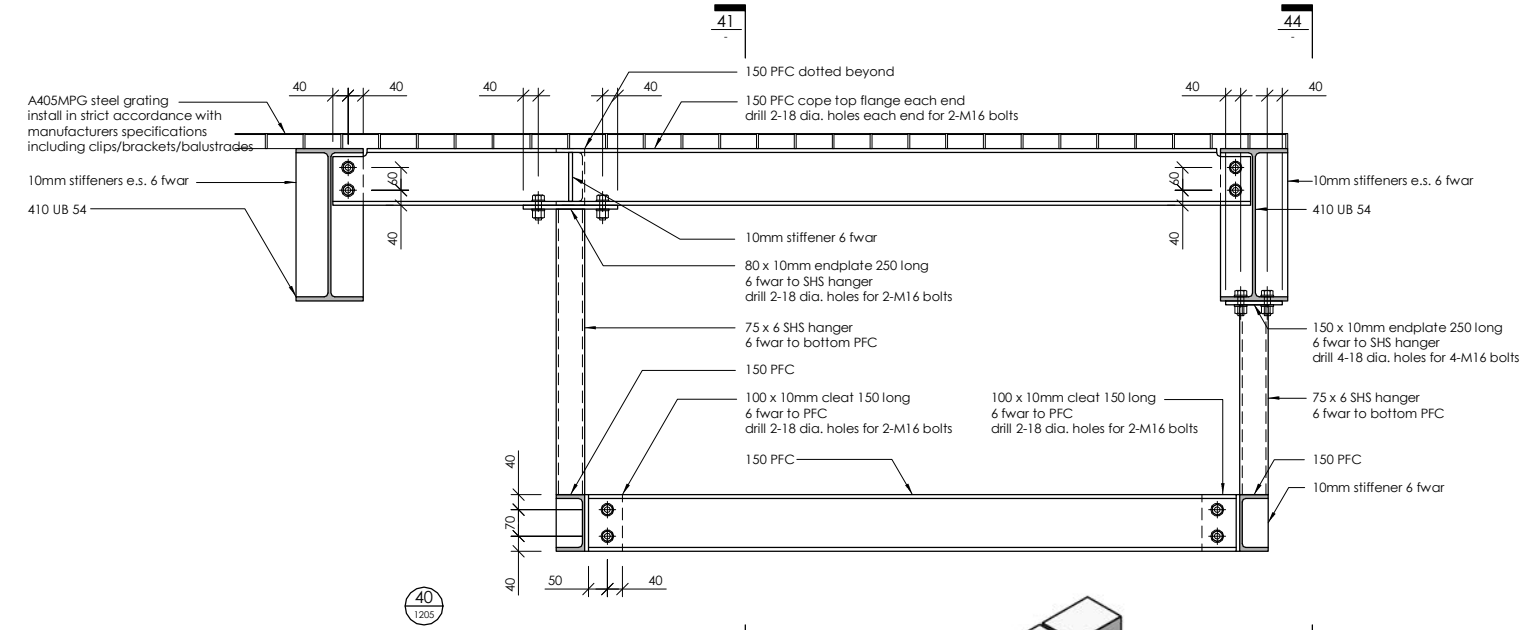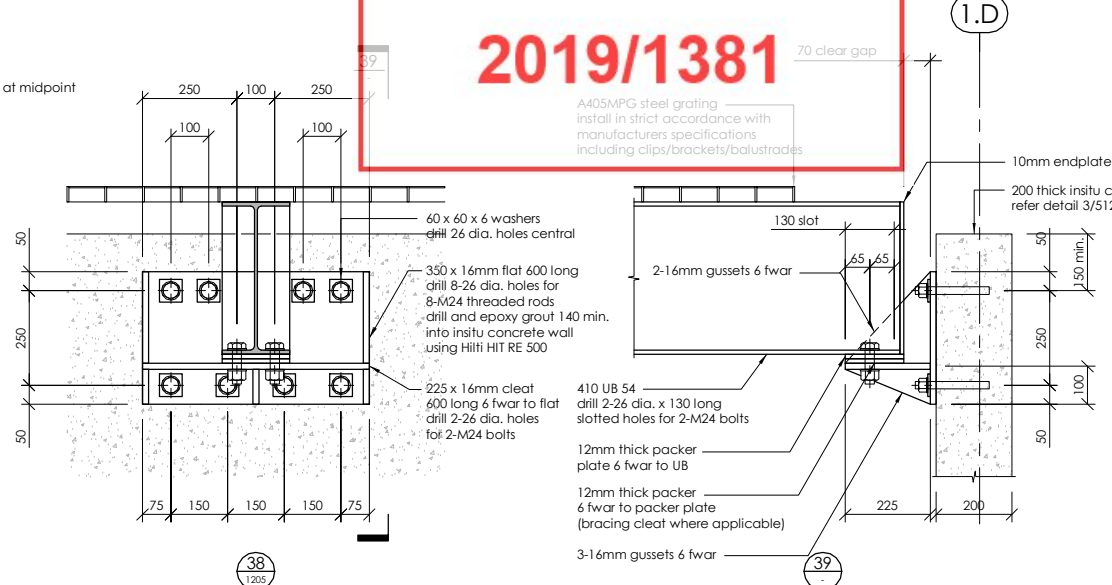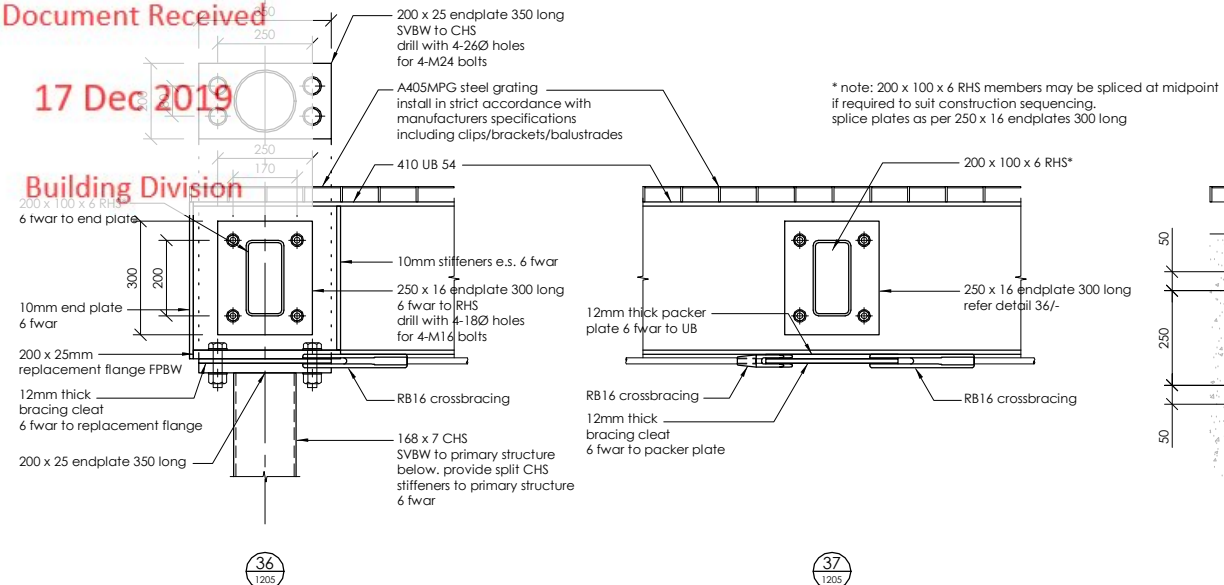

Invercargill City Council
Building Consent Authority
Approved Site Copy

Approved For Issue
27/02/2020

REV	DATE	AMENDMENT	BY
1	25.10.19	CONSENT ISSUE	GPW

CLIENT:
HWCP

lewis bradford
CONSULTING ENGINEERS

PROJECT:
**INVERCARGILL CENTRAL
ZONE 1 ANCHOR**

DRAWING TITLE:
**ROOF
STEELWORK DETAILS
SHEET 4**

DRAWN: GPW	SCALE: 1 : 10 at A1
ENGINEER: EL/TSS	
CHECKED: -	
118083-Z1-WD-ST 5713	REV. 1

17 Dec 2019

Building Division

BUILDING CONSENT NUMBER
2019/1381


THIS DRAWING AND ALL INFORMATION CONTAINED WITHIN IS THE PROPERTY OF LEWIS BRADFORD. ITS CONTENTS ARE CONFIDENTIAL AND MUST NOT BE REPRODUCED OR DISTRIBUTED TO ANY OTHER PERSON OR COMPANY UNLESS AGREED TO IN WRITING BY LEWIS BRADFORD

CONTRACTOR TO VERIFY ALL DIMENSIONS ON SITE REFER TO ARCHITECT'S DRAWING FOR ALL SETOUTS


NOTES :
Refer drawing 0002 for standard notes.
Refer also to Structural Specification

note: apply intumescent fire protection with equivalent FRR to connections to all elements shown on plans/elevations designated with a *, ** or ***


Where unprotected areas of steelwork meet fire protected elements overlap the fire protection onto the adjoining 500mm of 'unprotected' structural steel!

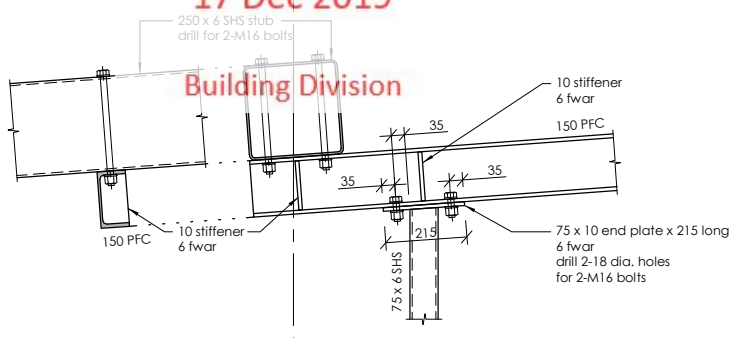

46
120x

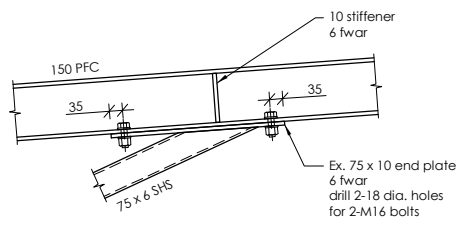


47
120x

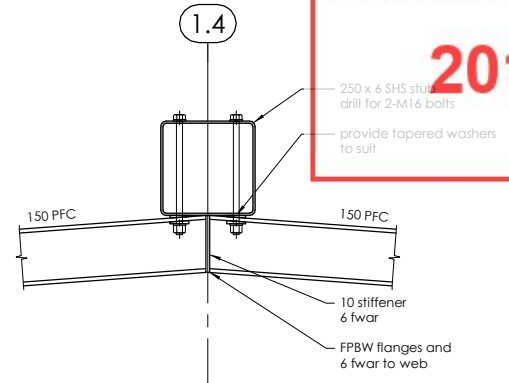


48
120x


1.3

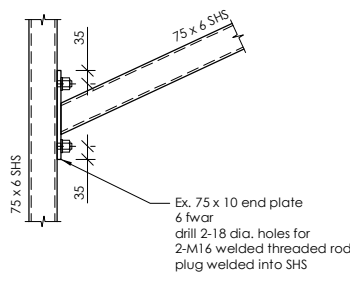

50
120x

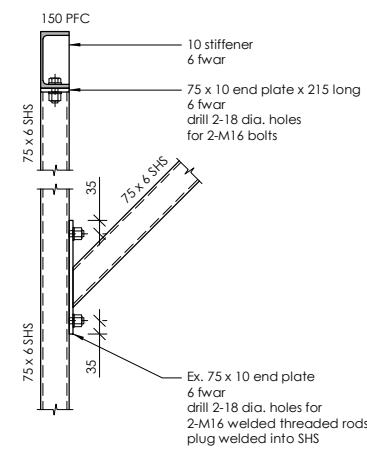


51
120x

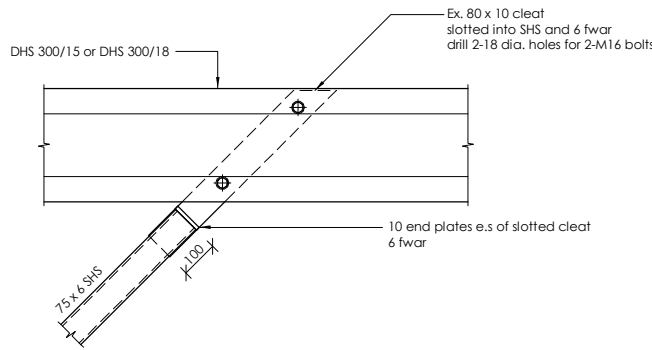

52
120x

1.3

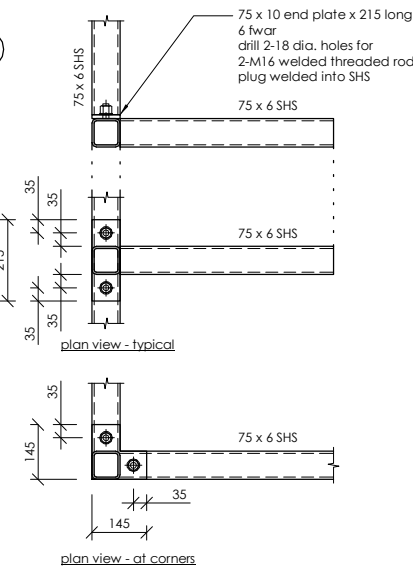

54
120x

Invercargill City Council
Building Consent Authority
Approved Site Copy

Approved For Issue
27/02/2020

REV	DATE	AMENDMENT	BY
1	25.10.19	CONSENT ISSUE	GPW

CLIENT:
HWCP

lewis bradford
CONSULTING ENGINEERS

PROJECT:
**INVERCARGILL CENTRAL
ZONE 1 ANCHOR**

DRAWING TITLE:
**ROOF
STEELWORK DETAILS
SHEET 5**


DRAWN: GPW	SCALE:
ENGINEER: EL/TSS	1 : 10 at A1
CHECKED: -	

118083-Z1-WD-ST 5714
REV. 1

17 Dec 2019

Building Division

BUILDING CONSENT NUMBER
2019/1381

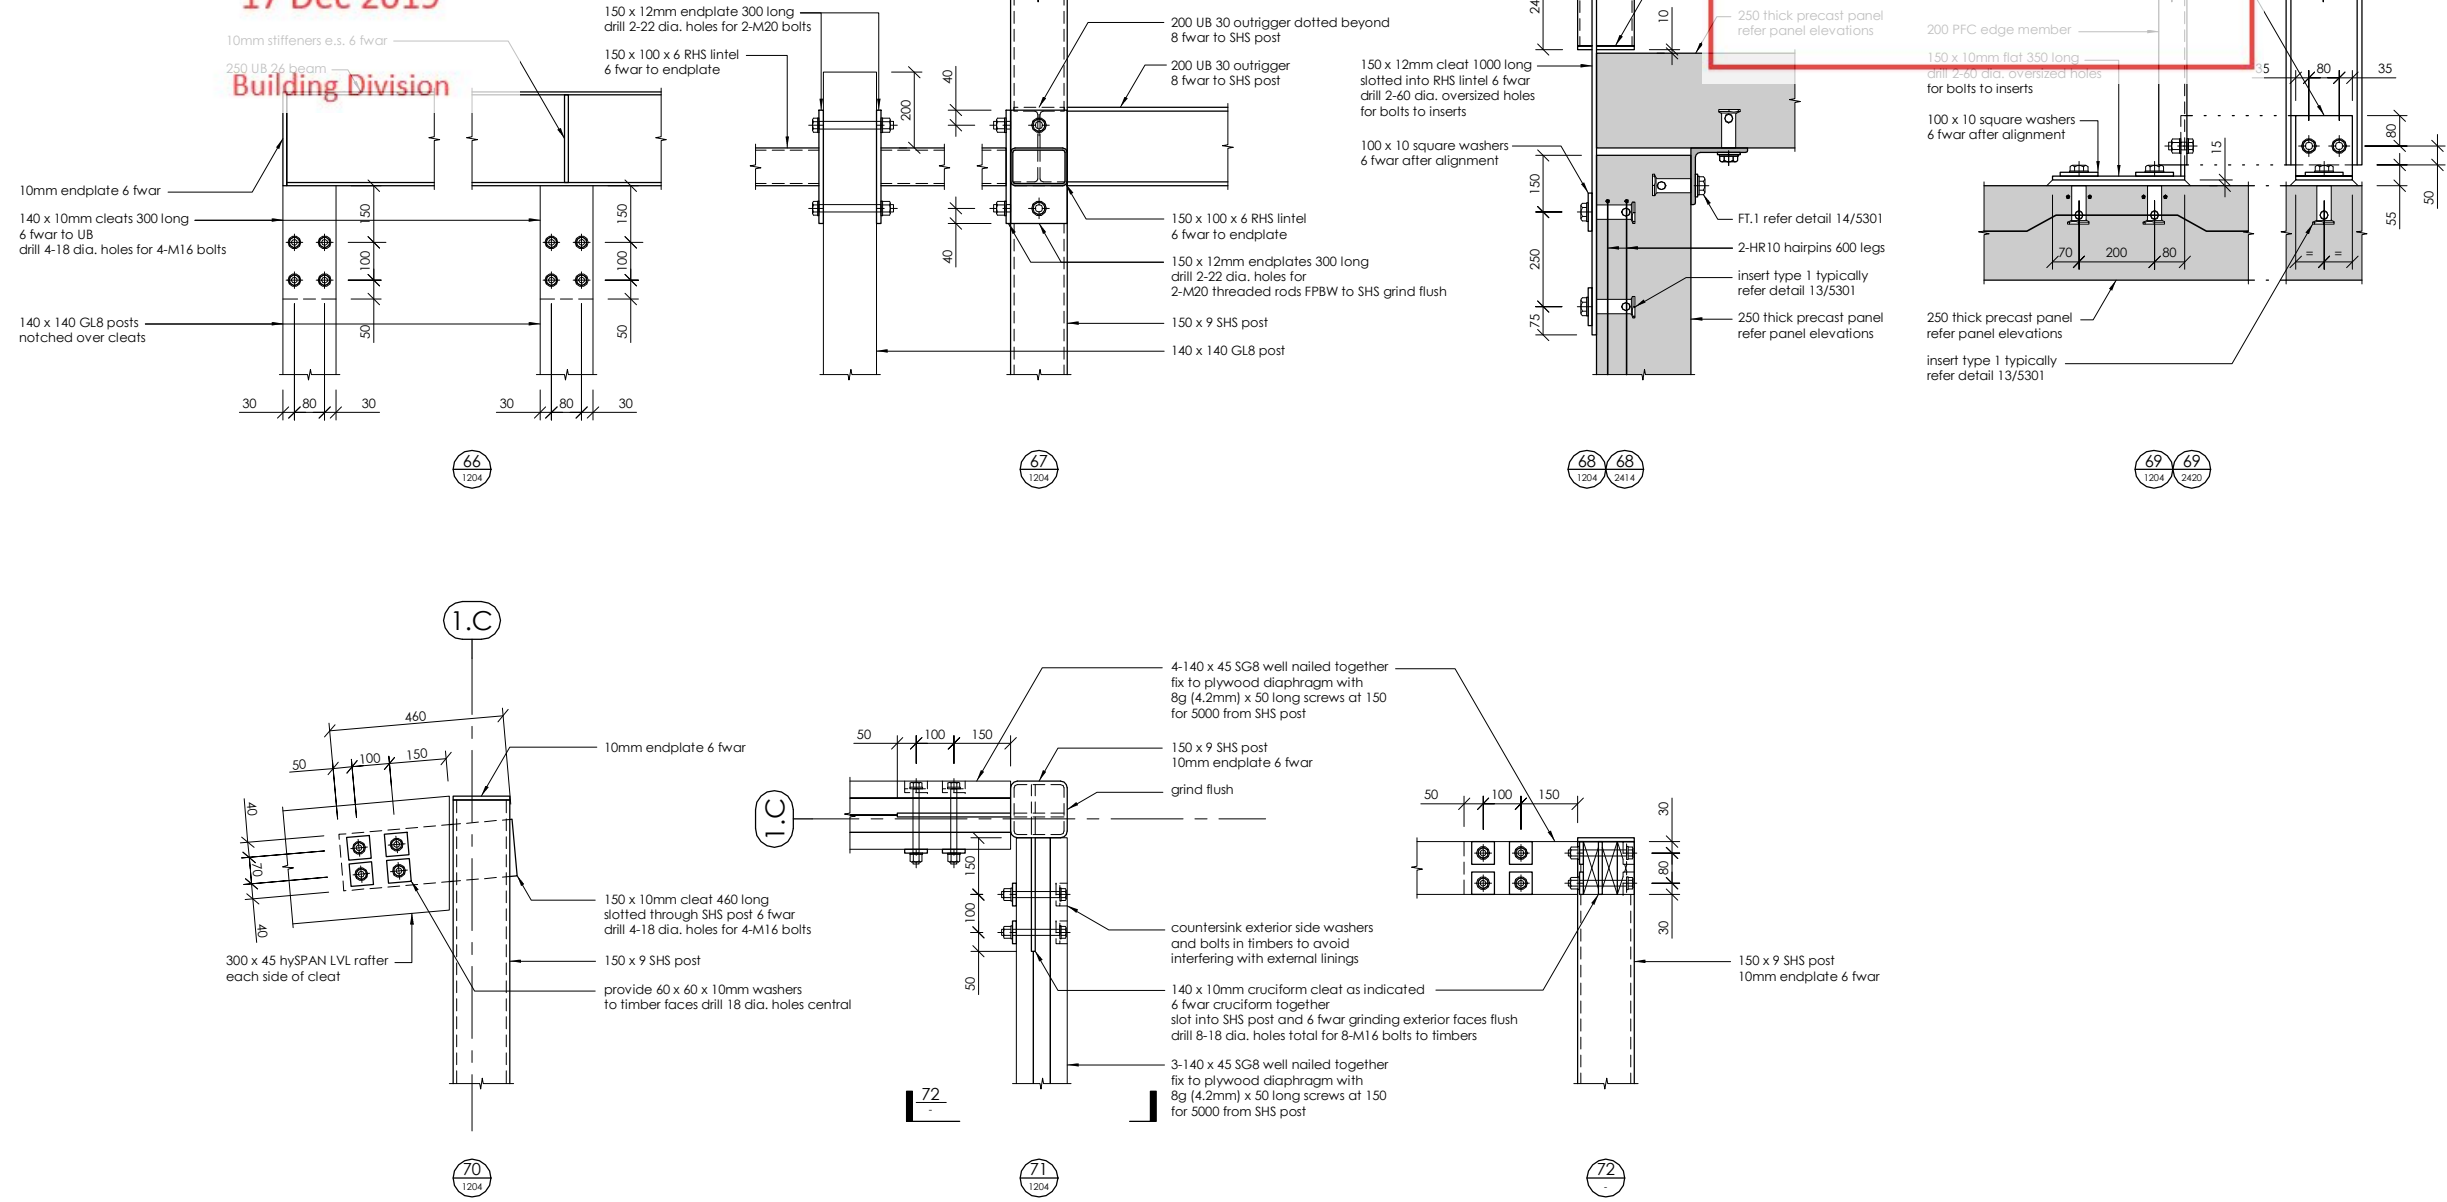

THIS DRAWING AND ALL INFORMATION CONTAINED WITHIN IS THE PROPERTY OF LEWIS BRADFORD. ITS CONTENTS ARE CONFIDENTIAL AND MUST NOT BE REPRODUCED OR DISTRIBUTED TO ANY OTHER PERSON OR COMPANY UNLESS AGREED TO IN WRITING BY LEWIS BRADFORD

CONTRACTOR TO VERIFY ALL DIMENSIONS ON SITE REFER TO ARCHITECT'S DRAWING FOR ALL SETOUTS

NOTES:
Refer drawing 0002 for standard notes. Refer also to Structural Specification.
note: apply intumescent fire protection with equivalent FRR to connections to all elements shown on plans/elevations designated with a *, ** or ***
Where unprotected areas of steelwork meet fire protected elements overlap the fire protection onto the adjoining 500mm of 'unprotected' structural steel

Invercargill City Council
Building Consent Authority
Approved Site Copy

Approved For Issue
27/02/2020

REV	DATE	AMENDMENT	BY
1	25.10.19	CONSENT ISSUE	GPW

CLIENT:
HWCP

lewis bradford
CONSULTING ENGINEERS

PROJECT:
**INVERCARGILL CENTRAL
ZONE 1 ANCHOR**


DRAWING TITLE:
**ROOF
STEELWORK DETAILS
SHEET 7**

DRAWN: GPW	SCALE: 1 : 10 at A1
ENGINEER: EL/TSS	
CHECKED: -	
118083-Z1-WD-ST 5716	REV. 1



weldplate WP.1 (ZONE 1 only)


300 x 16mm endplate 850 long
8-19 dia. Nelson studs 150 long
FPBW to endplate

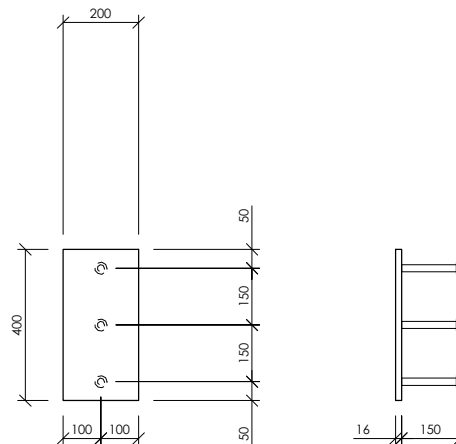

weldplate WP.2 (ZONE 1 only)


200 x 16mm endplate 400 long
3-19 dia. Nelson studs 150 long
FPBW to endplate

BUILDING CONSENT NUMBER
2019/1381

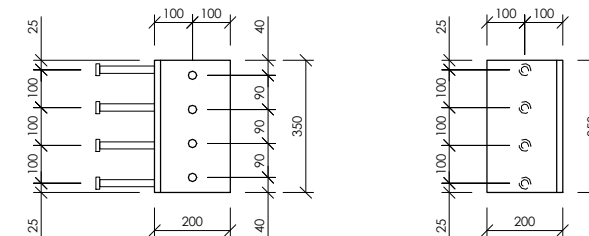


weldplate WP.3 (ZONE 1 only)

200 x 16 EA 350 long
drill 4-22 dia. holes for 4-M20 bolts
4-19 dia. Nelson studs 150 long FPBW to EA

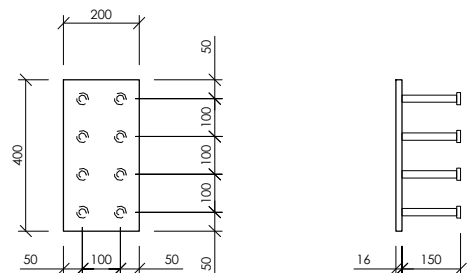


weldplate WP.4 (ZONE 1 only)

250 x 16mm endplate 400 long
8-19 dia. Nelson studs 150 long
FPBW to endplate

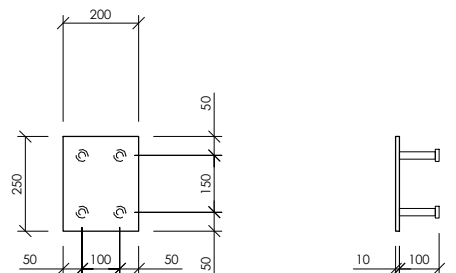

weldplate WP.5 (ZONE 1 only)

250 x 10mm endplate 200 long
4-19 dia. Nelson studs 100 long

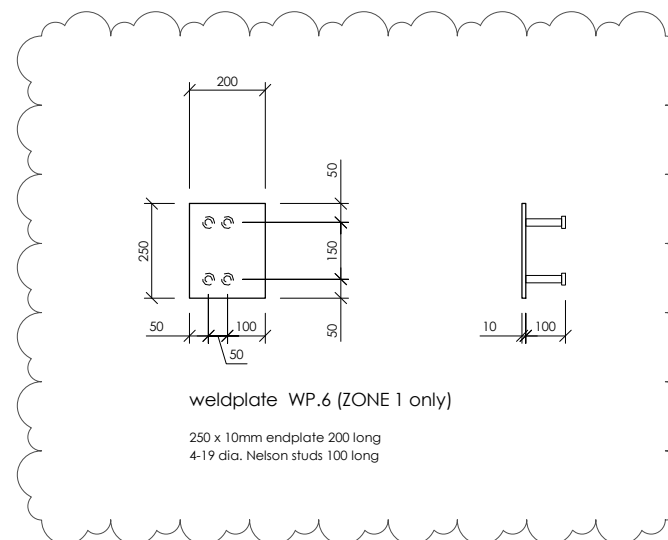

weldplate WP.6 (ZONE 1 only)

250 x 10mm endplate 200 long
4-19 dia. Nelson studs 100 long

THIS DRAWING AND ALL INFORMATION CONTAINED WITHIN IS THE PROPERTY OF LEWIS BRADFORD. ITS CONTENTS ARE CONFIDENTIAL AND MUST NOT BE REPRODUCED OR DISTRIBUTED TO ANY OTHER PERSON OR COMPANY UNLESS AGREED TO IN WRITING BY LEWIS BRADFORD

CONTRACTOR TO VERIFY ALL DIMENSIONS ON SITE REFER TO ARCHITECT'S DRAWING FOR ALL SETOUTS

NOTES :

Refer drawing 0002 for standard notes. Refer also to Structural Specification

note: apply intumescent fire protection with equivalent FRR to connections to all elements shown on plans/elevations designated with a *, ** or ***

Where unprotected areas of steelwork meet fire protected elements overlap the fire protection onto the adjoining 500mm of 'unprotected' structural steel

Invercargill City Council
Building Consent Authority
Approved Site Copy

Approved For Issue
27/02/2020

REV	DATE	AMENDMENT	BY
2	25.10.19	CONSENT ISSUE	GPW
1	27.09.19	PEER REVIEW ISSUE	GPW

CLIENT:
HWCP

lewis bradford
CONSULTING ENGINEERS

PROJECT:
INVERCARGILL CENTRAL ZONE 1 ANCHOR

DRAWING TITLE:
WELDPLATE DETAILS SHEET 1

DRAWN: GPW	SCALE: 1 : 10 at A1
ENGINEER: EL/TSS	
CHECKED: -	
118083-Z1-WD-ST 5900	REV. 2